

## ADDENDUM NO. 2

TO: PLANS AND SPECIFICATIONS FOR STATE OF MISSOURI

Modernize Elevator  
Sexual Offender Rehabilitation Treatment Services (SORTS)  
Hoctor Building  
Farmington, Missouri  
PROJECT NO. M1814-01

Bid Opening Date: 1:30 PM, Thursday, December 19, 2019 (Not Changed)

Bidders are hereby informed that the Construction Plans and/or Specifications are modified as follows:

### **SPECIFICATION CHANGES:**

1. None

### **DRAWING CHANGES:**

#### 1. Sheet A-101

a. ADD the following notes below the table for Detail 5/A-101:

1. There are 4 stops for this elevator. The stops are as follows: Tunnel, First Floor, Second Floor, and Third Floor.
2. There is no sump pump at the bottom of the elevator shaft.

#### 2. Sheet A-102

a. REMOVE and REPLACE Detail 3/A-102 with attached revised Detail 3/A-102.

b. ADD the following notes to Detail 4/A-102:

1. The elevator call button height of 42" is representative of existing but the new recessed elevator call button should be located directly over where each of the existing call buttons are currently located.
2. The new call buttons and new floor indicator may or may not be the same size as the existing. The size will vary based upon manufacturer. If the new call buttons and floor indicator are not large enough to cover the holes left in the walls from the removal of the existing call buttons and floor indicator, it will be necessary for the contractor to repair the damaged area of the wall to match the surrounding existing wall.

### **GENERAL COMMENTS:**

1. Please contact Kelly Copeland, Contract Specialist, at 573-522-2283 or [kelly.copeland@oa.mo.gov](mailto:kelly.copeland@oa.mo.gov) for questions regarding bidding procedures, MO Buys, and MBE/WBE/SDVE submittal requirements.
2. The deadline for technical questions was December 12, 2019 at 12:00 PM.
3. All correspondence with respect to this project must include the State of Missouri project number as indicated above.


4. Changes to, or clarification of, the Bid Documents are only made as issued in the Addenda.
5. Current Planholders list is available at: <https://www.adsplanroom.net/jobs/247/planholders/m1814-01-modernize-elevator-sexual-offender-rehab-treatment-services-sorts-hoctor-bldg>
6. Prospective bidders contact American Document Solutions, 1400 Forum Blvd Suite 1C, Columbia MO 65201, 573-446-7768 to order official plans and specifications.
7. Prospective bidders may contact Brad Burgess at 573-218-6857 to arrange a site visit. Please provide at least 24 hours' notice.

**ATTACHMENTS:**

1. Revised Detail 3/A-102

**December 12, 2019**

**END ADDENDUM NO. 2**

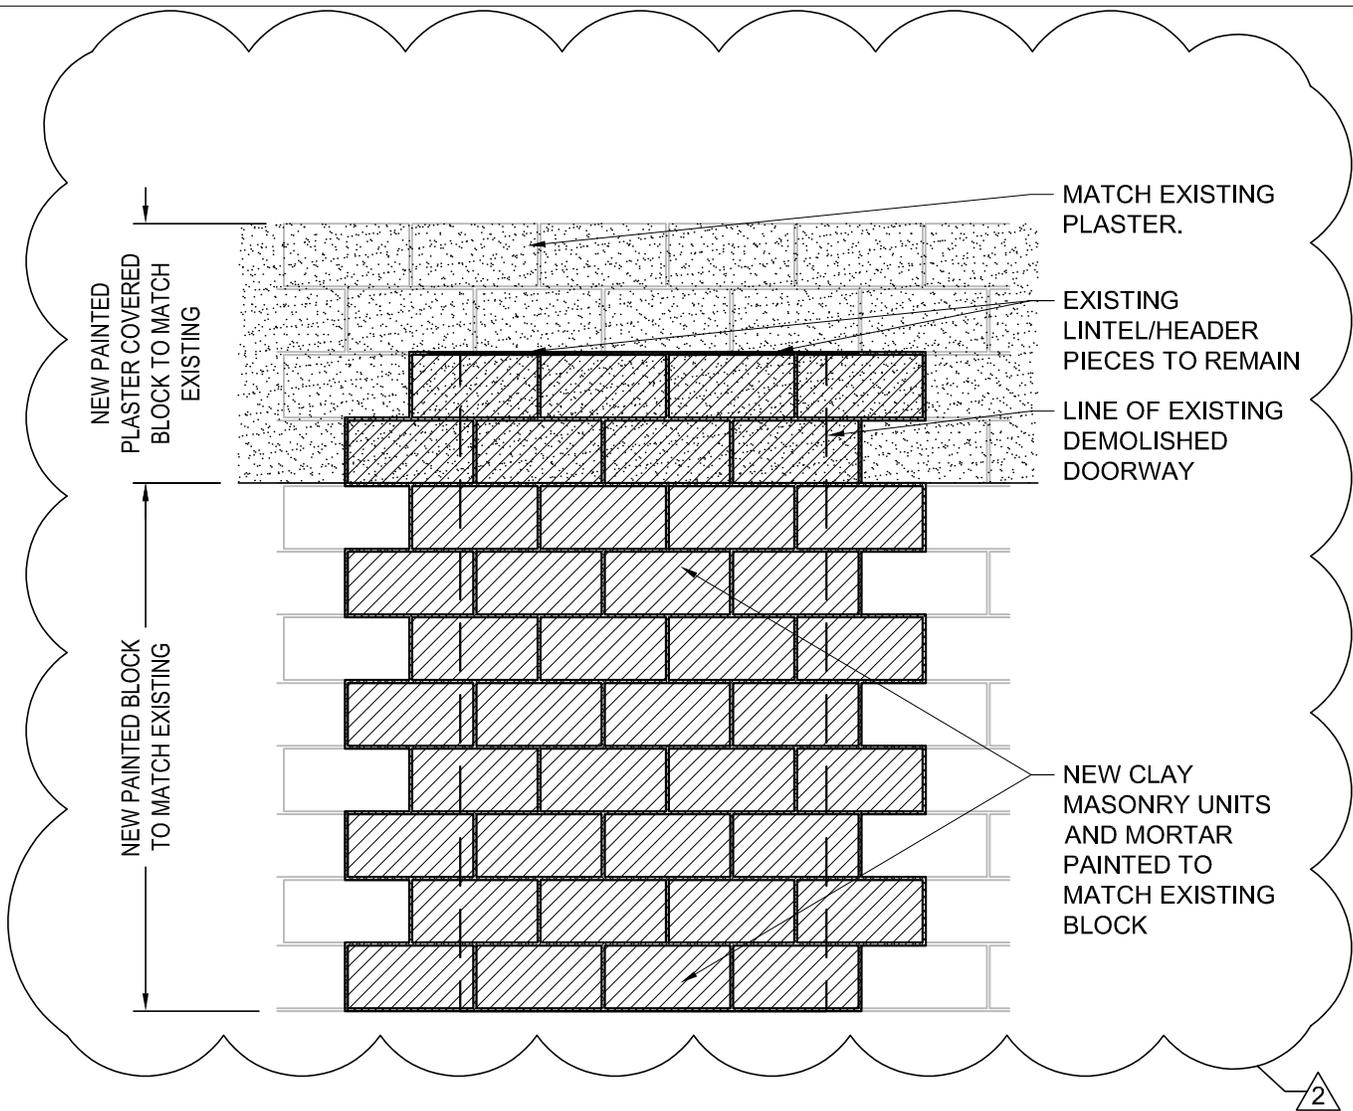

3  
A102

## REAR DOOR INFILL ELEVATION

SCALE: 1/2" = 1'-0"



Hurst-Rosche, Inc.  
PROFESSIONAL DESIGN NUMBER: 000372

200 NORTH MARKET ST.  
MARION, IL 62959  
PH: 618.998.0075  
[www.hurst-rosche.com](http://www.hurst-rosche.com)  
HILLSBORO, IL  
EAST ST. LOUIS, IL  
ARNOLD, MO  
NEOSHO, MO  
NASHVILLE, TN

### REAR DOOR INFILL ELEVATION

MODERNIZE ELEVATOR  
SEXUAL OFFENDER REHABILITATION SERVICES  
(SORTS)  
HOCTOR BUILDING  
1010 W COLUMBIA STREET FARMINGTON, MO  
Site #: 6517 Facility #: 6517359003

PROJECT #: M1814-01  
HR #: 370-3258

ATTACHMENT  
NUMBER: 1  
ADDENDUM  
NUMBER: 2

DATE: 12.12.19