

## Addendum No. 03

TO: PLANS AND SPECIFICATIONS FOR:

Upgrade HVAC Controls  
Staples Building  
Southeast MO Mental Health Center  
Farmington, MO  
PROJECT NO. M2011-01

**New Bid Opening Date: 1:30PM, April 16, 2024 (CHANGED)**

**Bidders are hereby informed that the construction plans and/or specifications are modified as follows:**

### **SPECIFICATION CHANGES:**

1. Section 000110 - TABLE OF CONTENTS  
**ADD:** APPENDIX A – AS BUILT DRAWINGS OF STAPLE BUILDING
2. Section 001116 - INVITATION FOR BID  
**REVISE** Paragraph 3.0-A as follows  
A. Until: 1:30 PM, April 16, 2024

### **DRAWING CHANGES:**

NONE

### **GENERAL COMMENTS:**


- The Pre-Bid meeting was held March 13, 2024
- Bidders desiring to perform a site inspection should contact staff Brad Burgess at 573-218-6857 [Brad.Burgess@oa.mo.gov](mailto:Brad.Burgess@oa.mo.gov) to schedule a time to enter the facility.
- Please contact Paul Girouard, 573-751-4797 [paul.girouard@oa.mo.gov](mailto:paul.girouard@oa.mo.gov) for questions about bidding procedures, MBE\WBE\SDVE Goals, and other submittal requirements.
- Changes to, or clarification of, the bid documents are only made as issued in the addenda.
- All correspondence with respect to this project must include the State of Missouri project number as indicated above.
- **All bids shall be submitted on the bid form without additional terms and conditions, modifications, or stipulations. Each space on the bid form shall be properly filled including a bid amount for each alternate. Failure to do so will result in rejection of the bid.**
- **MBE/WBE/SDVE participation requirements can be found in DIVISION 00. The MBE/WBE/SDVE participation goals are 10%/10%/3%, respectively. Only certified firms as of the bid opening date can be used to satisfy the MBE/WBE/SDVE participation goals for this project. If a bidder is unable to meet a participation goal, a Good Faith Effort Determination Form must be completed. Failure to complete this process will result in rejection of the bid.**
- Propress is an acceptable installation practice.
- All ASU fan motors and pump motors are 480V / 3 Phase.

**ATTACHMENTS:**

**APPENDIX A – AS BUILT DRAWINGS OF STAPLE BUILDING**

**END OF ADDENDUM 03**

April 8, 2024

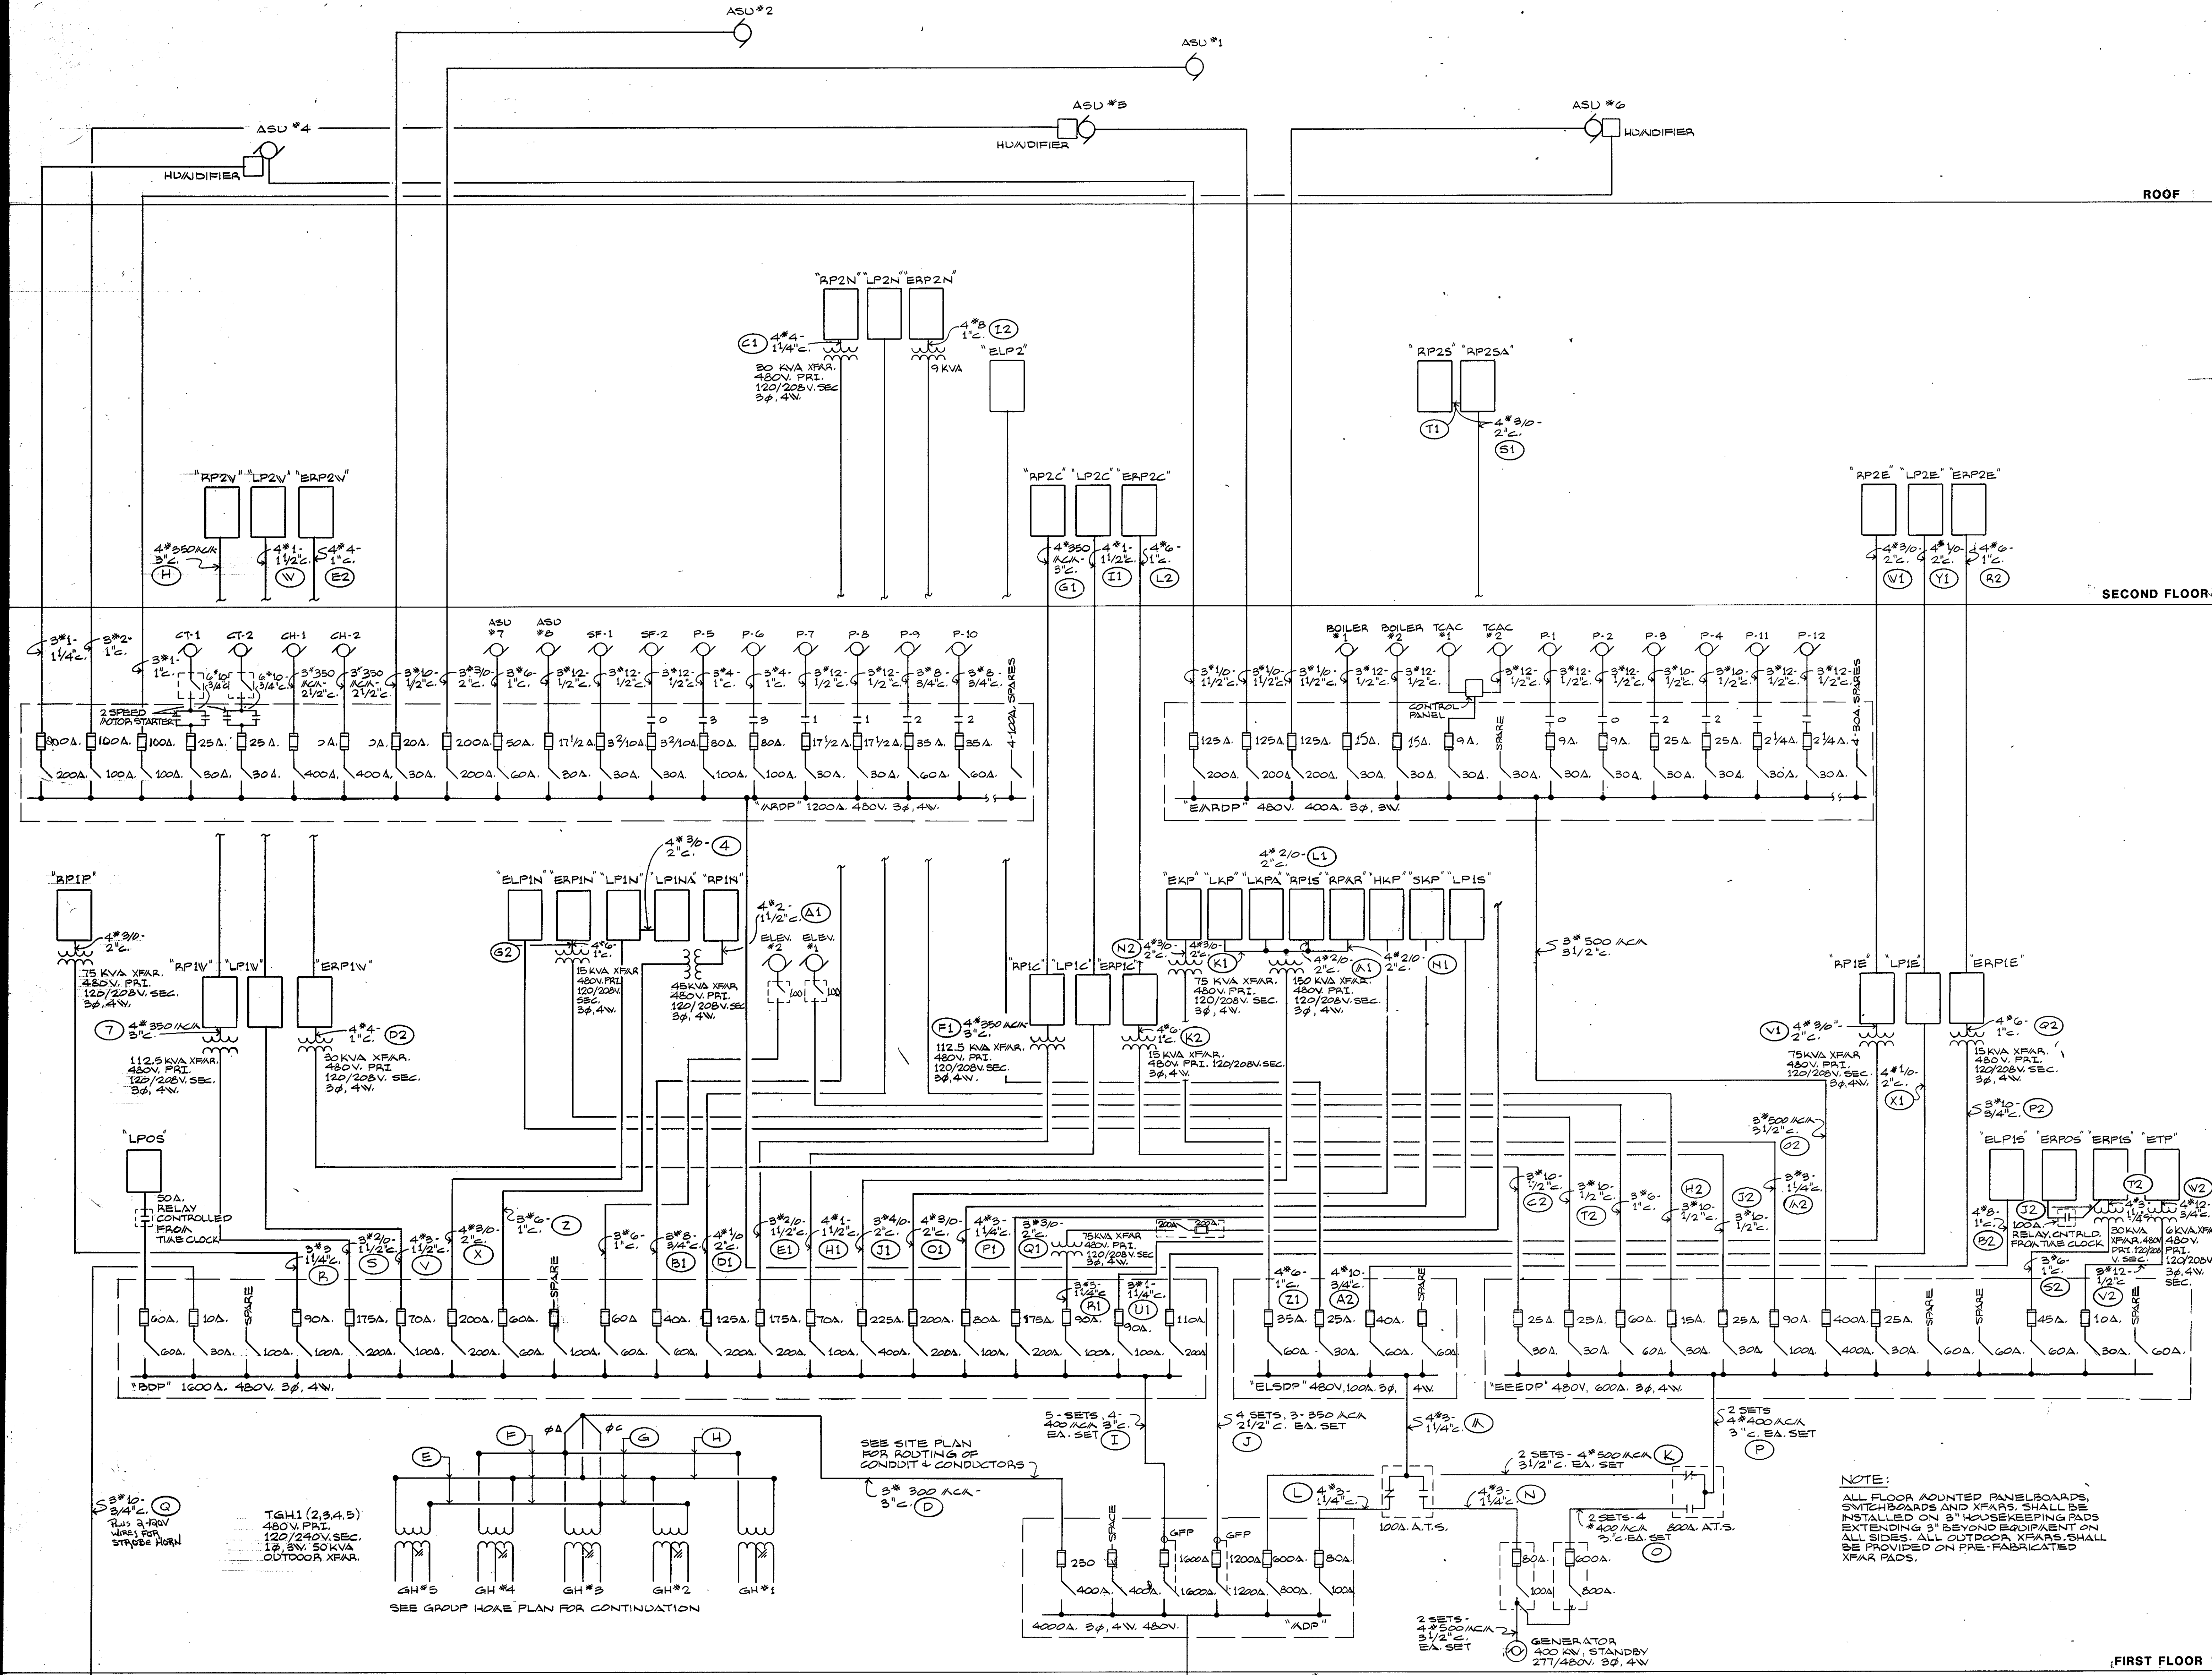

- ELECTRICAL SYMBOLS**
- FLOURESCENT FIXTURE
  - STRIP FLOURESCENT FIXTURE
  - FLOURESCENT FIXTURE ON EMERGENCY POWER
  - INCANDESCENT OR H.L.D. FIXTURE
  - INCANDESCENT FIXTURE ON EMERGENCY
  - EXIT LIGHT, W/DIRECTIONAL ARROWS
  - EMERGENCY LIGHTING UNIT, BATTERY OPERATED, TWO HEAD
- SUBSCRIPTS:**
- S = CIRCUIT
  - A = FIXTURE TYPE
  - B = SWITCH
- PHOTO ELECTRIC RELAY - PER DEVICE DESIGNATION**
- DUPLEX RECEPTACLE (1Ø = ISOLATED GROUND)
  - DUPLEX RECEPTACLE ABOVE COUNTER
  - SPECIAL PURPOSE OUTLET (AS NOTE)
  - FLOOR RECEPTACLE
  - COMBINATION FLOOR RECEPTACLE AND TELEPHONE JACK
  - CLOCK OUTLET
  - SURFACE MOUNTED REWAYWAY WITH RECEPTABLES
- SINGLE POLE SWITCH**
- SUBSCRIPTS:**
- 3, 4 = 3 WAY, 4 WAY
  - A, B, C = SWITCH IDENTIFICATION
  - K, P = KEY OPERATED, PILOT LIGHT
  - Q, I = DIMMER SWITCH, INTENSITY CONTROL FOR SURGICAL LIGHT
  - M = MANUAL MOTOR STARTER
  - JUNCTION BOX
- MOTOR W/IDENTIFYING DESIGNATION**
- COMBINATION MOTOR STARTER
  - MAGNETIC MOTOR STARTER
  - DISCONNECT
  - TEMPERATURE SENSOR
  - TRANSFORMER
  - COMBINATION AUDIOIBLE VISUAL DEVICE
  - BUZZER
  - FIRE ALARM STATION (MANUAL)
  - HEAT DETECTOR
  - SMOKE DETECTOR
  - WATER FLOW SWITCH
  - SMOKE DAMPER
  - TAMPER SWITCH
- MAGNETIC DOOR HOLDER**
- FIRE ALARM CONTROL PANEL
  - BRANCH CIRCUIT PANELBOARD
  - DISTRIBUTION POWER PANEL
  - CONDUIT EXPOSED
  - CONDUIT CONCEALED IN FLOOR
  - CONDUIT CONCEALED IN CEILING OR WALL
  - CONDUIT UP
  - CONDUIT DOWN
  - TERMINATED
  - CAPPED
  - HOME RUN: PANEL - LPT CIRCUITS - 1, 3 WIRES (L TO R) 1-GREEN GROUND, 1-NEUTRAL, 2-HOT
  - NON-METALLIC SHEATHED CABLE W/ES (L TO R) 1-GROUND, 1-HOT, 2-NEUTRAL
  - NURSE CALL MASTER STATION
  - NURSE CALL EMERGENCY STATION (TOILET, BATH)
  - NURSE CALL DOME LIGHT (NUMERAL INDICATES NO. OF LIGHTS)
  - TELEPHONE CONDUIT
  - TELEPHONE OUTLET (P = PUBLIC)
  - TELEPHONE OUTLET (N = MALL)
  - NO SUBSCRIPT INDICATES DESK TYPE
  - STUBS 9/4" ABOVE DROPPED CEILING
  - INFRARED HEAT SENSOR
  - INFRARED HEAT SENSOR CONTROL UNIT
- ABBREVIATIONS**
- S. SAFETY SWITCH
  - A.F.S. ABOVE FINISHED
  - ENC. ELECTRICAL
  - PH. EMERGENCY
  - 7'-0", 4'-6" INDICATES MOUNTING OTHER THAN THOSE CALLED FOR IN SPECIFICATIONS
  - N.T.S. NOT TO SCALE
  - W.P. WEATHER PROOF
  - E.C. EMPTY CONDUIT
  - P.H. PANEL
  - I.C. UNDER COUNTER
  - ATS. AUTOMATIC TRANSFER SWITCH

**NOTE:**  
ALL FLOOR MOUNTED PANELBOARDS, SWITCHBOARDS AND XFARS, SHALL BE INSTALLED ON 3" HOUSEKEEPING PADS EXTENDING 3" BEYOND EQUIPMENT ON ALL SIDES. ALL OUTDOOR XFARS SHALL BE PROVIDED ON FAE-FABRICATED XFAR PADS.

# APPENDIX A

This record drawing has been prepared in part, by Colton/Lester Corporation, based upon information furnished by others. While this information is believed to be accurate, and thus is not responsible for the accuracy of this record drawing or for any errors or omissions which may have been incorporated into it as a result. Those relying on this record document are advised to obtain independent verification of its accuracy before applying it for any purpose.

**DRAWING TITLE:**  
ONE - LINE DIAGRAM & SYMBOLS

**SCALE:**

**REVISIONS:**

**RECORD DRAWING**

FOR REFERENCE ONLY

THE CHRISNER PARTNERSHIP NC ARCHITECTS AND PLANNERS 20 SOUTH HANLEY RD - CLAYTON, MISSOURI 63105 314-725-2927 11 VICTORY WAY - CARLE, COLORADO 80525 303-824-9707

MICHAEL R. KRUEGER REGISTERED PROFESSIONAL ENGINEER LICENSE NUMBER E-18502

**SHEET NUMBER:**  
E1


**PROJECT NUMBER:**  
83013

**ISSUE DATE:**  
6-27-85

This record drawing has been prepared in part, by Colton/Lester Corporation, based upon information furnished by others. While this information is believed to be reliable, the Engineer cannot assure its accuracy, and thus is not responsible for the accuracy of this record drawing or for any errors or omissions which may have been incorporated into it as a result. Those relying on this record document are advised to obtain independent verification of its accuracy before applying it for any purpose.

**ROOM SCHEDULE**

<b>PUBLIC</b>	
1000	MAIN ENTRY VESTIBULE
1001	LOBBY
1002	RECEPTIONIST
1003	TELEPHONE
1004	CORRIDOR
1005	PUBLIC MALE TOILET
1006	PUBLIC FEMALE TOILET
1007	JANITORS CLOSET
<b>OUTPATIENT</b>	
1008	VESTIBULE
1009	WAITING
1010	RECEPTIONIST
1011	RECORD STORAGE
1012	OFFICE WORK AREA
1013	PASSAGE
1014	NURSE TREATMENT/OFFICE
1015	SOCIAL WORKERS OFFICE
1016	PSYCHIATRIST OFFICE
1017	UNIT DIRECTORS OFFICE
1018	PSYCHIATRY
1019	PSYCHOLOGIST OFFICE
1020	THERAPY
1021	PSYCHOLOGIST OFFICE
1022	PSYCHOLOGY TESTING
1023	BIOFEEDBACK/EXAM
1024	CONSULTANT OFFICE
1025	STORAGE
1026	CONFERENCE ROOM
1027	PASSAGE
<b>COMMUNICATIONS</b>	
1028	MAIL ROOM
1029	STORAGE CLOSET
<b>CIRCULATION</b>	
1029	STAFF MALE TOILET
1030	STAFF FEMALE TOILET
1031	CORRIDOR
1032	PASSAGE
1033	VESTIBULE
<b>ADMITTING</b>	
1033	WAITING
1034	RECEPTIONIST
1035	ADMITTING CLERK
1036	ADMITTING CLERK
1037	PASSAGE
1038	ADMITTING CLERK
<b>CIRCULATION</b>	
1039	JANITORS CLOSET
1040	WORK ROOM
1041	EXAM/TREATMENT
1042	ADMITTING CLERK
1043	ELECTRICAL CLOSET
<b>ADMITTING/ACCOUNTING</b>	
1044	TOILET
1045	RESOURCE INVESTIGATOR
1046	SECRETARY
1047	RESOURCE INVESTIGATOR
1048	RESOURCE INVESTIGATOR
<b>PATIENT ACTIVITY</b>	
1049	STORAGE
1050	PT/ACTIVITY/TREATMENT EQUIP. STOR.
1051	EQUIP./CHAIR STORAGE
1052	ACTIVITY THERAPY OFFICE
<b>CIRCULATION</b>	
1053	ELEV. EQUIPMENT ROOM
1054	STAIR NO. 2
<b>PATIENT ACTIVITY</b>	
1057	CYANASUM
1058	CORRIDOR
1059	PATIENT FEMALE ACTIVITY TOILET
1060	SHOWERS/LOCKERS
1061	PASSAGE
1062	WASHROOM
1063	SHOWERS/LOCKERS
1064	PATIENT MALE ACTIVITY TOILET
1065	CORRIDOR
1066	POOL
1067	POOL EQUIPMENT
<b>CIRCULATION</b>	
1067	VESTIBULE
1068	STAIR NO. 3
1069	CORRIDOR
<b>NURSING - ACUTE SECURED</b>	
1070	SOCIAL WORKERS OFFICE
1071	PSYCHIATRIST OFFICE
1072	PSYCHOLOGIST OFFICE
1073	STAFF LOCKERS
1074	STAFF FEMALE TOILET
1075	STAFF MALE TOILET
1076	STAFF LOUNGE
<b>CIRCULATION</b>	
1078	ELEVATOR LOBBY
<b>NURSING - ACUTE SECURED</b>	
1145	CONFERENCE
1146	CONFERENCING ROOM
1147	ELECTRICAL CLOSET

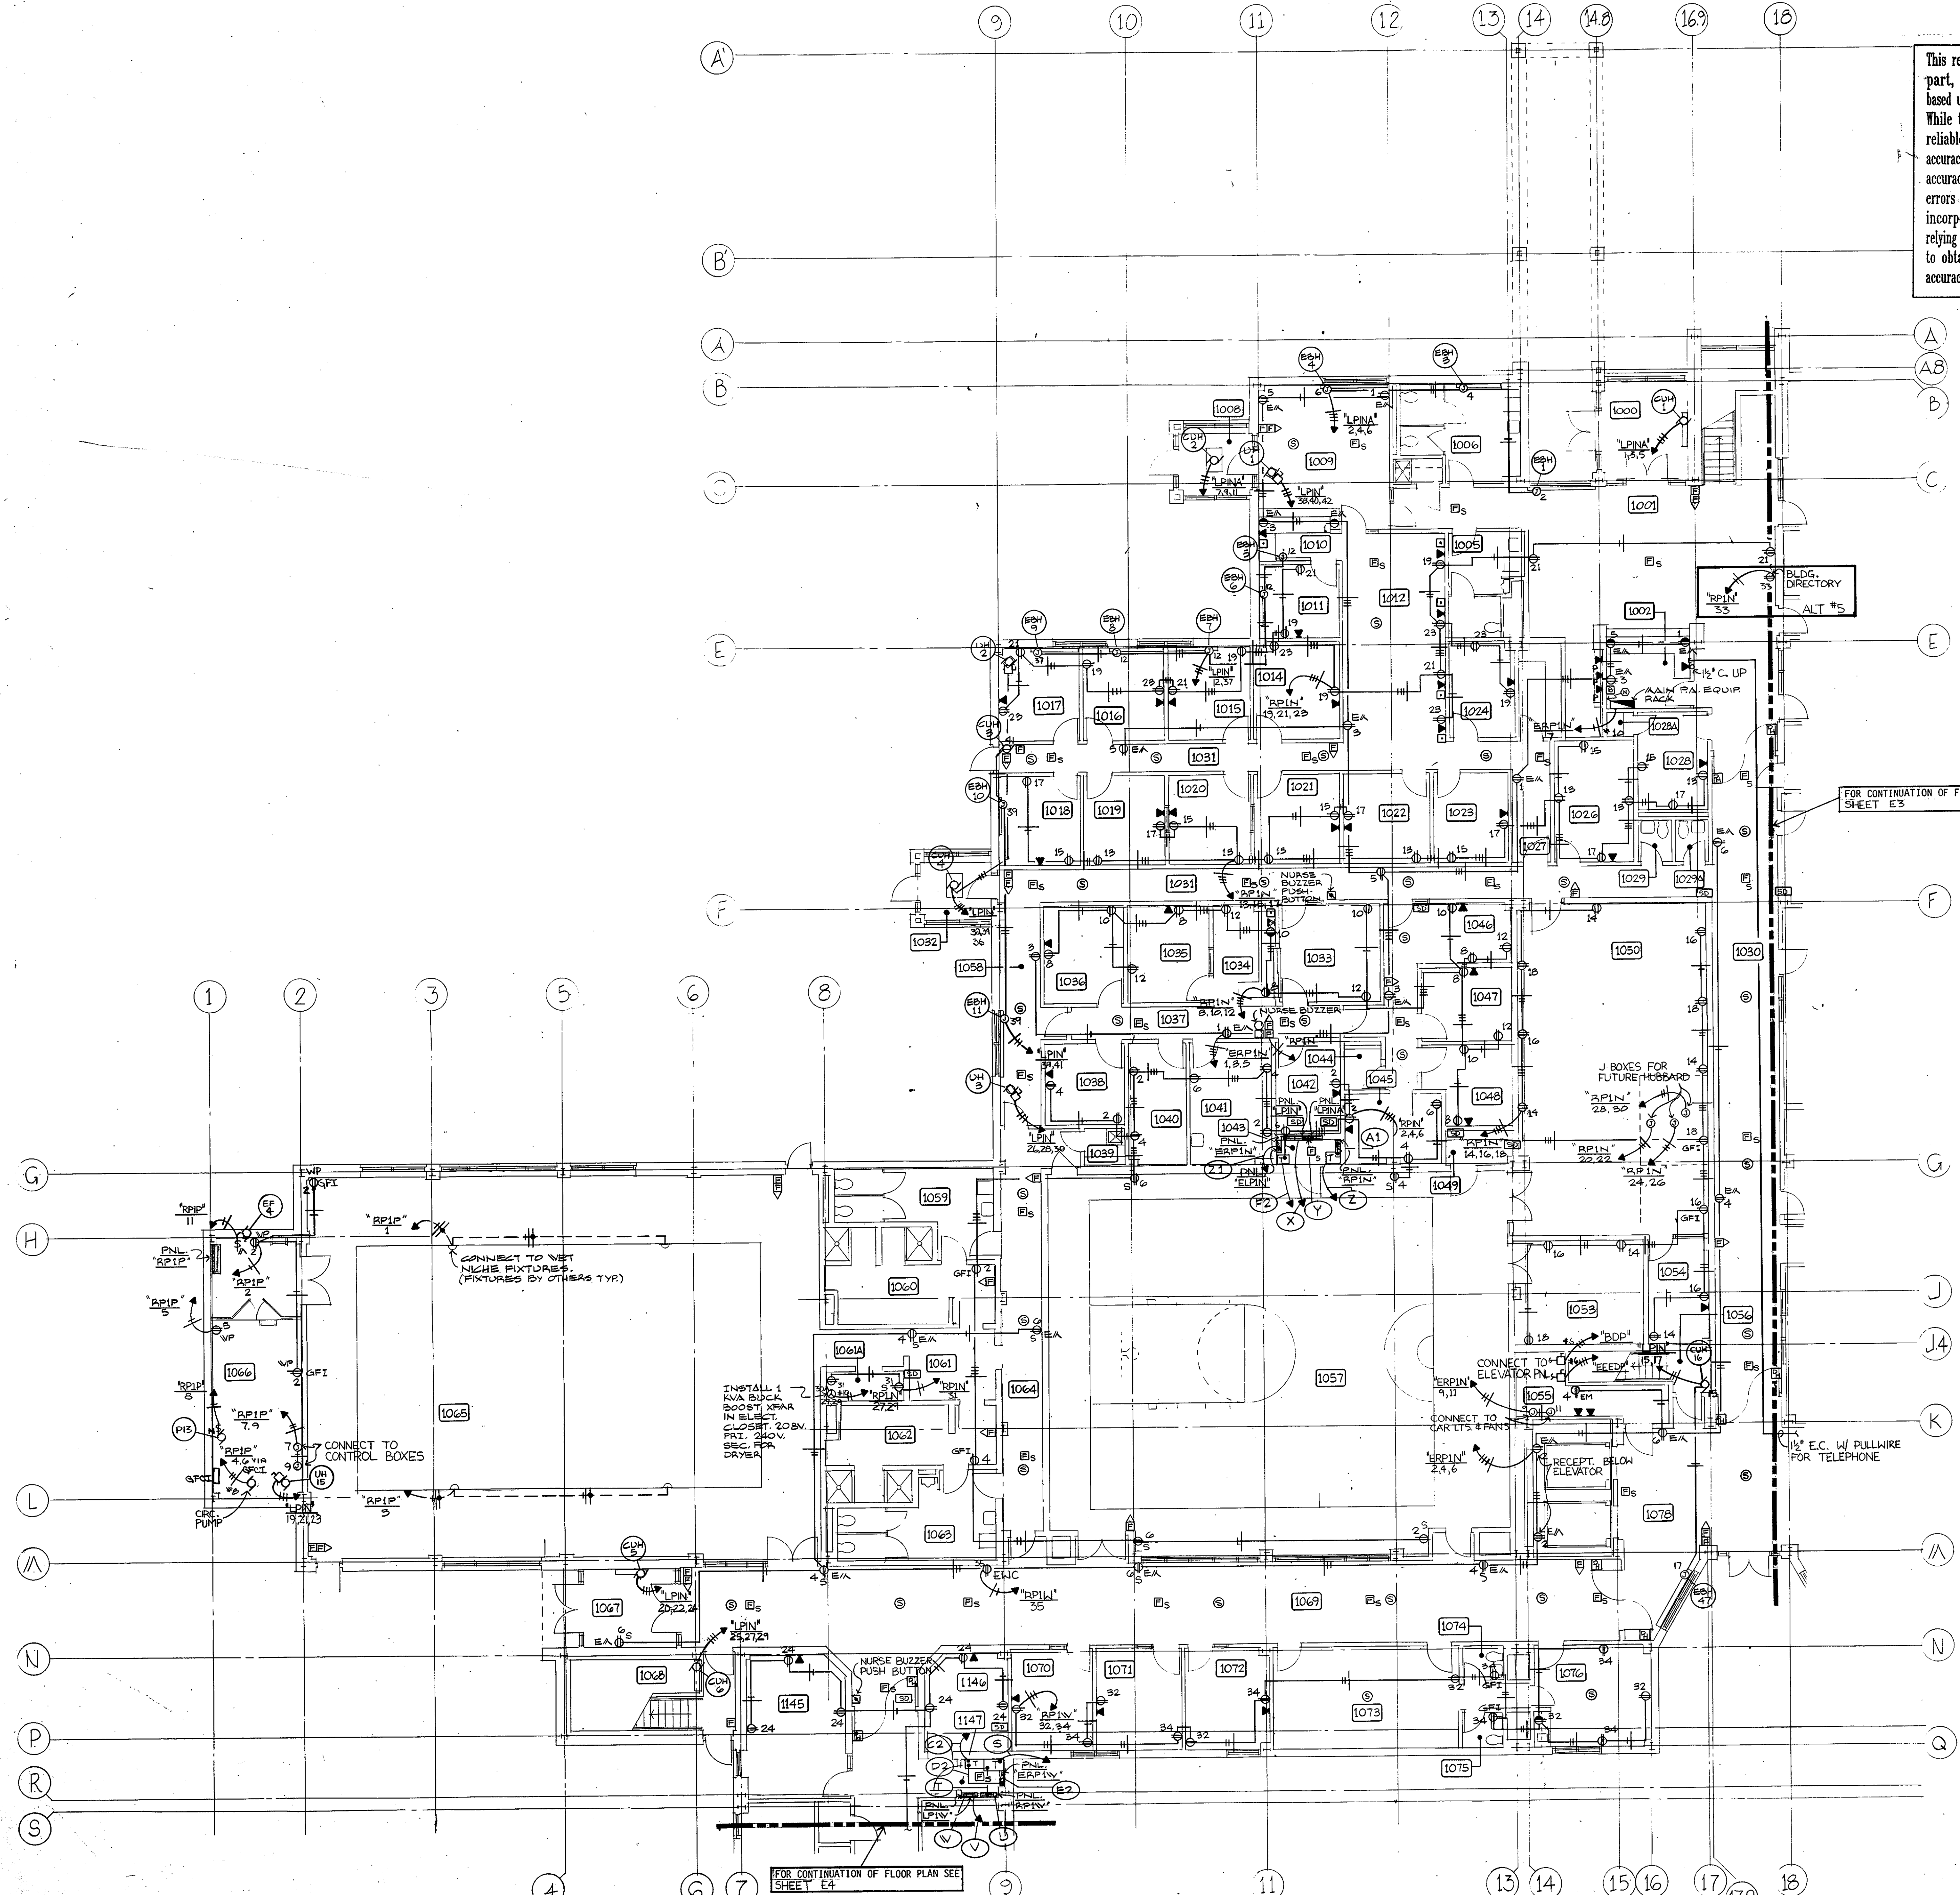


FOR CONTINUATION OF FLOOR PLAN SEE SHEET E3

FOR CONTINUATION OF FLOOR PLAN SEE SHEET E4

**NOTES**

- SEE SHEET E1 FOR ONE-LINE DIAGRAM AND SYMBOLS.
- SEE SHEET E-23 FOR MOTOR CONTROL DIAGRAMS AND SCHEDULES.
- SEE SHEET E-22 FOR MISC. DIAGRAMS.

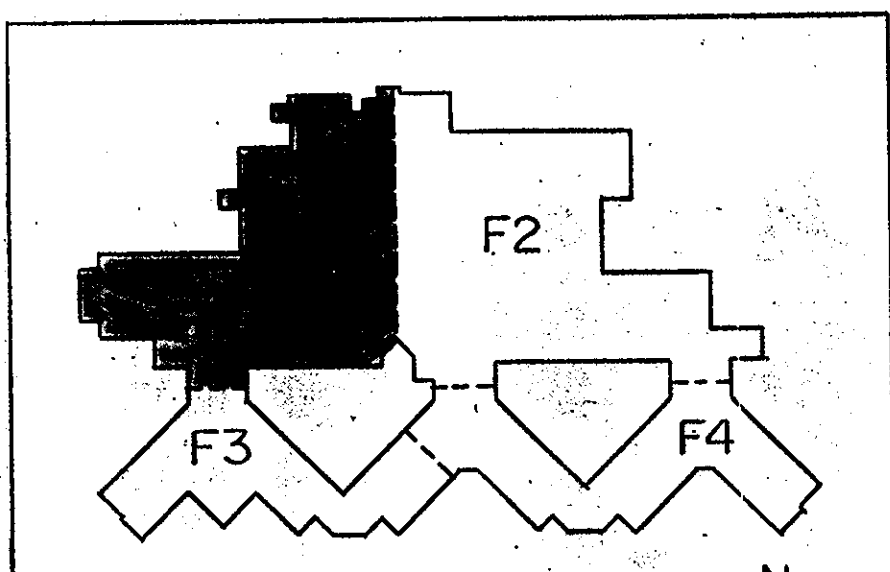

**DRAWING TITLE:**  
PARTIAL FIRST FLOOR  
POWER - AREA F1

**SCALE:** 1/8" = 1'0"

**REVISIONS:**

**RECORD DRAWING**



FOR REFERENCE ONLY

SHEET NUMBER:  
**E2**

PROJECT NUMBER:  
83013


ISSUE DATE:  
6-27-85

THE CHRISTNER PARTNERSHIP INC. ARCHITECTS AND PLANNERS, 20 SOUTH HANLEY RD., CLAYTON, MISSOURI 63105 314-725-2927 - 11 W. VICTORY WAY - CRAIG, COLORADO 80625 303-824-9707

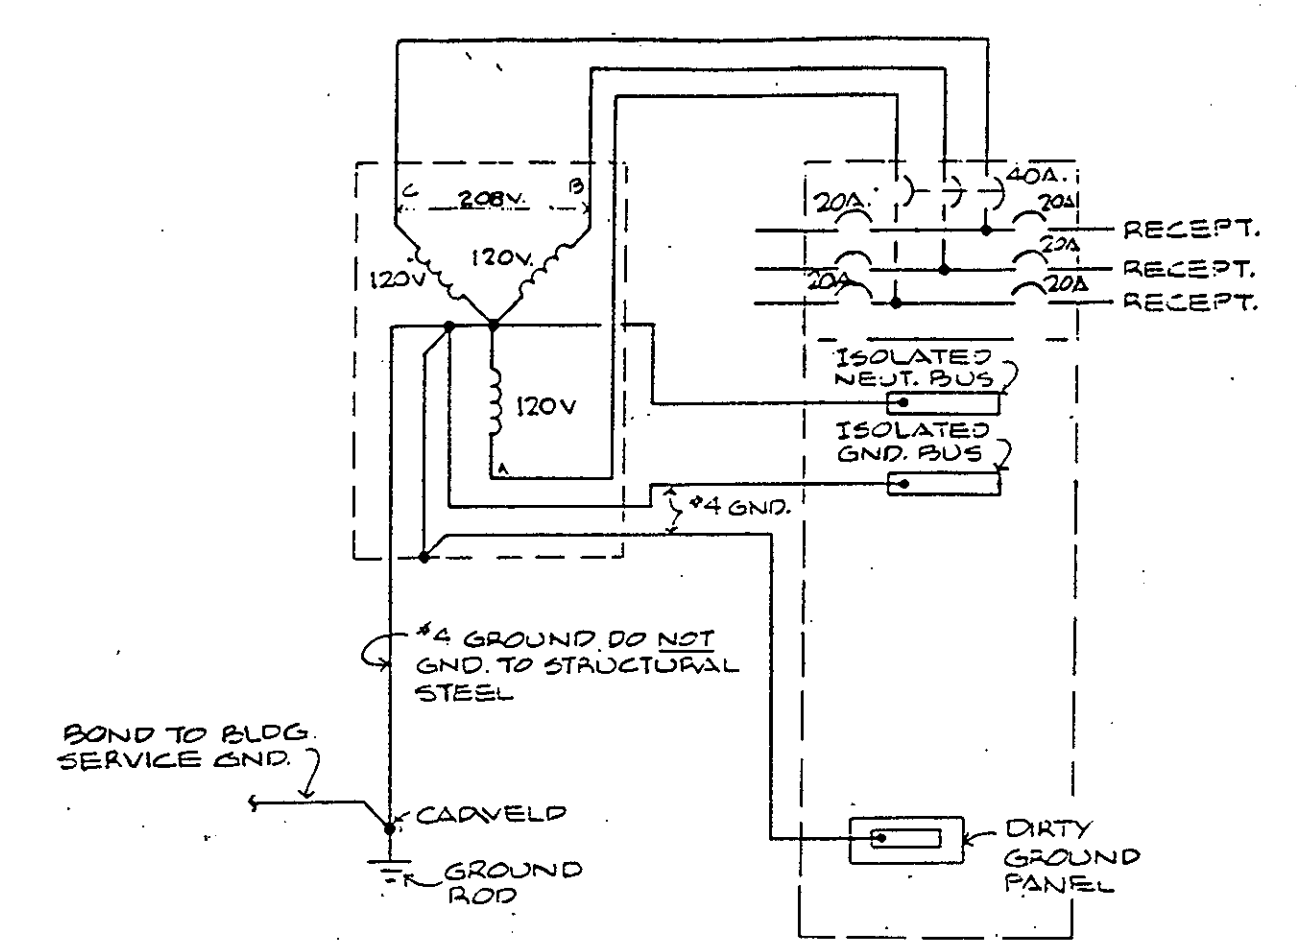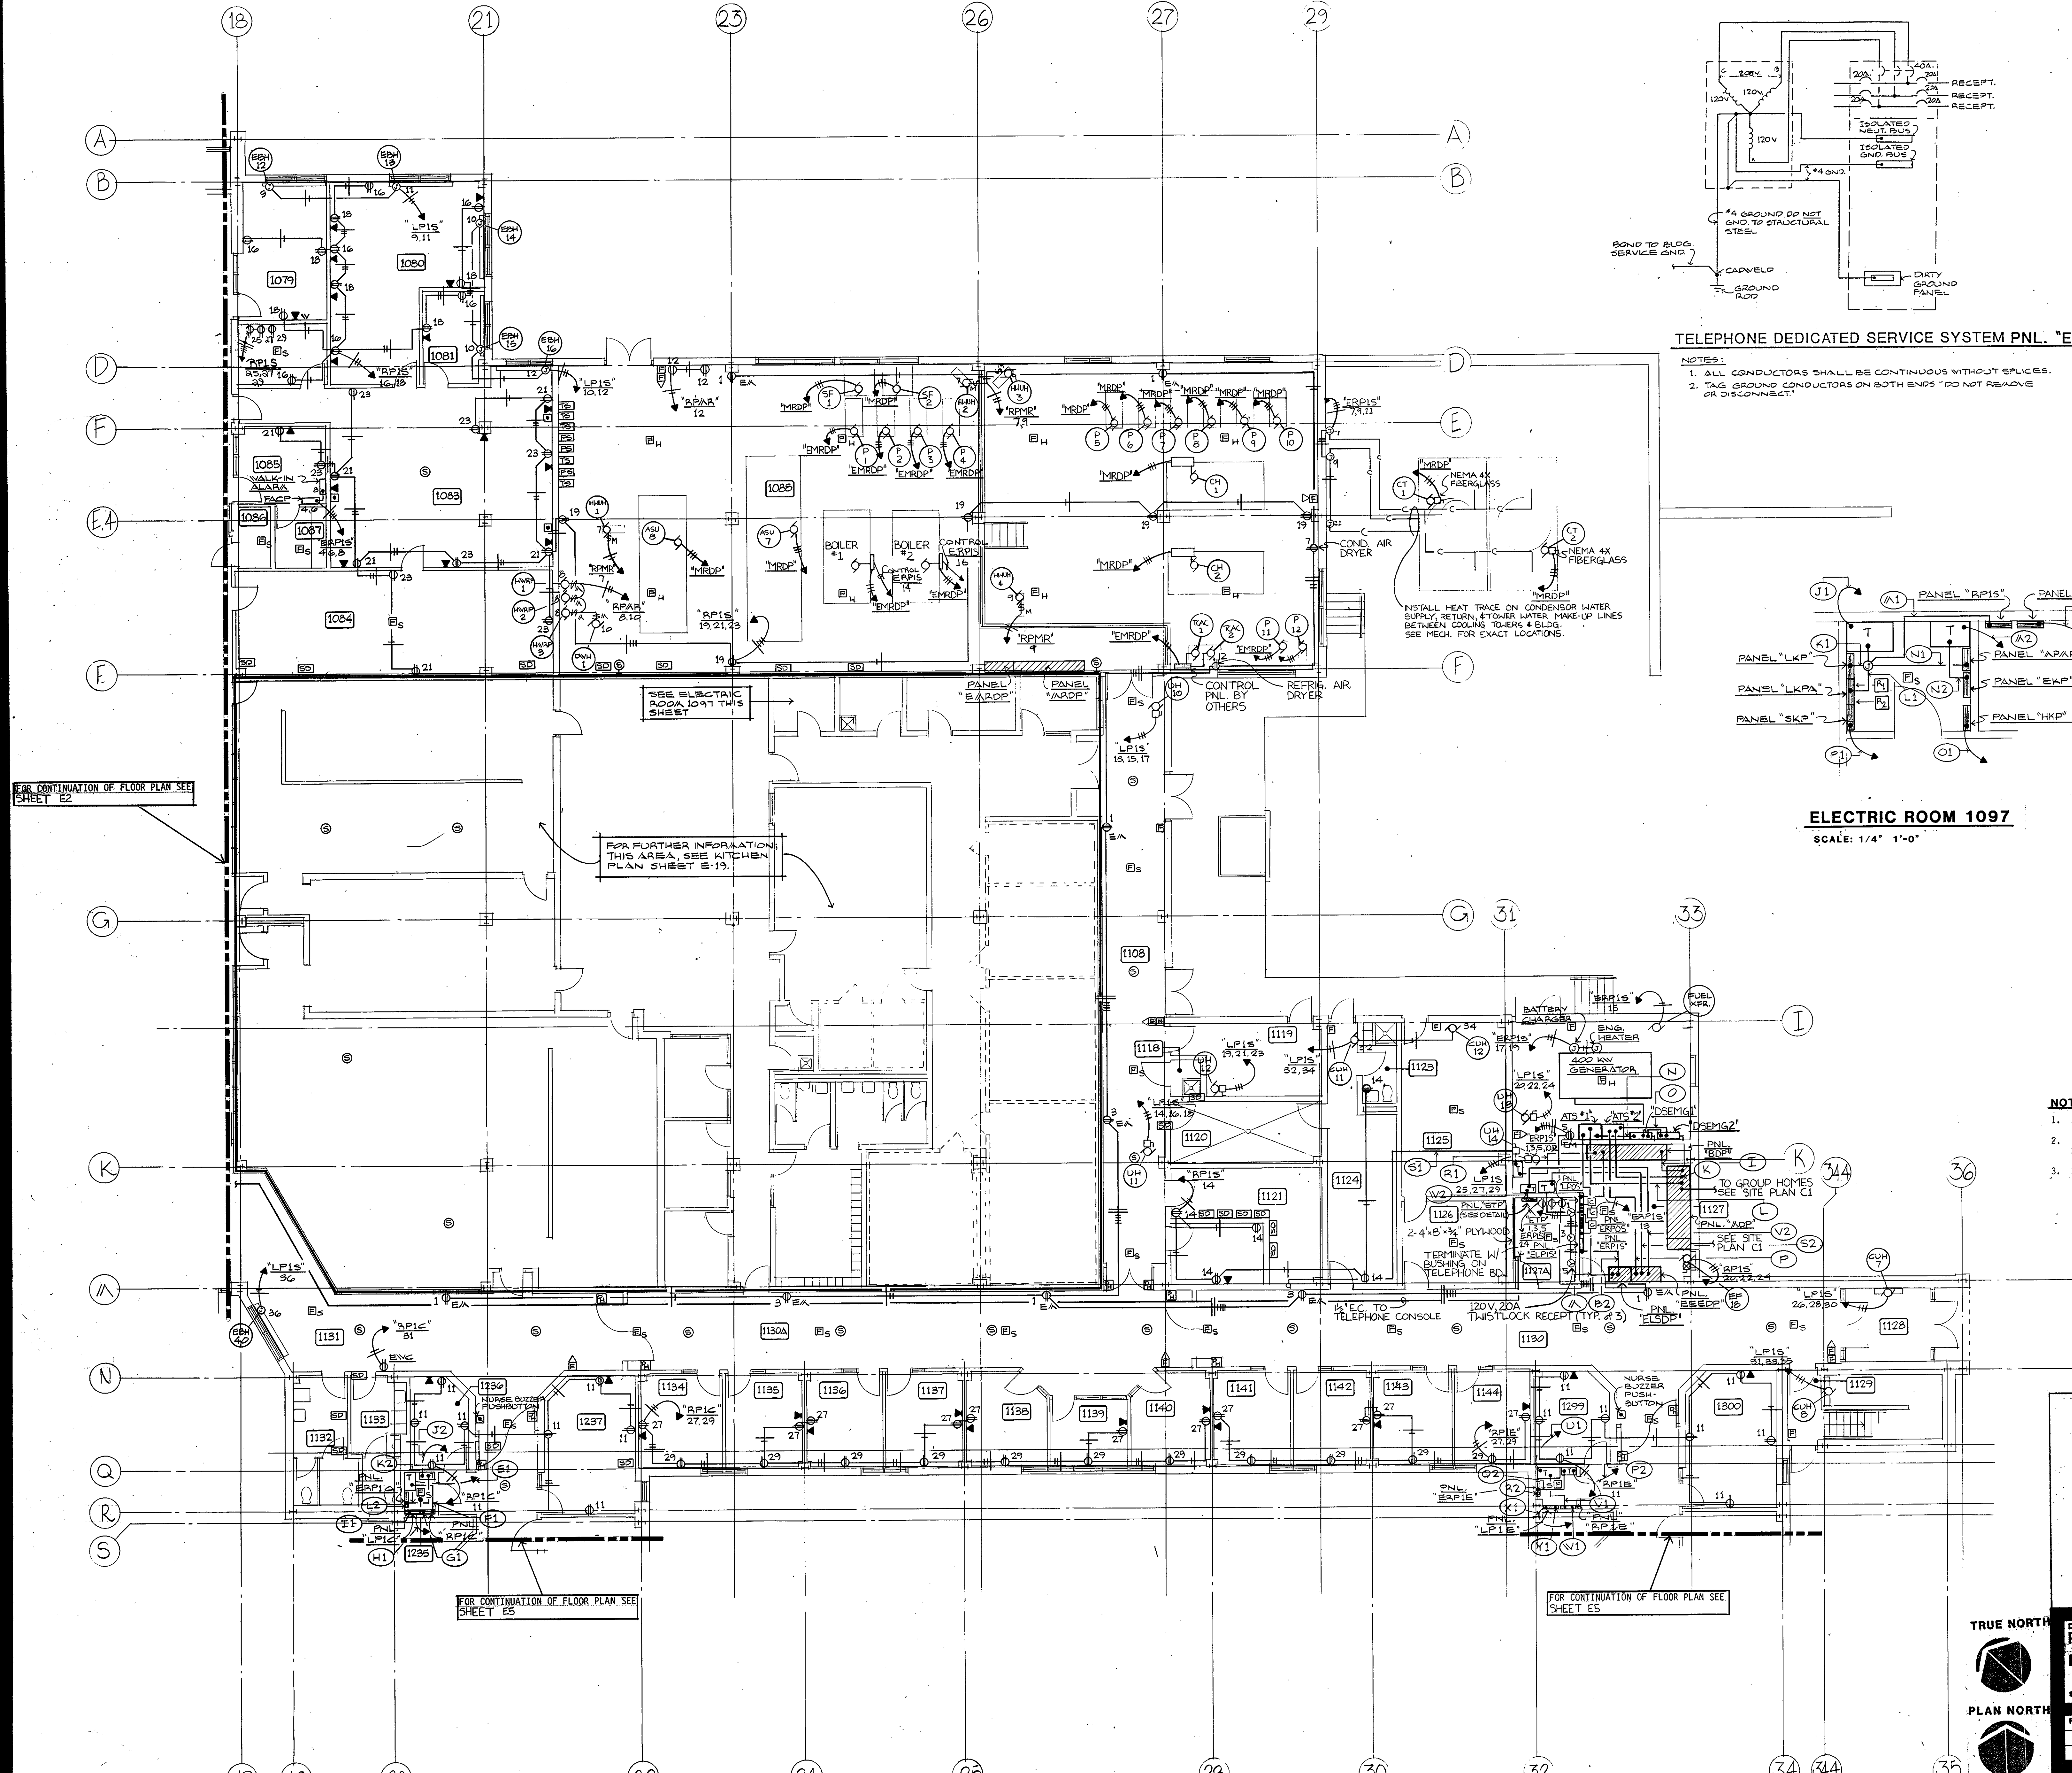

TELEPHONE DEDICATED SERVICE SYSTEM PNL. "ETP"

- NOTES:
1. ALL CONDUCTORS SHALL BE CONTINUOUS WITHOUT SPLICES.
  2. TAG GROUND CONDUCTORS ON BOTH ENDS "DO NOT REMOVE OR DISCONNECT."

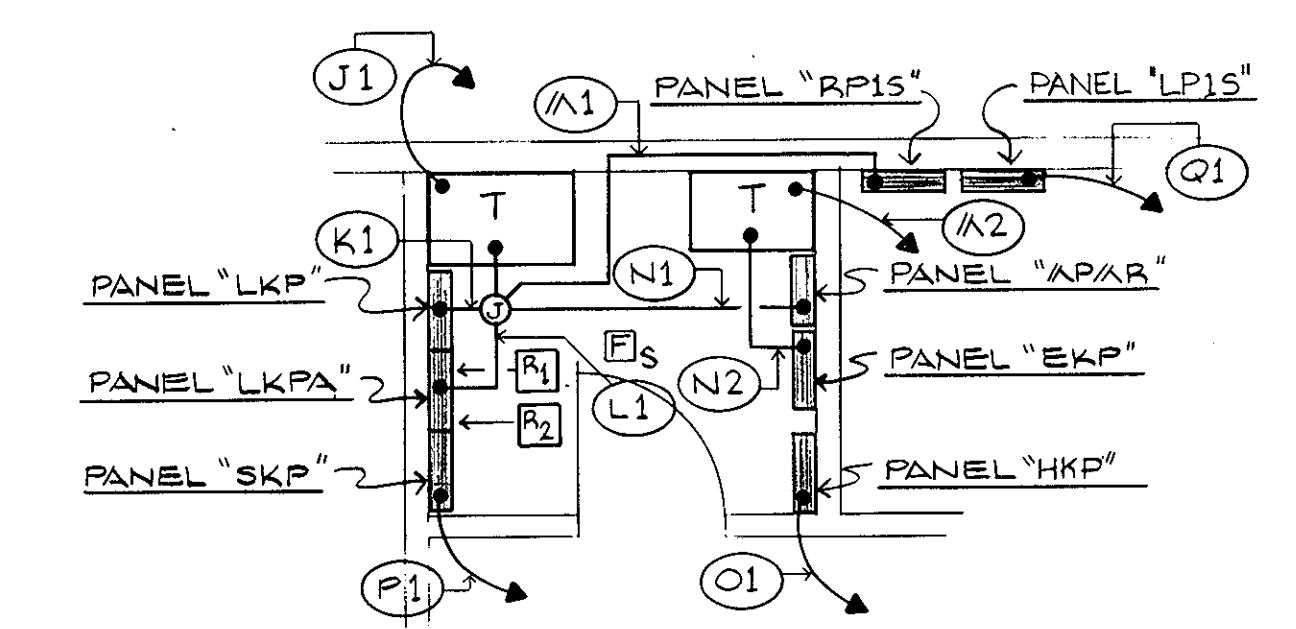


ELECTRIC ROOM 1097  
SCALE: 1/4" = 1'-0"

**ROOM SCHEDULE**

1079	GIFT SHOP
1080	OPEN WORK AREA
1081	DIRECTORS OFFICE
1082	TRAIN EQUIP. ROOM
1083	OPEN WORK AREA
1084	RECORD STORAGE
1085	SECURITY OFFICE
1086	ELECTRICAL CLOSET
1087	STORAGE
1088	BUILDING SUPPORT
1089	MECHANICAL ROOM
1090	HOUSEKEEPING
1121	SUPPLIES/STORAGE
1122	CUSTOMER SUPERVISORS OFFICE
1123	TOILET/SHOWER
1124	SOLED LINE
1125	BULK LINEN/CART MAKE-UP
1126	EXCHANGE CART HOLDING
1127	BUILDING SUPPORT
1128	ELECTRICAL ROOM
1129	VESTIBULE
1130	STAIR NO. 4
1131	CORRIDOR
1132	CORRIDOR
1133	CORRIDOR
1134	PATIENT SUPPORT
1135	PATIENT FEMALE TOILET
1136	PATIENT MALE TOILET
1137	NURSING: INTERMEDIATE SHARED OFFICE
1138	SOCIAL WORKERS OFFICE
1139	PSYCHIATRIST OFFICE
1140	PSYCHOLOGIST OFFICE
1141	ACTIVITY THERAPY SUPERVISORS OFFICE
1142	UNIT DIRECTORS OFFICE
1143	SECRETARY
1144	ACTIVITY SUPERVISORS OFFICE
1145	SOCIAL WORKERS SUPERVISORS OFFICE
1146	PSYCHOLOGIST OFFICE
1147	PSYCHIATRIST OFFICE
1148	SOCIAL WORKERS OFFICE
1149	NURSING: INTERMEDIATE
1231	ELECTRICAL CLOSET
1232	COUNSELING ROOM
1233	CONFERENCE ROOM
1234	ELECTRICAL CLOSET
1235	COUNSELING ROOM
1236	CONFERENCE ROOM

This record drawing has been prepared in part, by Colton/Lester Corporation, based upon information furnished by others. While this information is believed to be reliable, the Engineer cannot assure its accuracy, and thus is not responsible for any errors or omissions which may have been incorporated into it as a result. Those relying on this record document are advised to obtain independent verification of its accuracy before applying it for any purpose.

- NOTES:
1. SEE SHEET E1 FOR ONE-LINE DIAGRAM AND SYMBOLS.
  2. SEE SHEET E-23 FOR MOTOR CONTROL DIAGRAMS AND SCHEDULES.
  3. SEE SHEET E-22 FOR MISC. DIAGRAMS.

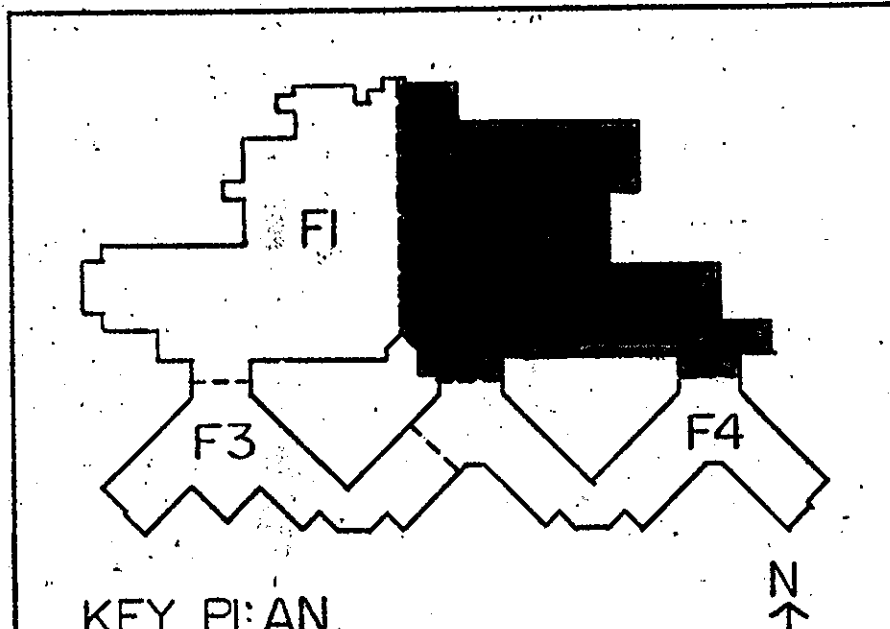

TRUE NORTH

PLAN NORTH

DRAWING TITLE:  
**PARTIAL FIRST FLOOR  
POWER - AREA F2**

SCALE: 1/8" = 1'-0"

REVISIONS:


**RECORD DRAWING**


FOR REFERENCE ONLY

SHEET NUMBER:  
**E3**

PROJECT NUMBER:  
83013

ISSUE DATE:  
6-27-85

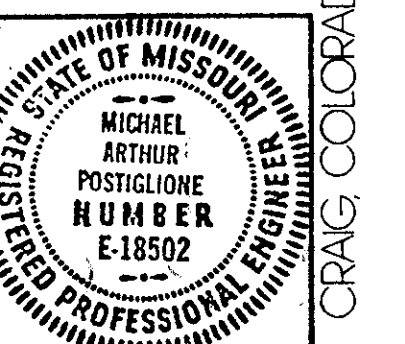

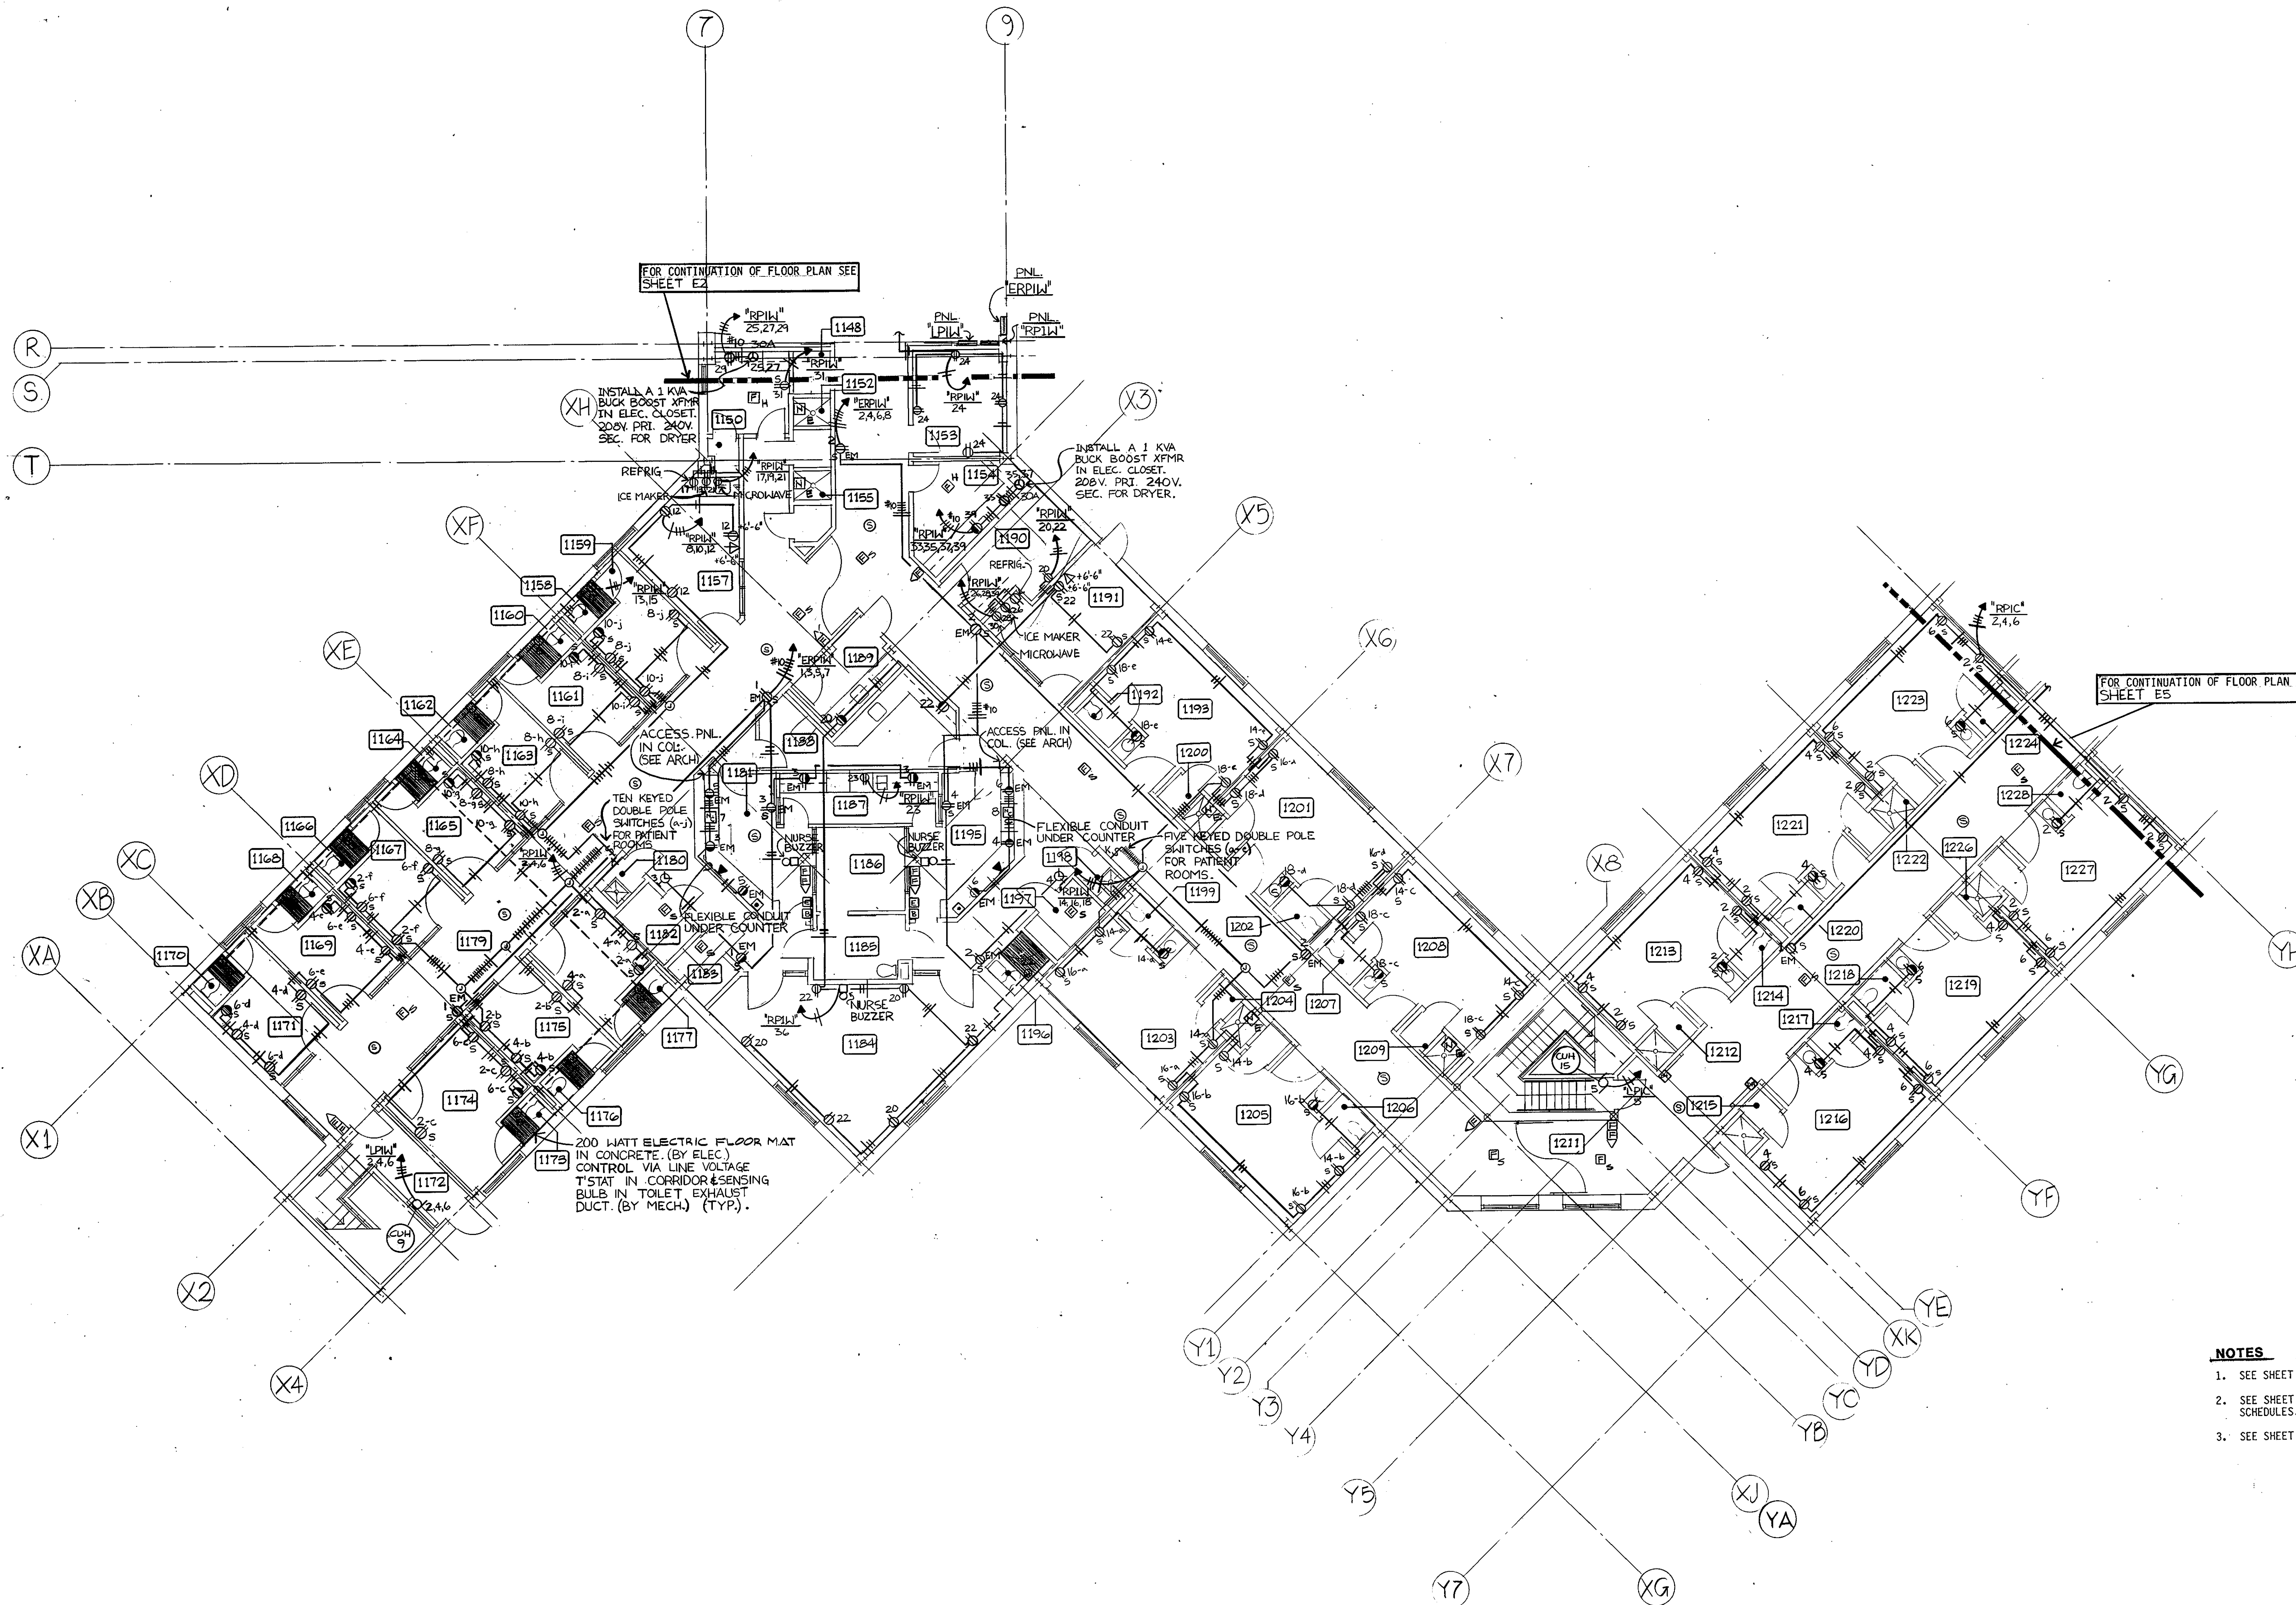

**ROOM SCHEDULE**

**NURSING - ACUTE SECURED**


1148	TRASH ROOM
1149	CORRIDOR
1150	LAUNDRY
1151	STORAGE
1152	SHOWER ROOM
1153	ESSENTIAL TREATMENT ROOM
1154	LAUNDRY
1155	SHOWER ROOM
1156	PASSAGE
1157	T.V. LOUNGE
1158	PATIENT TOILET
1159	PATIENT BEDROOM (1 BED)
1160	PATIENT TOILET
1161	PATIENT BEDROOM (1 BED)
1162	PATIENT TOILET
1163	PATIENT BEDROOM (1 BED)
1164	PATIENT TOILET
1165	PATIENT BEDROOM (1 BED)
1166	PATIENT TOILET
1167	PATIENT BEDROOM (1 BED)
1168	PATIENT TOILET
1169	PATIENT BEDROOM (1 BED)
1170	PATIENT TOILET
1171	PATIENT BEDROOM (1 BED)
1172	PATIENT TOILET
1173	PATIENT BEDROOM (1 BED)
1174	PATIENT TOILET
1175	PATIENT BEDROOM (1 BED)
1176	PATIENT TOILET
1177	PATIENT BEDROOM (1 BED)
1178	PATIENT TOILET
1179	PATIENT BEDROOM (1 BED)
1180	CORRIDOR
1181	SHOWER ROOM
1182	NURSES STATION
1183	LINE
1184	STORAGE
1185	ACTIVITY ROOM
1186	TOILET/ANTE ROOM
1187	SICKLEIN ROOM
1188	MEDICATION PREPARATION
1189	SOLID UTILITY
1190	CLEAN UTILITY
1191	TUB ROOM
1192	T.V. LOUNGE
1193	PATIENT BEDROOM (2 BED)
1194	CORRIDOR
1195	NURSES STATION
1196	TOILET
1197	LINE
1198	PATIENT TOILET
1199	SHOWER ROOM
1200	PATIENT BEDROOM (2 BED)
1201	PATIENT TOILET
1202	PATIENT BEDROOM (2 BED)
1203	SHOWER ROOM
1204	PATIENT BEDROOM (2 BED)
1205	PATIENT TOILET
1206	PATIENT BEDROOM (2 BED)
1207	PATIENT TOILET
1208	PATIENT BEDROOM (2 BED)
1209	SHOWER ROOM
1210	STAIR NO. 4
1211	VESTIBULE

**NURSING - INTERMEDIATE**

1212	SHOWER ROOM
1213	PATIENT BEDROOM (2 BED)
1214	PATIENT TOILET
1215	SHOWER ROOM
1216	PATIENT BEDROOM (2 BED)
1217	PATIENT TOILET
1218	SHOWER ROOM
1219	PATIENT BEDROOM (2 BED)
1220	PATIENT TOILET
1221	SHOWER ROOM
1222	PATIENT BEDROOM (2 BED)
1223	PATIENT TOILET
1224	SHOWER ROOM
1225	PATIENT BEDROOM (2 BED)
1226	PATIENT TOILET
1227	PATIENT BEDROOM (2 BED)

- NOTES**
- SEE SHEET E1 FOR ONE-LINE DIAGRAM AND SYMBOLS.
  - SEE SHEET E-23 FOR MOTOR CONTROL DIAGRAMS AND SCHEDULES.
  - SEE SHEET E-22 FOR MISC. DIAGRAMS.

This record drawing has been prepared in part, by Colton/Lester Corporation, based upon information furnished by others. While this information is believed to be reliable, the Engineer cannot assure its accuracy, and thus is not responsible for the accuracy of this record drawing or for any errors or omissions which may have been incorporated into it as a result. Those relying on this record document are advised to obtain independent verification of its accuracy before applying it for any purpose.

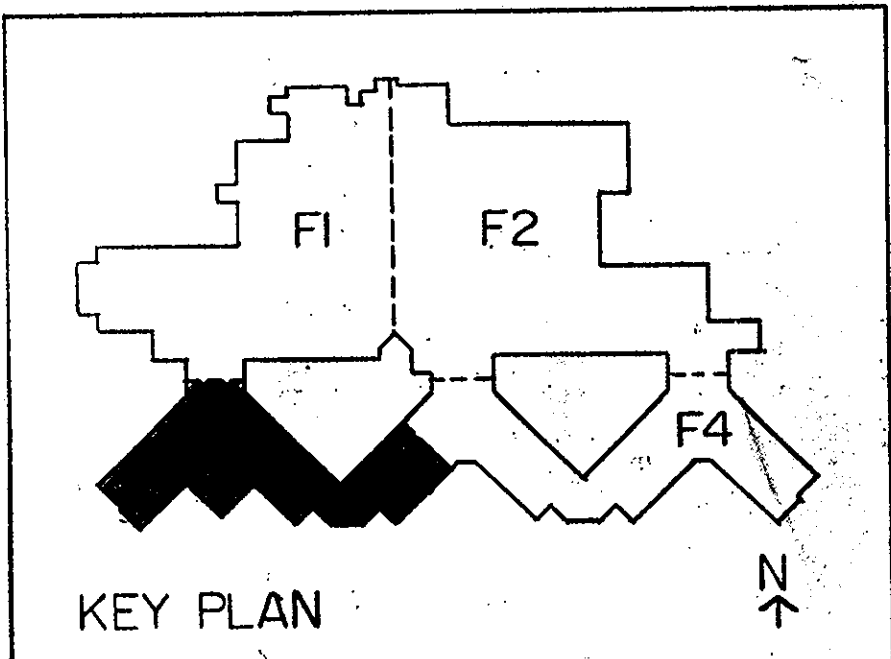

**DRAWING TITLE**  
**PARTIAL FIRST FLOOR**  
**POWER - AREA F3**

SCALE: 1/8" = 1'0"

**REVISIONS:**



**RECORD DRAWING**

FOR REFERENCE ONLY

SHEET NUMBER:  
**E4**

PROJECT NUMBER:  
 83013

ISSUE DATE:  
 6-27-85

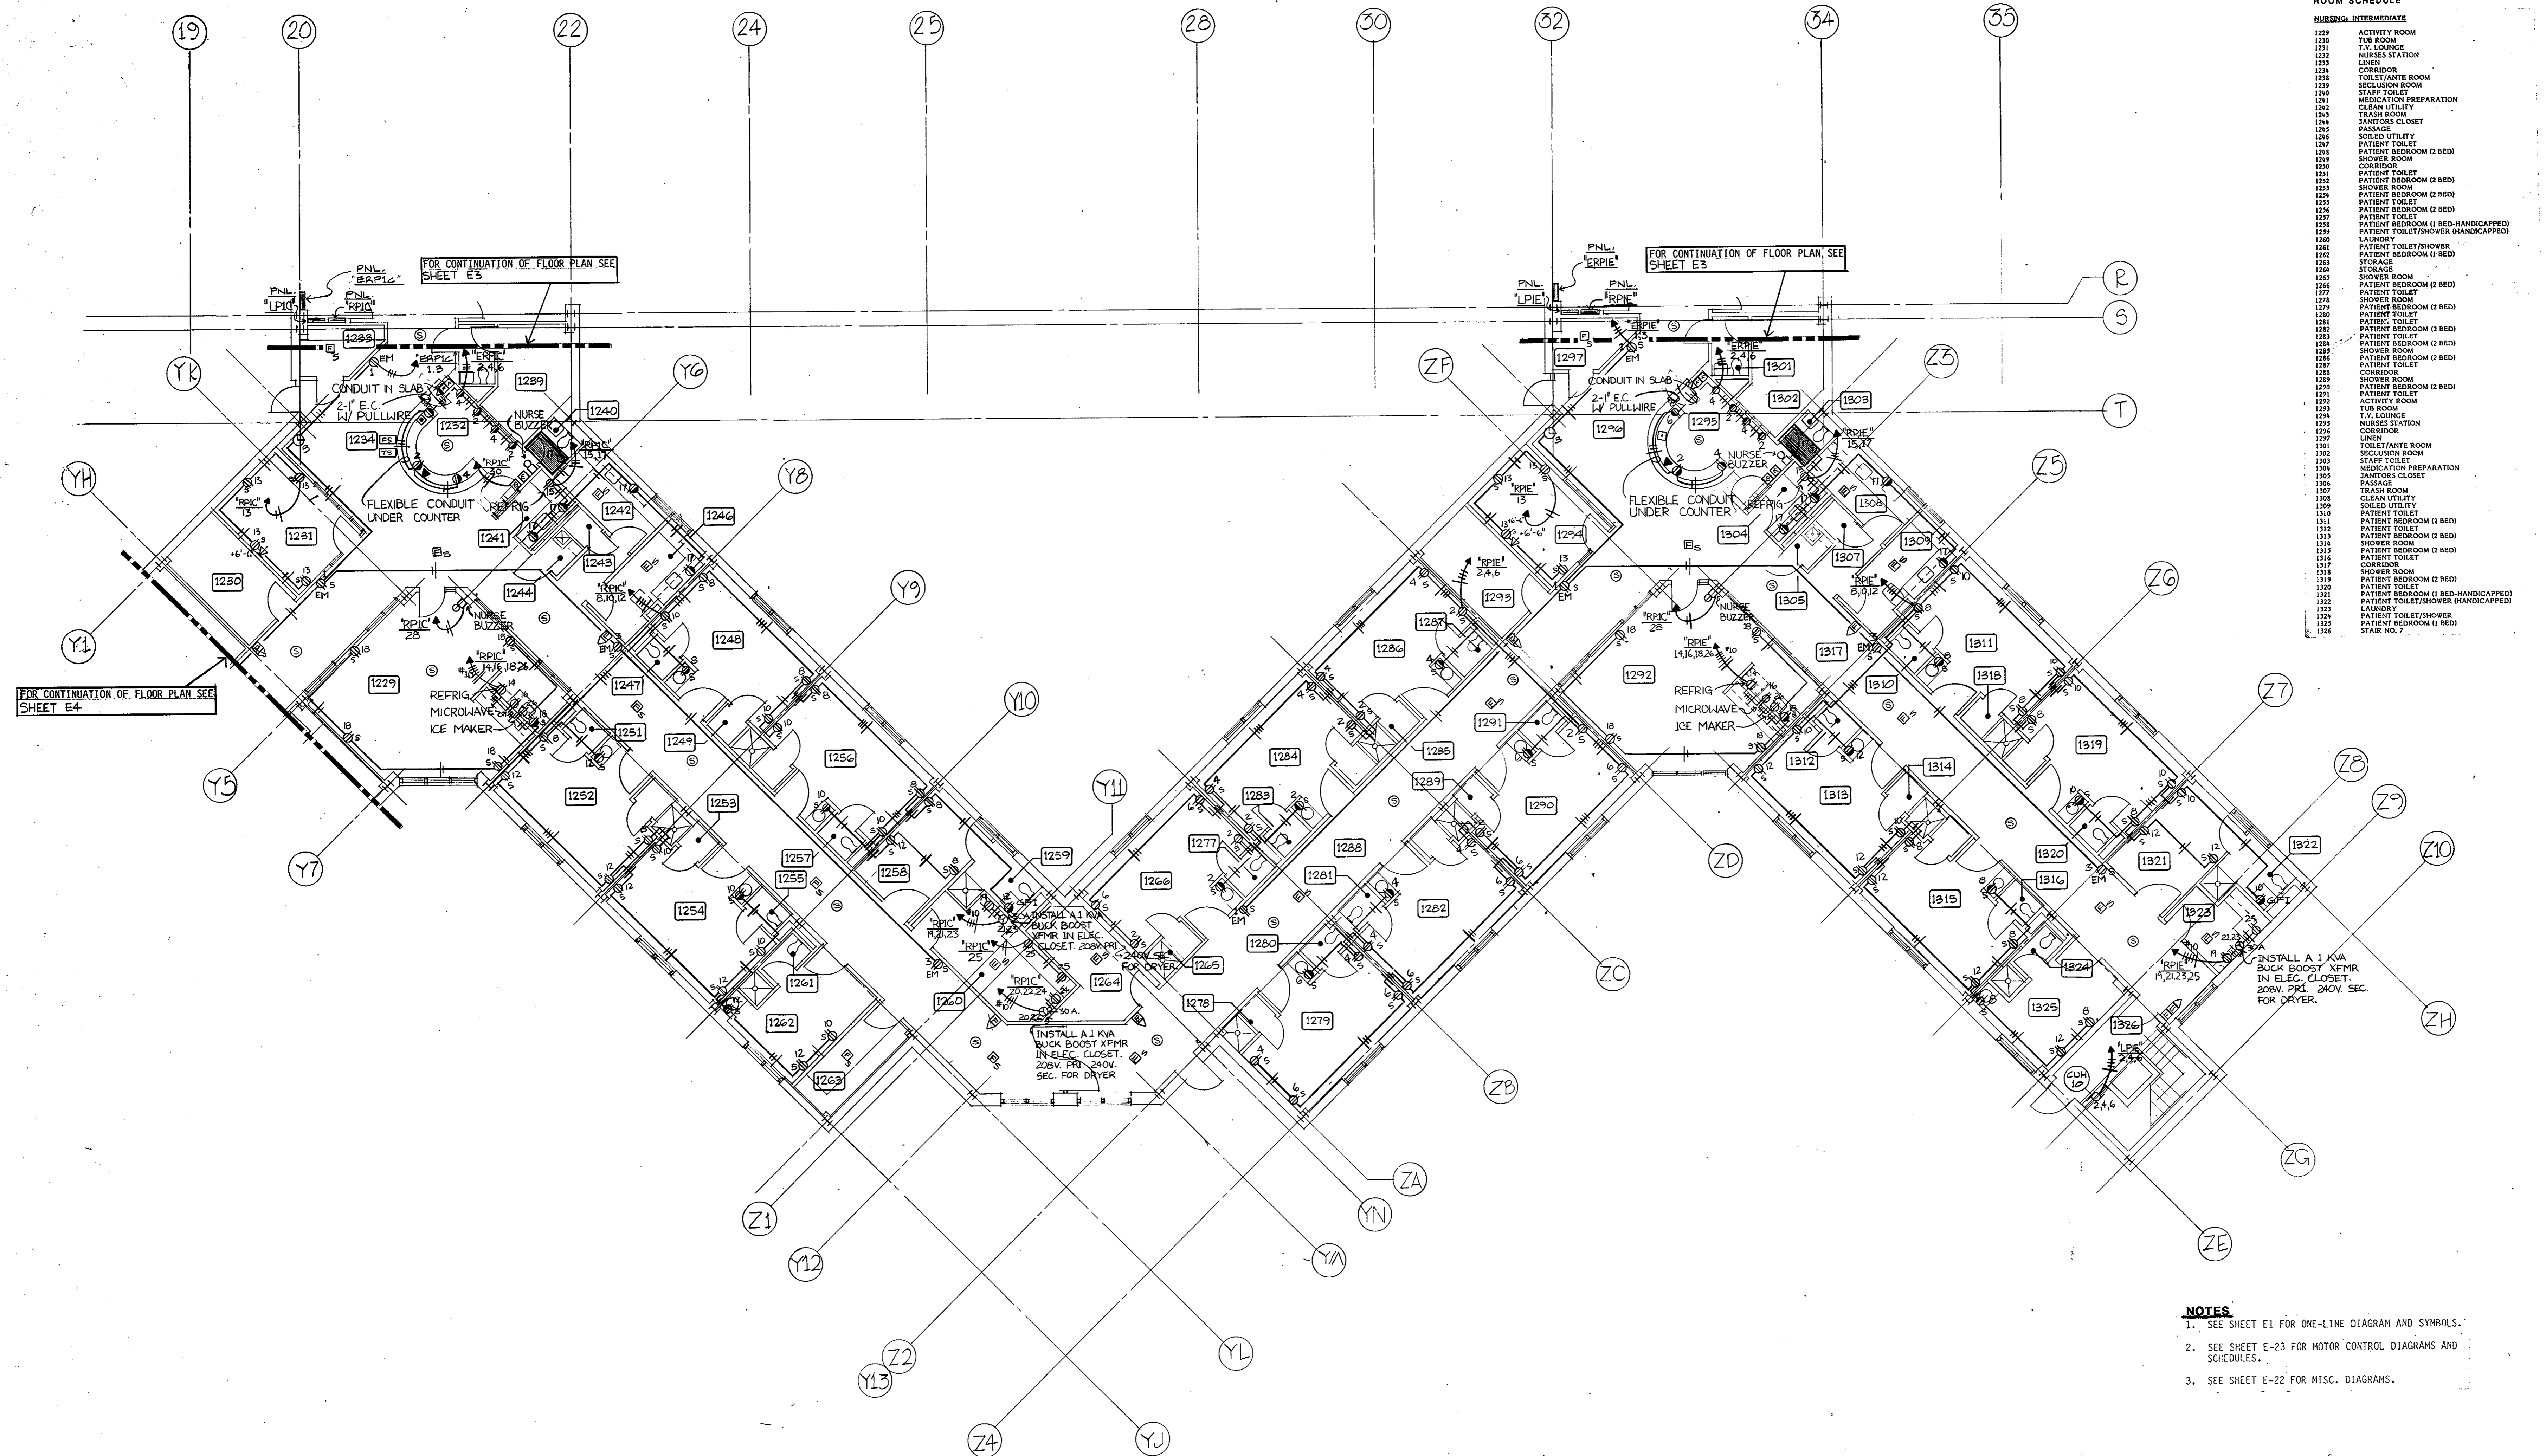


**ROOM SCHEDULE**

1229	ACTIVITY ROOM
1230	T.V. LOUNGE
1231	NURSES STATION
1232	CORRIDOR
1233	TOLERANTE ROOM
1234	SECLUSION ROOM
1235	STAFF TOILET
1236	MEDICATION PREPARATION
1237	CLEAN UTILITY
1238	TRASH ROOM
1239	JANITORS CLOSET
1240	PASSAGE
1241	SOLEID UTILITY
1242	PATIENT TOILET
1243	PATIENT BEDROOM (2 BED)
1244	SHOWER ROOM
1245	CORRIDOR
1246	PATIENT BEDROOM (2 BED)
1247	SHOWER ROOM
1248	PATIENT TOILET
1249	PATIENT BEDROOM (2 BED)
1250	SHOWER ROOM
1251	PATIENT TOILET
- NOTES**
1. SEE SHEET E1 FOR ONE-LINE DIAGRAM AND SYMBOLS.
  2. SEE SHEET E-23 FOR MOTOR CONTROL DIAGRAMS AND SCHEDULES.
  3. SEE SHEET E-22 FOR MISC. DIAGRAMS.

This record drawing has been prepared in part, by Colton/Lester Corporation, based upon information furnished by others. While this information is believed to be reliable, the Engineer cannot assure its accuracy, and thus is not responsible for the accuracy of this record drawing or for any errors or omissions which may have been incorporated into it as a result. Those relying on this record document are advised to obtain independent verification of its accuracy before applying it for any purpose.

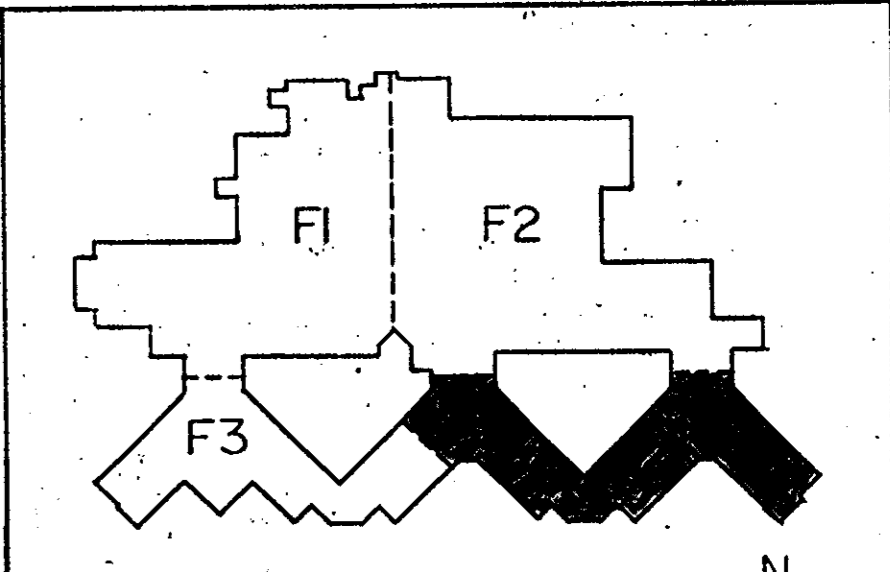

**DRAWING TITLE:**  
PARTIAL FIRST FLOOR  
POWER - AREA F4

**SCALE:** 1/8" = 1'-0"

**REVISIONS:**



**RECORD DRAWING**

**FOR REFERENCE ONLY**

**SHEET NUMBER:**  
**E5**

**PROJECT NUMBER:**  
830.13

**ISSUE DATE:**  
6-27-85

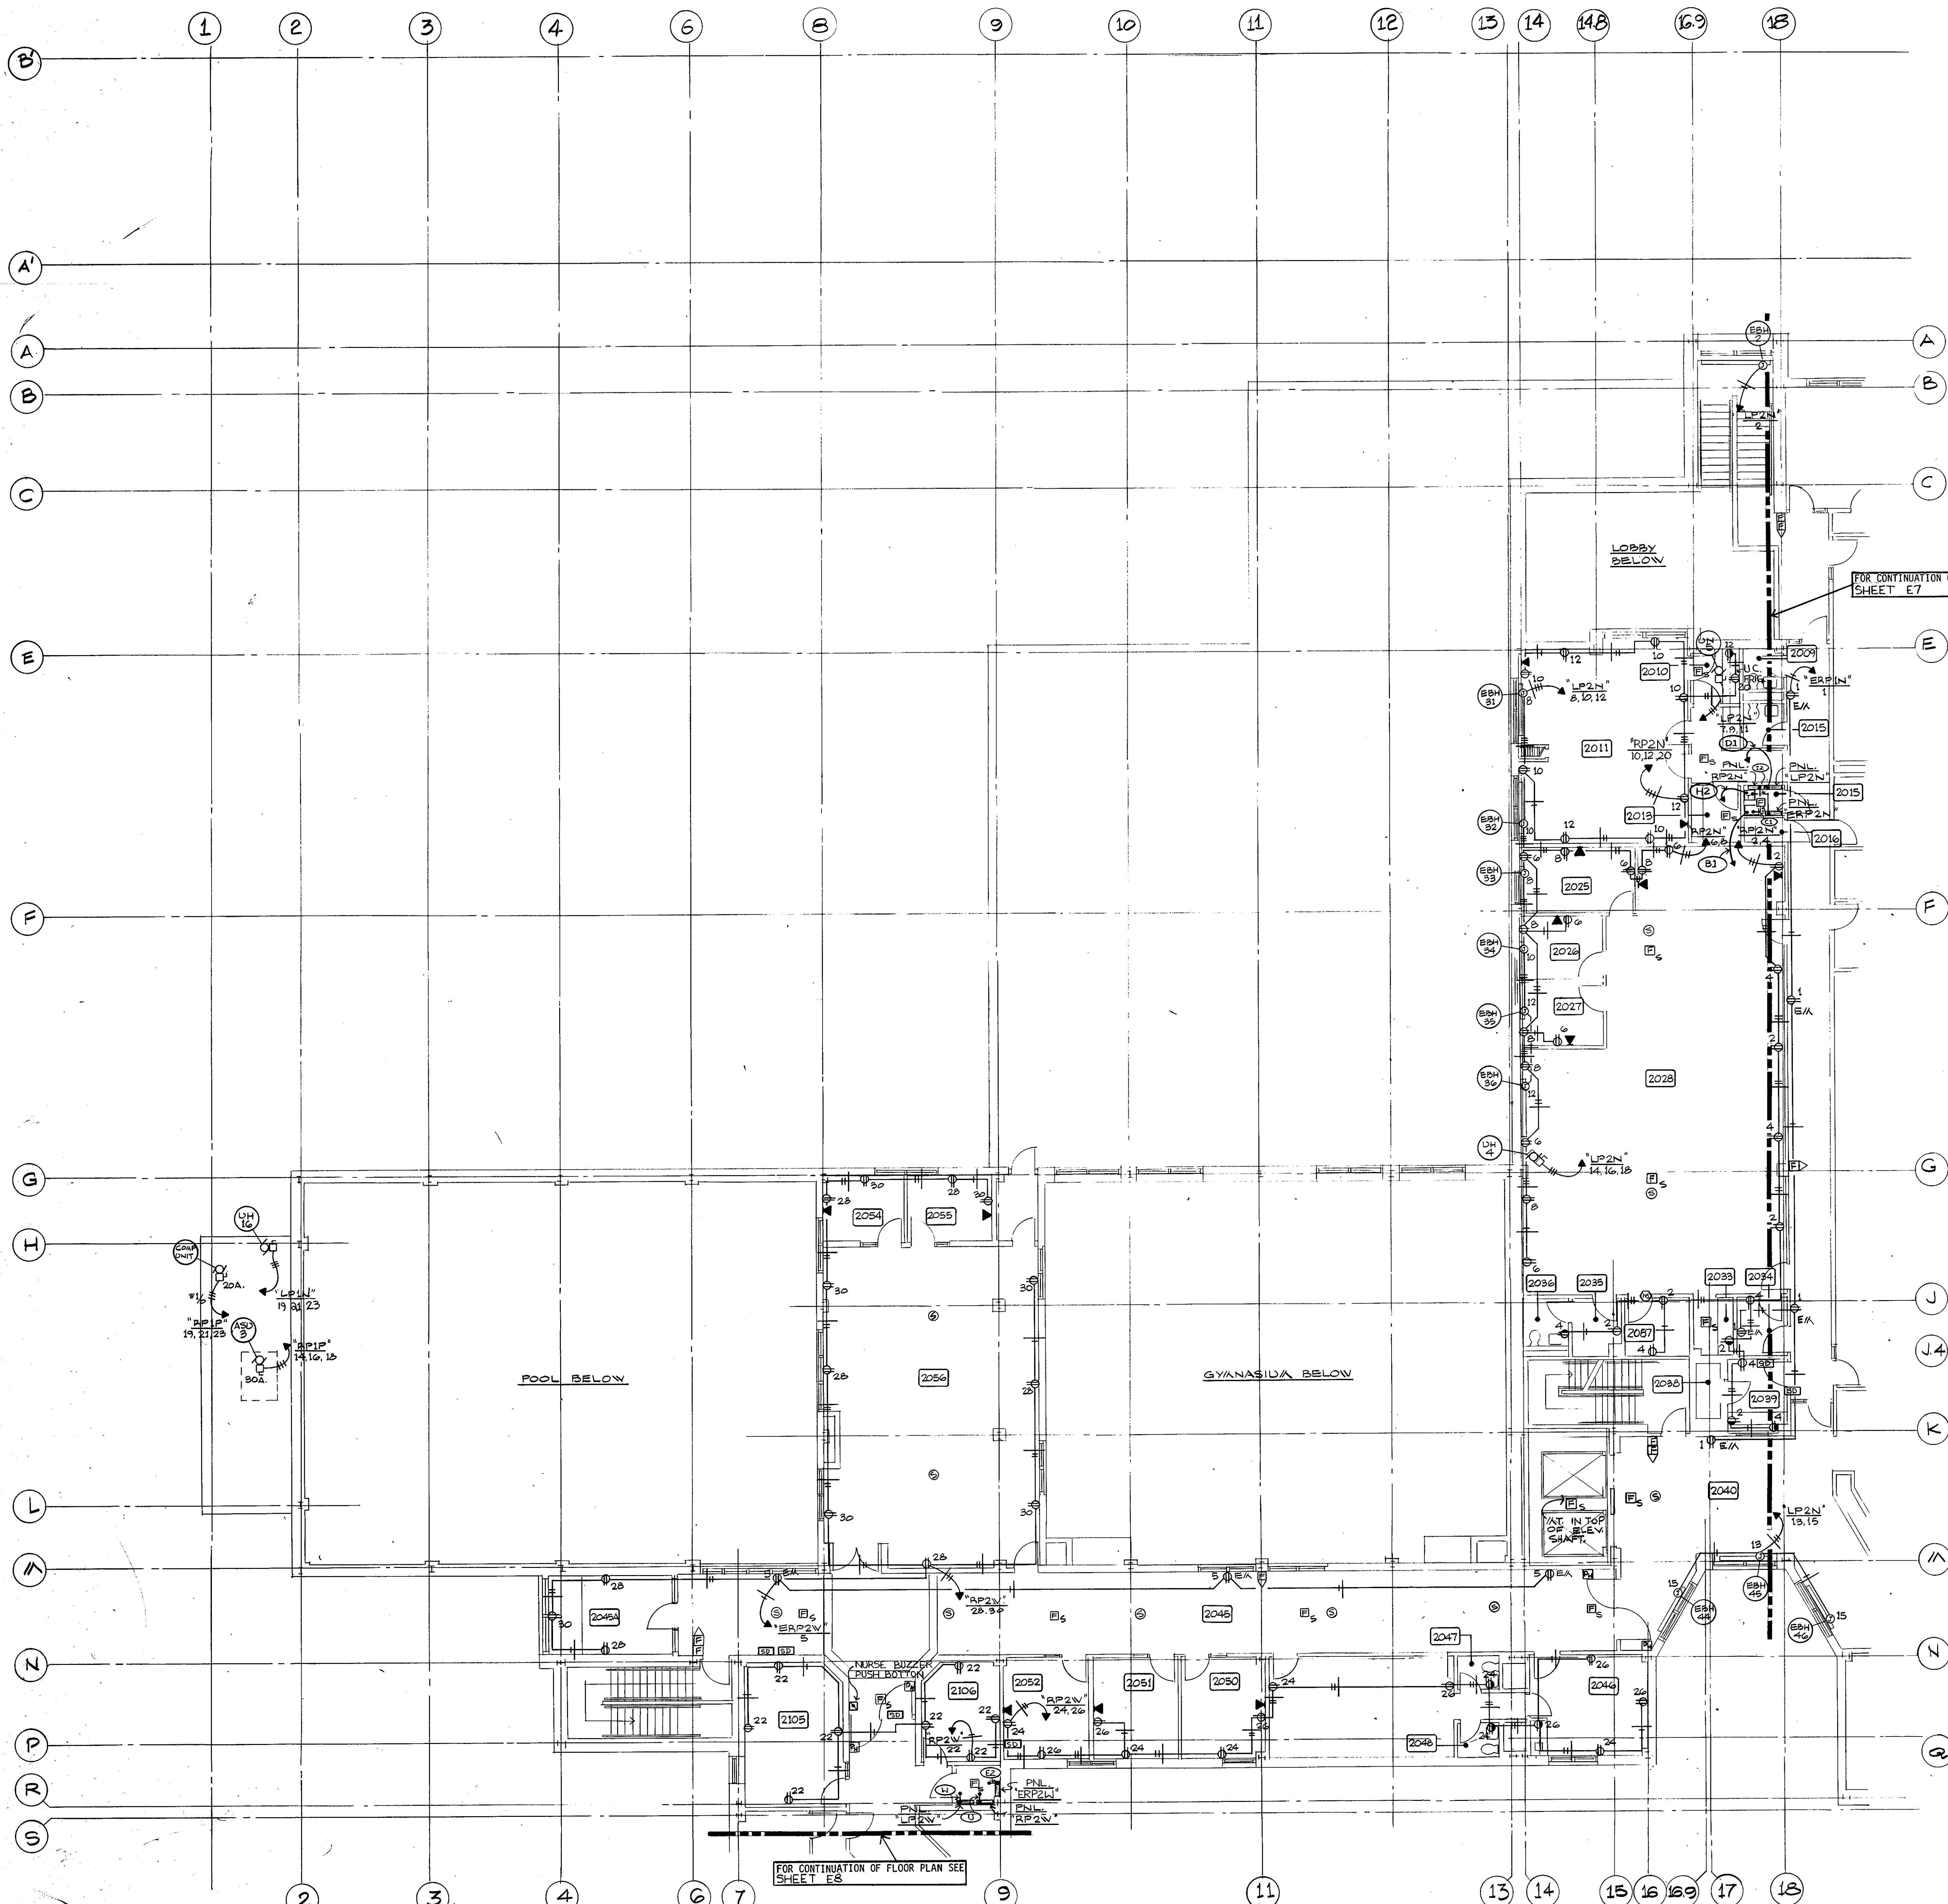


**ROOM SCHEDULE**

2009	MALE TOILET
2010	PANTRY
2011	CONFERENCE
2012	PASSAGE
2013	STORAGE
2014	FEMALE TOILET
2015	ELECTRICAL CLOSET
2016	JANITORS CLOSET
<b>PHARMACY</b>	
2025	DIRECTOR
2026	PHARMACIST
2027	PHARMACIST
2028	OPEN WORK AREA
2029	COMPUTING ROOM
2030	DRUG TRANSFER
2031	LOCKER ROOM
2032	TOILET
2033	TOILET
2034	CONTROLLED DRUG STORAGE
<b>ACCOUNTING</b>	
2038	VALET
2039	CASHIER
2040	ELEVATOR LOBBY
<b>CIRCULATION</b>	
2045	CORRIDOR
2046A	CONFERENCE ROOM 11
2046	STAFF LOUNGE
2047	STAFF FEMALE TOILET
2048	STAFF MALE TOILET
2049	STAFF LOCKERS OFFICE
2050	PSYCHOLOGIST OFFICE
2051	PSYCHIATRIST OFFICE
2052	SOCIAL WORKERS OFFICE
2053	STORAGE
<b>PATIENT ACTIVITY</b>	
2054	ACTIVITY THERAPY OFFICE
2055	ACTIVITY THERAPY OFFICE
2056	RECREATION ROOM
<b>NURSING ACUTE</b>	
2105	CONFERENCE ROOM
2106	COUNSELING ROOM
2107	ELECTRICAL CLOSET

This record drawing has been prepared in part, by Colton/Lester Corporation, based upon information furnished by others. While this information is believed to be reliable, the Engineer cannot assure its accuracy, and thus is not responsible for any errors or omissions which may have been incorporated into it as a result. Those relying on this record document are advised to obtain independent verification of its accuracy before applying it for any purpose.

- NOTES**
- SEE SHEET E1 FOR ONE-LINE DIAGRAM AND SYMBOLS.
  - SEE SHEET E-23 FOR MOTOR CONTROL DIAGRAMS AND SCHEDULES.
  - SEE SHEET E-22 FOR MISC. DIAGRAMS.

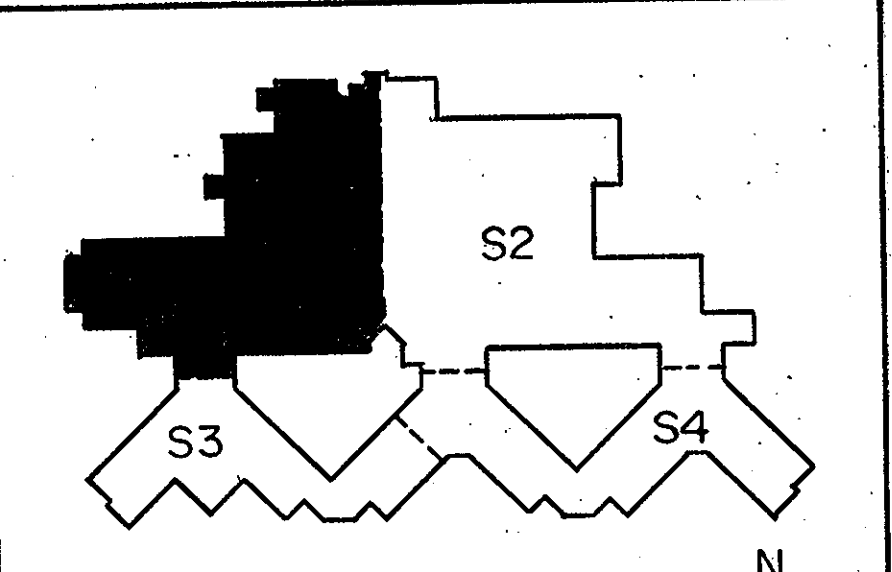

TRUE NORTH

PLAN NORTH

KEY PLAN

DRAWING TITLE:  
**PARTIAL SECOND FLOOR  
POWER - AREA S1**

SCALE: 1/8" = 1'-0"

REVISIONS:

**RECORD DRAWING**

FOR REFERENCE ONLY



SHEET NUMBER:  
**E6**

PROJECT NUMBER:  
83013

ISSUE DATE:  
6-27-85

THE CHRISNER PARTNERSHIP INC. ARCHITECTS AND PLANNERS, 20 SOUTH HANLEY RD., CLAYTON, MISSOURI 63105 314-725-2921 - 11 W VICTORY WAY, CRAIG, COLORADO 81625 303-824-9707



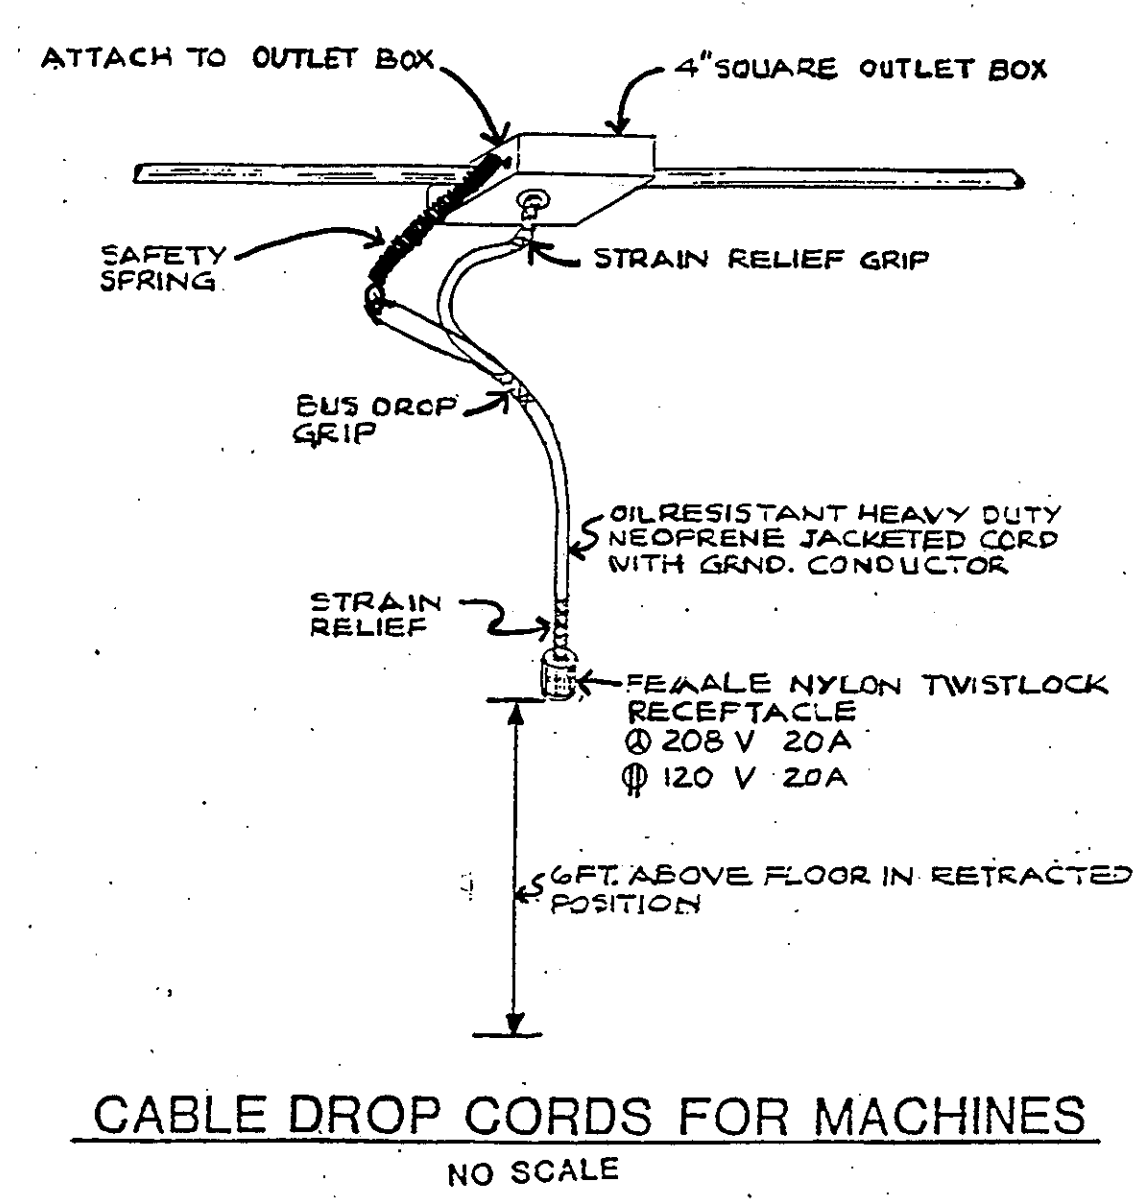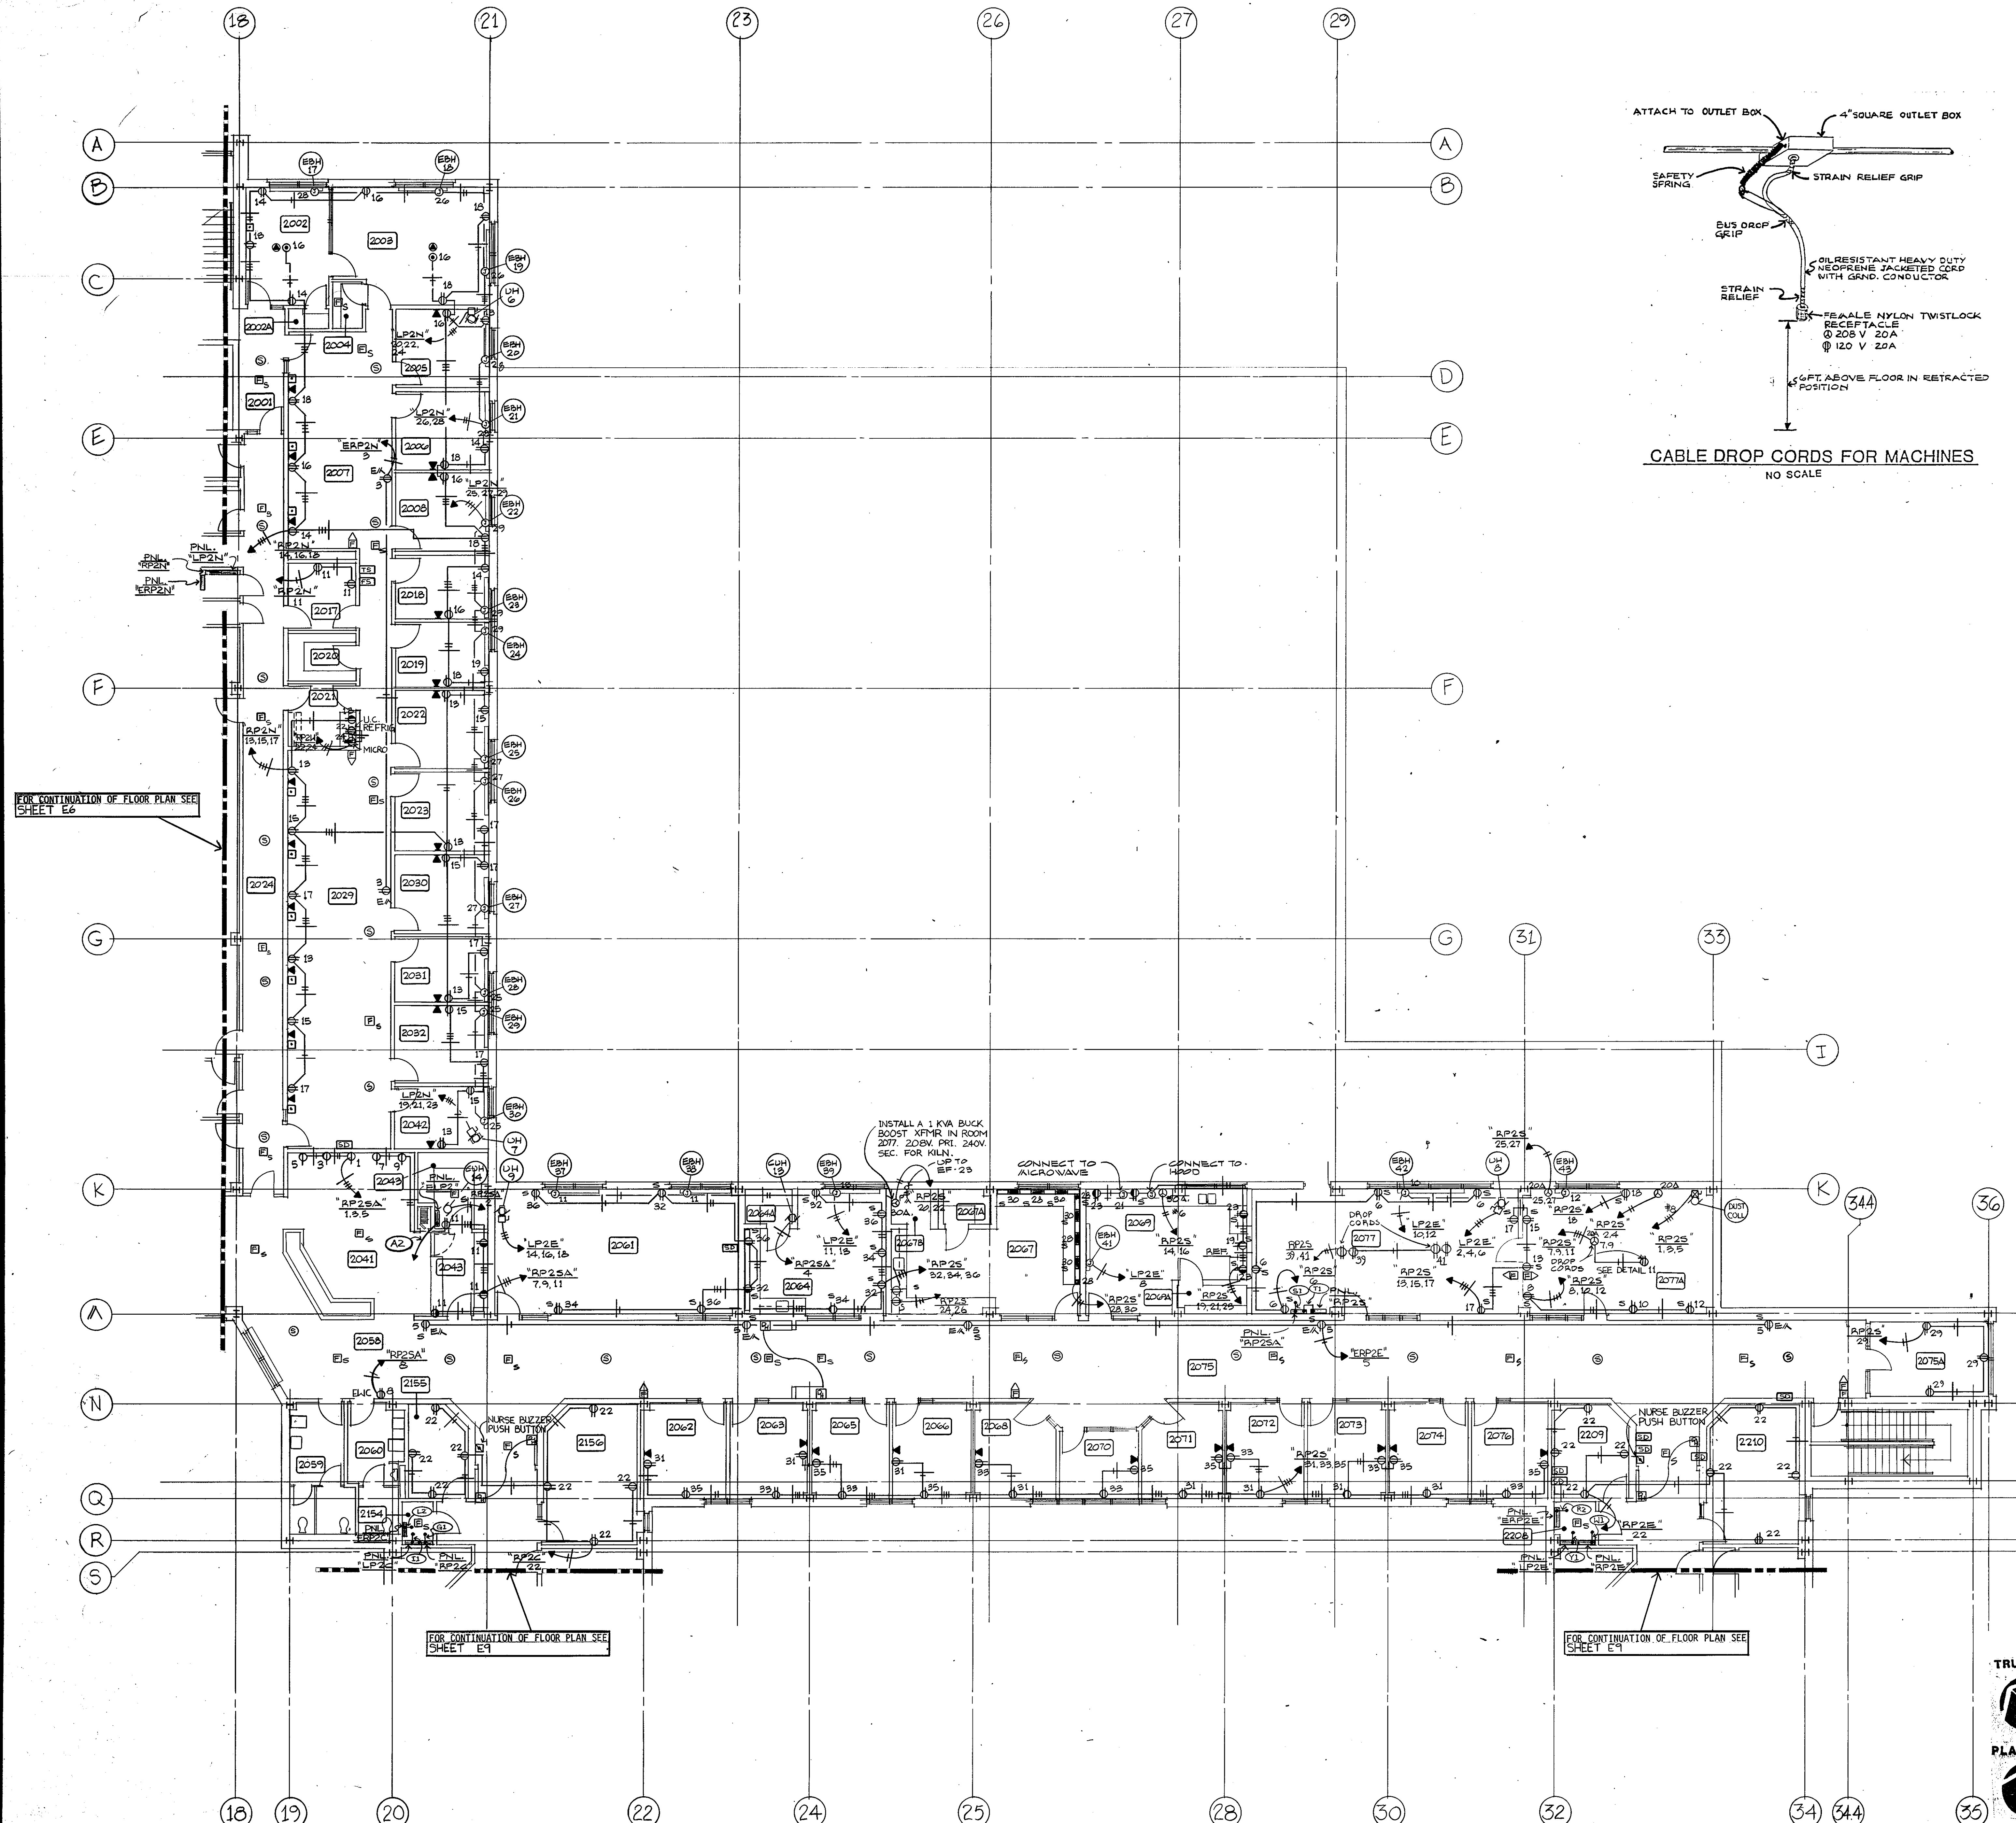


**ROOM SCHEDULE**

ADMINISTRATION	
2001	CORRIDOR
2002	EXECUTIVE SECRETARY
2002A	SECRETARY
2003	SUPERINTENDENT
2004	STORAGE CLOSET
2005	SUPERINTENDENT TREATMENT
2006	CHIEF OF STAFF
2007	OPEN WORK AREA
2008	HOSPITAL SUPERINTENDENT ADMINISTRATOR
2009	COPY
2010	HOSPITAL MANAGEMENT ASSISTANT
2011	OFFICE
2012	SUPPLIES
2013	PAINTRY/COATS
2014	SOCIAL WORK DIRECTOR
2015	PSYCHOLOGY DIRECTOR
2016	CORRIDOR
2017	OPEN WORK AREA
2018	ACTIVITY DIRECTOR
2019	CLINICAL NURSING COORDINATOR
2020	NURSING DIRECTOR
PATIENT SUPPORT	
2041	VENDING
2042	ASSISTANT NURSING DIRECTOR
2043	VENDING STORAGE
2044	SERVING
2045	CORRIDOR
2046	PATIENT FEMALE TOILET
2047	PATIENT MALE TOILET
PATIENT ACTIVITY (NURSING ACUTE SHARED SUPPORT)	
2061	LIBRARY
2062	SOCIAL WORKERS OFFICE
2063	PSYCHIATRIST OFFICE
2064	ARTS AND CRAFTS
2064A	STORAGE
2065	PSYCHOLOGIST OFFICE
2066	ACTIVITY THERAPY SUPERVISORS OFFICE
2067	CERAMICS SHOP
2067A	STORAGE
2068	STORAGE
2069	UNIT DIRECTORS OFFICE
2069A	COMMUNITY LIVING SKILLS
2069B	STORAGE
2070	SECRETARY
2071	NURSING SUPERVISORS OFFICE
2072	SOCIAL WORKER SUPERVISORS OFFICE
2073	PSYCHOLOGIST OFFICE
2074	PSYCHIATRIST OFFICE
2075	CORRIDOR
2075A	CONFERENCE ROOM
2076	WORKERS OFFICE
2077	WOOD SHOP
2077A	SAW ROOM
NURSING ACUTE	
2154	ELECTRICAL CLOSET
2155	COUNSELING ROOM
2156	CONFERENCE ROOM
NURSING INTERMEDIATE	
2208	ELECTRICAL CLOSET
2209	COUNSELING ROOM
2210	CONFERENCE ROOM

This record drawing has been prepared in part, by Colton/Lester Corporation, based upon information furnished by others. While this information is believed to be reliable, the Engineer cannot assure its accuracy, and thus is not responsible for any errors or omissions which may have been incorporated into it as a result. Those relying on this record document are advised to obtain independent verification of its accuracy before applying it for any purpose.

- NOTES**
- SEE SHEET E1 FOR ONE-LINE DIAGRAM AND SYMBOLS.
  - SEE SHEET E-23 FOR MOTOR CONTROL DIAGRAMS AND SCHEDULES.
  - SEE SHEET E-22 FOR MISC. DIAGRAMS.

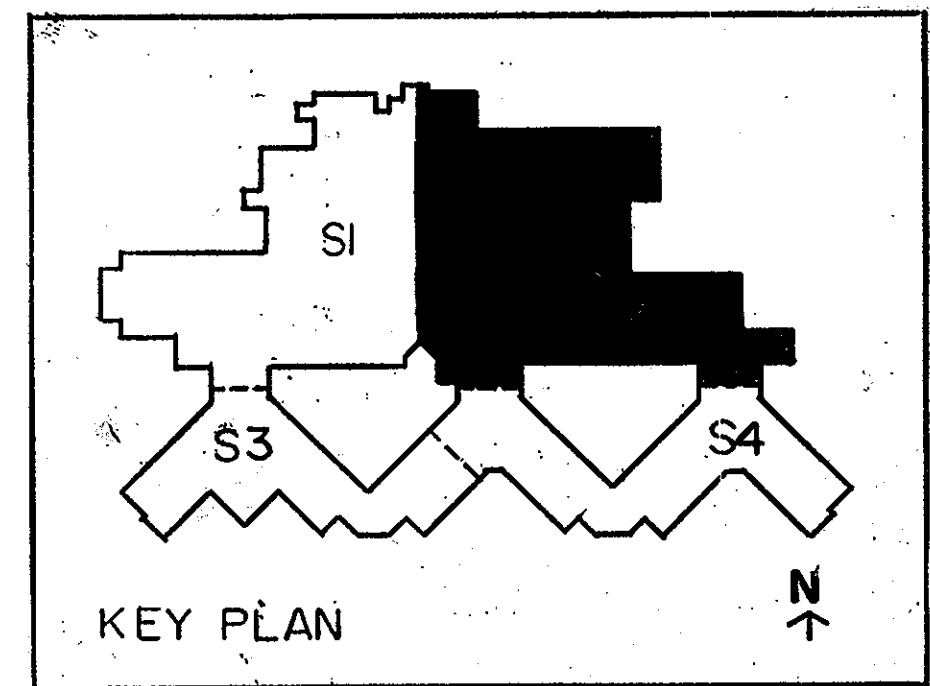

**DRAWING TITLE:**  
PARTIAL SECOND FLOOR  
POWER - AREA S2

**SCALE:** 1/8" = 1'-0"

**REVISIONS:**


**RECORD DRAWING**

FOR REFERENCE ONLY

**SHEET NUMBER:**  
E7

**PROJECT NUMBER:**  
83013

**ISSUE DATE:**  
6-27-85

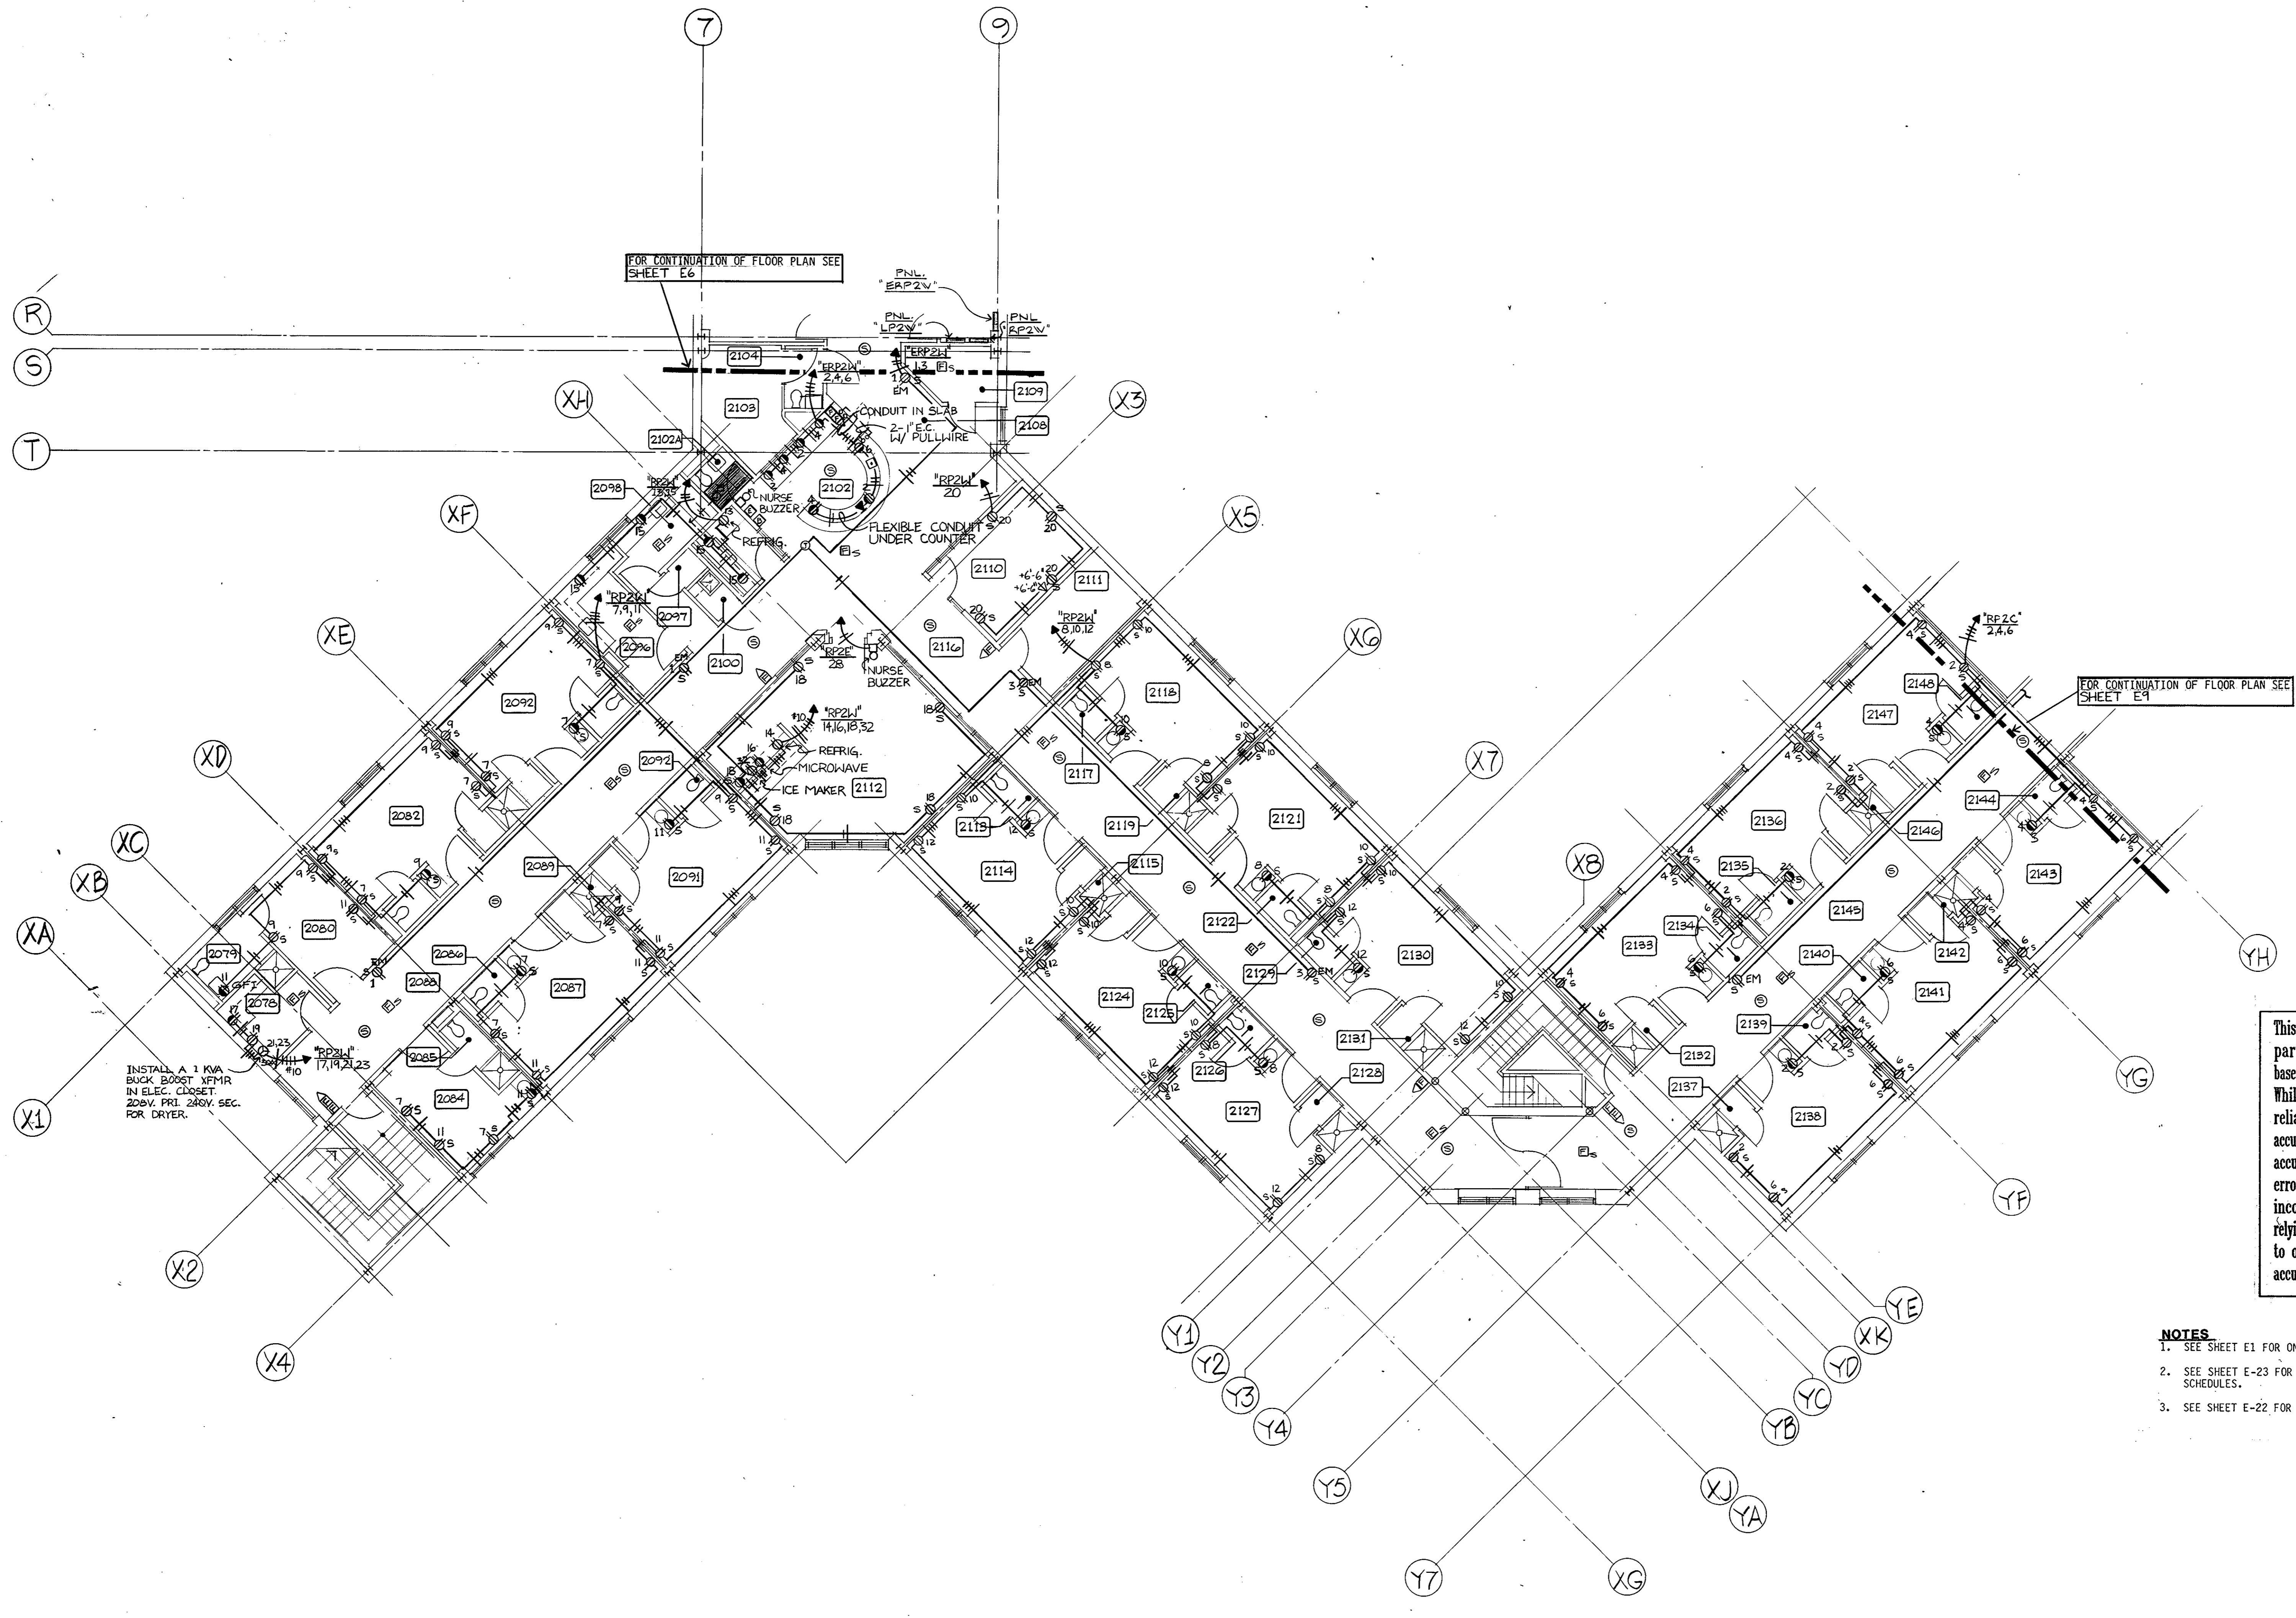


**ROOM SCHEDULE**

2078	LAUNDRY ROOM
2079	PATIENT TOILET (HANDICAPPED)
2080	PATIENT BEDROOM (1 BED-HANDICAPPED)
2081	PATIENT BEDROOM (2 BEDROOM)
2082	PATIENT BEDROOM (2 BEDROOM)
2083	PATIENT TOILET
2084	PATIENT BEDROOM (2 BED)
2085	PATIENT TOILET
2086	PATIENT BEDROOM (2 BED)
2087	PATIENT TOILET
2088	PATIENT BEDROOM (2 BED)
2089	PATIENT TOILET
2090	PATIENT BEDROOM (2 BED)
2091	PATIENT TOILET
2092	PATIENT BEDROOM (2 BED)
2093	PATIENT TOILET
2094	PATIENT BEDROOM (2 BED)
2095	PATIENT TOILET
2096	SOILED UTILITY ROOM
2097	TRASH ROOM
2098	CLEAN UTILITY ROOM
2099	PASSAGE
2100	JANITORS CLOSET
2101	MEDICATION PREPARATION
2102	NURSES STATION
2103	TILE
2104	SECLUSION ROOM
2105	TOILET/ANTE ROOM
2106	CORRIDOR
2107	ENLW
2108	T.V. LOUNGE
2109	TUB ROOM
2110	ACTIVITY ROOM
2111	PATIENT TOILET
2112	PATIENT BEDROOM (2 BED)
2113	SHOWER ROOM
2114	PATIENT TOILET
2115	PATIENT BEDROOM (2 BED)
2116	CORRIDOR
2117	PATIENT TOILET
2118	PATIENT BEDROOM (2 BED)
2119	SHOWER ROOM
2120	PATIENT TOILET
2121	PATIENT BEDROOM (2 BED)
2122	PATIENT TOILET
2123	PATIENT BEDROOM (2 BED)
2124	PATIENT TOILET
2125	PATIENT BEDROOM (2 BED)
2126	PATIENT TOILET
2127	PATIENT BEDROOM (2 BED)
2128	SHOWER ROOM
2129	PATIENT TOILET
2130	PATIENT BEDROOM (2 BED)
2131	SHOWER ROOM
2132	PATIENT TOILET
2133	PATIENT BEDROOM (2 BED)
2134	PATIENT TOILET
2135	PATIENT BEDROOM (2 BED)
2136	PATIENT TOILET
2137	SHOWER ROOM
2138	PATIENT BEDROOM (2 BED)
2139	PATIENT TOILET
2140	SHOWER ROOM
2141	PATIENT BEDROOM (2 BED)
2142	PATIENT TOILET
2143	PATIENT BEDROOM (2 BED)
2144	PATIENT TOILET
2145	PATIENT BEDROOM (2 BED)
2146	CORRIDOR
2147	SHOWER ROOM
2148	PATIENT BEDROOM (2 BED)
2149	PATIENT TOILET

INSTALL A 3 KVA  
BUCK BOOST XFMR  
IN ELEC. CLOSET  
200V. PRI. 230V. SEC.  
FOR DRYER.

This record drawing has been prepared in part, by Colton/Lester Corporation, based upon information furnished by others. While this information is believed to be reliable, the Engineer cannot assure its accuracy, and thus is not responsible for the accuracy of this record drawing or for any errors or omissions which may have been incorporated into it as a result. Those relying on this record document are advised to obtain independent verification of its accuracy before applying it for any purpose.

- NOTES**
- SEE SHEET E1 FOR ONE-LINE DIAGRAM AND SYMBOLS.
  - SEE SHEET E-23 FOR MOTOR CONTROL DIAGRAMS AND SCHEDULES.
  - SEE SHEET E-22 FOR MISC. DIAGRAMS.

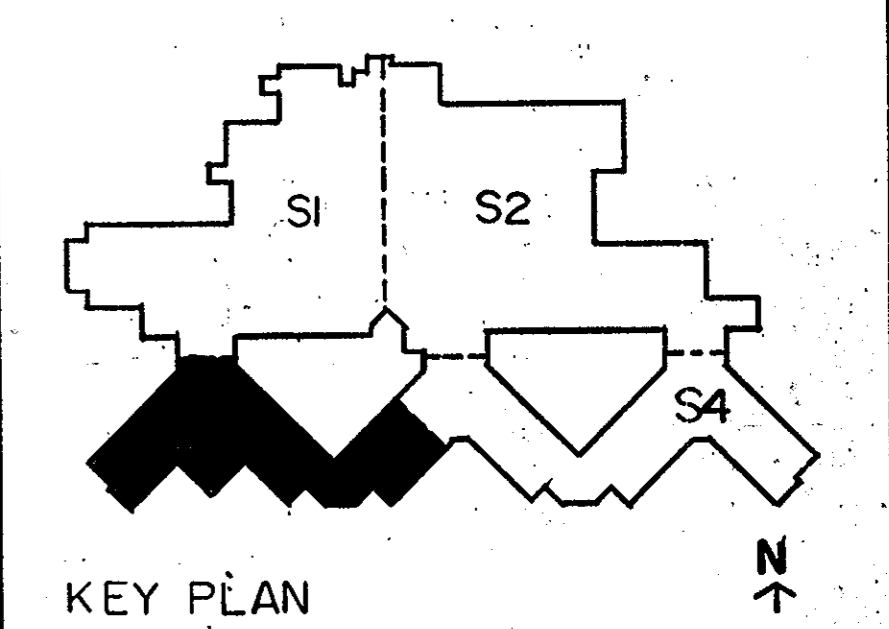

**TRUE NORTH**

**PLAN NORTH**

**DRAWING TITLE:**  
PARTIAL SECOND FLOOR  
POWER - AREA S3

**SCALE:** 1/8" = 1'0"

**REVISIONS:**


**RECORD DRAWING**

FOR REFERENCE ONLY

**SHEET NUMBER:**  
**E8**

**PROJECT NUMBER:**  
83013

**ISSUE DATE:**  
9-27-85

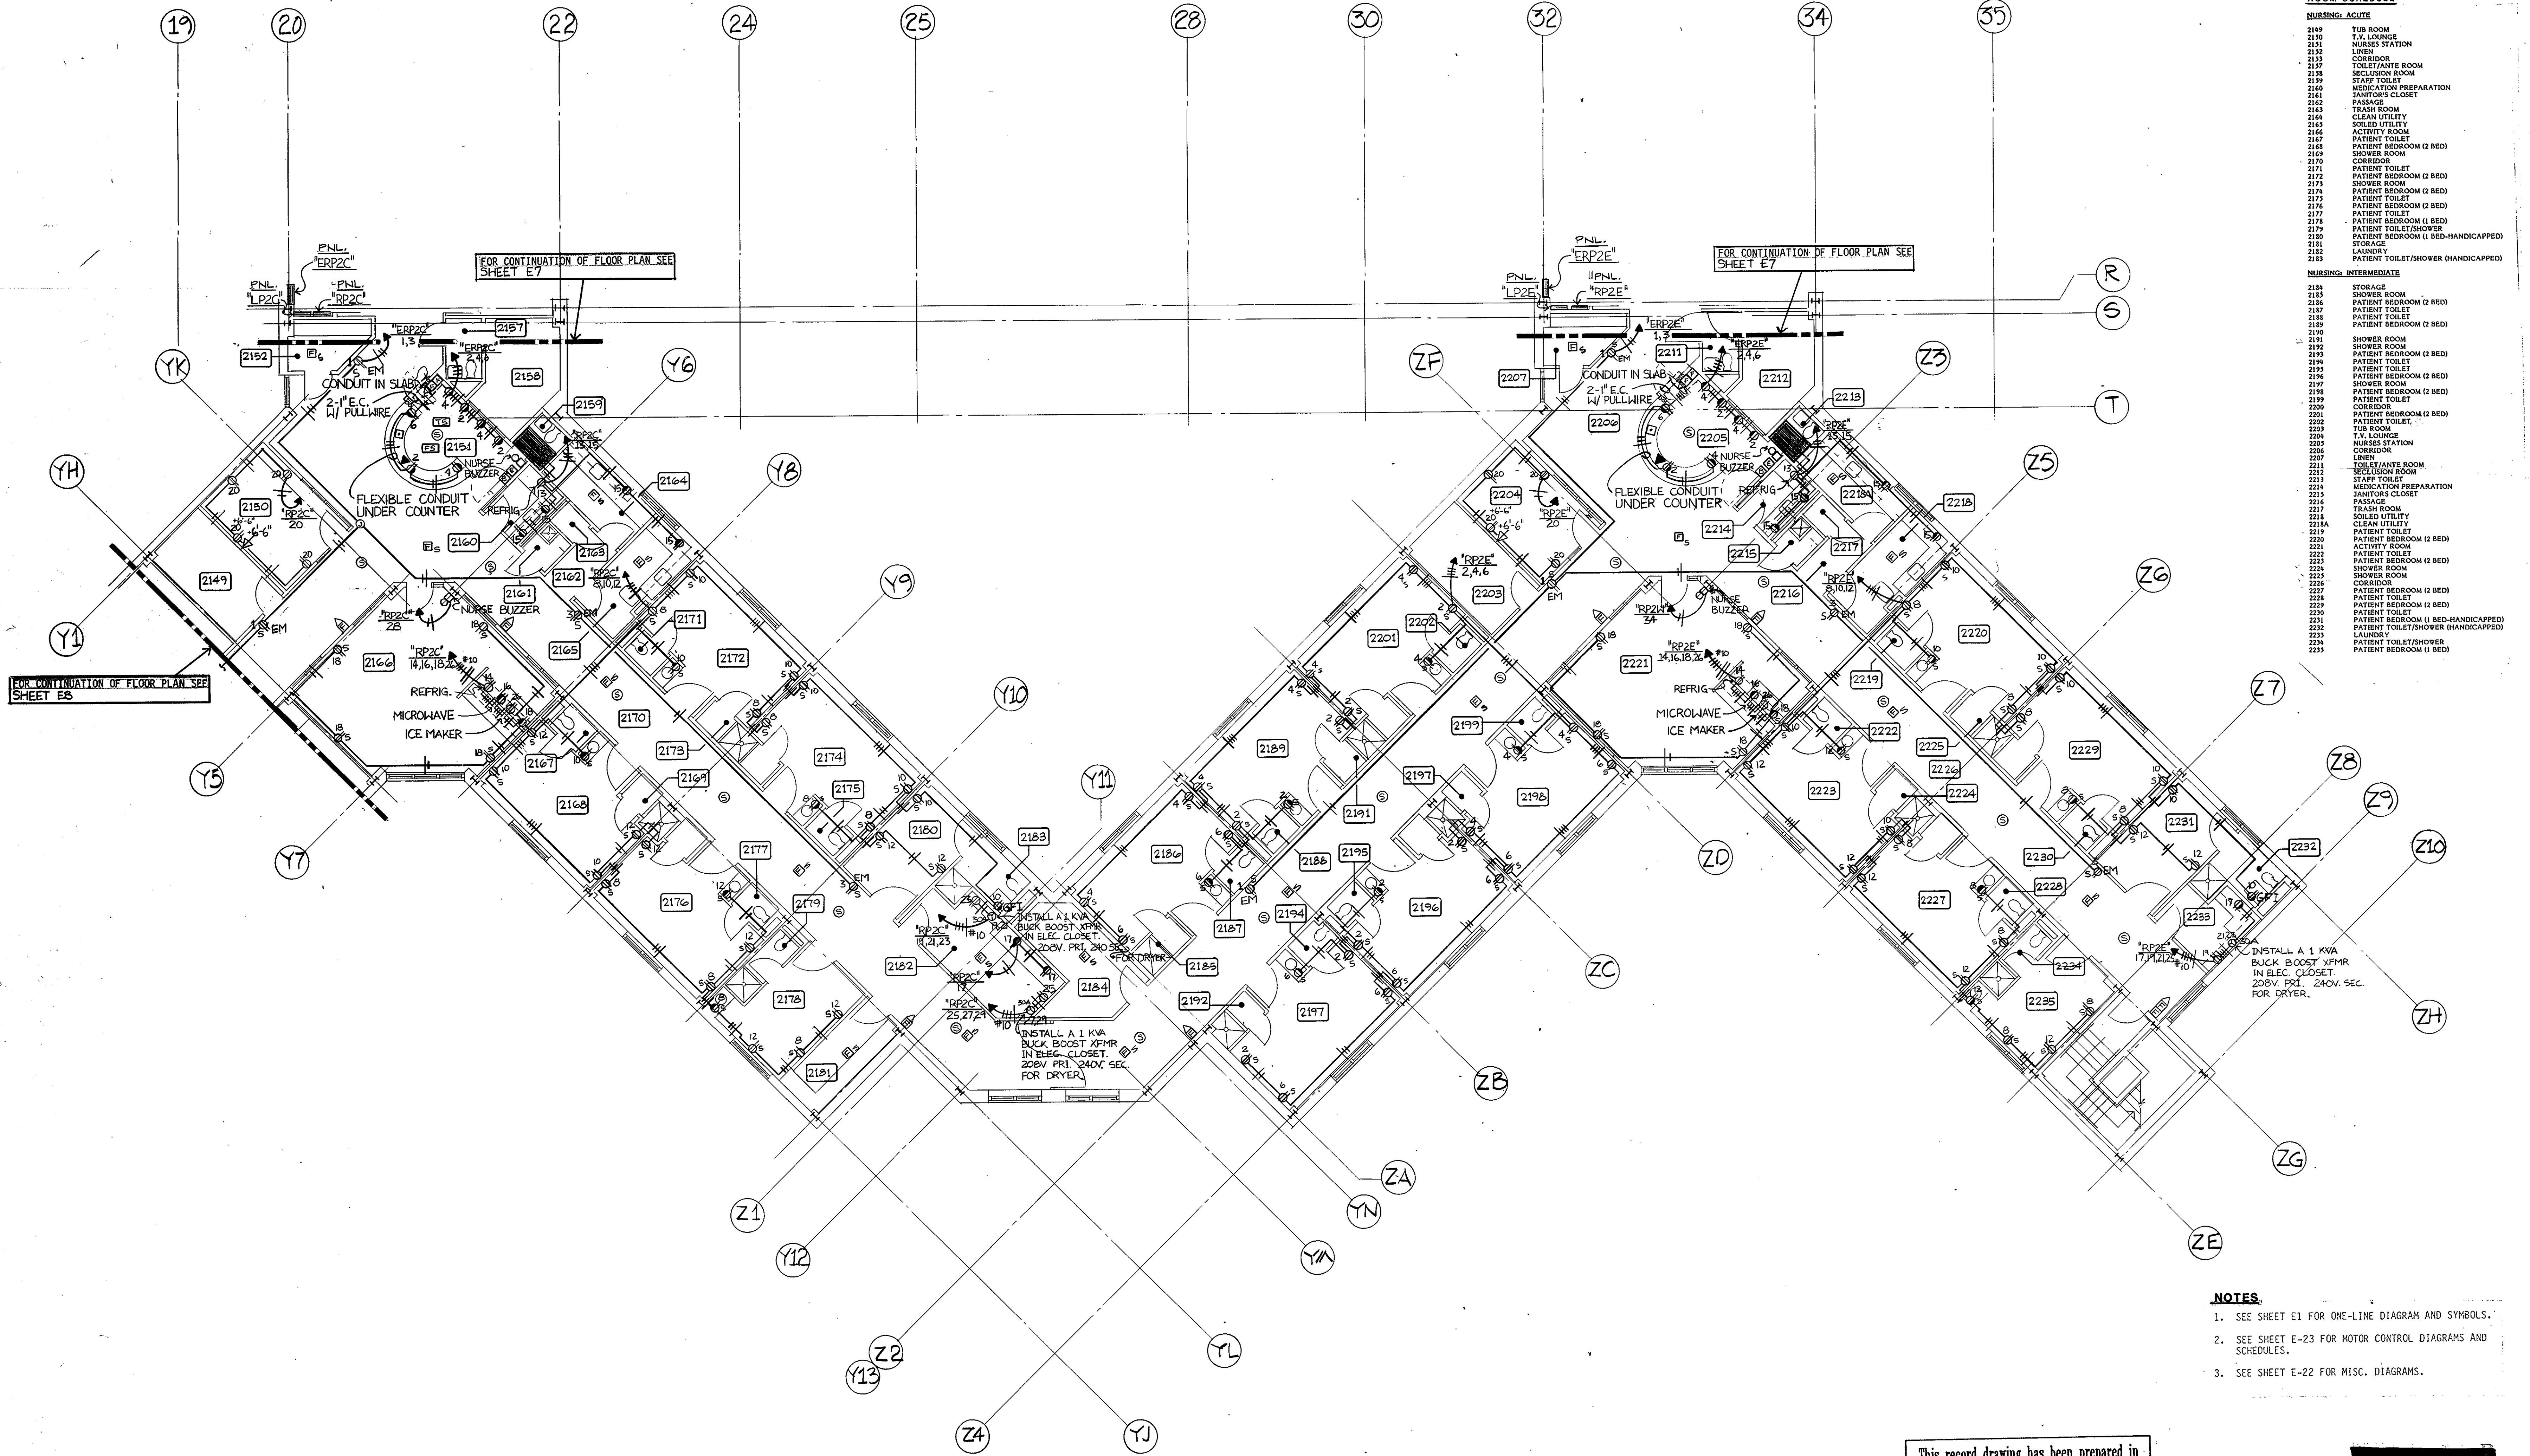

**ROOM SCHEDULE**

NURSING ACUTE	
2149	TUB ROOM
2150	T.V. LOUNGE
2151	NURSE STATION
2152	CORRIDOR
2153	TOILET/ANTE ROOM
2154	SECTION ROOM
2155	STAFF TOILET
2156	MEDICATION PREPARATION
2157	JANITORS CLOSET
2158	PASSAGE
2159	TRASH ROOM
2160	CLEAN UTILITY
2161	CLEAN UTILITY
2162	CLEAN UTILITY
2163	CLEAN UTILITY
2164	CLEAN UTILITY
2165	CLEAN UTILITY
2166	ACTIVITY ROOM
2167	PATIENT BEDROOM (2 BED)
2168	PATIENT BEDROOM (2 BED)
2169	PATIENT BEDROOM (2 BED)
2170	PATIENT BEDROOM (2 BED)
2171	PATIENT BEDROOM (2 BED)
2172	PATIENT BEDROOM (2 BED)
2173	PATIENT BEDROOM (2 BED)
2174	PATIENT BEDROOM (2 BED)
2175	PATIENT BEDROOM (2 BED)
2176	PATIENT BEDROOM (2 BED)
2177	PATIENT BEDROOM (2 BED)
2178	PATIENT BEDROOM (1 BED)
2179	PATIENT BEDROOM (1 BED)
2180	PATIENT BEDROOM (1 BED-HANDICAPPED)
2181	STORAGE
2182	LAUNDRY
2183	PATIENT TOILET/SHOWER (HANDICAPPED)
NURSING INTERMEDIATE	
2184	STORAGE
2185	SHOWER ROOM
2186	PATIENT BEDROOM (2 BED)
2187	PATIENT TOILET
2188	PATIENT BEDROOM (2 BED)
2189	PATIENT BEDROOM (2 BED)
2190	SHOWER ROOM
2191	SHOWER ROOM
2192	PATIENT BEDROOM (2 BED)
2193	PATIENT TOILET
2194	PATIENT BEDROOM (2 BED)
2195	PATIENT BEDROOM (2 BED)
2196	SHOWER ROOM
2197	PATIENT BEDROOM (2 BED)
2198	PATIENT TOILET
2199	PATIENT BEDROOM (2 BED)
2200	CORRIDOR
2201	PATIENT BEDROOM (2 BED)
2202	PATIENT TOILET
2203	T.V. LOUNGE
2204	NURSE STATION
2205	CORRIDOR
2206	TOILET/ANTE ROOM
2207	SECTION ROOM
2208	STAFF TOILET
2209	MEDICATION PREPARATION
2210	PASSAGE
2211	JANITORS CLOSET
2212	TRASH ROOM
2213	CLEAN UTILITY
2214	CLEAN UTILITY
2215	CLEAN UTILITY
2216	CLEAN UTILITY
2217	CLEAN UTILITY
2218	CLEAN UTILITY
2219	ACTIVITY ROOM
2220	PATIENT BEDROOM (2 BED)
2221	PATIENT TOILET
2222	PATIENT BEDROOM (2 BED)
2223	SHOWER ROOM
2224	SHOWER ROOM
2225	PATIENT BEDROOM (2 BED)
2226	PATIENT TOILET
2227	PATIENT BEDROOM (2 BED)
2228	PATIENT TOILET
2229	PATIENT BEDROOM (1 BED)
2230	PATIENT TOILET/SHOWER (HANDICAPPED)
2231	LAUNDRY
2232	PATIENT TOILET/SHOWER (HANDICAPPED)
2233	PATIENT BEDROOM (1 BED)
2234	PATIENT BEDROOM (1 BED)

FOR CONTINUATION OF FLOOR PLAN SEE SHEET E7


FOR CONTINUATION OF FLOOR PLAN SEE SHEET E7

FOR CONTINUATION OF FLOOR PLAN SEE SHEET E8

INSTALL A 1 KVA BUCK BOOST XFMR IN ELEC. CLOSET. 208V. PRI. 240V. SEC. FOR DRYER.

- NOTES**
- SEE SHEET E1 FOR ONE-LINE DIAGRAM AND SYMBOLS.
  - SEE SHEET E-23 FOR MOTOR CONTROL DIAGRAMS AND SCHEDULES.
  - SEE SHEET E-22 FOR MISC. DIAGRAMS.

This record drawing has been prepared in part, by Colton/Lester Corporation, based upon information furnished by others. While this information is believed to be reliable, the Engineer cannot assure its accuracy, and thus is not responsible for the accuracy of this record drawing or for any errors or omissions which may have been incorporated into it as a result. Those relying on this record document are advised to obtain independent verification of its accuracy before applying it for any purpose.

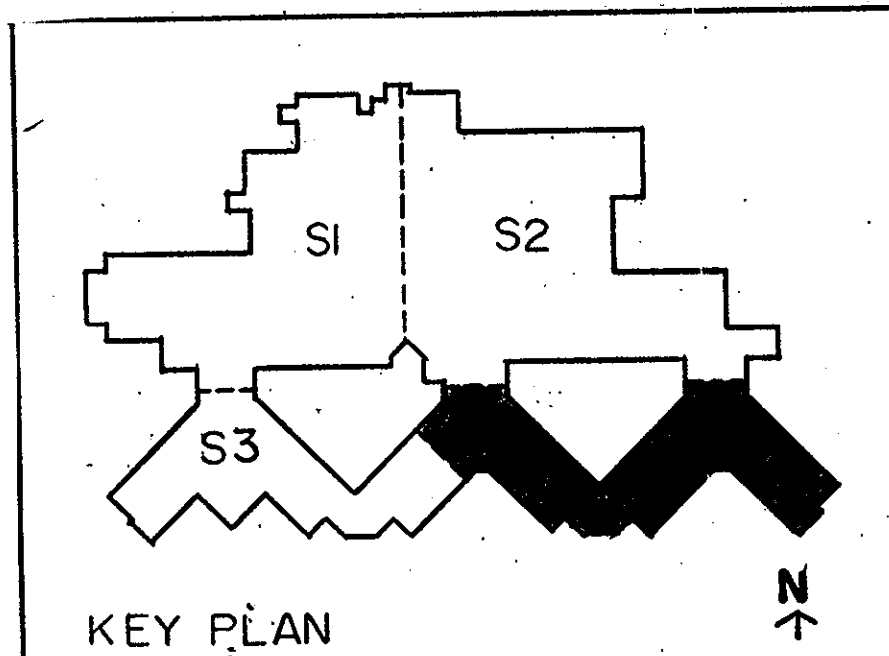

TRUE NORTH

PLAN NORTH

DRAWING TITLE:  
**PARTIAL SECOND FLOOR**  
**POWER - AREA S4**

SCALE: 1/8" = 1'-0"


REVISIONS:

**RECORD DRAWING**

SHEET NUMBER:  
**E9**

PROJECT NUMBER:  
83013  
ISSUE DATE:  
6-27-85

FOR REFERENCE ONLY

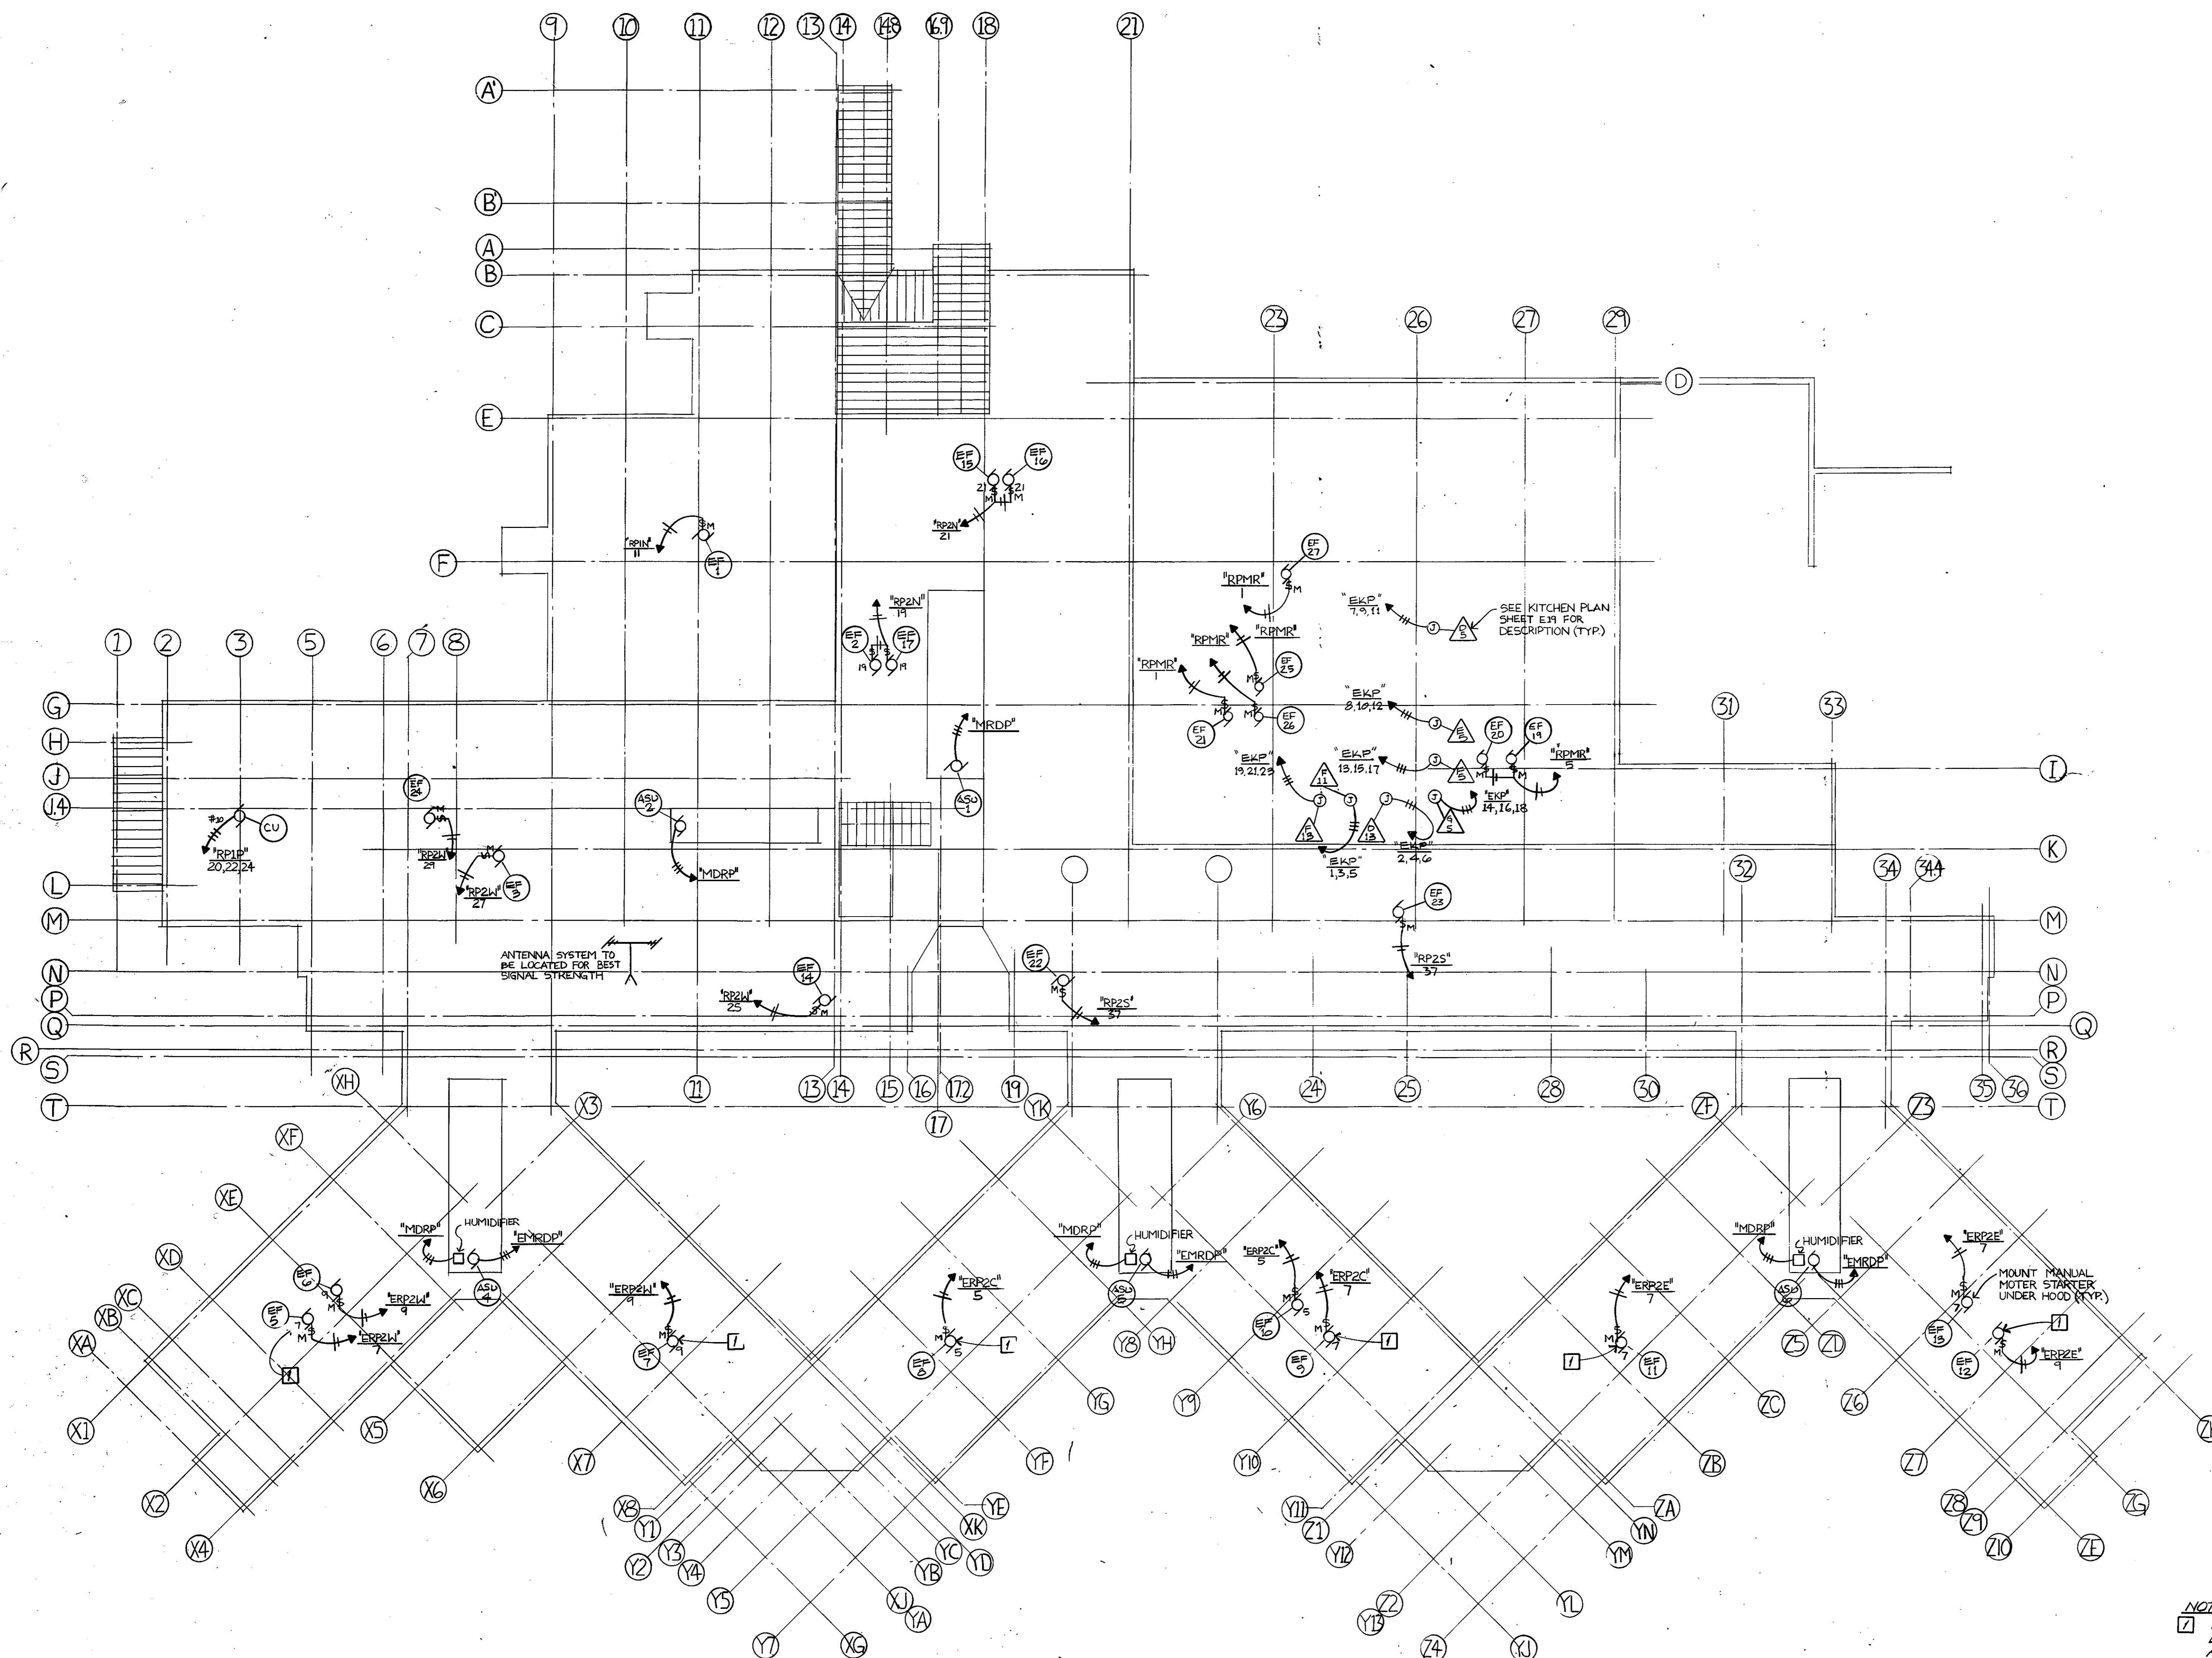


This record drawing has been prepared in part, by Colton/Lester Corporation, based upon information furnished by others. While this information is believed to be reliable, the Engineer cannot assure its accuracy, and thus is not responsible for the accuracy of this record drawing or for any errors or omissions which may have been incorporated into it as a result. Those relying on this record document are advised to obtain independent verification of its accuracy before applying it for any purpose.

NOTE:  
 [Symbol] INSTALL DUCT DETECTOR IN EXHAUST FAN DUCTWORK. CONNECT DETECTOR TO FIRE ALARM PANEL EACH FAN ON ONE ZONE, 3 ZONES TOTAL.

DRAWING TITLE:	
ROOF PLAN	
SCALE: 1/16" = 1'-0"	
REVISIONS:	
Δ 3-20-86	
RECORD DRAWING	




SHEET NUMBER:
<b>E18</b>
PROJECT NUMBER:
83013
ISSUE DATE:
6-27-85

FOR REFERENCE ONLY

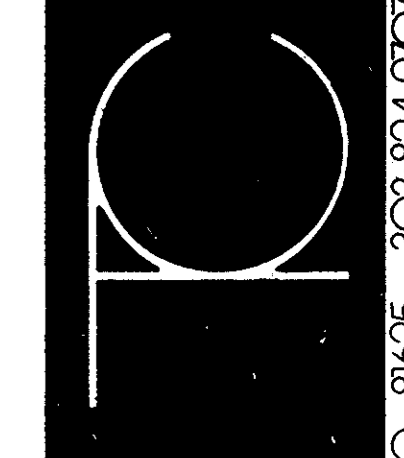





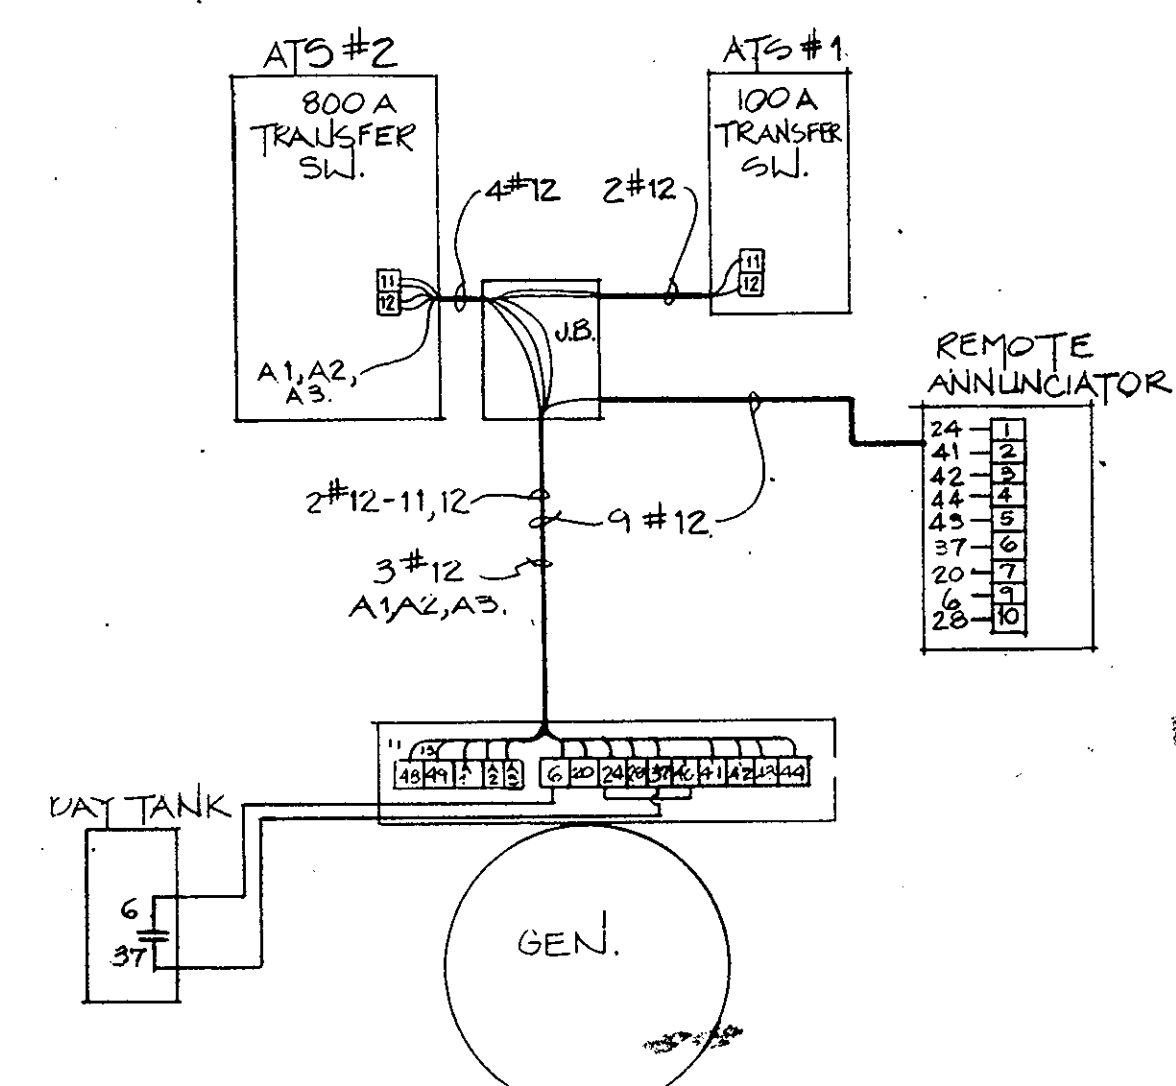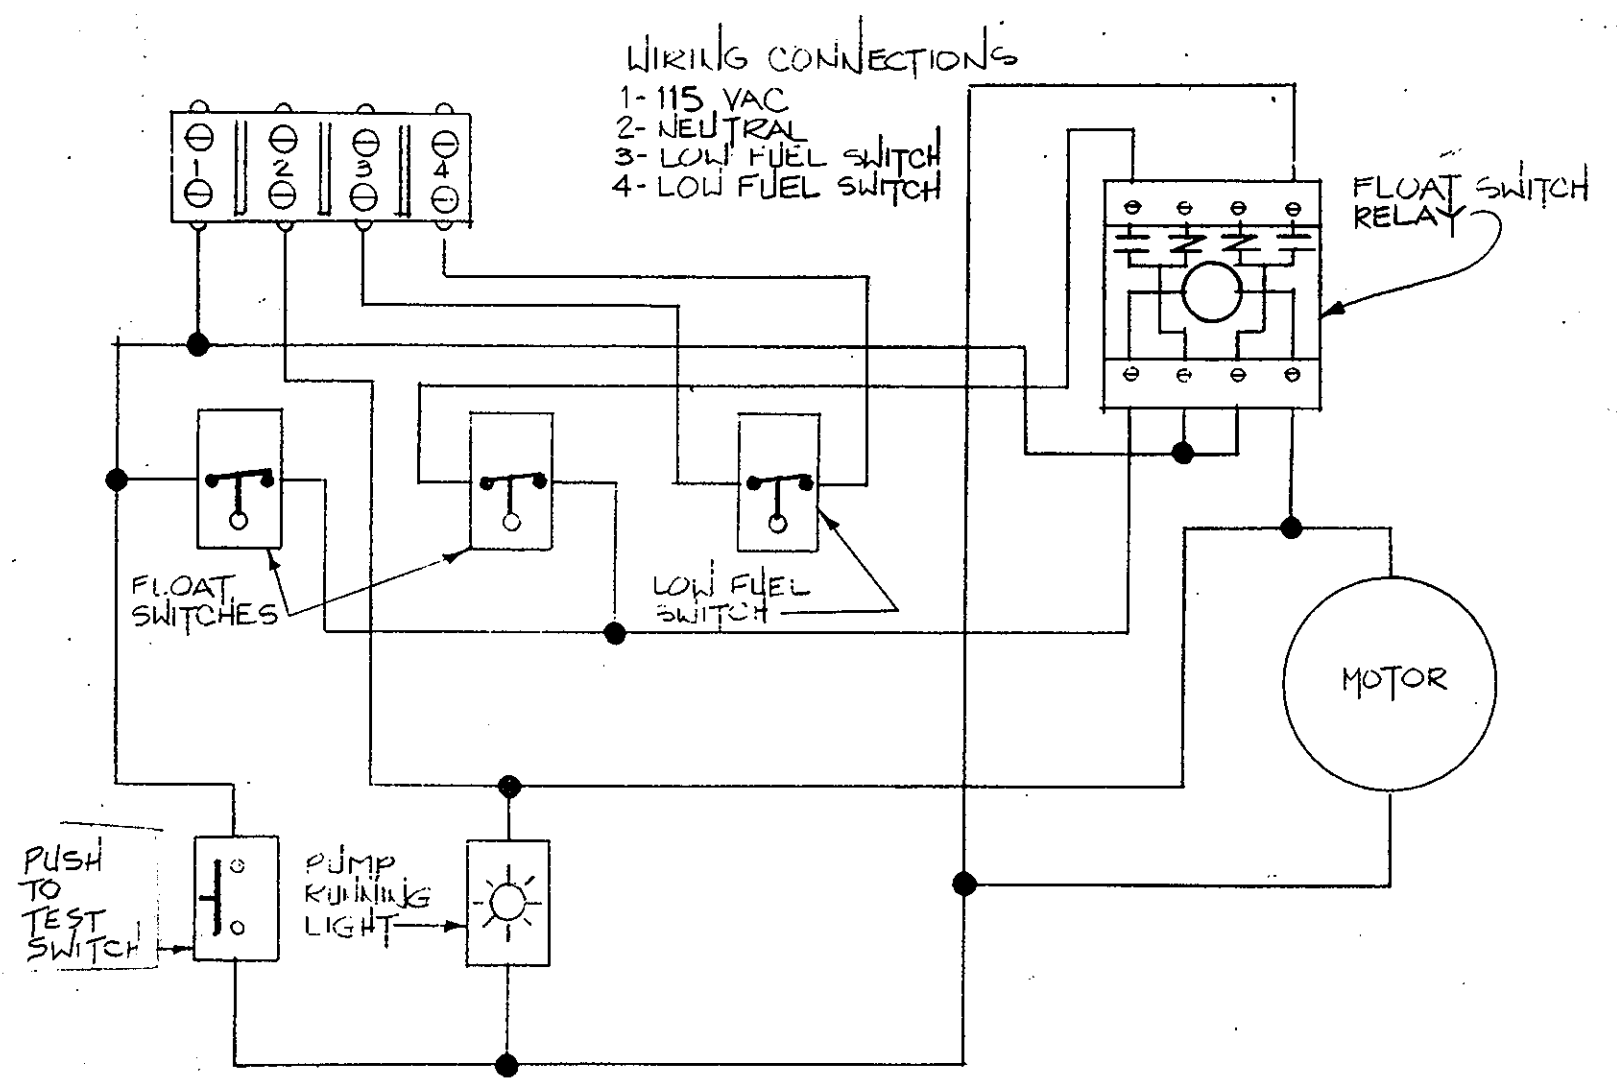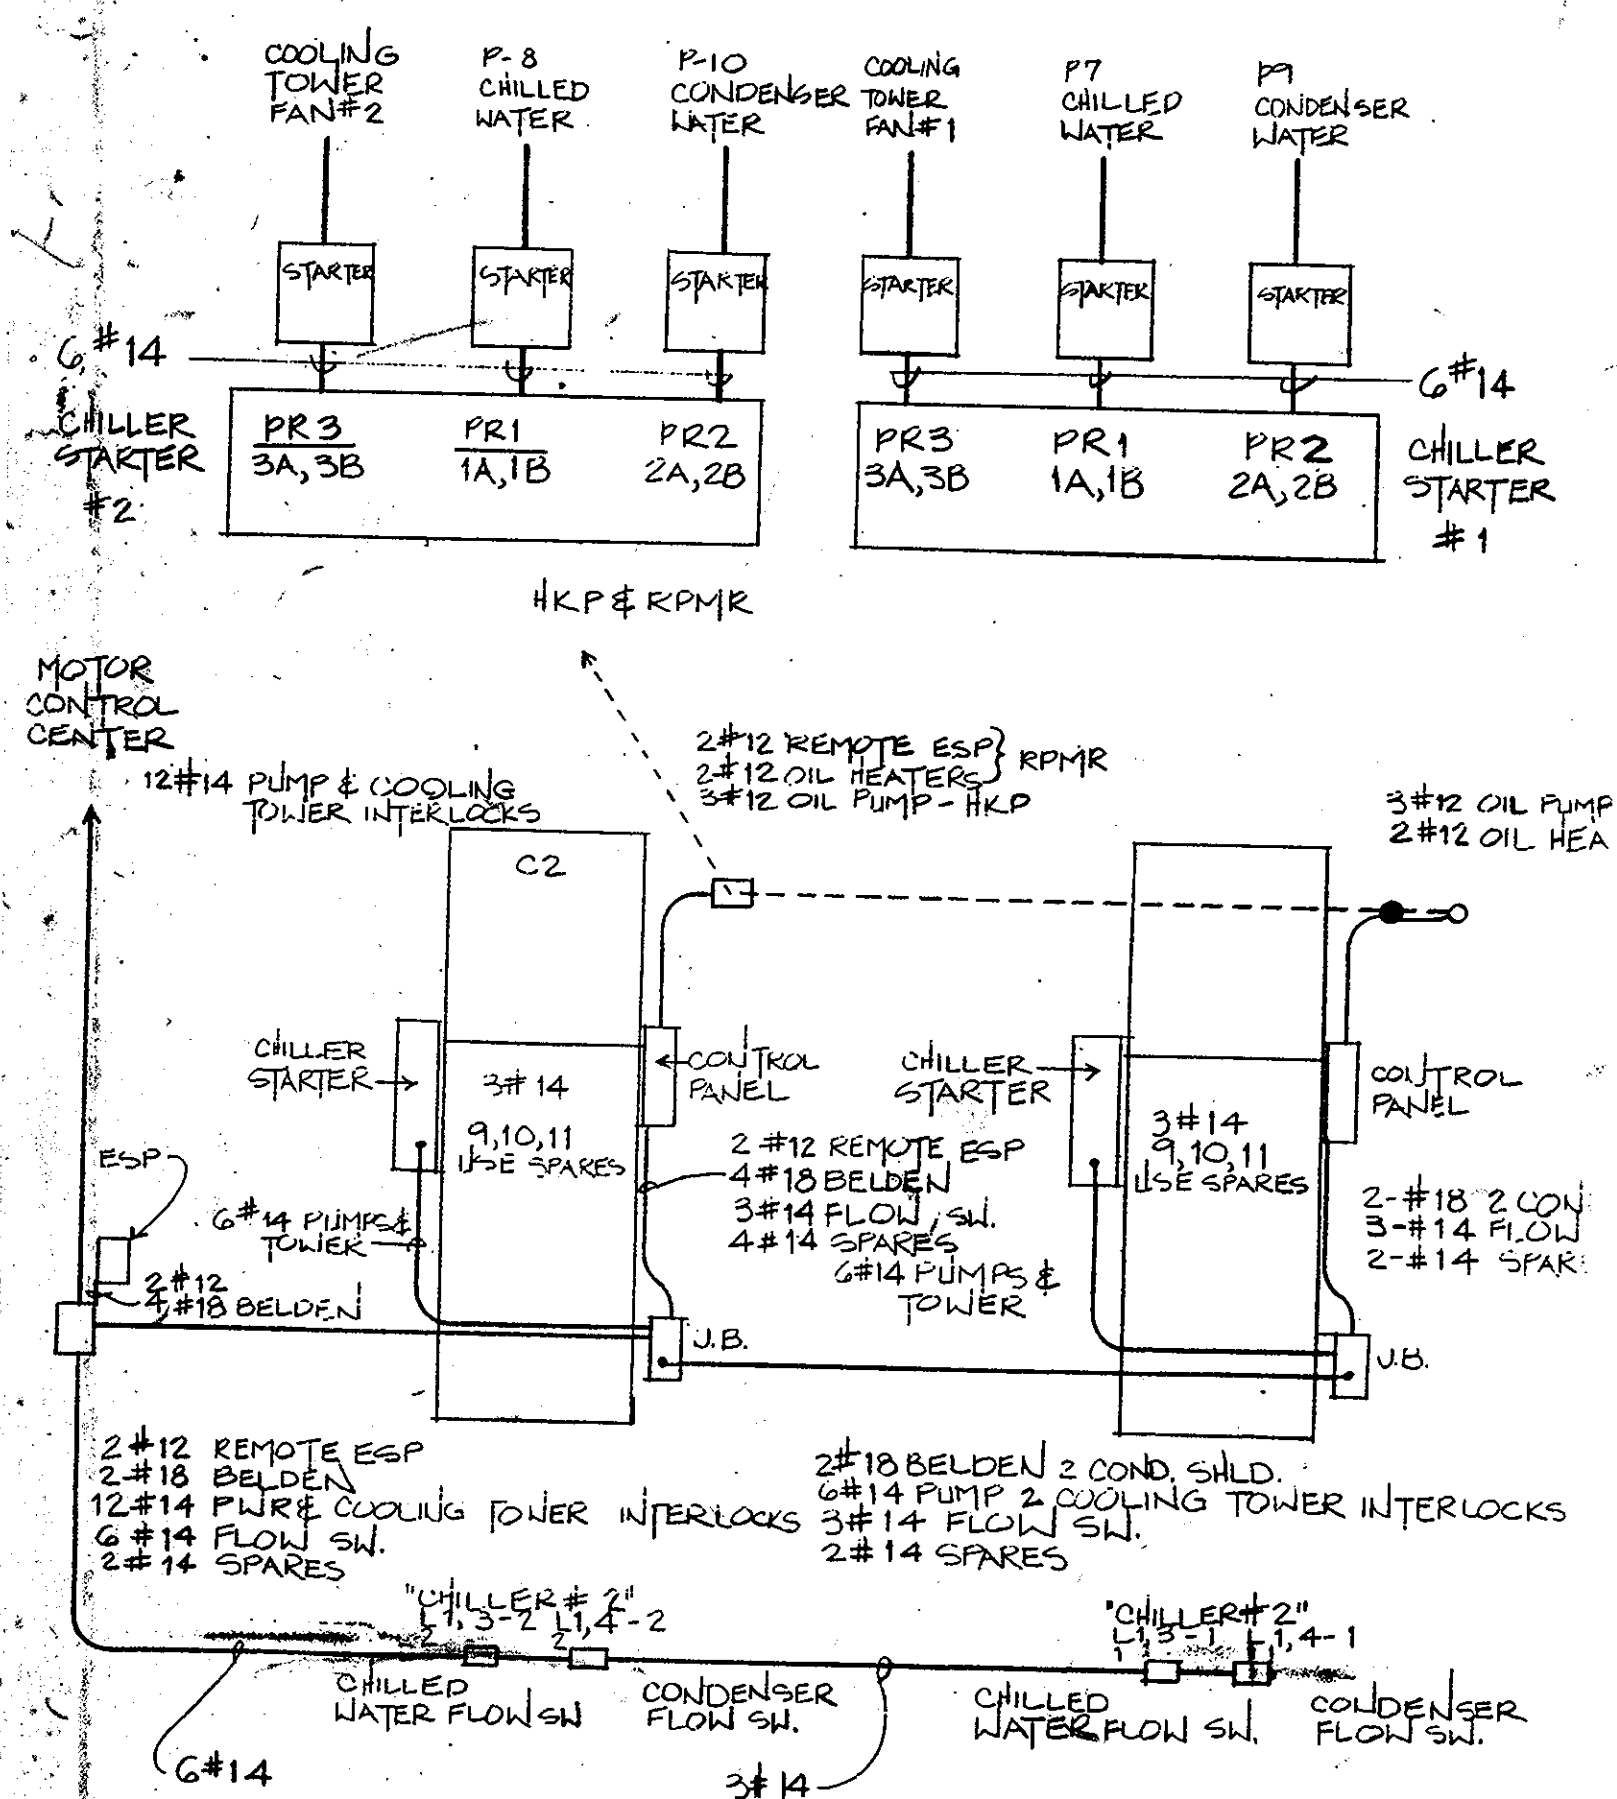

LIGHT FIXTURE SCHEDULE						
MAIN HOSPITAL BUILDING						
TYPE	MANUFACTURER	CATALOG NO.	LAMPS	FINISH	MOUNTING	REMARKS
A	WILLIAMS †	4424-SMKA-110	4 - F40CW/200	WHITE	R	277V
B/B	WILLIAMS †	4423-SMKA-110	3 - F40CW/150	WHITE	R	277V FURNISH TYPE BS WITH KSH TYPE K-15 LENS (CLEAR)
C/C	WILLIAMS †	4422-SMKA-110	2 - F40CW/100	WHITE	R	277V FURNISH TYPE CS WITH KSH TYPE K-15 LENS (CLEAR)
D/D	WILLIAMS †	4421-SMKA-110	2 - F40U/6/100	WHITE	R	277V FURNISH TYPE CS WITH KSH TYPE K-15 LENS (CLEAR)
E	MARCO ††	0301124	1 - 150/840	WHITE	R	
F	MARCO ††	0301121	1 - 150/840	WHITE	R	
G	MARCO ††	MW775-72	1-MH3AN-675/DA	WHITE	R	277V
H	MARCO ††	M028158	1-H37K-285/01	WHITE	R	277V PROVIDE W/NECESSARY SLOPED CEILING ADAPTER.
J	WILLIAMS †	7520	1 - F40CW/100	WHITE	S	277V
K	WILLIAMS †	8022	2 - F40CW/100	WHITE	S	277V
L	KIRLIN **	9904126	2 - F40U/6/100	WHITE	R	277V FURNISH W/ MED. SECURITY GLASS/PLASTIC OVERLAY LENS
N	KIRLIN **	990424	2 - F40CW/100	WHITE	R	277V FURNISH W/ MED. SECURITY GLASS/PLASTIC OVERLAY LENS
N	KIRLIN **	990390	2 - F40CW/100	WHITE	S	277V FURNISH W/ MED. SECURITY GLASS/PLASTIC OVERLAY LENS
P	PASS & SEYMOUR	44	1 - 100W-19/100	WHITE	S	
R	KIRLIN **	1203-10	1 - 100W-21/100	WHITE	R	
S	PEARLESS †	30-L0602-	1 - F40CW/50/74 SEC.	WHITE	S	277V SEE FLOOR PLAN FOR LENGTH AND DIMENSIONS
T	PEARLESS †	30-L041-0113	1 - F40CW/50/74 SEC.	WHITE	S	277V SEE FLOOR PLAN FOR LENGTH AND DIMENSIONS
U	PEARLESS †	30-L06003	2 - F40CW/50/74 SEC.	WHITE	BRACKET	277V SEE FLOOR PLAN FOR LENGTH AND DIMENSIONS
V	HUBBELL ††	M85-301	1 - 150/840/75	BRONZE	S	(120V)
W	MOLDCAST X	9202-27-RZ-1FU-1PH	1 - LUM00/435	BRONZE	R	120V MOUNT FIXTURE EVEN WITH TOP OF FIRST FLOOR WINDOW
X	DUAL-LITE =	EXQUISITE	2 - 2576/145	WHITE	S	277V
Y	WILLIAMS †	8922-08-0PM-277V	2 - F40CW/100	WHITE	S	277V
AA	HUBBELL X X	M85-3400M-EU	1 - MVR400/435	SILVER/GRAY	S	277V
BB	MORRIS-KURTZON †	LM40-03	1 - LUM00/435	STAINLESS STEEL	S	277V MOUNT FIXTURE 14" A.F.F.
CC	WILLIAMS †	89F-0122-FMKA-110	2 - F40CW/100	WHITE	R	277V CHANNELED TRACK BRASS
DD	WILLIAMS †	2900-6A	1 - F40CW/50	WHITE	S	277V
EE	MARCO ††	M40-4615	1 - 75-19/75	WHITE	R	
FF	PROGRESS ©	P5696	2 - 80W-19/100	WHITE/CHROME	S	
GG						
HH	COLUMBIA	AL110-43-VARIABLES	1 - F40CW/100	WHITE/CHROME	S	277V
JJ	WILLIAMS †	8722A	2 - F40CW/100	GRAY	S	277V
KK	MARCO ††	M026158	125	WHITE	R	277V
LL	WILLIAMS †	4122-SMKA-110	2 - F40CW/100	WHITE	R	277V
MM	WILLIAMS †	89F-5224-FMKA-110	4 - F40CW/200	WHITE	R	277V
NN	JUNO **	TRACK MASTER PB	1 - 150-840/150	POLISHED BRASS	SURFACE	PROVIDE STAFF DINING AREA W/120V TRACK HEADS TOTAL
PP	JUNO **	TRACK MASTER PB	1 - 150-840/150	POLISHED BRASS	SURFACE	PROVIDE PATIENT DINING AREA W/40 120V TRACK HEADS TOTAL
QQ	WILLIAMS †	89F-5223-SMKA-110	3 - F40CW/150	WHITE	R	277V
RR	MARCO ††	M0335674	1 - 125	WHITE	R	277V PROVIDE WITH NECESSARY SLOPED CEILING ADAPTER
TT	PROGRESS ©	P1372	1 - 32W CIR. 1 - 32W CIR. 1 - 32W CIR.	WHITE	S	120V
UU	WILLIAMS †	89F-5262-FMKA-110	2 - F40CW/100	WHITE	R	277V
VV	KIRLIN **	9904123	1 - 40W/100/50	WHITE	S	120V
WW	KENALL © ©	4450	1 - 22W/812	CLEAR	S	
XX	ALCO †††	M8546	1 - 75/30/20	WHITE	S	120V MOUNT UNDER COUNTER
YY	COLUMBIA	T14-140 W/LENS	1 - F40CW/50	WHITE	S	277V BRACKET MOUNTED
ZZ	QUALITY LIGHTING	410-130-120 MS100CLX	1 - LUM00/125	STAINLESS STEEL	S	
AB	WILLIAMS †	7434	1 - F40T12CW/110	WHITE	IN COVE	277V
AC	WILLIAMS †	7510	1 - F40T12CW/42	WHITE	IN CAB.	277V
SA	LST *	CT4-400PS-F 480V	1 - LUM00/435	BRONZE	S	PROVIDE W/30" SO. STEEL POLE-PAINT TO MATCH FIXT
SB	LST *	80C-5100-HP5-42-120-8R2	1 - LUM00/125	BRONZE	S	

\* NOTE: THESE MANUFACTURERS AND CATALOG NUMBERS ARE NOTED AS A BASIS FOR THE LIGHT FIXTURE TYPES. OTHER FIXTURES OF SAME QUALITY, STYLE AND CHARACTERISTICS OF THE MANUFACTURERS LISTED BELOW ARE EQUALLY ACCEPTABLE. SYMBOLS CORRELATE ALTERNATE MANUFACTURERS WITH FIXTURE TYPE. FLUORESCENT FIXTURES OF SAME STYLE WITH EQUIVALENT LUMEN OUTPUT MAY BE ACCEPTABLE.

† DAYBRITE, COLUMBIA †† OMEGA, PRESCOLITE \*\* FAILSAFE, MARK  
 †† SLATER, EAGLE † STERNER, LINEAR †† ACME DUNBAR, KENALL  
 = PRESCOLITE, EMERGI-LITE X HUBBELL, KIM X KEENE, MILLER  
 © KEYSTONE, LIGHTOLIER © © ACME DUNBAR FAILSAFE  
 \* MOLDCAST, QUALITY LIGHTING \*\* MOLDCAST, HUBBELL \*\* NL, LIGHTOLIER  
 ††† PRESCOLITE, PROGRESS \* QUALITY LIGHTING, LAM  
 \* = HUBBELL, DEVINE

This record drawing has been prepared in part, by Colton/Lester Corporation, based upon information furnished by others. While this information is believed to be reliable, the Engineer cannot assure its accuracy, and thus is not responsible for the accuracy of this record drawing or for any errors or omissions which may have been incorporated into it as a result. Those relying on this record document are advised to obtain independent verification of its accuracy before applying it for any purpose.

DRAWING TITLE:  
**LIGHTING SCHEDULE**

SCALE:

REVISIONS:

**RECORD DRAWING**

SHEET NUMBER:  
**E25**

PROJECT NUMBER:  
83013

ISSUE DATE:  
6-27-85


FOR REFERENCE ONLY

**GENERAL NOTES:**

- REFER TO SHEET M-9 FOR PIPING.
- ALL ELBOWS, FITTINGS, ETC., IN DUCTWORK ARE NOT NECESSARILY INDICATED TO CLEAR ALL JOBS OBSTRUCTIONS.
- DUE TO THE LIMITED SPACE AVAILABLE TO INSTALL, ALL OF THE MECHANICAL WORK, CLOSE COORDINATION BETWEEN THE VARIOUS TRADES IS OF THE UTMOST IMPORTANCE.

**KEYED NOTES:**

- SMOKE DAMPER IN DUCT AT THIS LOCATION.
- FIRE DAMPER IN DUCT AT THIS LOCATION.
- COMBINATION SMOKE/FIRE DAMPER IN DUCT AT THIS LOCATION.

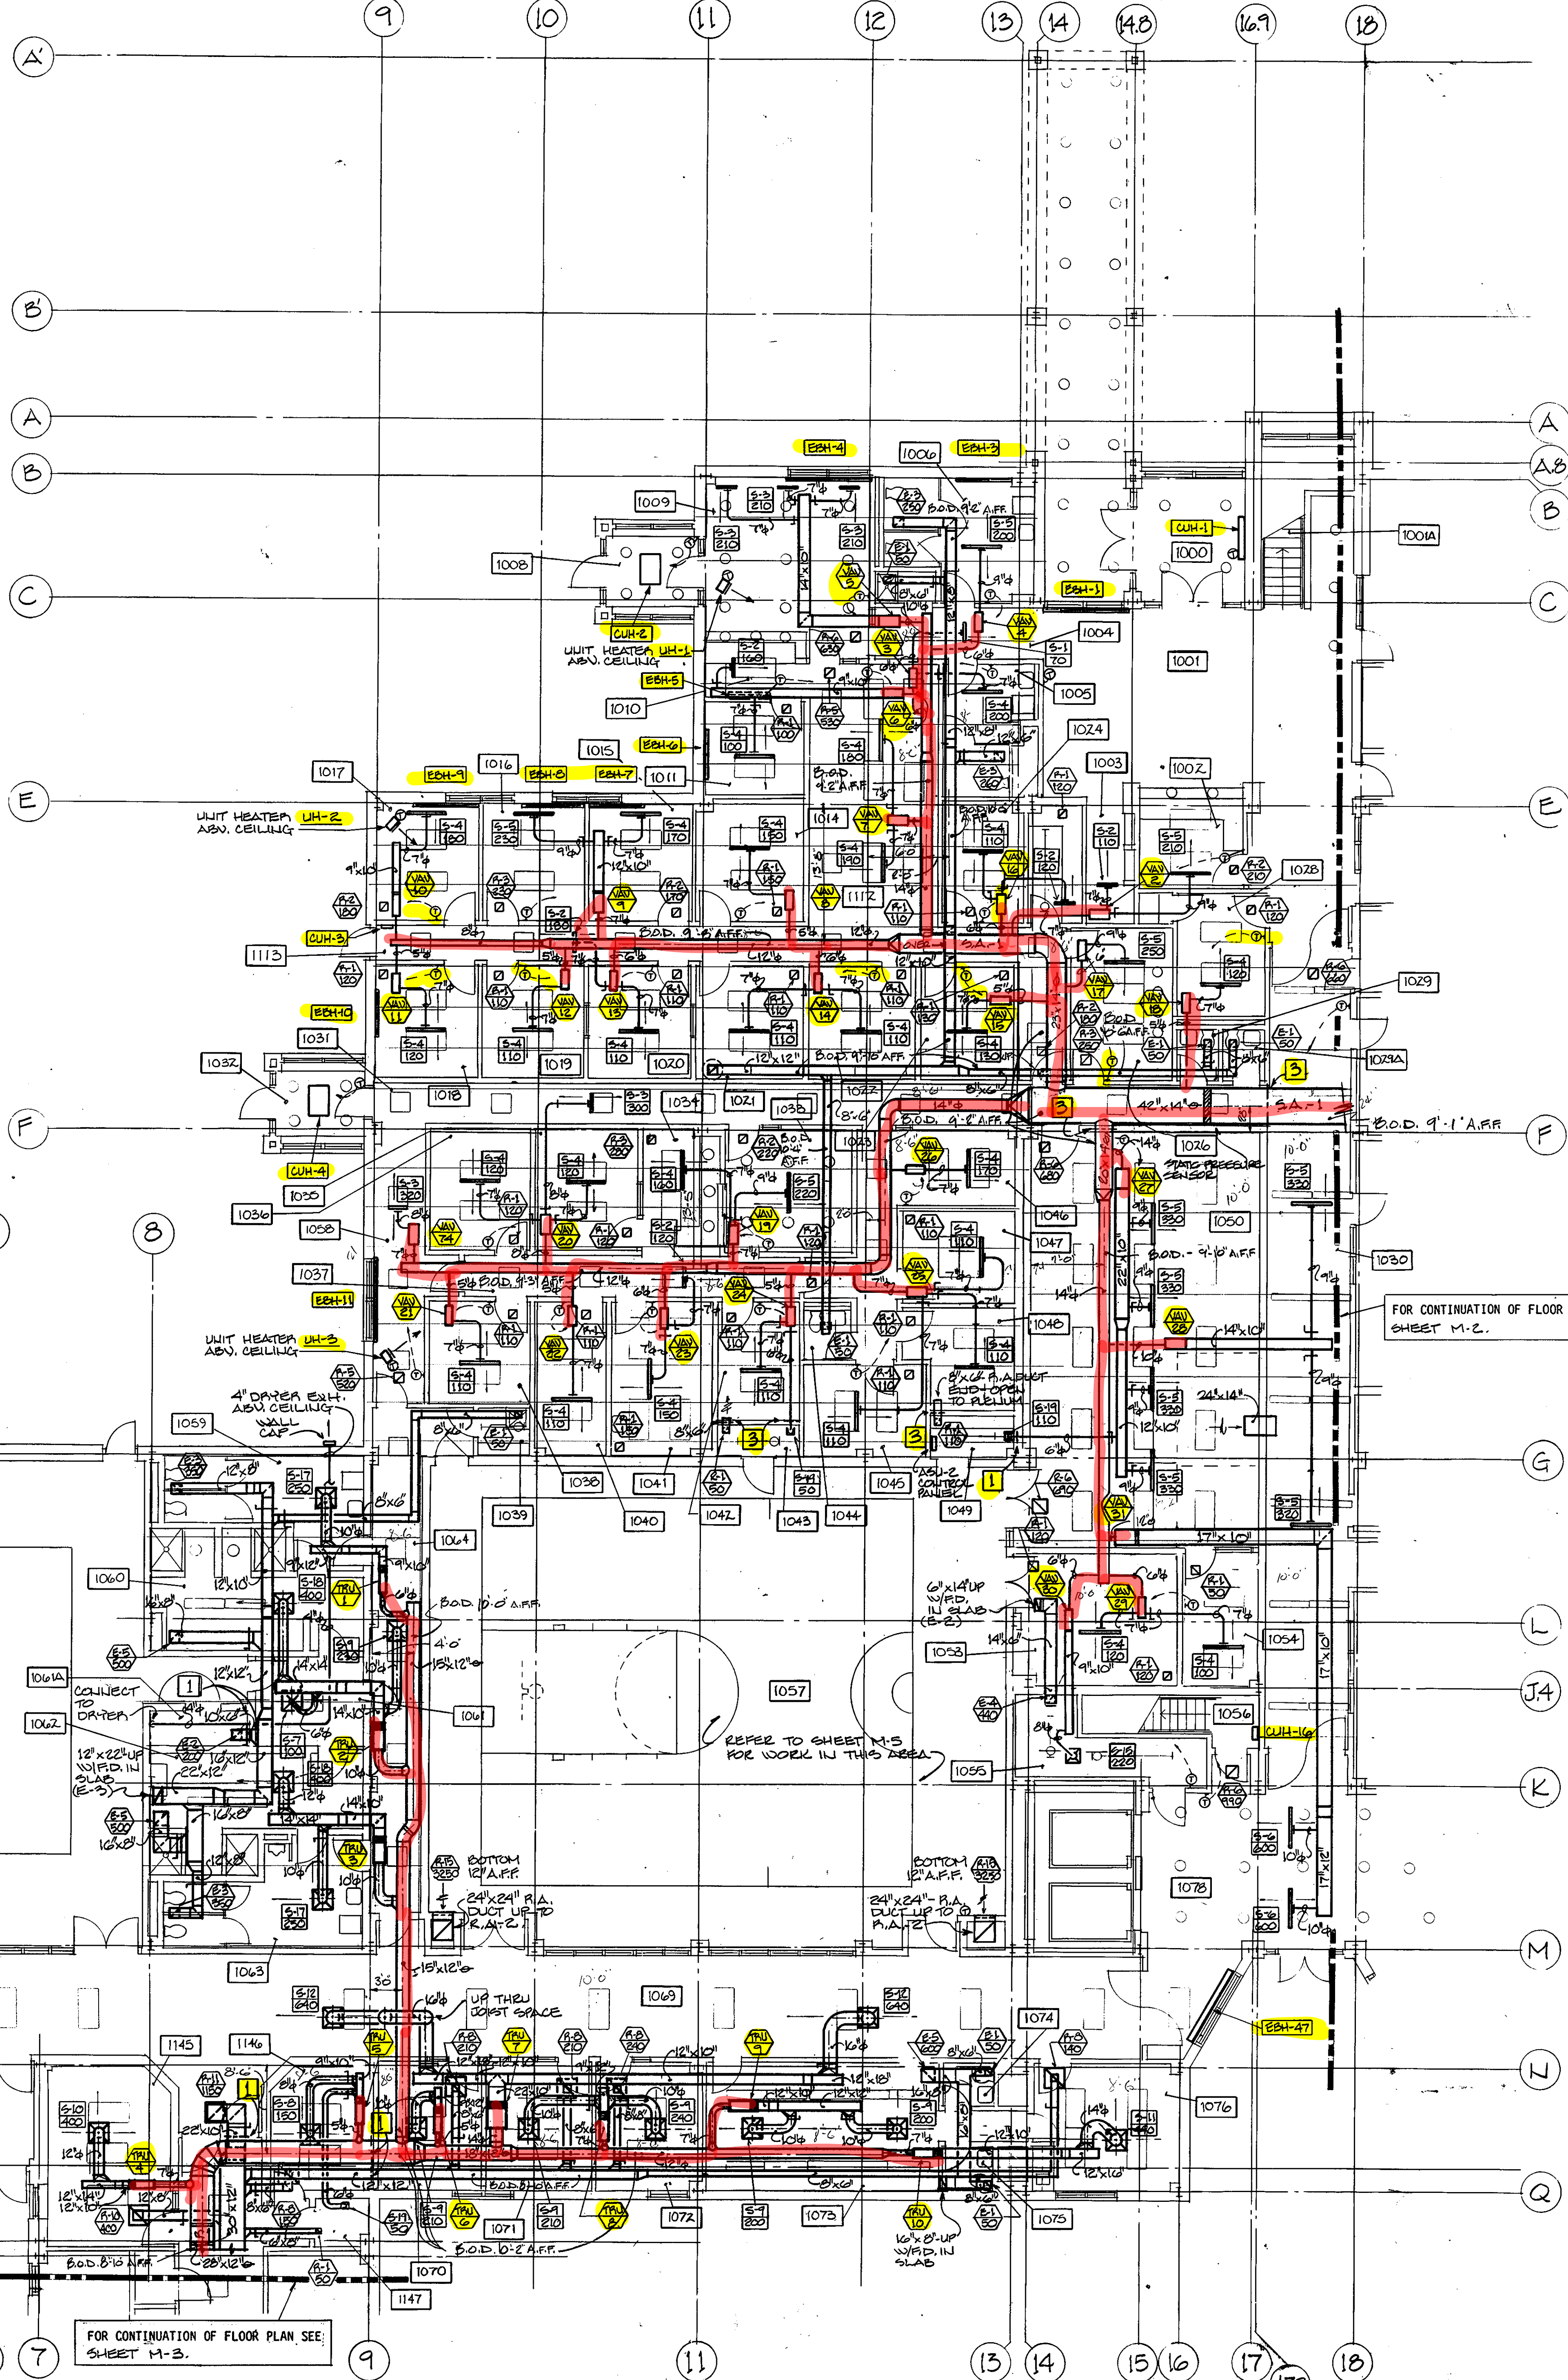


ROOM SCHEDULE	
1000	LOBBY
1001	MAIN ENTRY VESTIBULE
1002	RECEPTION
1003	RECEPTIONIST
1004	TELEPHONE
1005	CORRIDOR
1006	PUBLIC MALE TOILET
1007	PUBLIC FEMALE TOILET
1008	JANITORS CLOSET
1009	VESTIBULE
1010	WAITING
1011	RECEPTIONIST
1012	RECORDS STORAGE
1013	OFFICE WORK AREA
1014	PASSAGE
1015	NURSE'S STATION/OFFICE
1016	UNIT DIRECTORS OFFICE
1017	SOCIAL WORKERS OFFICE
1018	PSYCHIATRIST OFFICE
1019	UNIT DIRECTORS OFFICE
1020	PSYCHIATRIST OFFICE
1021	PSYCHOLOGIST OFFICE
1022	THERAPY
1023	PSYCHOLOGIST OFFICE
1024	BIOPHYSICS/EXAM
1025	CONFERENCE ROOM
1026	STORAGE
1027	CONFERENCE ROOM
1028	PASSAGE
1029	MAIL ROOM
1030	STORAGE CLOSET
1031	CIRCULATION
1032	STAFF MALE TOILET
1033	STAFF FEMALE TOILET
1034	CORRIDOR
1035	PASSAGE
1036	VESTIBULE
1037	ADMITTING CLERK
1038	ADMITTING CLERK
**MECHANICAL DRAWING INDEX**

- M1 Partial First Floor Ductwork-Area F1
- M2 Partial First Floor Ductwork-Area F2
- M3 Partial First Floor Ductwork-Area F3
- M4 Partial First Floor Ductwork-Area F4
- M5 Partial Second Floor Ductwork-Area S1
- M6 Partial Second Floor Ductwork-Area S2
- M7 Partial Second Floor Ductwork-Area S3
- M8 Partial Second Floor Ductwork-Area S4
- M9 Partial First Floor Piping-Area F1
- M10 Partial First Floor Piping-Area F2
- M11 Partial First Floor Piping-Area F3
- M12 Partial First Floor Piping-Area F4
- M13 Partial Second Floor Piping-Area S1
- M14 Partial Second Floor Piping-Area S2
- M15 Partial Second Floor Piping-Area S3
- M16 Partial Second Floor Piping-Area S4
- M17 Roof Plan
- M18 Mechanical Equipment Room Plan
- M19 Piping Diagram
- M20 Schedules
- M21 Schedules
- M22 Schedules
- M23 Details
- M24 Details
- M25 Details
- M26 Group Home Plan

A-S Built  
6-8-87  
Richard Sides

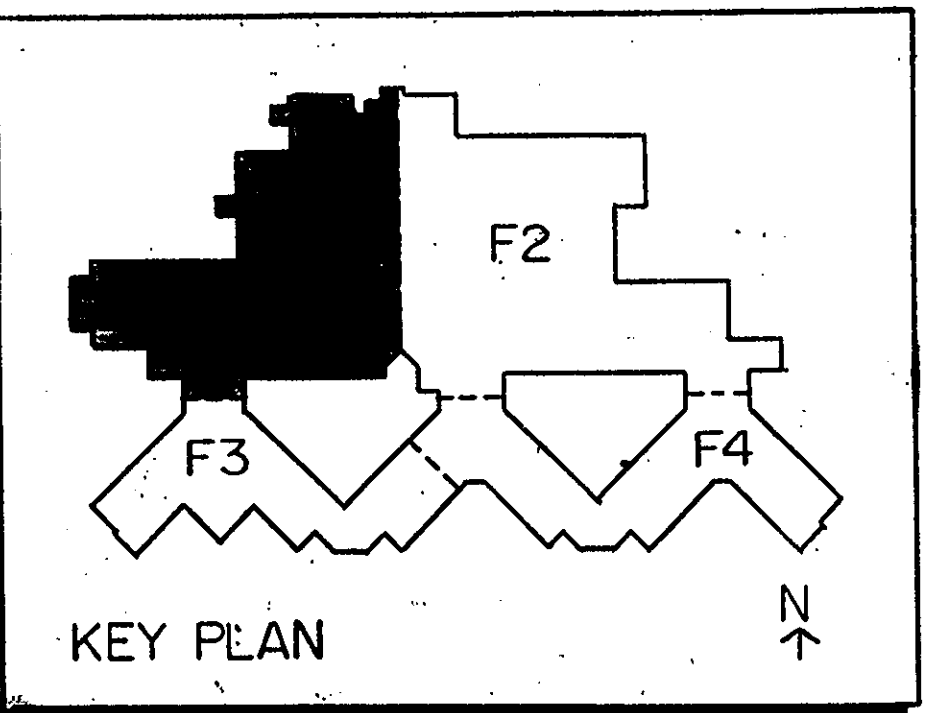

TRUE NORTH  
PLAN NORTH

**DRAWING TITLE:**  
PARTIAL FIRST FLOOR  
DUCTWORK - AREA F1

SCALE: 1/8" = 1'-0"

REVISIONS:


MEDICAL ONLY

303-824-9707

REGISTERED PROFESSIONAL ENGINEER  
AROLD COLTON  
NUMBER 12345  
EXPIRES 12/31/2000

30 SOUTH HANLEY RD. CLAYTON, MISSOURI 63106 314-725-2927 - 11 W. VICTORY WAY - CRAIG, COLORADO 81625

**FOR REFERENCE ONLY**


SHEET NUMBER:  
**M1**

PROJECT NUMBER:  
83013

ISSUE DATE:  
6-27-85

THE CHRISNER PARTNERSHIP INC. ARCHITECTS AND PLANNERS



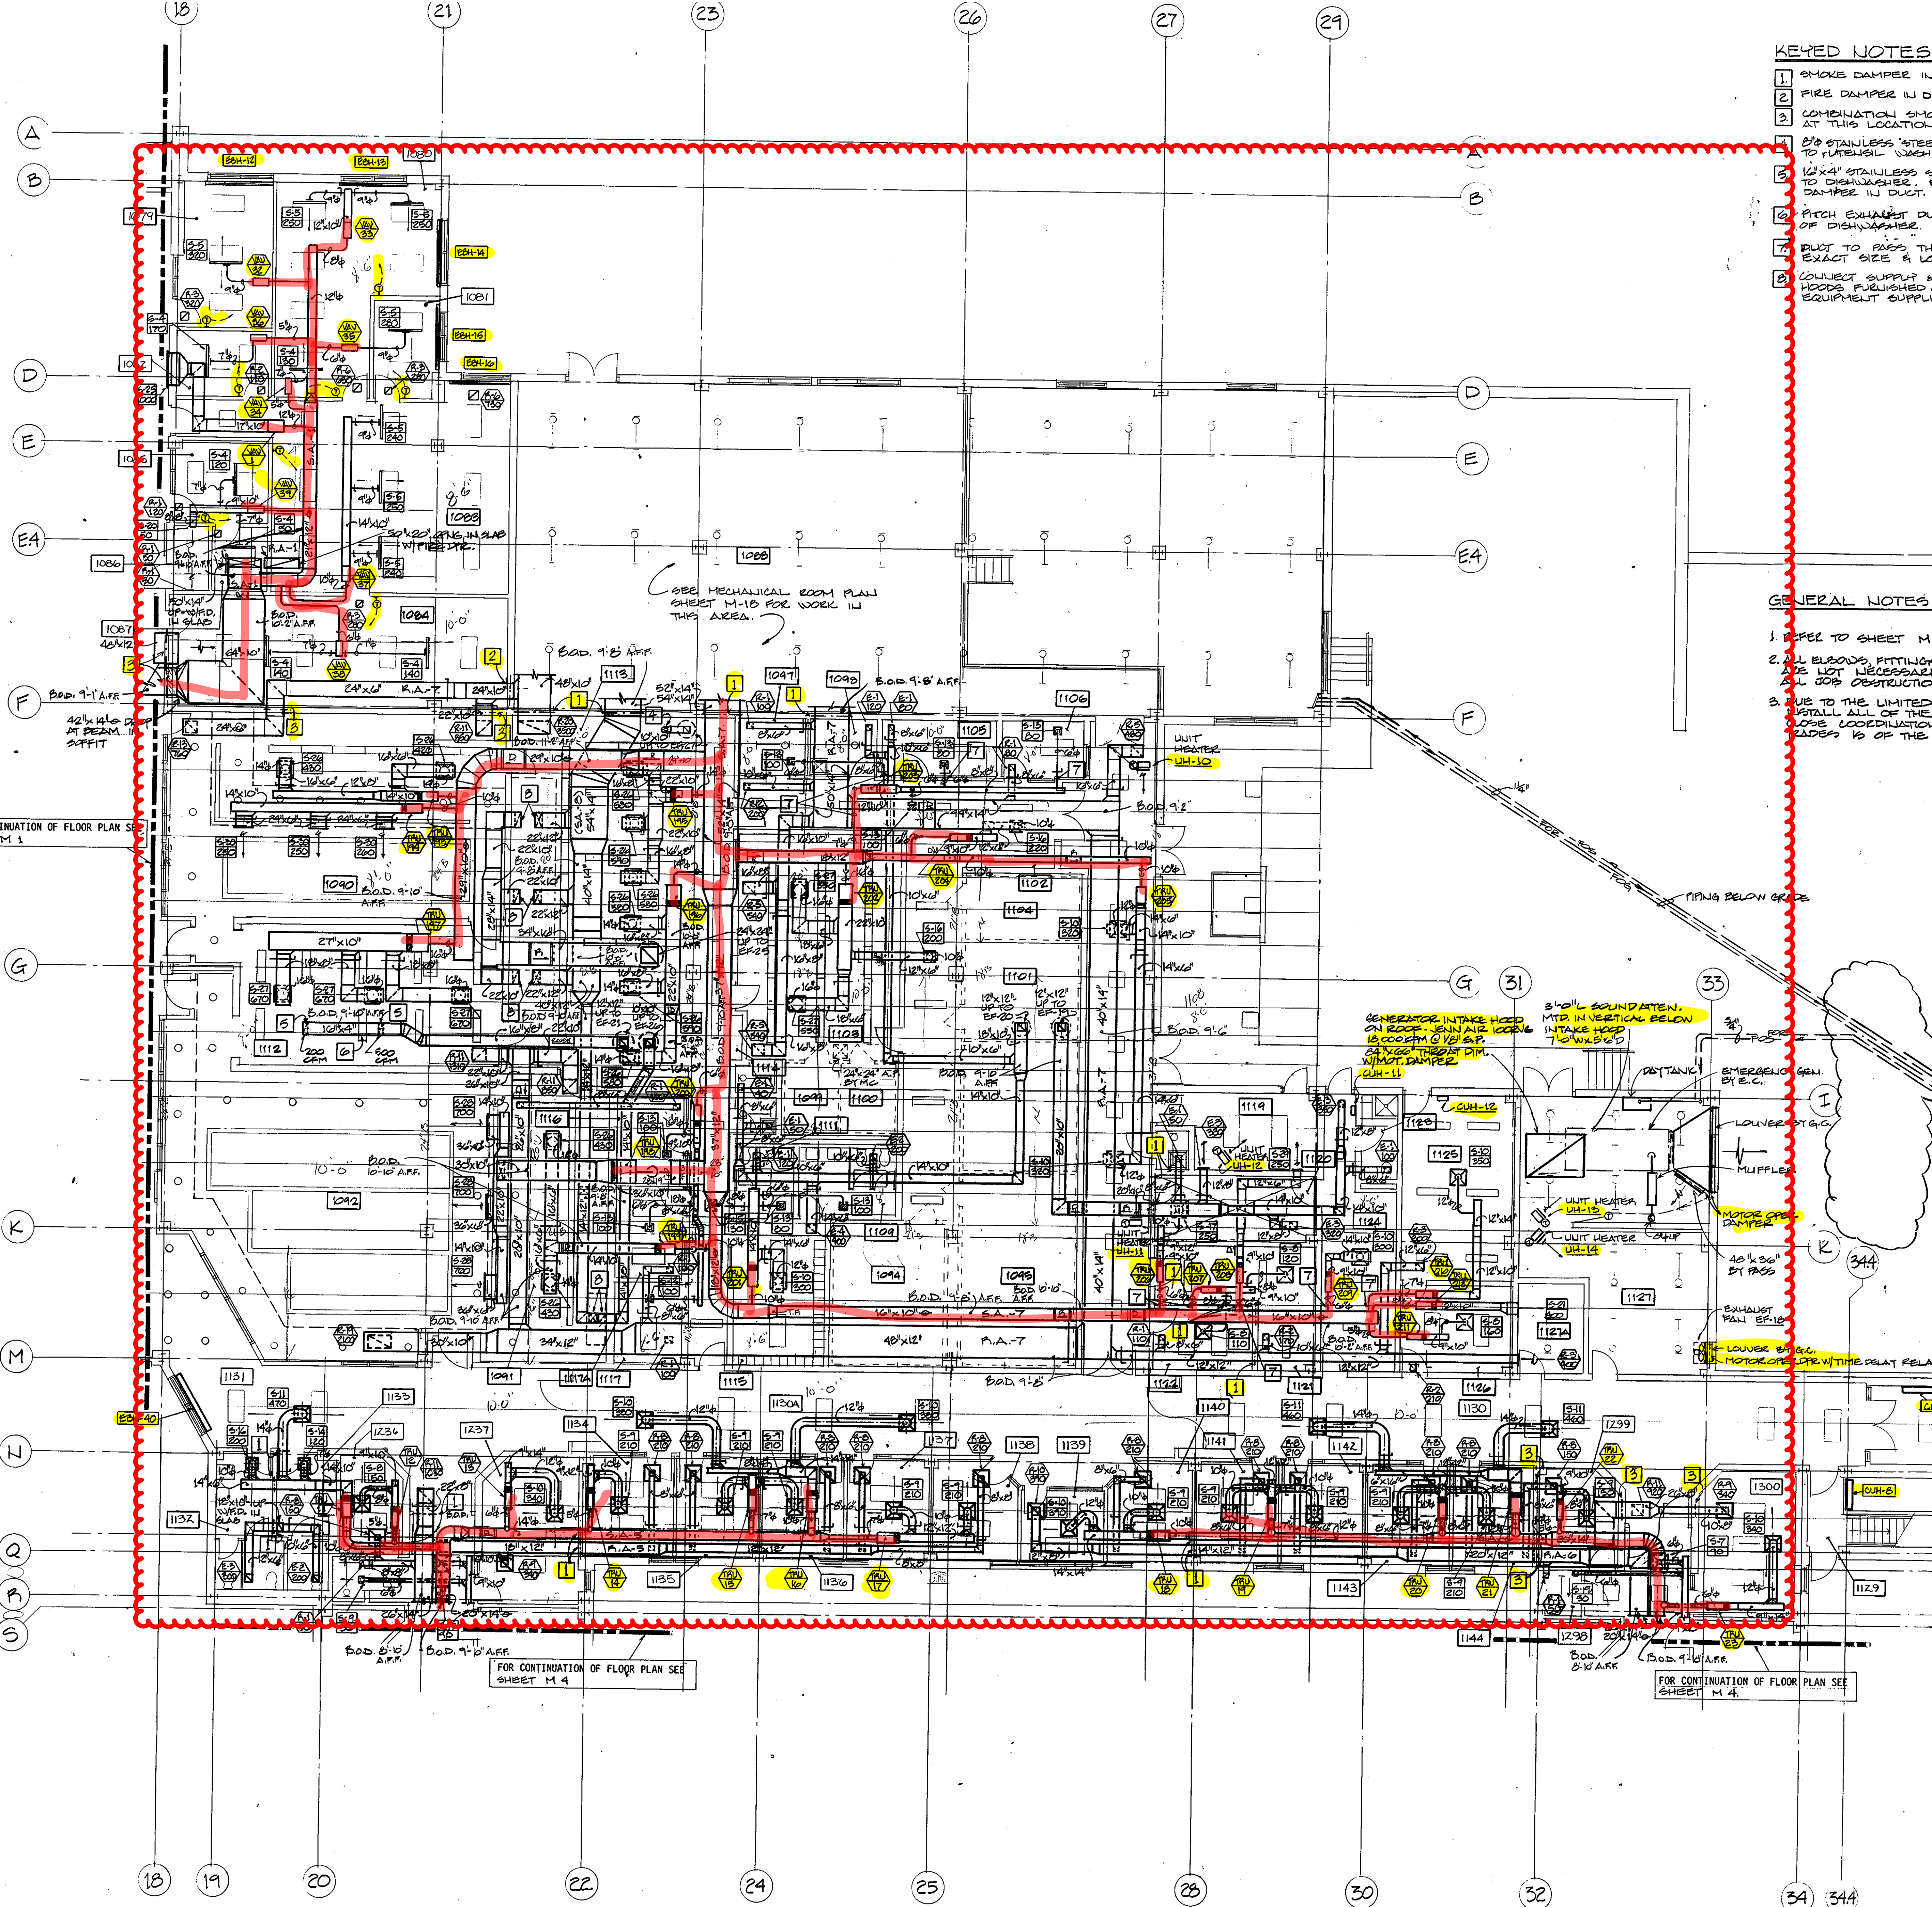

**KEYED NOTES:**


1. SMOKE DAMPER IN DUCT AT THIS LOCATION.
2. FIRE DAMPER IN DUCT AT THIS LOCATION.
3. COMBINATION SMOKE/FIRE DAMPER IN DUCT AT THIS LOCATION.
4. 6" STAINLESS STEEL EXHAUST DUCT-CONNECT TO FURNACE W/ASHER.
5. 12"x4" STAINLESS STEEL EXHAUST DUCT-CONNECT TO DISHWASHER. PROVIDE LOCKING BALANCING DAMPER IN DUCT.
6. PATCH EXHAUST DUCT TOWARD BOILER END OF DISHWASHER.
7. DUCT TO PASS THRU WEBB OF JOISTS. VERIFY EXACT SIZE & LOCATION IN FIELD.
8. COLLECT SUPPLY & EXHAUST DUCT TO HOODS. HOODS FURNISHED & INSTALLED BY KITCHEN EQUIPMENT SUPPLIER.

**GENERAL NOTES:**

1. REFER TO SHEET M-10 FOR PIPING.
2. ALL ELBOWS, FITTINGS, ETC., IN DUCTWORK ARE NOT NECESSARILY INDICATED TO CLEAR ALL JOB OBSTRUCTIONS.
3. DUE TO THE LIMITED SPACE AVAILABLE TO INSTALL ALL OF THE MECHANICAL WORK, CLOSE COORDINATION BETWEEN THE VARIOUS TRADES IS OF THE UTMOST IMPORTANCE.

**ROOM SCHEDULE:**

1079	GIFT SHOP
1080	OPEN WORK AREA
1081	DIRECTORS OFFICE
1082	TRANS. EQUIP. ROOM
1083	OPEN WORK AREA
1084	RECORD STORAGE
1085	SECURITY OFFICE
1086	ELECTRICAL CLOSET
1087	STORAGE
1088	MECHANICAL ROOM
1089	STAFF DINING
1090	PATIENT DINING
1091	PATIENT DINING
1092	PASSAGE
1093	PASSAGE
1094	FREEZER
1095	DAILY REFRIGERATOR
1096	REFRIGERATOR
1097	ELECTRICAL CLOSET
1098	JANITORS CLOSET
1099	REFRIGERATOR
1100	FREEZER
1101	PRODUCE REFRIGERATOR
1102	RECEIVING
1103	INGREDIENT ROOM
1104	CEREAL/GRAIN STORAGE
1105	PAPER/CHEMICAL STORAGE
1106	RECEIVING OFFICE
1107	JANITORS CLOSET
1108	JANITORS CLOSET
1109	CORRIDOR
1110	FEMALE TOILET
1111	MALE TOILET
1112	DISHWASHING AREA
1113	PREDUCTION AREA
1114	ASSEMBLY AREA
1115	LOCKER ROOM
1116	FOOD SERVICE MANAGER/DIETITIAN
1117	FOOD SERVICE DIRECTORS OFFICE
1118	DIETITIAN
1119	JANITOR CLOSET
1120	TRASH ROOM
1121	CART WASH
1122	SUPPLIES/STORAGE
1123	CUSTOMER SUPERVISORS OFFICE
1124	TOILET/BROWER
1125	SOLED LINEN
1126	BULK LINEN CART MAKE-UP
1127	EXCHANGE CART HOLDING
1128	ELECTRICAL ROOM
1129	VESTIBULE
1130	STAR NO. 4
1131	CORRIDOR
1132	CORRIDOR
1133	CORRIDOR
1134	PATIENT FEMALE TOILET
1135	PATIENT MALE TOILET
1136	INTERMEDIATE SHARED SUPPORT
1137	SOCIAL WORKERS OFFICE
1138	PSYCHIATRIST OFFICE
1139	ACTIVITY THERAPY SUPERVISORS OFFICE
1140	UNIT DIRECTORS OFFICE
1141	SECRETARY
1142	NURSE SUPERVISORS OFFICE
1143	SOCIAL WORKERS SUPERVISORS OFFICE
1144	PSYCHOLOGIST OFFICE
1145	PSYCHIATRIST OFFICE
1146	SOCIAL WORKERS OFFICE
1147	INTERMEDIATE
1148	ELECTRICAL CLOSET
1149	COUNSELING ROOM
1150	CONFERENCE ROOM
1151	ELECTRICAL CLOSET
1152	COUNSELING ROOM
1153	CONFERENCE ROOM
1154	CONFERENCE ROOM
1155	CONFERENCE ROOM

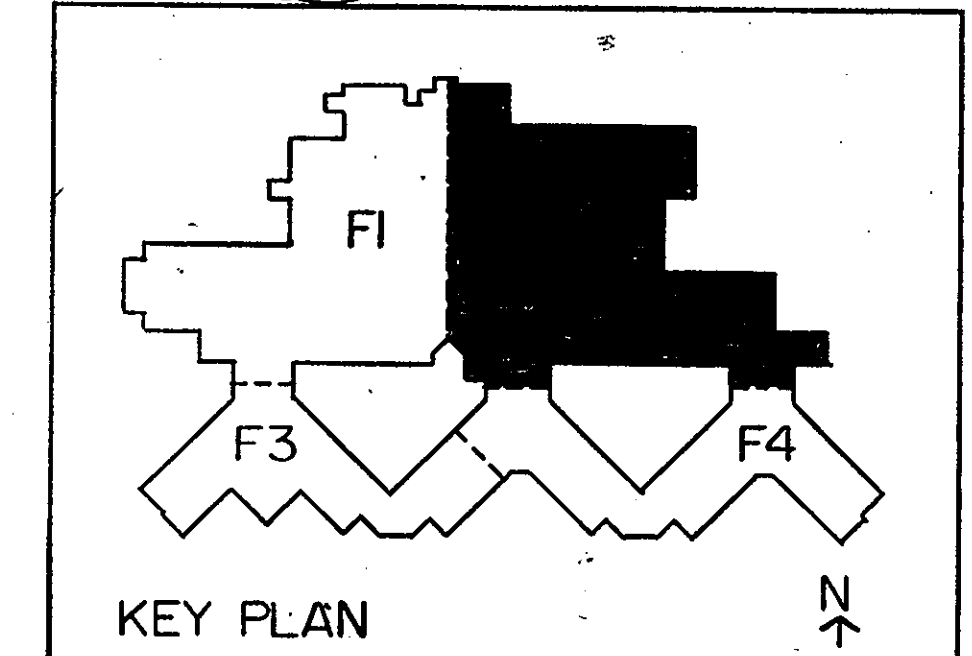


**DRAWING TITLE:**  
PARTIAL FIRST FLOOR  
DUCTWORK - AREA F2

**SCALE:** 1/8" = 1'-0"

**REVISIONS:**

1	1/24/06
---	---------


**FOR REFERENCE ONLY**  
 THE CHRISNER PARTNERSHIP INC. ARCHITECTS AND PLANNERS, 20 SOUTH HANLEY RD. CLAYTON, MISSOURI 63105 314-725-2927 - 11 W VICTORY WAY - CRAIG COLORADO 81625 303-824-9707  
 PROJECT NUMBER: 83013  
 ISSUE DATE: 6-27-85  
 A.S. BULLER 6-8-87  
 Richard D. Buller  
 SEE DRAWING M-4 FOR CONTINUATION

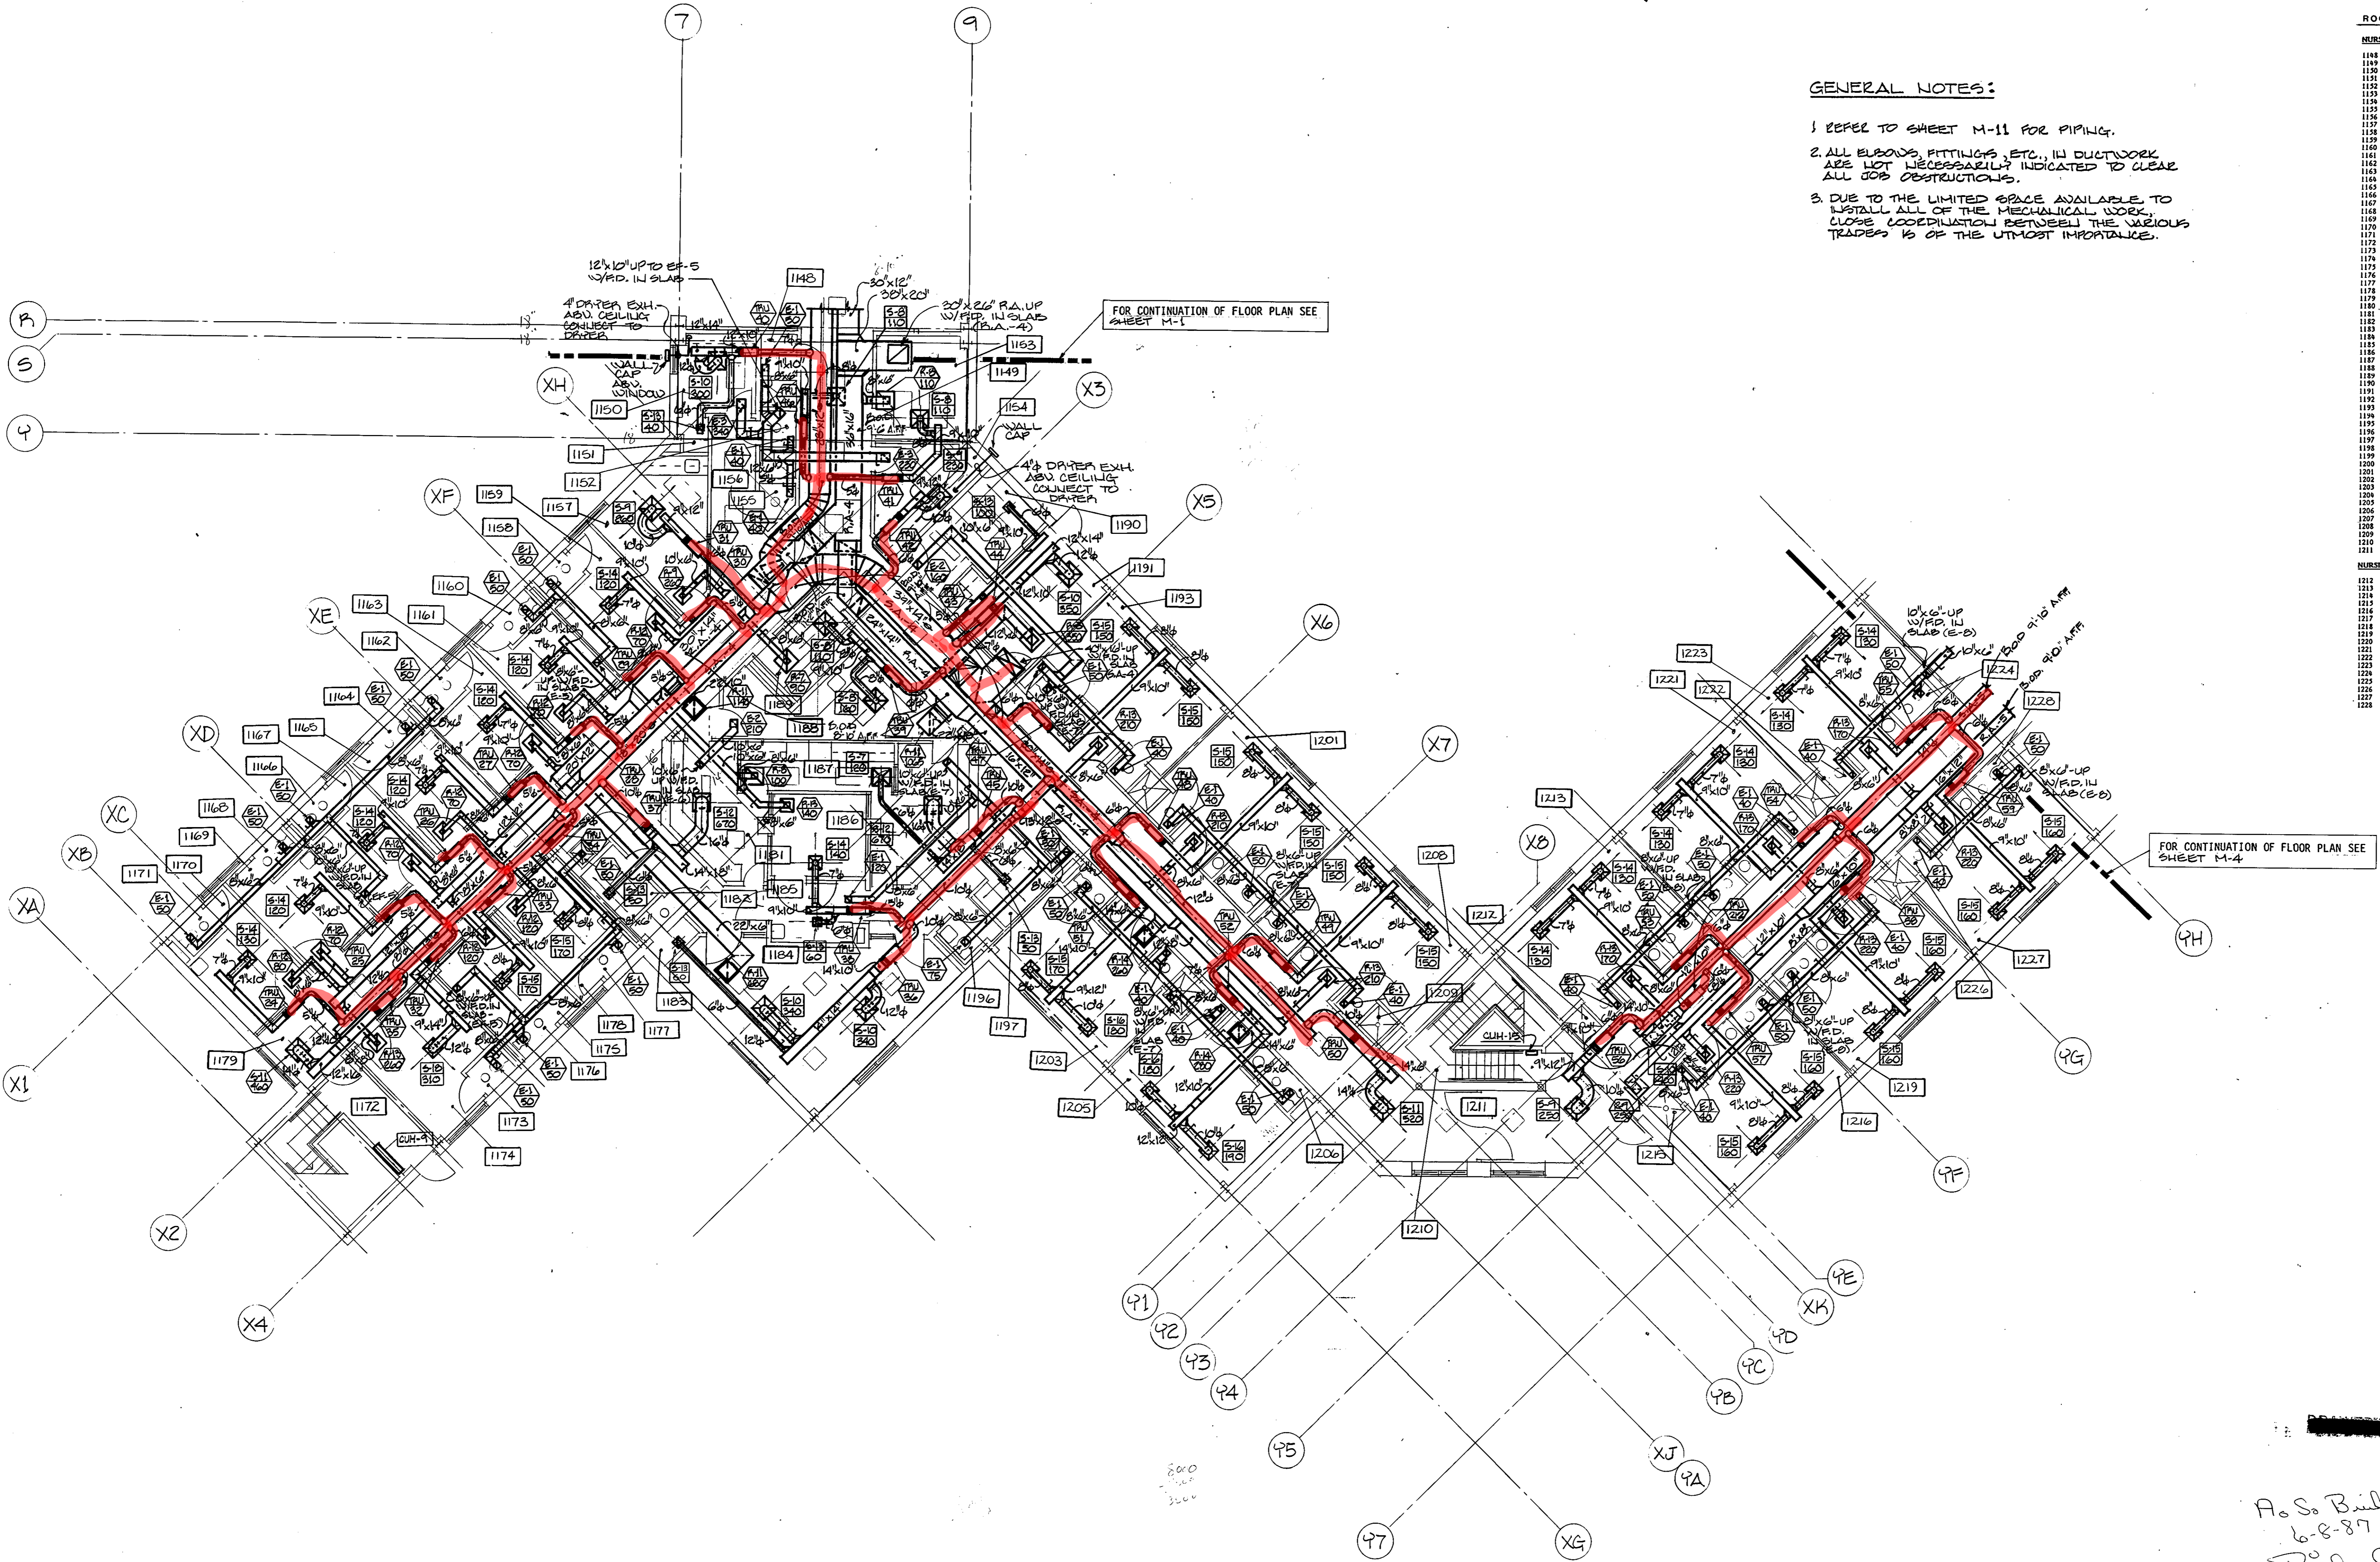

**ROOM SCHEDULE**

1142	TRASH ROOM
1143	CORRIDOR
1144	LAUNDRY
1145	STORAGE
1146	EXAM/TREATMENT ROOM
1147	LAUNDRY
1148	SHOWER ROOM
1149	PASSAGE
1150	T.V. LOUNGE
1151	PATIENT TOILET
1152	PATIENT BEDROOM (1 BED)
1153	PATIENT BEDROOM (1 BED)
1154	PATIENT BEDROOM (1 BED)
1155	PATIENT BEDROOM (1 BED)
1156	PATIENT BEDROOM (1 BED)
1157	PATIENT BEDROOM (1 BED)
1158	PATIENT BEDROOM (1 BED)
1159	PATIENT BEDROOM (1 BED)
1160	PATIENT TOILET
1161	PATIENT BEDROOM (1 BED)
1162	PATIENT BEDROOM (1 BED)
1163	PATIENT BEDROOM (1 BED)
1164	PATIENT BEDROOM (1 BED)
1165	PATIENT BEDROOM (1 BED)
1166	PATIENT BEDROOM (1 BED)
1167	PATIENT BEDROOM (1 BED)
1168	PATIENT BEDROOM (1 BED)
1169	PATIENT BEDROOM (1 BED)
1170	PATIENT BEDROOM (1 BED)
1171	PATIENT BEDROOM (1 BED)
1172	STAIR NO. 1
1173	PATIENT BEDROOM (1 BED)
1174	PATIENT BEDROOM (1 BED)
1175	PATIENT BEDROOM (1 BED)
1176	PATIENT TOILET
1177	PATIENT BEDROOM (1 BED)
1178	PATIENT BEDROOM (1 BED)
1179	CORRIDOR
1180	JANITORS CLOSET
1181	NURSES STATION
1182	LINE
1183	STORAGE
1184	ACTIVITY ROOM
1185	TOLERIANT ROOM
1186	SECLUSION ROOM
1187	MEDICATION PREPARATION
1188	SOILED UTILITY
1189	CLEAN UTILITY
1190	TUB ROOM
1191	T.V. LOUNGE
1192	PATIENT TOILET
1193	PATIENT BEDROOM (2 BED)
1194	CORRIDOR
1195	NURSES STATION
1196	TOILET
1197	LINE
1198	JANITORS CLOSET
1199	PATIENT TOILET
1200	SHOWER ROOM
1201	PATIENT BEDROOM (2 BED)
1202	PATIENT TOILET
1203	PATIENT BEDROOM (2 BED)
1204	SHOWER ROOM
1205	PATIENT BEDROOM (2 BED)
1206	PATIENT TOILET
1207	PATIENT BEDROOM (2 BED)
1208	PATIENT BEDROOM (2 BED)
1209	SHOWER ROOM
1210	STAIR NO. 2
1211	VESTIBULE
1212	SHOWER ROOM
1213	PATIENT BEDROOM (2 BED)
1214	PATIENT TOILET
1215	SHOWER ROOM
1216	PATIENT BEDROOM (2 BED)
1217	PATIENT TOILET
1218	PATIENT BEDROOM (2 BED)
1219	PATIENT TOILET
1220	PATIENT BEDROOM (2 BED)
1221	PATIENT TOILET
1222	SHOWER ROOM
1223	PATIENT BEDROOM (2 BED)
1224	CORRIDOR
1225	SHOWER ROOM
1226	PATIENT BEDROOM (2 BED)
1227	PATIENT BEDROOM (2 BED)
1228	PATIENT TOILET

As So Built  
6-8-87  
Richard Diller

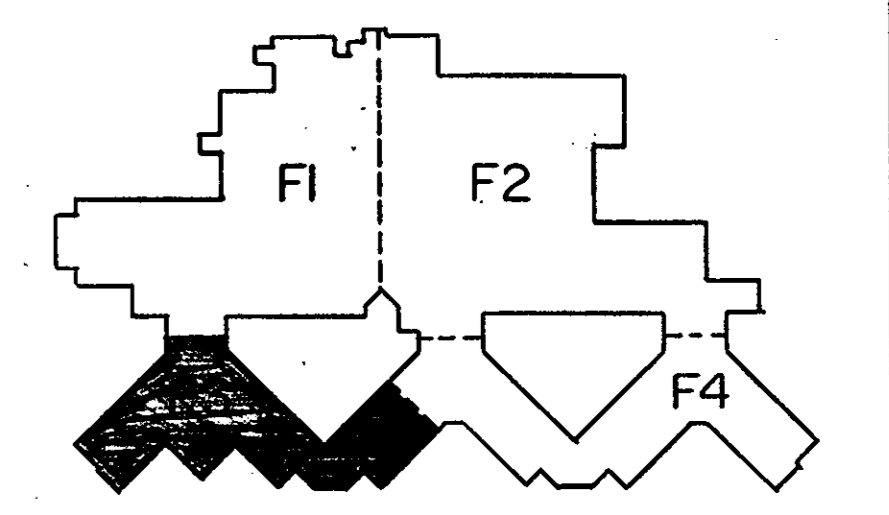

KEY PLAN



**DRAWING TITLE:**  
PARTIAL FIRST FLOOR  
DUCTWORK - AREA F3

**SCALE:** 1/8" = 1'-0"

REVISIONS:	


FOR REFERENCE ONLY

SHEET NUMBER:  
**M3**

PROJECT NUMBER:  
83013  
DATE:  
6-27-85

**ROOM SCHEDULE**


NURSING, INTERMEDIATE	
1229	ACTIVITY ROOM
1230	T.V. LOUNGE
1231	NURSE STATION
1232	CORRIDOR
1233	TOILET/ANTE ROOM
1234	SECLUSION ROOM
1235	STAFF TOILET
1236	MEDICATION PREPARATION
1237	CLEAN UTILITY
1238	TRASH ROOM
1239	JANITORS CLOSET
1240	PASSAGE
1241	SOILED UTILITY
1242	PATIENT TOILET
1243	PATIENT BEDROOM (2 BED)
1244	SHOWER ROOM
1245	CORRIDOR
1246	PATIENT TOILET
1247	PATIENT BEDROOM (2 BED)
1248	SHOWER ROOM
1249	CORRIDOR
1250	PATIENT TOILET
1251	PATIENT BEDROOM (2 BED)
1252	SHOWER ROOM
1253	CORRIDOR
1254	PATIENT TOILET
1255	PATIENT BEDROOM (1 BED-HANDICAPPED)
1256	PATIENT TOILET
1257	PATIENT BEDROOM (2 BED)
1258	SHOWER ROOM
1259	PATIENT TOILET/SHOWER (HANDICAPPED)
1260	LAUNDRY
1261	PATIENT BEDROOM (1 BED)
1262	STORAGE
1263	SHOWER ROOM
1264	PATIENT BEDROOM (2 BED)
1265	PATIENT TOILET
1266	SHOWER ROOM
1267	PATIENT BEDROOM (2 BED)
1268	SHOWER ROOM
1269	PATIENT TOILET
1270	PATIENT BEDROOM (2 BED)
1271	PATIENT TOILET
1272	PATIENT BEDROOM (2 BED)
1273	PATIENT TOILET
1274	PATIENT BEDROOM (2 BED)
1275	SHOWER ROOM
1276	PATIENT TOILET
1277	CORRIDOR
1278	PATIENT TOILET
1279	PATIENT BEDROOM (2 BED)
1280	PATIENT TOILET
1281	PATIENT BEDROOM (2 BED)
1282	PATIENT TOILET
1283	PATIENT BEDROOM (2 BED)
1284	SHOWER ROOM
1285	PATIENT TOILET
1286	CORRIDOR
1287	PATIENT TOILET
1288	SHOWER ROOM
1289	PATIENT BEDROOM (2 BED)
1290	PATIENT TOILET
1291	ACTIVITY ROOM
1292	T.V. LOUNGE
1293	NURSE STATION
1294	CORRIDOR
1295	TOILET/ANTE ROOM
1296	SECLUSION ROOM
1297	STAFF TOILET
1298	MEDICATION PREPARATION
1299	PASSAGE
1300	CLEAN UTILITY
1301	TRASH ROOM
1302	JANITORS CLOSET
1303	PASSAGE
1304	SOILED UTILITY
1305	PATIENT TOILET
1306	PATIENT BEDROOM (2 BED)
1307	SHOWER ROOM
1308	PATIENT TOILET
1309	PATIENT BEDROOM (2 BED)
1310	CORRIDOR
1311	PATIENT TOILET
1312	PATIENT BEDROOM (2 BED)
1313	SHOWER ROOM
1314	PATIENT TOILET
1315	PATIENT BEDROOM (2 BED)
1316	CORRIDOR
1317	SHOWER ROOM
1318	PATIENT BEDROOM (2 BED)
1319	PATIENT TOILET
1320	PATIENT BEDROOM (1 BED-HANDICAPPED)
1321	PATIENT TOILET/SHOWER (HANDICAPPED)
1322	LAUNDRY
1323	PATIENT TOILET/SHOWER
1324	PATIENT BEDROOM (1 BED)
1325	STAIR NO. 7

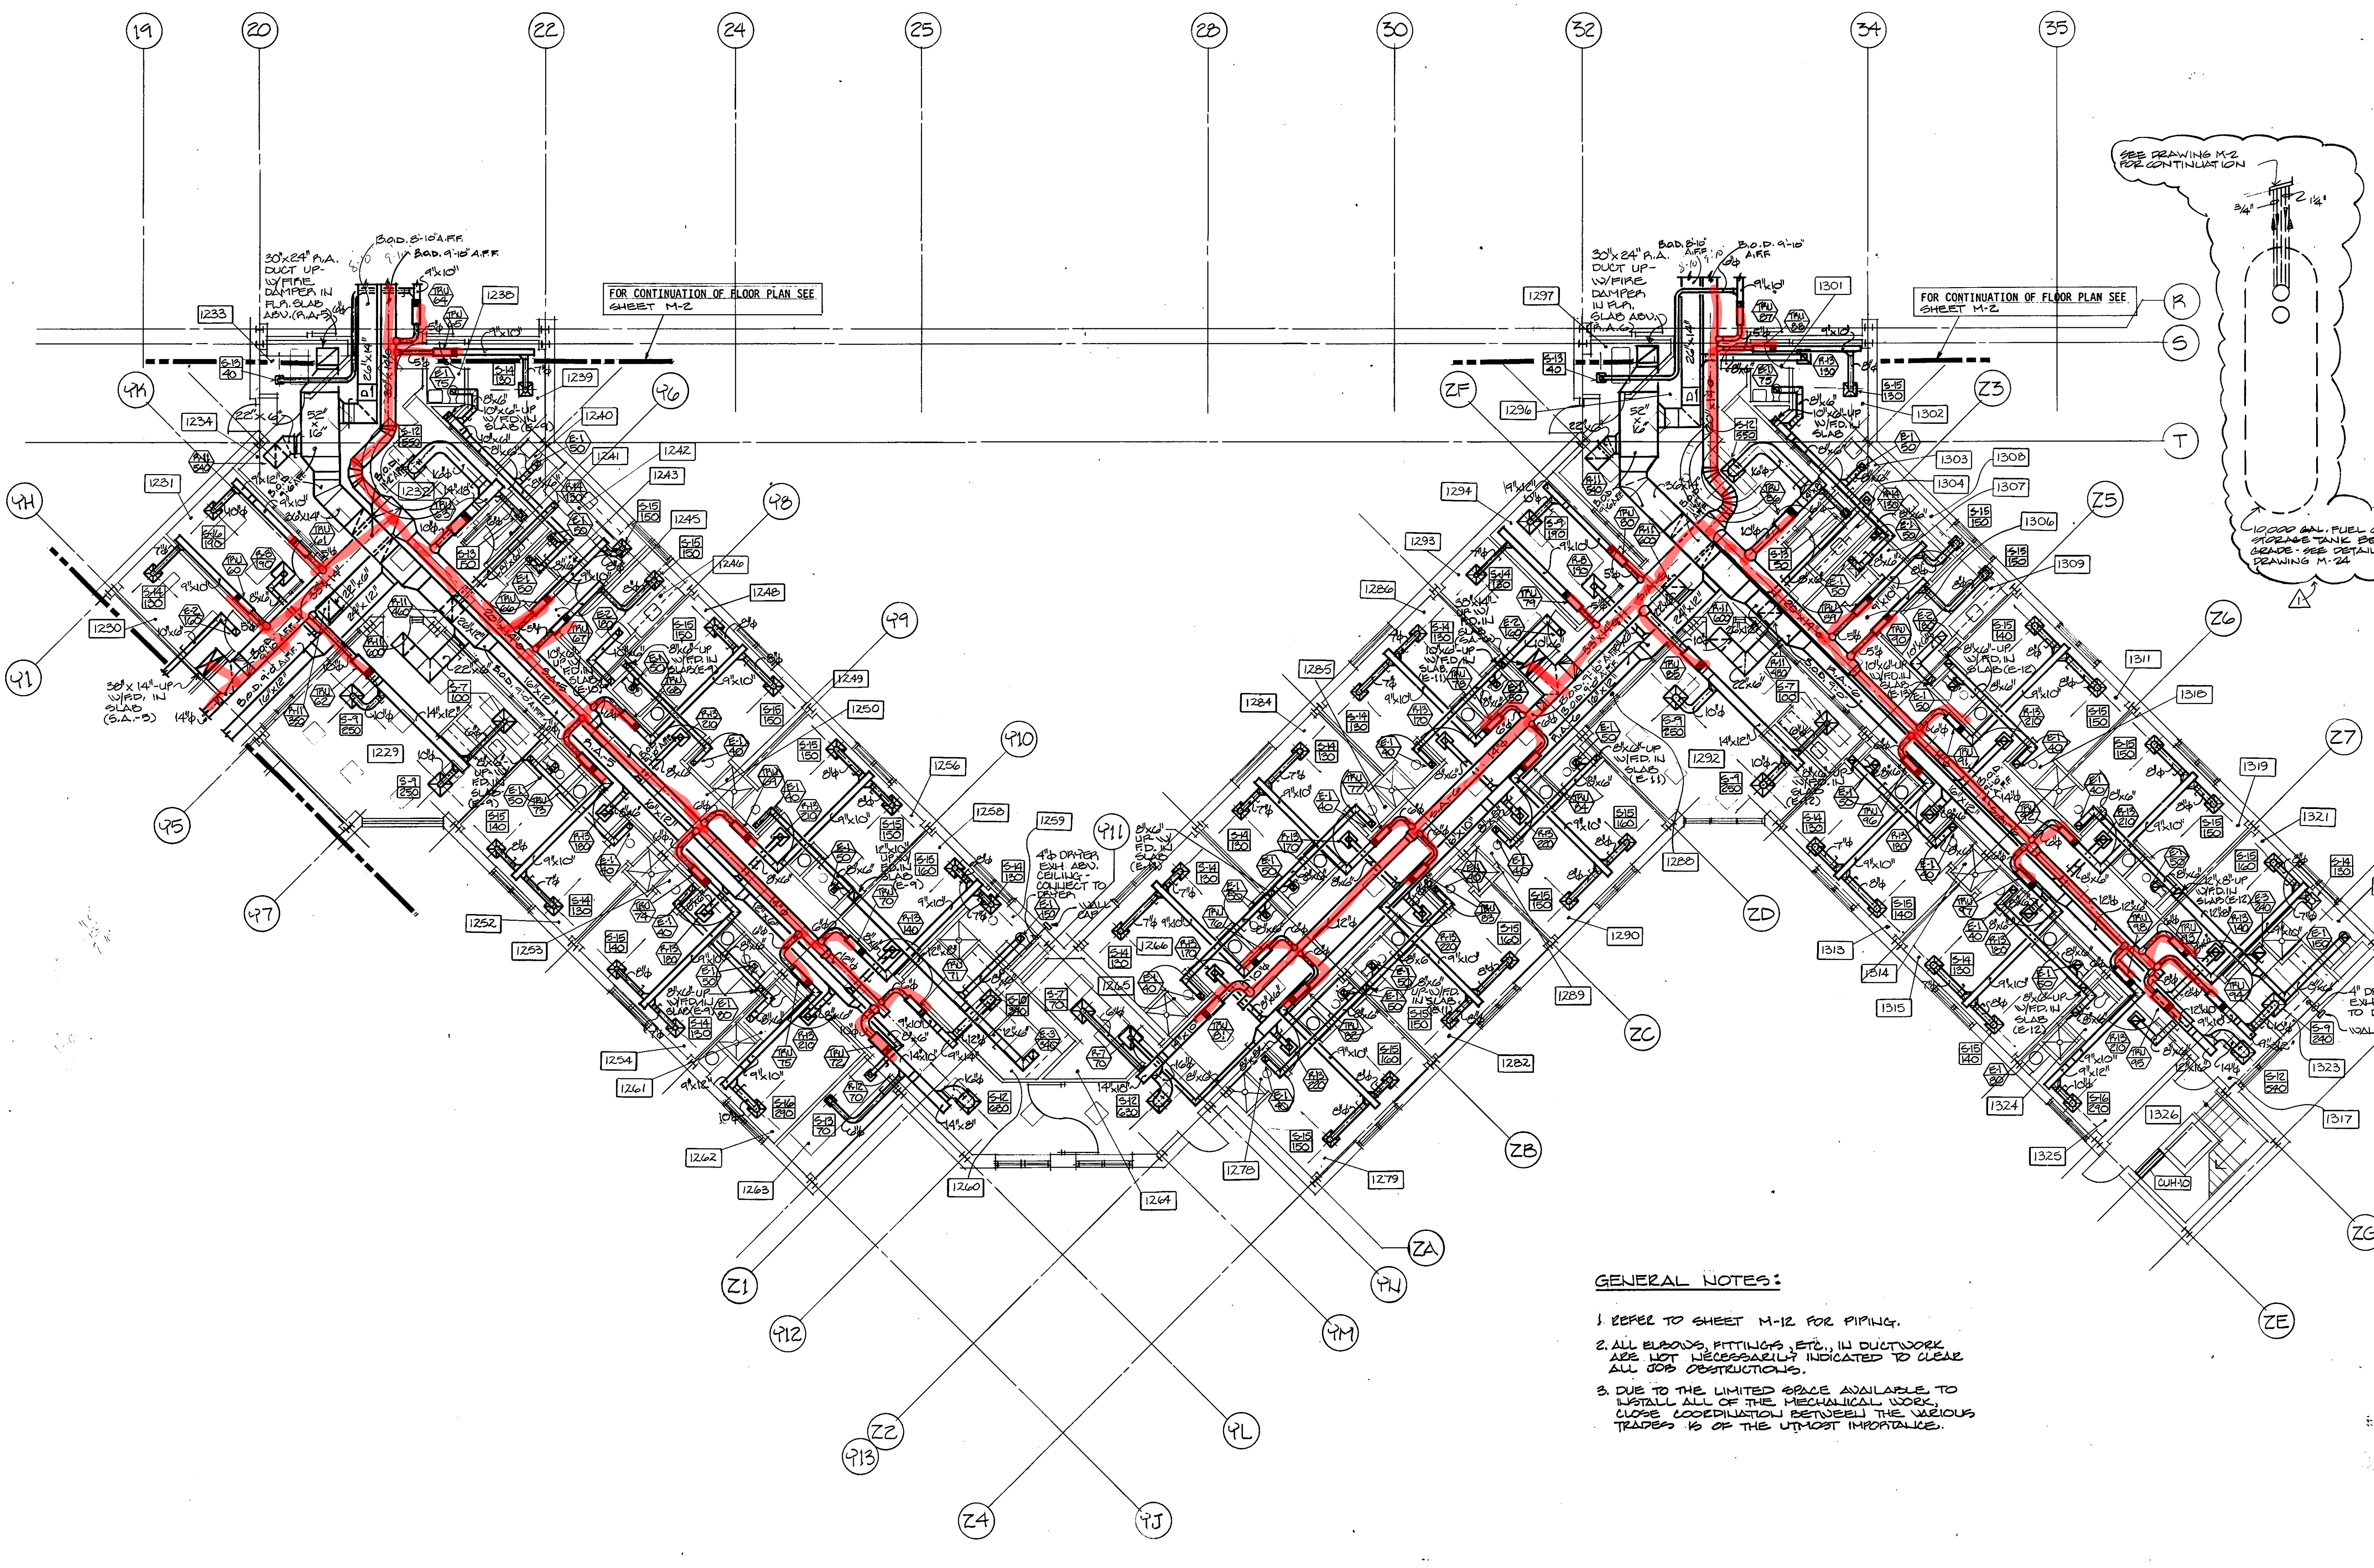

**GENERAL NOTES:**

1. REFER TO SHEET M-12 FOR PIPING.
2. ALL ELBOWS, FITTINGS, ETC., IN DUCTWORK ARE NOT NECESSARILY INDICATED TO CLEAR ALL JOB OBSTRUCTIONS.
3. DUE TO THE LIMITED SPACE AVAILABLE TO INSTALL ALL OF THE MECHANICAL WORK, CLOSE COORDINATION BETWEEN THE VARIOUS TRADES IS OF THE UTMOST IMPORTANCE.

A. S. Builders  
6-8-87  
Richard Sides

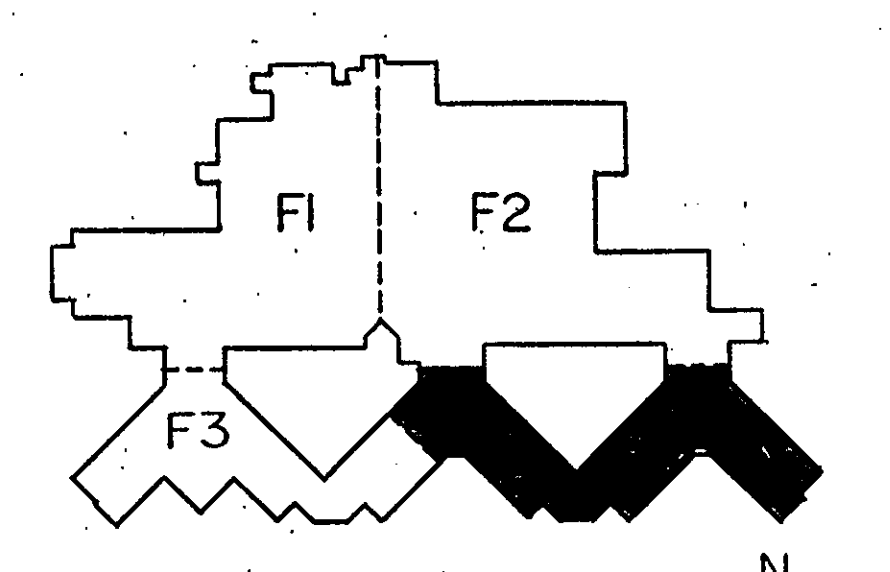

KEY PLAN



**DRAWING TITLE:**  
PARTIAL FIRST FLOOR  
DUCTWORK - AREA F4

SCALE: 1/8" = 1'-0"

REVISIONS:	
1	1/24/86

**FOR REFERENCE ONLY**


SHEET NUMBER:  
**M4**

PROJECT NUMBER:  
83013

ISSUE DATE:  
6-27-85

**ROOM SCHEDULE**

2009	MALE TOILET
2010	PANTRY
2011	CONFERENCE
2012	PASSAGE
2013	STORAGE
2014	FEMALE TOILET
2015	ELECTRICAL CLOSET
2016	JANITORS CLOSET
<b>PHARMACY</b>	
2023	DIRECTOR
2024	PHARMACIST
2025	PHARMACIST
2026	PHARMACIST
2027	PHARMACIST
2028	OFFICE WORK AREA
2029	COMPOUNDING ROOM
2030	DRUG TRANSFER
2031	LOCKER ROOM
2032	TOILET
2033	CONTROLLED DRUG STORAGE
<b>ACCOUNTING</b>	
2038	VAULT
2039	CASHER
2040	ELEVATOR LOBBY
<b>CIRCULATION</b>	
2041	CORRIDOR
2042	CONFERENCE ROOM
2043	STAFF LOUNGE
2044	STAFF LOUNGE
2045	STAFF FEMALE TOILET
2046	STAFF MALE TOILET
2047	STAFF LOCKERS
2048	STAFF LOCKERS
2049	PSYCHOLOGIST OFFICE
2050	PSYCHOLOGIST OFFICE
2051	SOCIAL WORKERS OFFICE
2052	SOCIAL WORKERS OFFICE
2053	STORAGE
<b>PATIENT ACTIVITY</b>	
2054	ACTIVITY THERAPY OFFICE
2055	ACTIVITY THERAPY OFFICE
2056	RECREATION ROOM
<b>NURSING ACUTE</b>	
2105	CONFERENCE ROOM
2106	COUNSELING ROOM
2107	ELECTRICAL CLOSET

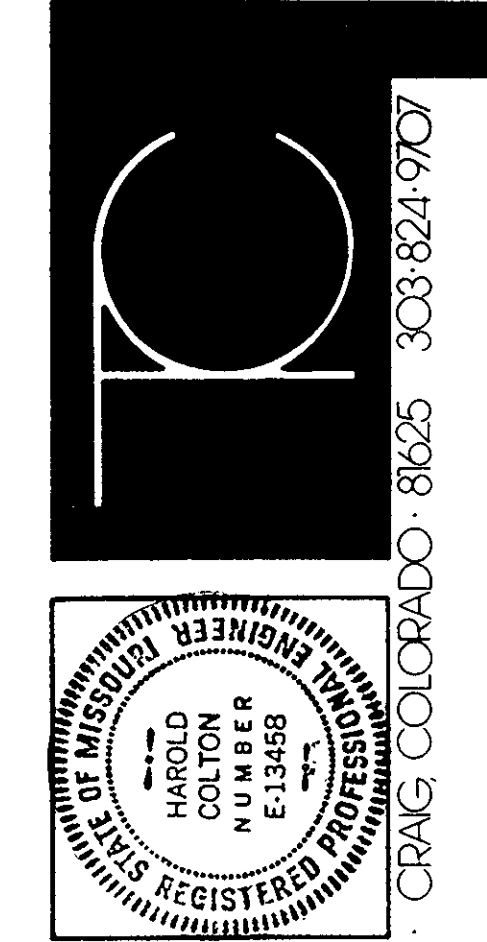

THE CHRISNER PARTNERSHIP INC ARCHITECTS AND PLANNERS  
 20 SOUTH HANLEY RD · CLAYTON, MISSOURI · 63105 314.726.2927 - 11 W VICTORY WAY · CROAG, COLORADO · 81625 303.821.9707

**GENERAL NOTES:**

- REFER TO SHEET M-10 FOR PIPING.
- ALL ELBOWS, FITTINGS, ETC., IN DUCTWORK ARE NOT NECESSARILY INDICATED TO CLEAR ALL JOB OBSTRUCTIONS.
- DUE TO THE LIMITED SPACE AVAILABLE TO INSTALL ALL OF THE MECHANICAL WORK, CLOSE COORDINATION BETWEEN THE VARIOUS TRADES IS OF THE UTMOST IMPORTANCE.

**KEYED NOTES:**


- SMOKE DAMPER IN DUCT AT THIS LOCATION.
- FIRE DAMPER IN DUCT AT THIS LOCATION.
- COMBINATION SMOKE/FIRE DAMPER IN DUCT AT THIS LOCATION.



FOR CONTINUATION OF FLOOR PLAN SEE SHEET M-6

AIRFLOW MEASURING STATION

AIRFLOW MEASURING STATION

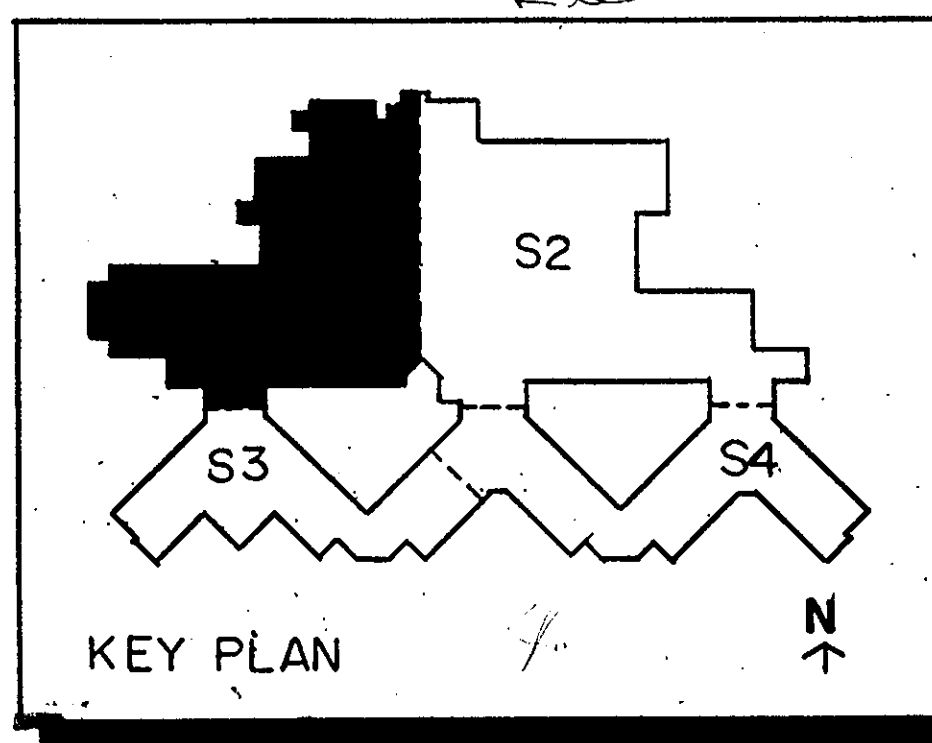

TRUE NORTH  
 PLAN NORTH

**DRAWING TITLE:**  
 PARTIAL SECOND FLOOR  
 DUCTWORK - AREA S1

SCALE: 1/8" = 1'-0"

REVISIONS:




FOR REFERENCE ONLY

SHEET NUMBER:  
**M5**

PROJECT NUMBER:  
 83013

ISSUE DATE:  
 6-27-85

A.S. Built  
 6-8-87  
 Richard S. Sibley

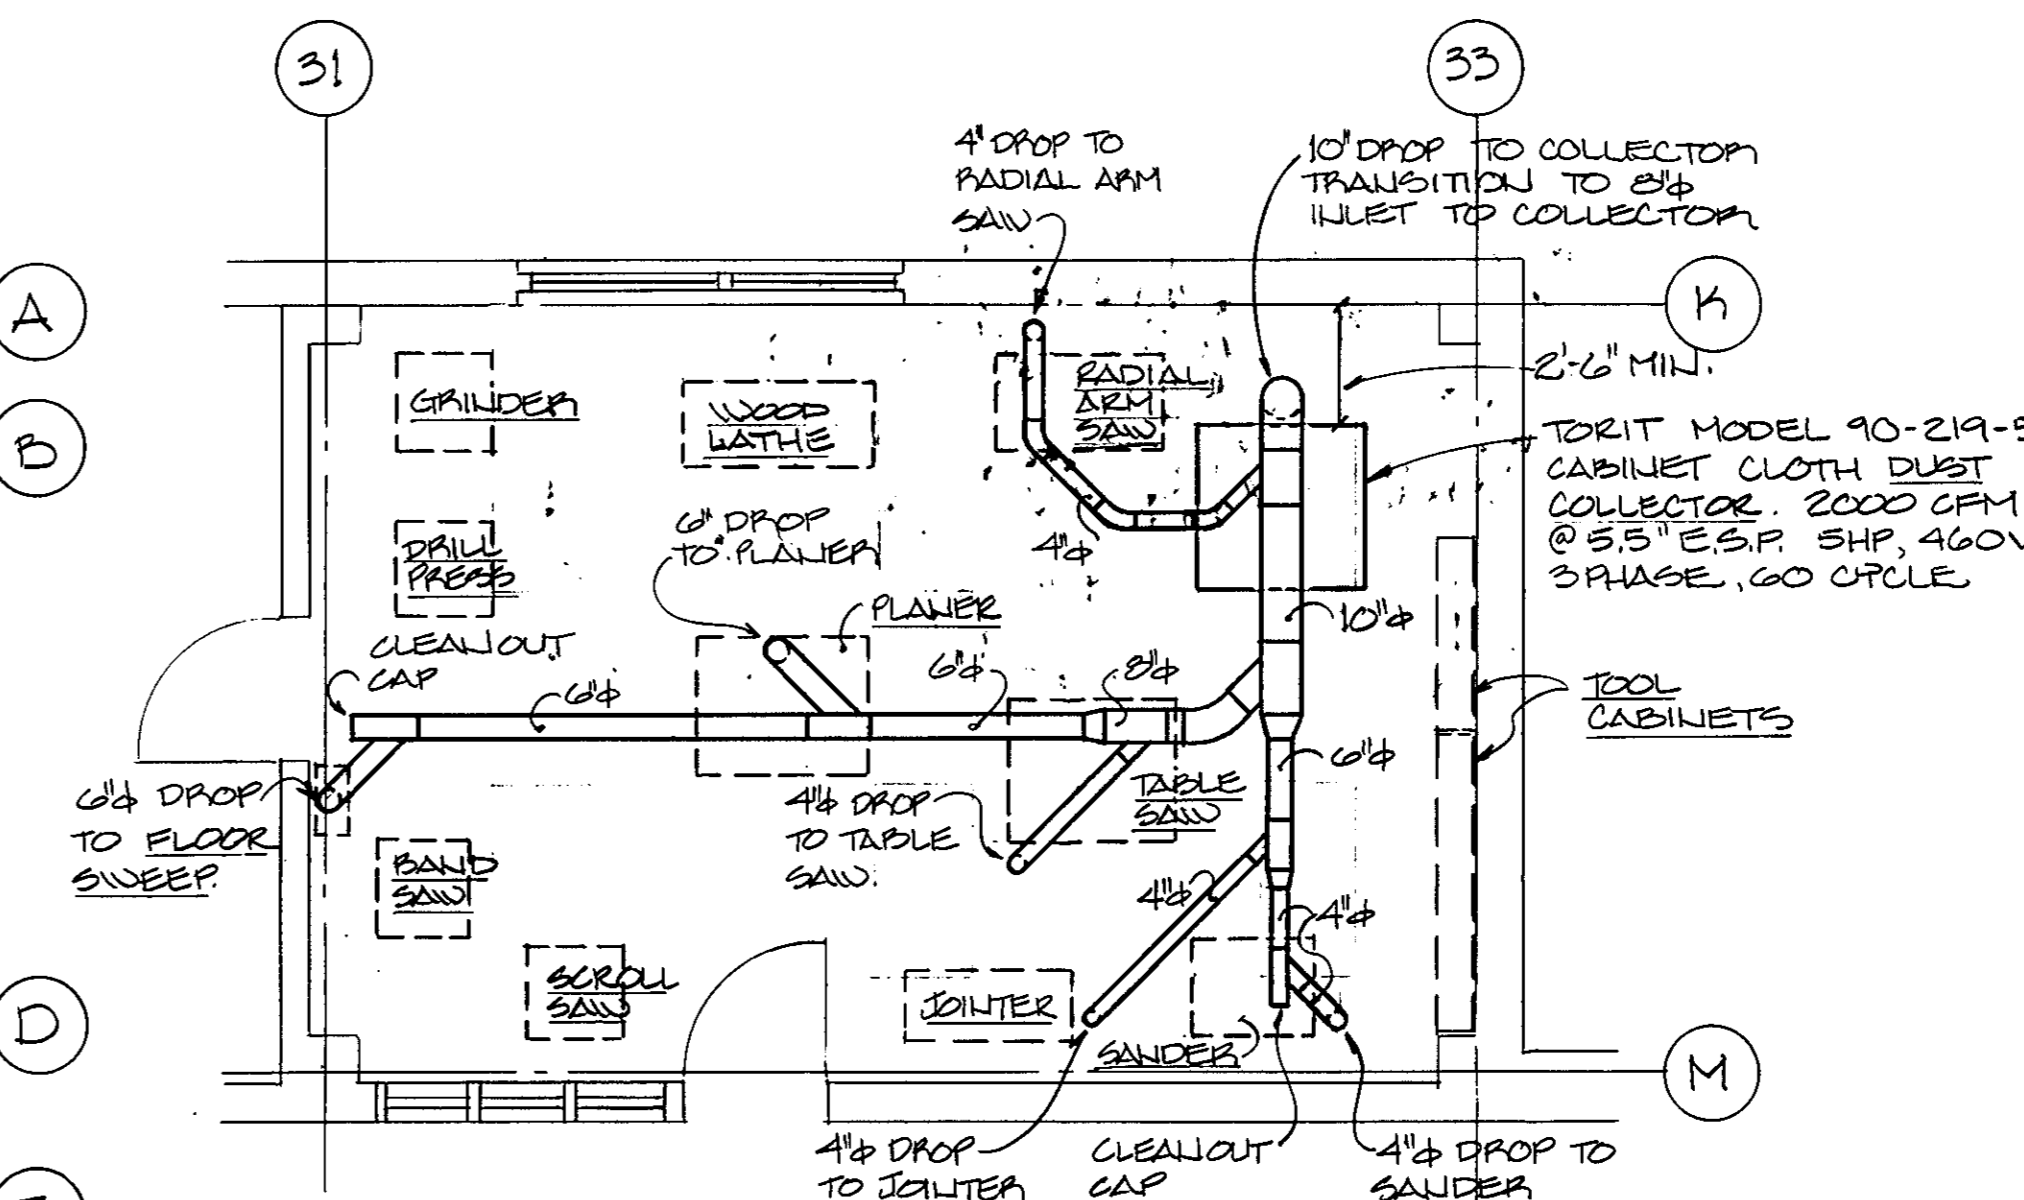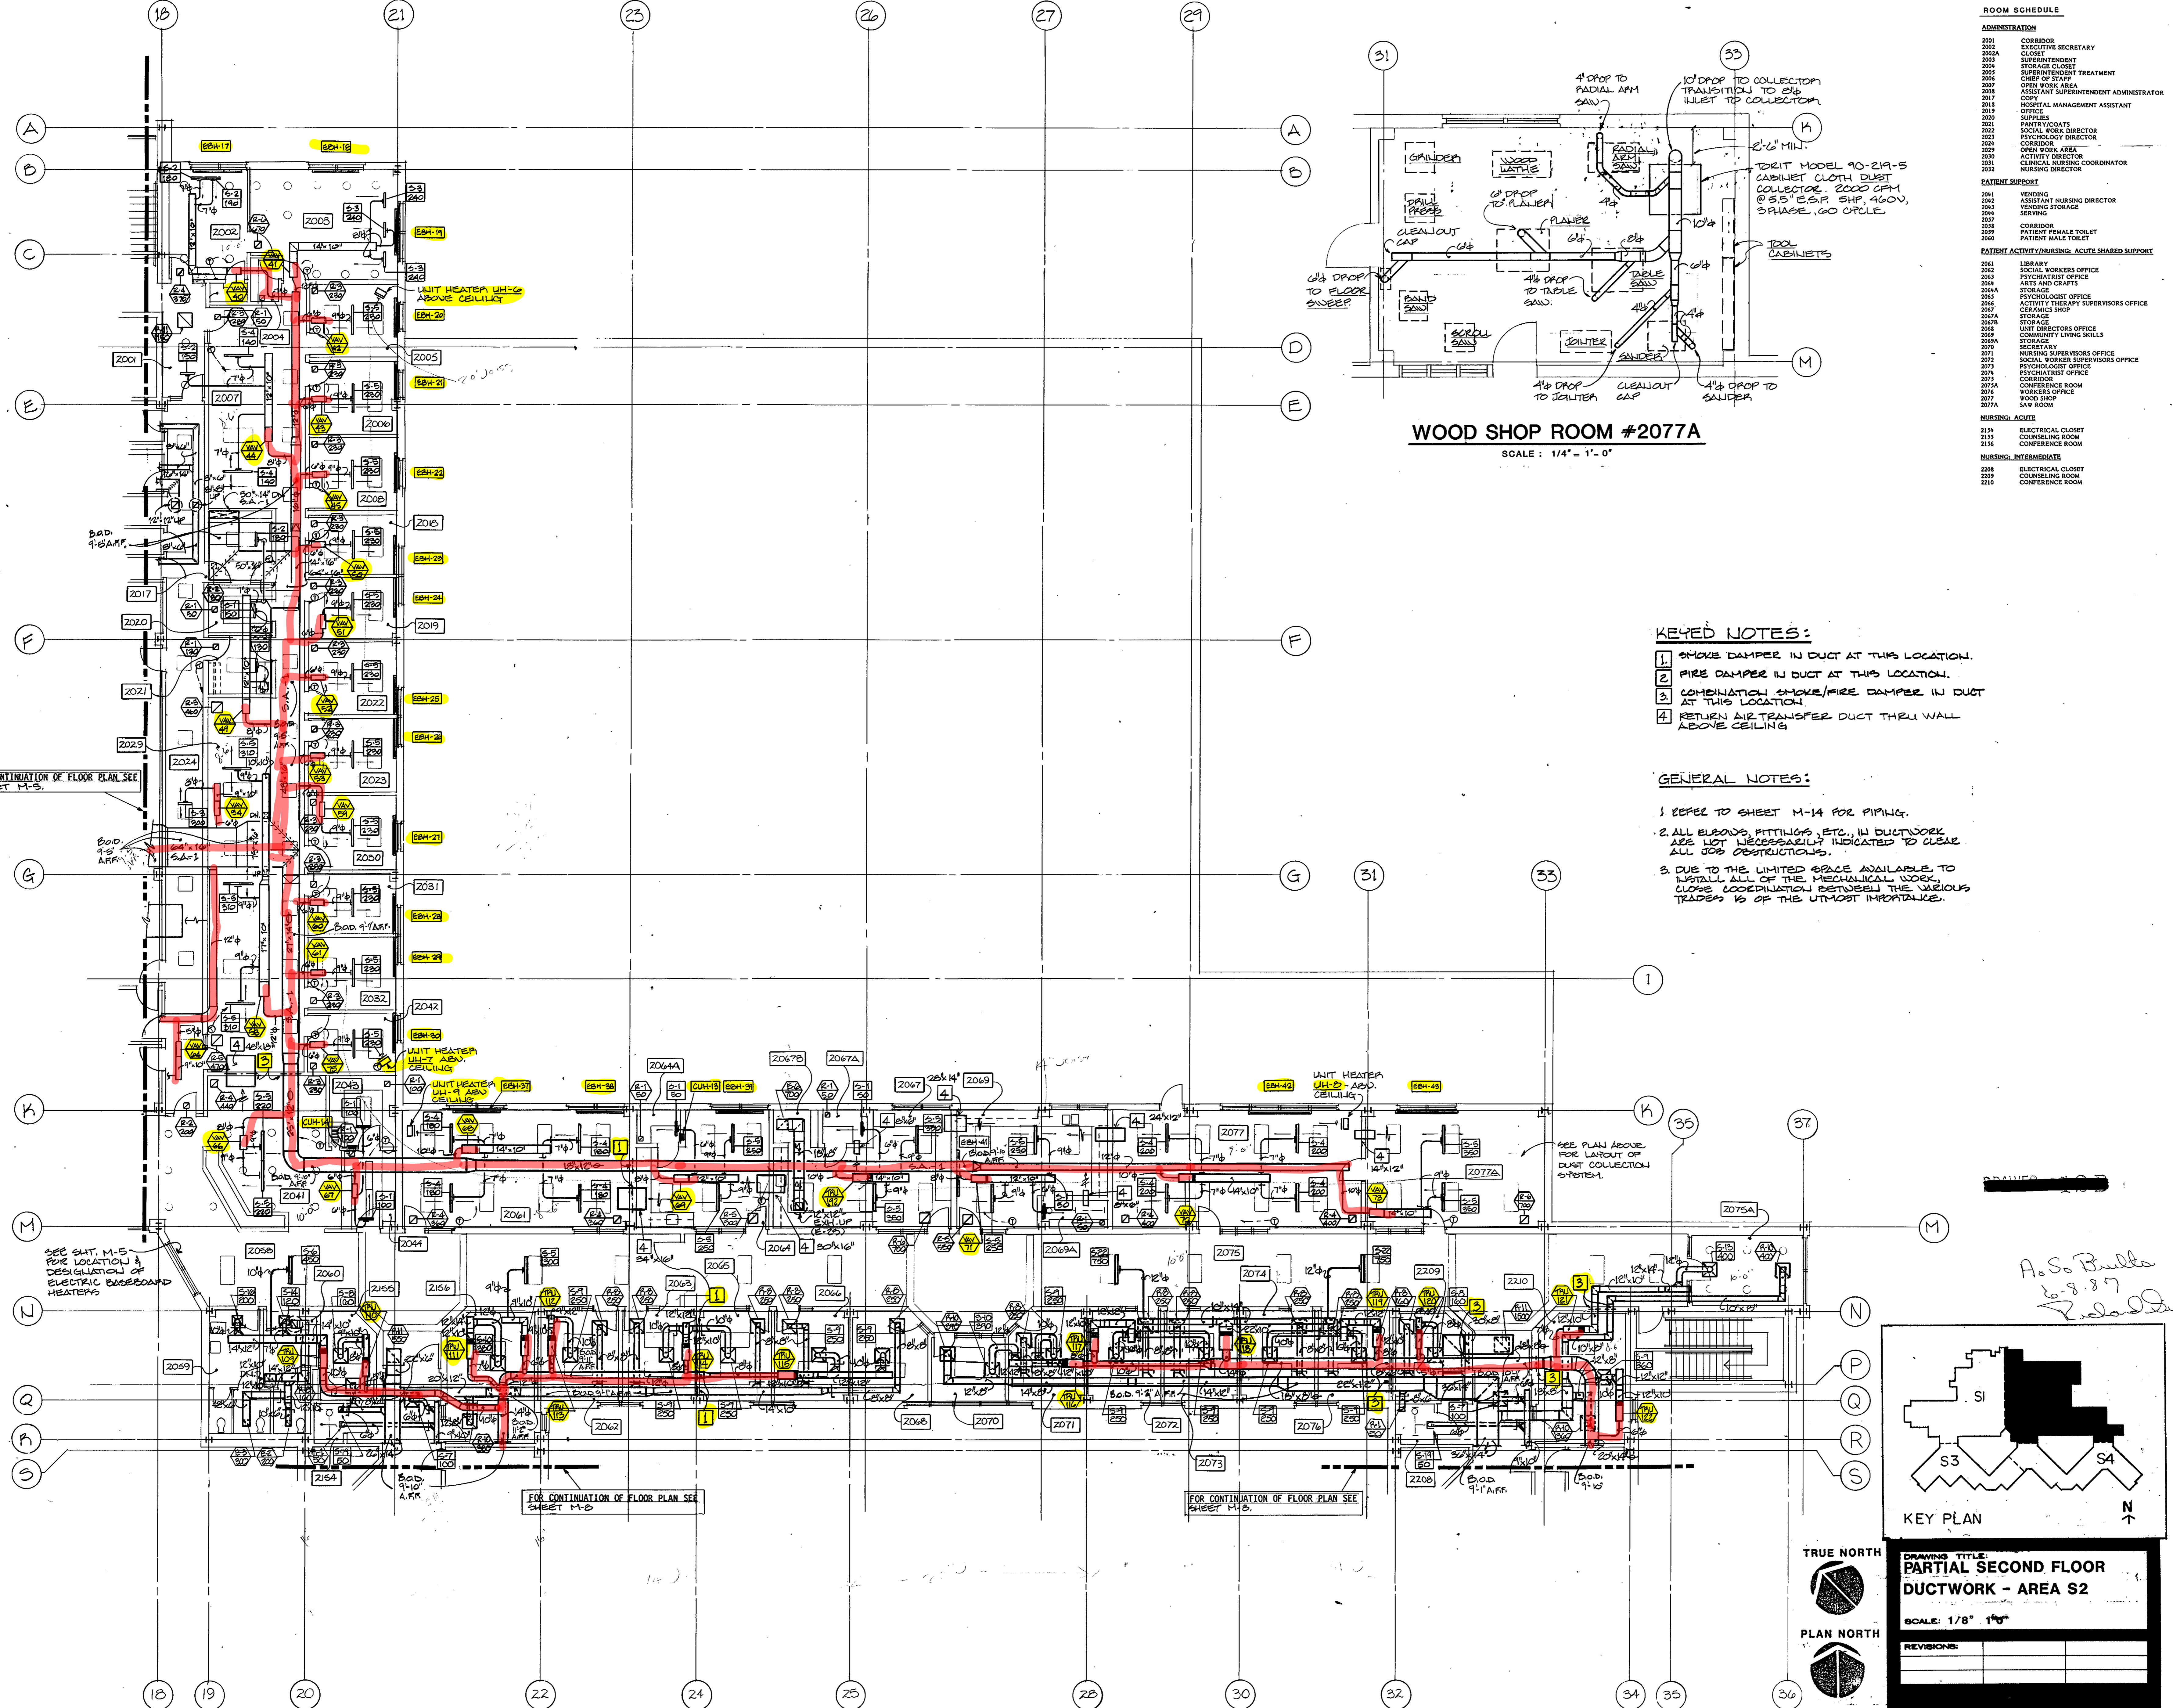

**WOOD SHOP ROOM #2077A**  
SCALE: 1/4" = 1'-0"

- KEYED NOTES:**
1. SMOKE DAMPER IN DUCT AT THIS LOCATION.
  2. FIRE DAMPER IN DUCT AT THIS LOCATION.
  3. COMBINATION SMOKE/FIRE DAMPER IN DUCT AT THIS LOCATION.
  4. RETURN AIR TRANSFER DUCT THRU WALL ABOVE CEILING.

- GENERAL NOTES:**
1. REFER TO SHEET M-14 FOR PIPING.
  2. ALL ELBOWS, FITTINGS, ETC., IN DUCTWORK ARE NOT NECESSARILY INDICATED TO CLEAR ALL CORNER OBSTRUCTIONS.
  3. DUE TO THE LIMITED SPACE AVAILABLE TO INSTALL ALL OF THE MECHANICAL WORK, CLOSE COORDINATION BETWEEN THE VARIOUS TRADES IS OF THE UTMOST IMPORTANCE.


**ROOM SCHEDULE**

ADMINISTRATION	
2001	CORRIDOR
2002	EXECUTIVE SECRETARY
2002A	CLOSET
2002B	SUPERINTENDENT
2006	STORAGE CLOSET
2007	SUPERINTENDENT TREATMENT
2008	CHIEF OF STAFF
2009	OPEN WORK AREA
2017	ASSISTANT SUPERINTENDENT ADMINISTRATOR
2018	COPY
2019	HOSPITAL MANAGEMENT ASSISTANT
2020	OFFICE
2021	SUPPLIES
2022	PANTYCOATS
2022	SOCIAL WORK DIRECTOR
2023	PSYCHOLOGY DIRECTOR
2024	CORRIDOR
2025	OPEN WORK AREA
2030	ACTIVITY DIRECTOR
2031	CLINICAL NURSING COORDINATOR
2032	NURSING DIRECTOR
PATIENT SUPPORT	
2041	VENING
2042	ASSISTANT NURSING DIRECTOR
2043	VENING STORAGE
2044	SERVING
2045	STORAGE
2046	PATIENT FEMALE TOILET
2047	PATIENT MALE TOILET
PATIENT ACTIVITY/NURSING, ACUTE SHARED SUPPORT	
2061	LIBRARY
2062	SOCIAL WORKERS OFFICE
2063	PSYCHIATRIST OFFICE
2064	ARTS AND CRAFTS
2064A	PSYCHOLOGIST OFFICE
2066	ACTIVITY THERAPY SUPERVISORS OFFICE
2067	STORAGE
2067A	CERAMICS SHOP
2068	STORAGE
2069	UNIT DIRECTORS OFFICE
2069A	COMMUNITY LIVING SKILLS
2071	STORAGE
2071	NURSING SUPERVISORS OFFICE
2072	SECRETARY
2073	SOCIAL WORKER SUPERVISORS OFFICE
2074	PSYCHIATRIST OFFICE
2075	PSYCHOLOGIST OFFICE
2076	PSYCHIATRIST OFFICE
2077	CORRIDOR
2077A	CONFERENCE ROOM
2078	WORKERS OFFICE
2079	WOOD SHOP
2079A	SAF ROOM
NURSING, ACUTE	
2156	ELECTRICAL CLOSET
2157	COUNSELING ROOM
2158	CONFERENCE ROOM
NURSING, INTERMEDIATE	
2208	ELECTRICAL CLOSET
2209	COUNSELING ROOM
2210	CONFERENCE ROOM

THE CHRISNER PARTNERSHIP INC ARCHITECTS AND PLANNERS  
 20 SOUTH HANLEY RD. CLAYTON MISSOURI 63105 314-725-2927 11 W VICTORY WAY CRAIG COLORADO 81625 303-824-9707

**FOR REFERENCE ONLY**

PROJECT NUMBER: 83013  
 SHEET NUMBER: M6  
 ISSUE DATE: 6-27-85

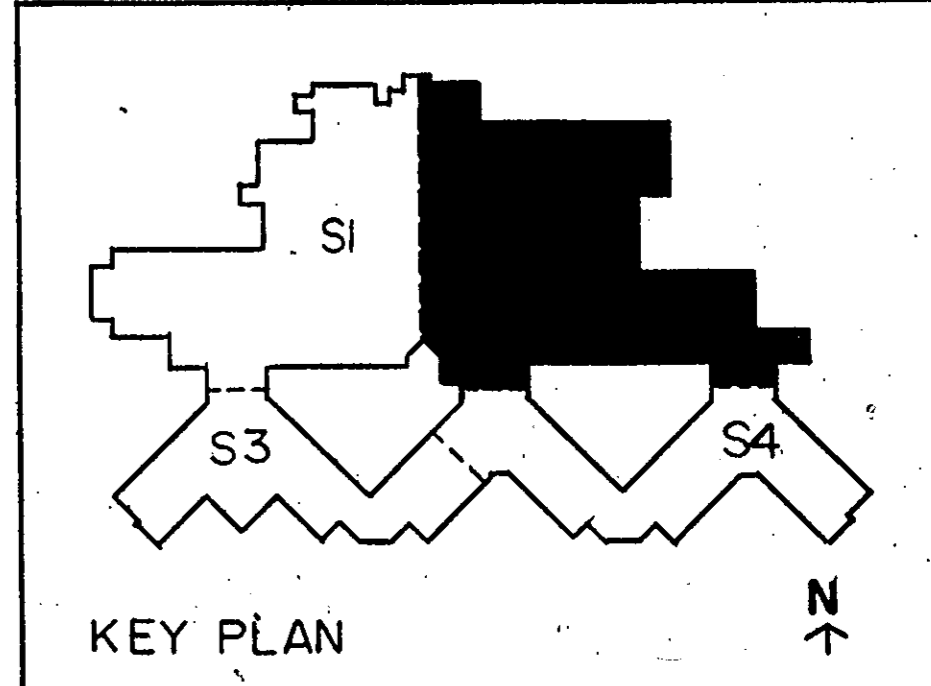

**KEY PLAN**

TRUE NORTH  
PLAN NORTH

**DRAWING TITLE:**  
PARTIAL SECOND FLOOR  
DUCTWORK - AREA S2

SCALE: 1/8" = 1'-0"



REVISIONS:

*A.S. Bullock*  
6-8-87  
*Rubal...*

**ROOM SCHEDULE**

2075	LAUNDRY ROOM
2076	PATIENT TOILET/SHOWER (HANDICAPPED)
2077	PATIENT BEDROOM (1 BED-HANDICAPPED)
2078	PATIENT TOILET
2079	PATIENT TOILET
2080	SHOWER ROOM
2081	PATIENT TOILET/SHOWER
2082	PATIENT TOILET/SHOWER
2083	PATIENT TOILET/SHOWER
2084	PATIENT TOILET/SHOWER
2085	PATIENT TOILET/SHOWER
2086	PATIENT TOILET/SHOWER
2087	PATIENT TOILET/SHOWER
2088	SHOWER ROOM
2089	PATIENT BEDROOM (2 BED)
2090	PATIENT TOILET
2091	PATIENT TOILET
2092	PATIENT TOILET
2093	PATIENT TOILET
2094	PATIENT TOILET
2095	PATIENT TOILET
2096	SEMI-UTILITY ROOM
2097	TRASH ROOM
2098	CLEAN UTILITY ROOM
2099	PASSAGE
2100	JANITORS CLOSET
2101	MEDICATION PREPARATION
2102	NURSE STATION
2103	TOILET
2104	TOILET
2105	TOILET
2106	TOILET/ANTE ROOM
2107	CORRIDOR
2108	CORRIDOR
2109	LINE
2110	T.V. LOUNGE
2111	TUB ROOM
2112	ACTIVITY ROOM
2113	PATIENT TOILET
2114	PATIENT BEDROOM (2 BED)
2115	SHOWER ROOM
2116	CORRIDOR
2117	PATIENT TOILET
2118	PATIENT BEDROOM (2 BED)
2119	SHOWER ROOM
2120	PATIENT TOILET
2121	PATIENT BEDROOM (2 BED)
2122	PATIENT TOILET
2123	PATIENT TOILET
2124	PATIENT BEDROOM (2 BED)
2125	PATIENT TOILET
2126	PATIENT TOILET
2127	PATIENT TOILET
2128	SHOWER ROOM
2129	PATIENT TOILET
2130	PATIENT BEDROOM (2 BED)
2131	PATIENT TOILET
2132	SHOWER ROOM
2133	PATIENT BEDROOM (2 BED)
2134	PATIENT TOILET
2135	PATIENT TOILET
2136	PATIENT BEDROOM (2 BED)
2137	SHOWER ROOM
2138	PATIENT BEDROOM (2 BED)
2139	PATIENT TOILET
2140	PATIENT TOILET
2141	PATIENT BEDROOM (2 BED)
2142	SHOWER ROOM
2143	PATIENT BEDROOM (2 BED)
2144	PATIENT TOILET
2145	CORRIDOR
2146	SHOWER ROOM
2147	PATIENT BEDROOM (2 BED)
2148	PATIENT TOILET

- GENERAL NOTES:**
- REFER TO SHEET M-15 FOR PIPING.
  - ALL ELBOWS, FITTINGS, ETC., IN DUCTWORK ARE NOT NECESSARILY INDICATED TO CLEAR ALL JOB OBSTRUCTIONS.
  - DUE TO THE LIMITED SPACE AVAILABLE TO INSTALL ALL OF THE MECHANICAL WORK, CLOSE COORDINATION BETWEEN THE VARIOUS TRADES IS OF THE UTMOST IMPORTANCE.

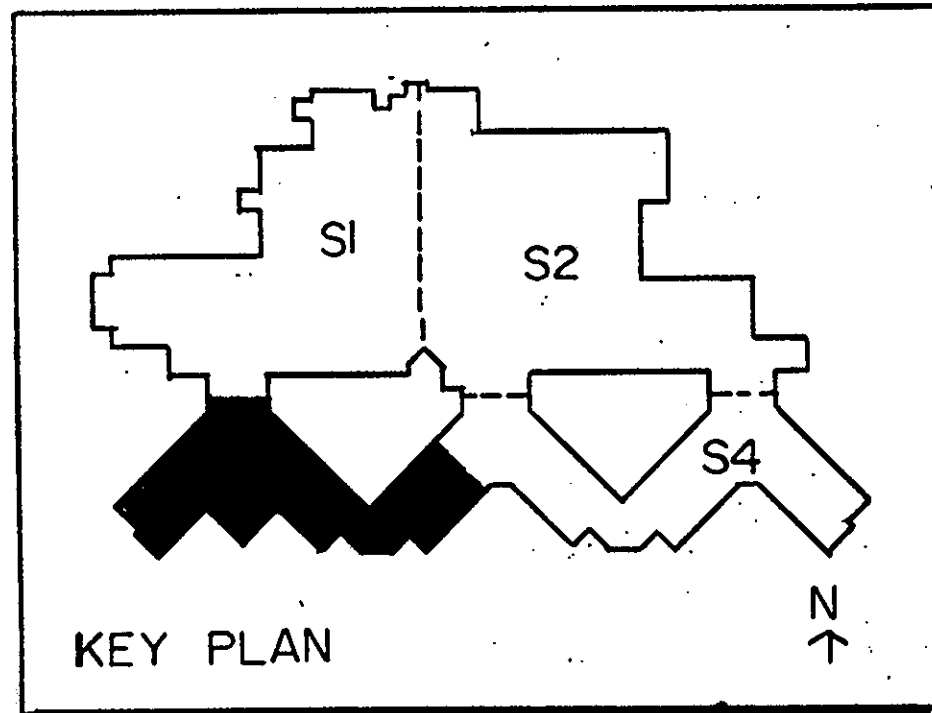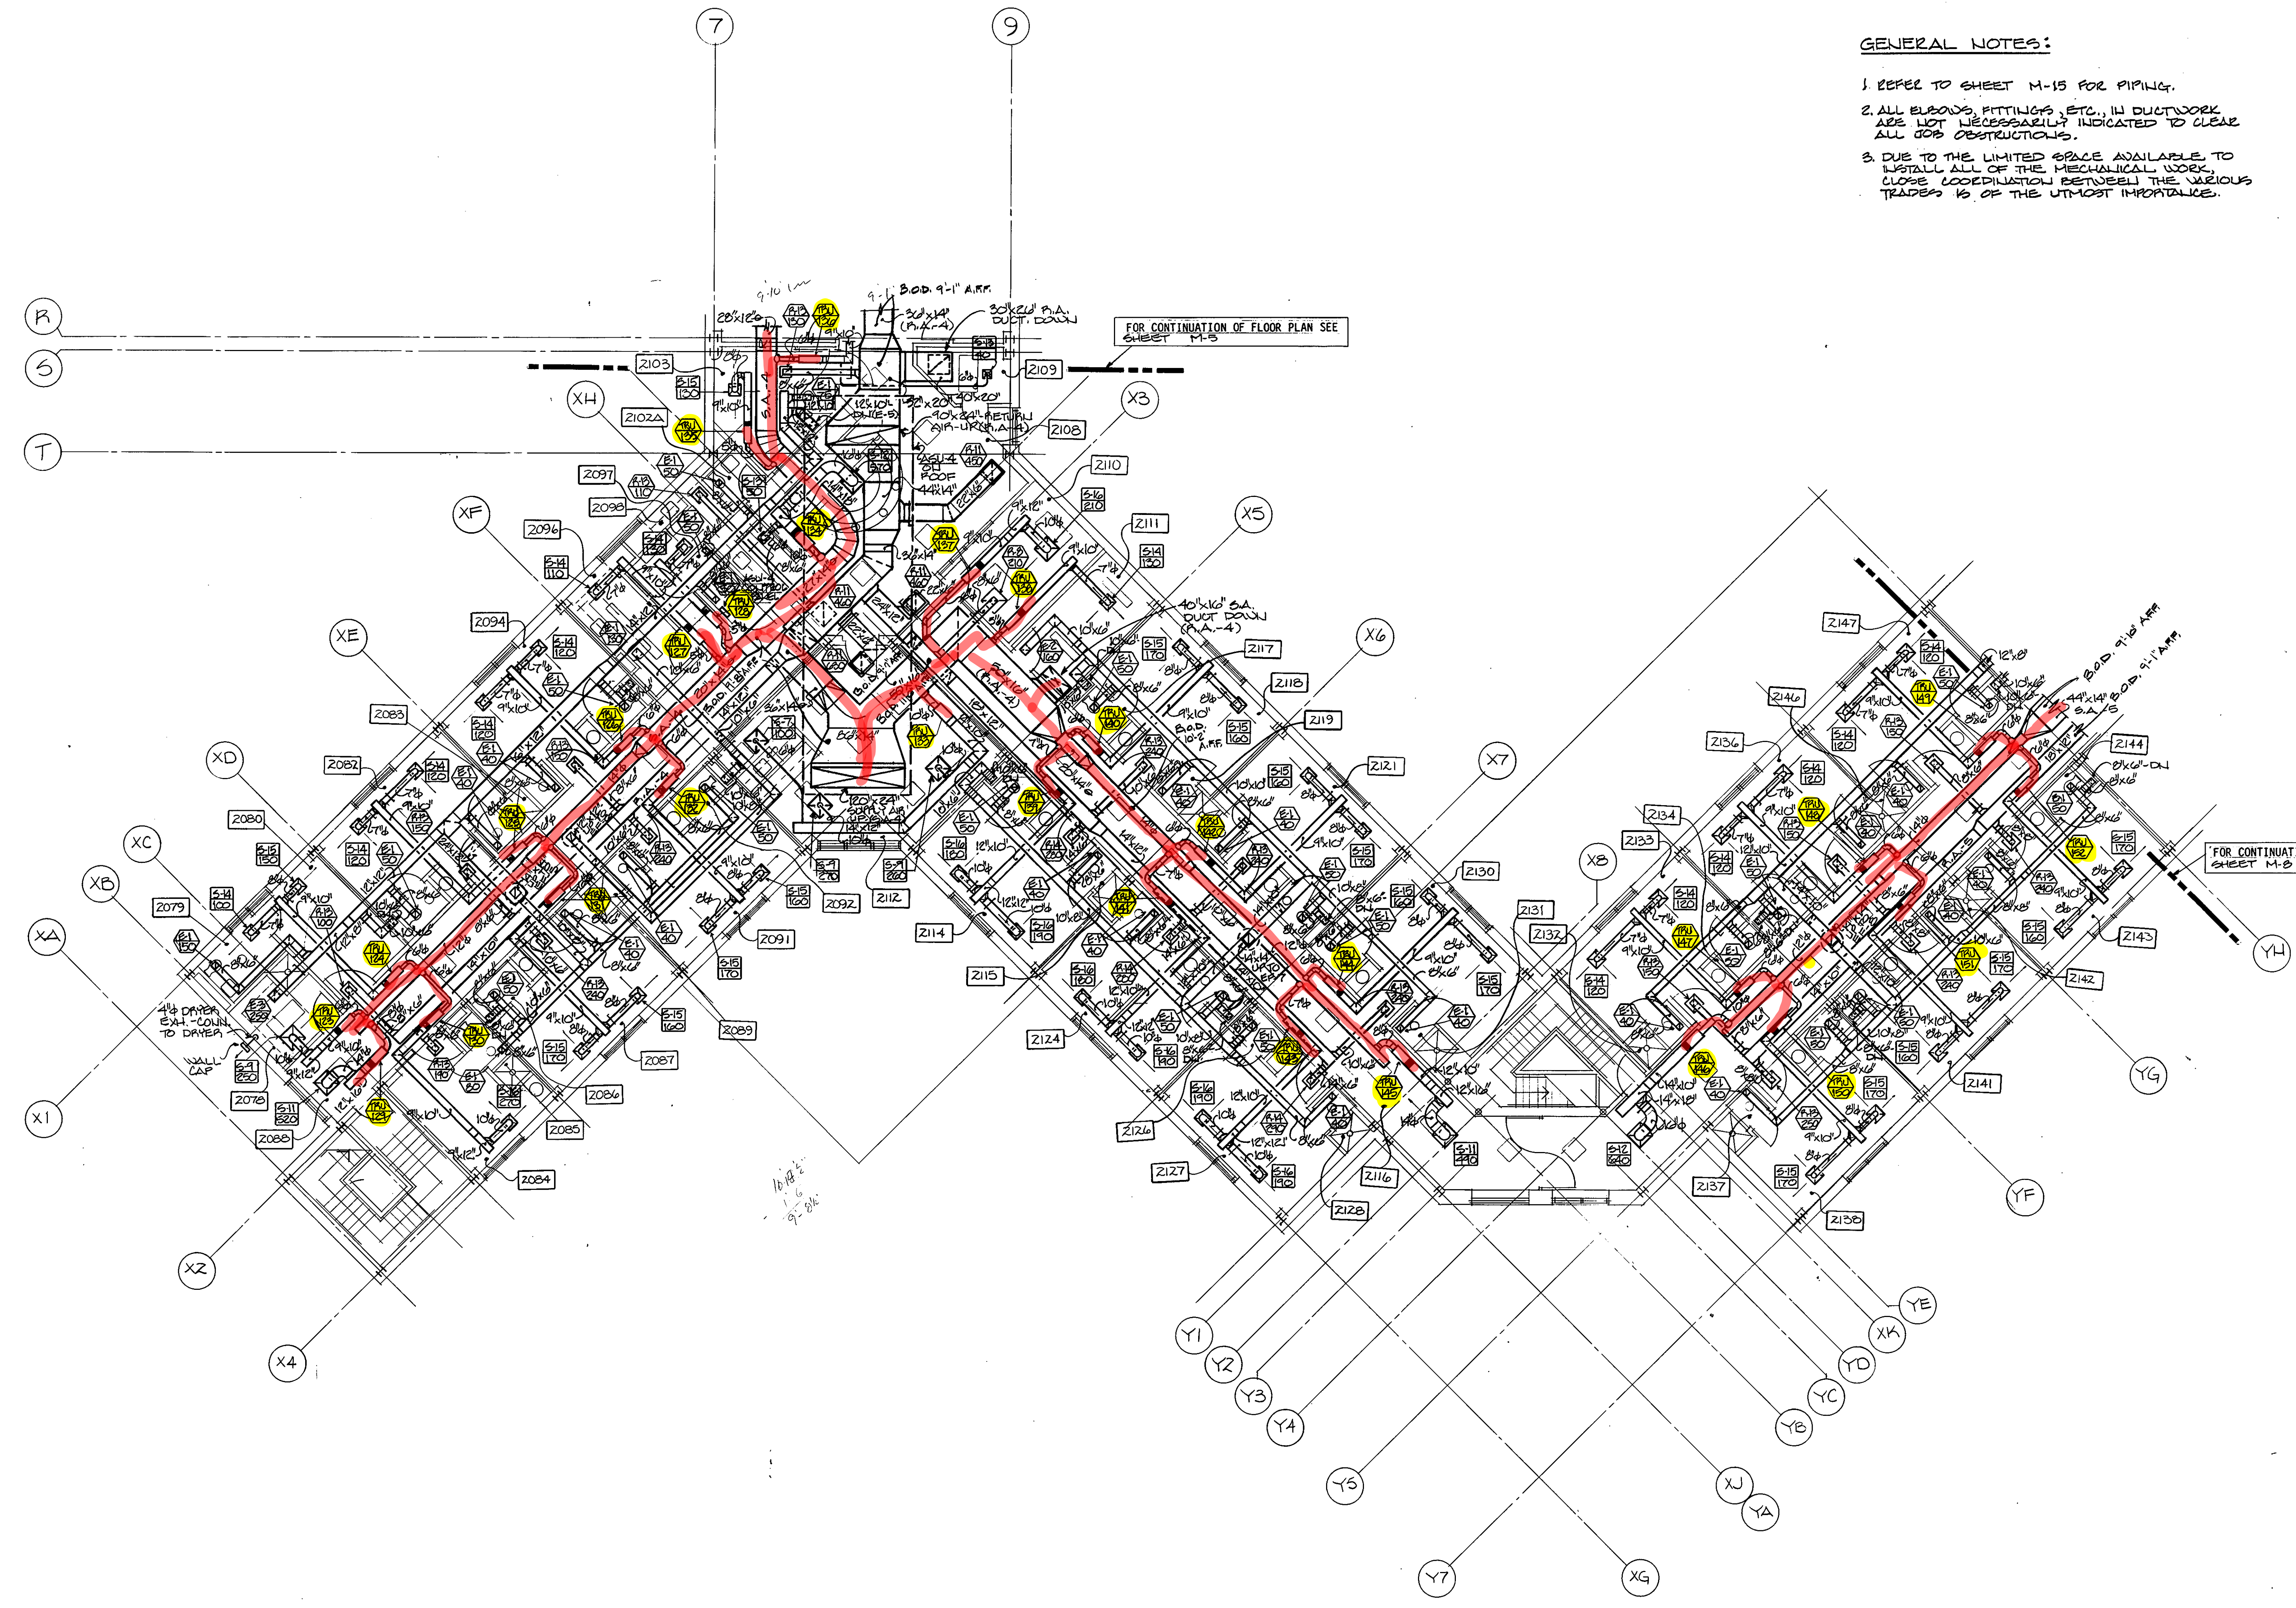

**KEY PLAN**

**DRAWING TITLE:**  
PARTIAL SECOND FLOOR  
DUCTWORK - AREA S3

**SCALE:** 1/8" = 1'-0"

**REVISIONS:**


TRUE NORTH

PLAN NORTH


*A.S. Builds  
6-8-87  
Richard D. B...*

**FOR REFERENCE ONLY**

SHEET NUMBER:  
**M7**

PROJECT NUMBER:  
83013

ISSUE DATE:  
6-27-85

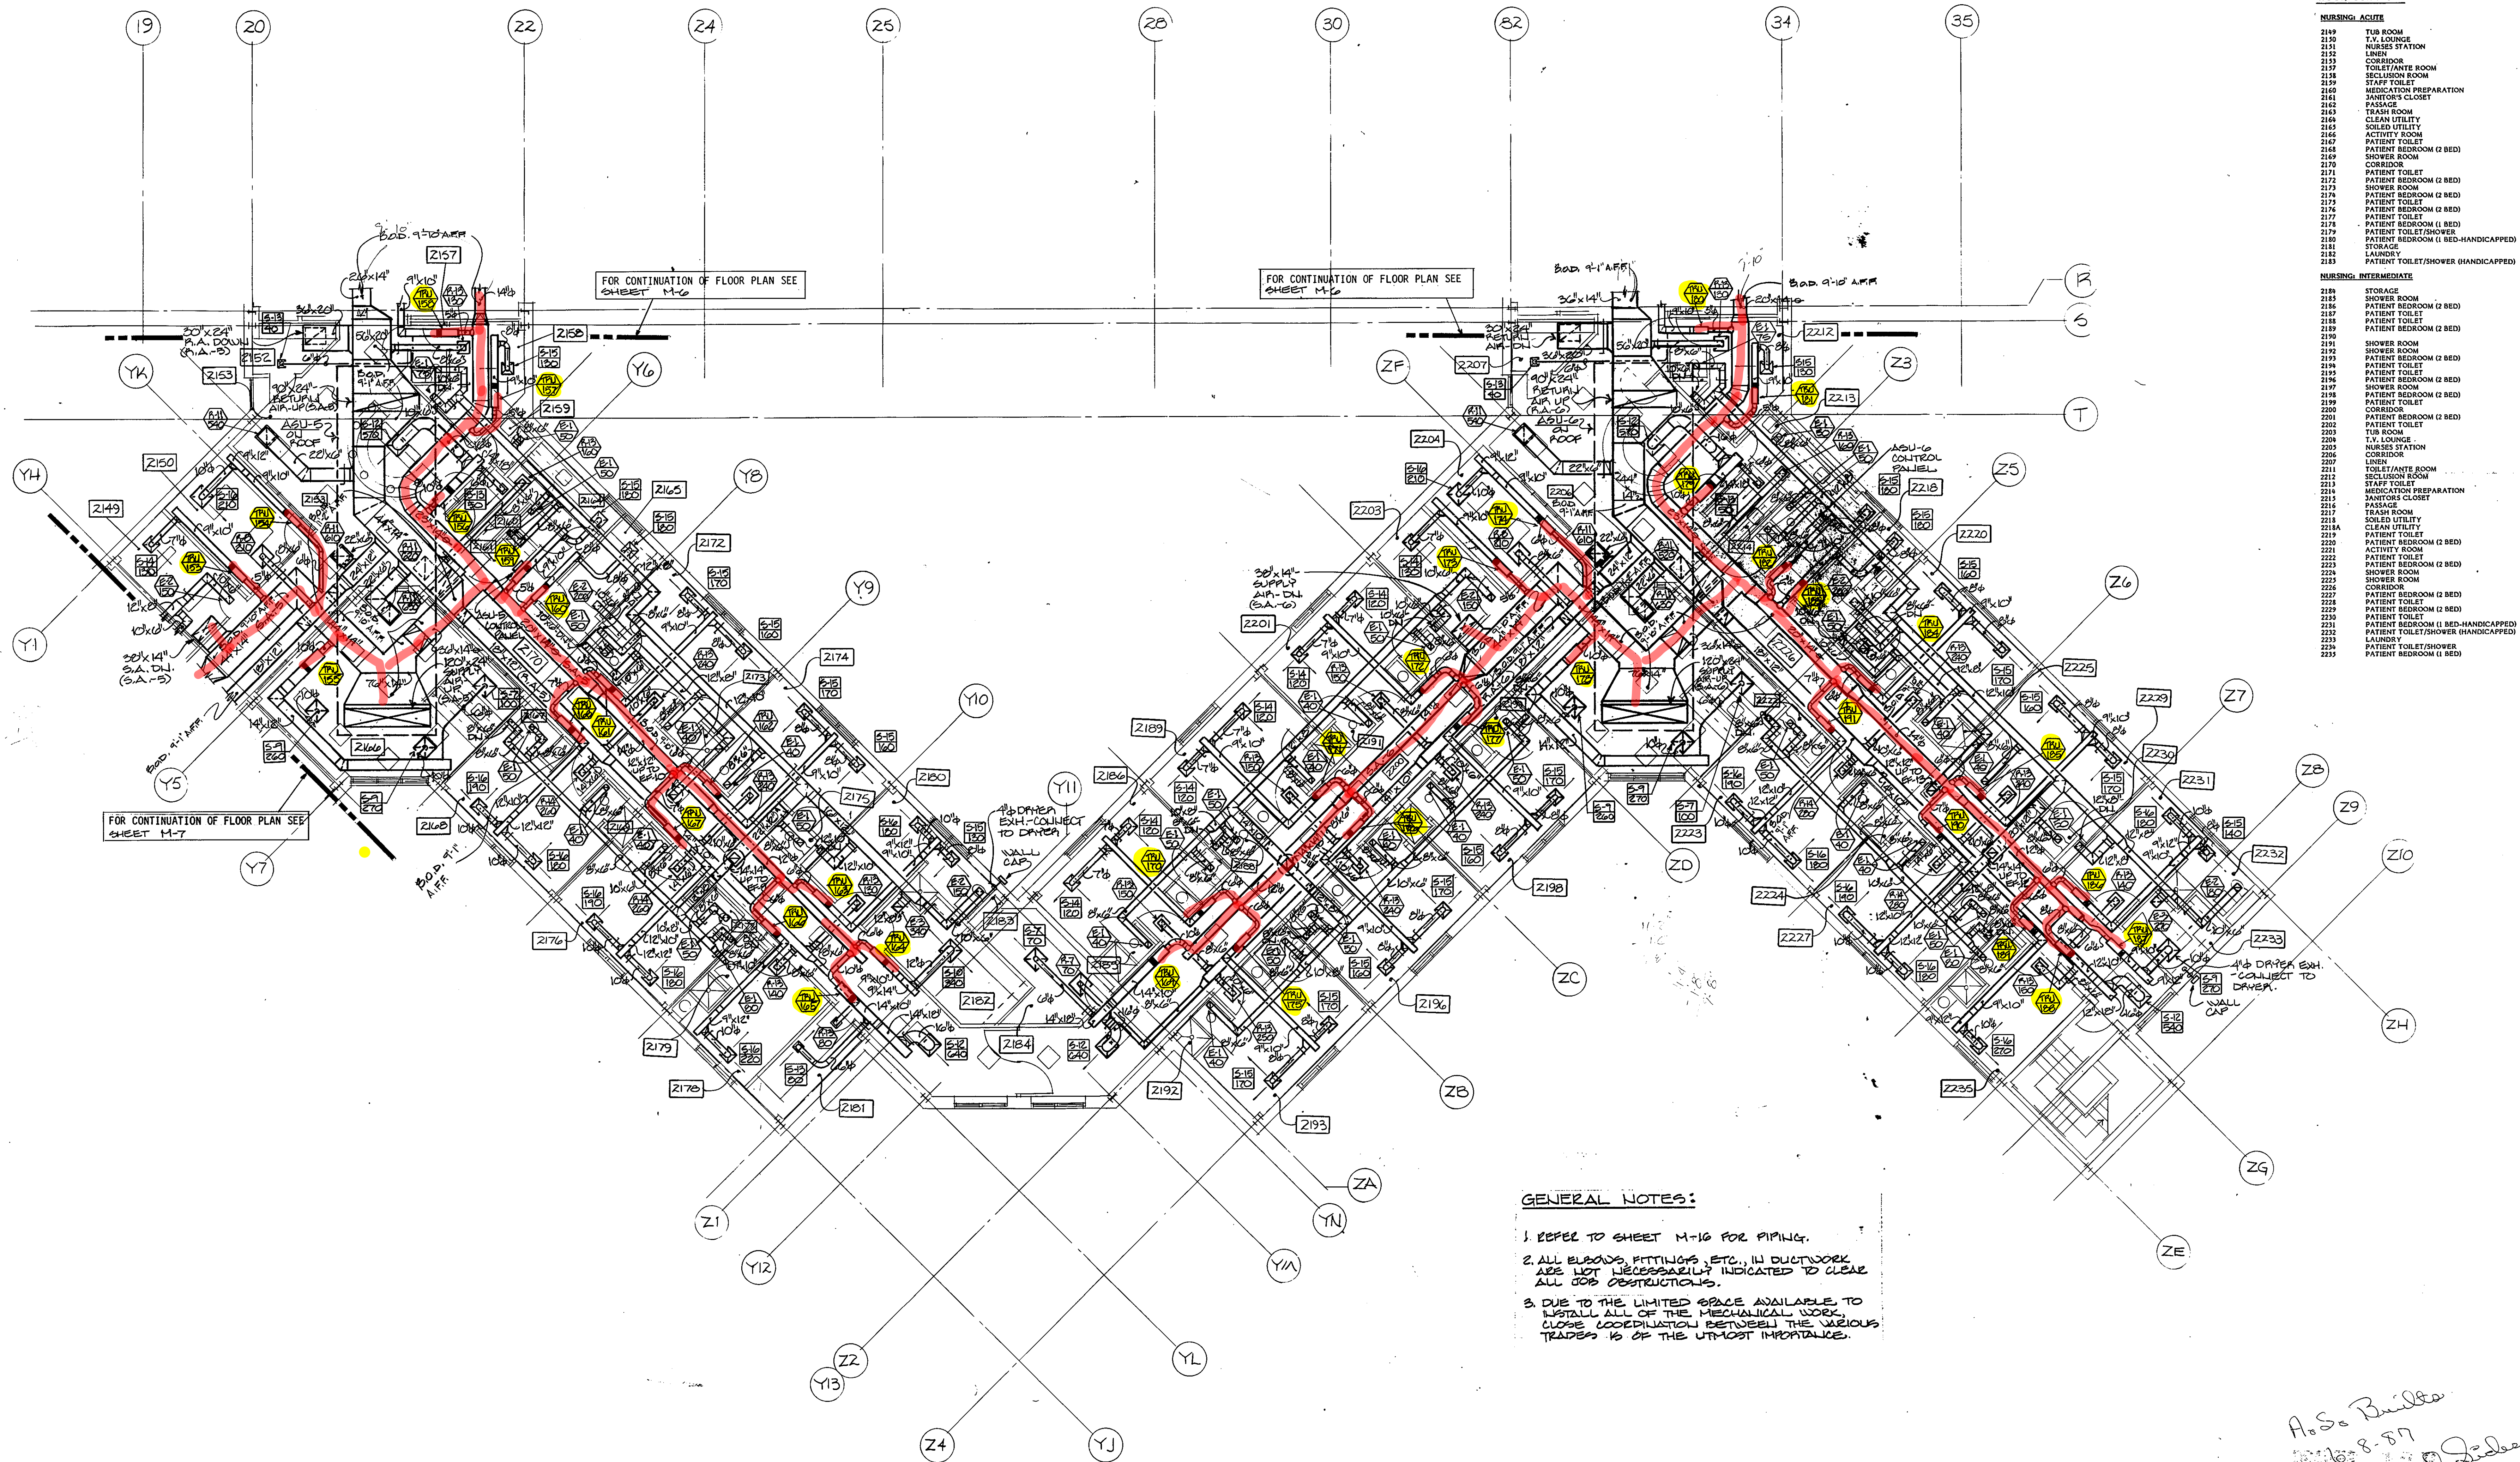

**ROOM SCHEDULE**

**NURSING - ACUTE**


2144	TUB ROOM
2150	T.V. LOUNGE
2151	NURSE STATION
2152	LINEN
2153	CORRIDOR
2157	TOILET/ANTE ROOM
2158	SECLUSION ROOM
2159	STAFF TOILET
2160	MEDICATION PREPARATION
2161	JANITOR'S CLOSET
2162	PASSAGE
2163	TRASH ROOM
2164	CLEAN UTILITY
2165	SOLED UTILITY
2166	ACTIVITY ROOM
2167	PATIENT TOILET
2168	PATIENT BEDROOM (2 BED)
2169	SHOWER ROOM
2170	CORRIDOR
2171	PATIENT TOILET
2172	PATIENT BEDROOM (2 BED)
2173	SHOWER ROOM
2174	PATIENT BEDROOM (2 BED)
2175	PATIENT TOILET
2176	PATIENT BEDROOM (2 BED)
2177	PATIENT TOILET
2178	PATIENT BEDROOM (1 BED)
2179	PATIENT TOILET/SHOWER
2180	PATIENT BEDROOM (1 BED-HANDICAPPED)
2181	STORAGE
2182	LAUNDRY
2183	PATIENT TOILET/SHOWER (HANDICAPPED)

**NURSING - INTERMEDIATE**

2184	STORAGE
2185	SHOWER ROOM
2186	PATIENT BEDROOM (2 BED)
2187	PATIENT TOILET
2188	PATIENT BEDROOM (2 BED)
2189	PATIENT TOILET
2190	SHOWER ROOM
2191	SHOWER ROOM
2192	PATIENT BEDROOM (2 BED)
2193	PATIENT TOILET
2194	PATIENT TOILET
2195	PATIENT TOILET
2196	SHOWER ROOM
2197	PATIENT BEDROOM (2 BED)
2198	PATIENT TOILET
2199	CORRIDOR
2200	PATIENT BEDROOM (2 BED)
2201	PATIENT TOILET
2202	TUB ROOM
2203	T.V. LOUNGE
2204	NURSE STATION
2205	CORRIDOR
2206	LINEN
2211	TOILET/ANTE ROOM
2212	SECLUSION ROOM
2213	STAFF TOILET
2214	MEDICATION PREPARATION
2215	JANITOR'S CLOSET
2216	PASSAGE
2217	TRASH ROOM
2218	CLEAN UTILITY
2219	SOLED UTILITY
2220	PATIENT BEDROOM (2 BED)
2221	PATIENT BEDROOM (2 BED)
2222	PATIENT TOILET
2223	PATIENT BEDROOM (2 BED)
2224	SHOWER ROOM
2225	SHOWER ROOM
2226	CORRIDOR
2227	PATIENT TOILET
2228	PATIENT BEDROOM (2 BED)
2229	PATIENT TOILET
2230	PATIENT BEDROOM (1 BED-HANDICAPPED)
2231	PATIENT TOILET/SHOWER (HANDICAPPED)
2232	LAUNDRY
2233	PATIENT TOILET/SHOWER
2234	PATIENT BEDROOM (1 BED)

**GENERAL NOTES:**

1. REFER TO SHEET M-16 FOR PIPING.
2. ALL ELBOWS, FITTINGS, ETC., IN DUCTWORK ARE NOT NECESSARILY INDICATED TO CLEAR ALL JOB OBSTRUCTIONS.
3. DUE TO THE LIMITED SPACE AVAILABLE TO INSTALL ALL OF THE MECHANICAL WORK, CLOSE COORDINATION BETWEEN THE VARIOUS TRADES IS OF THE UTMOST IMPORTANCE.

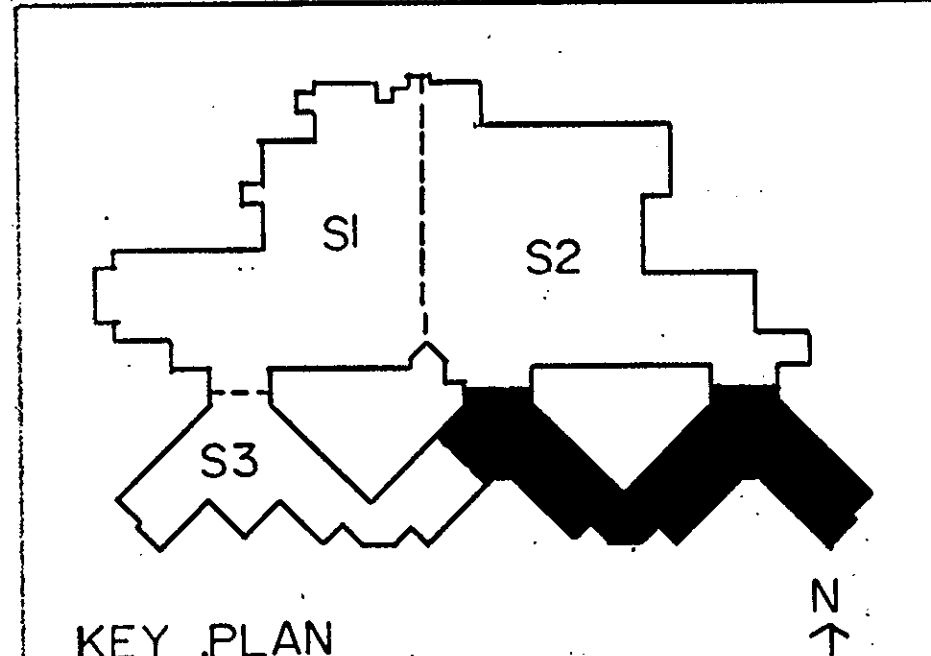

TRUE NORTH  
PLAN NORTH

**DRAWING TITLE:**  
PARTIAL SECOND FLOOR  
DUCTWORK - AREA S4

SCALE: 1/8" = 1'0"


REVISIONS:	DATE:	BY:

FOR REFERENCE ONLY

SHEET NUMBER:  
**M8**

PROJECT NUMBER:  
83013  
ISSUE DATE:  
6-27-85

THE CHRISNER PARTNERSHIP, NC ARCHITECTS AND PLANNERS, 20 SOUTH HANLEY RD., CLAYTON, MISSOURI 63105 314-725-2927 - 11 W. VICTORY WAY - CRAIG, COLORADO 81625 303-824-9707

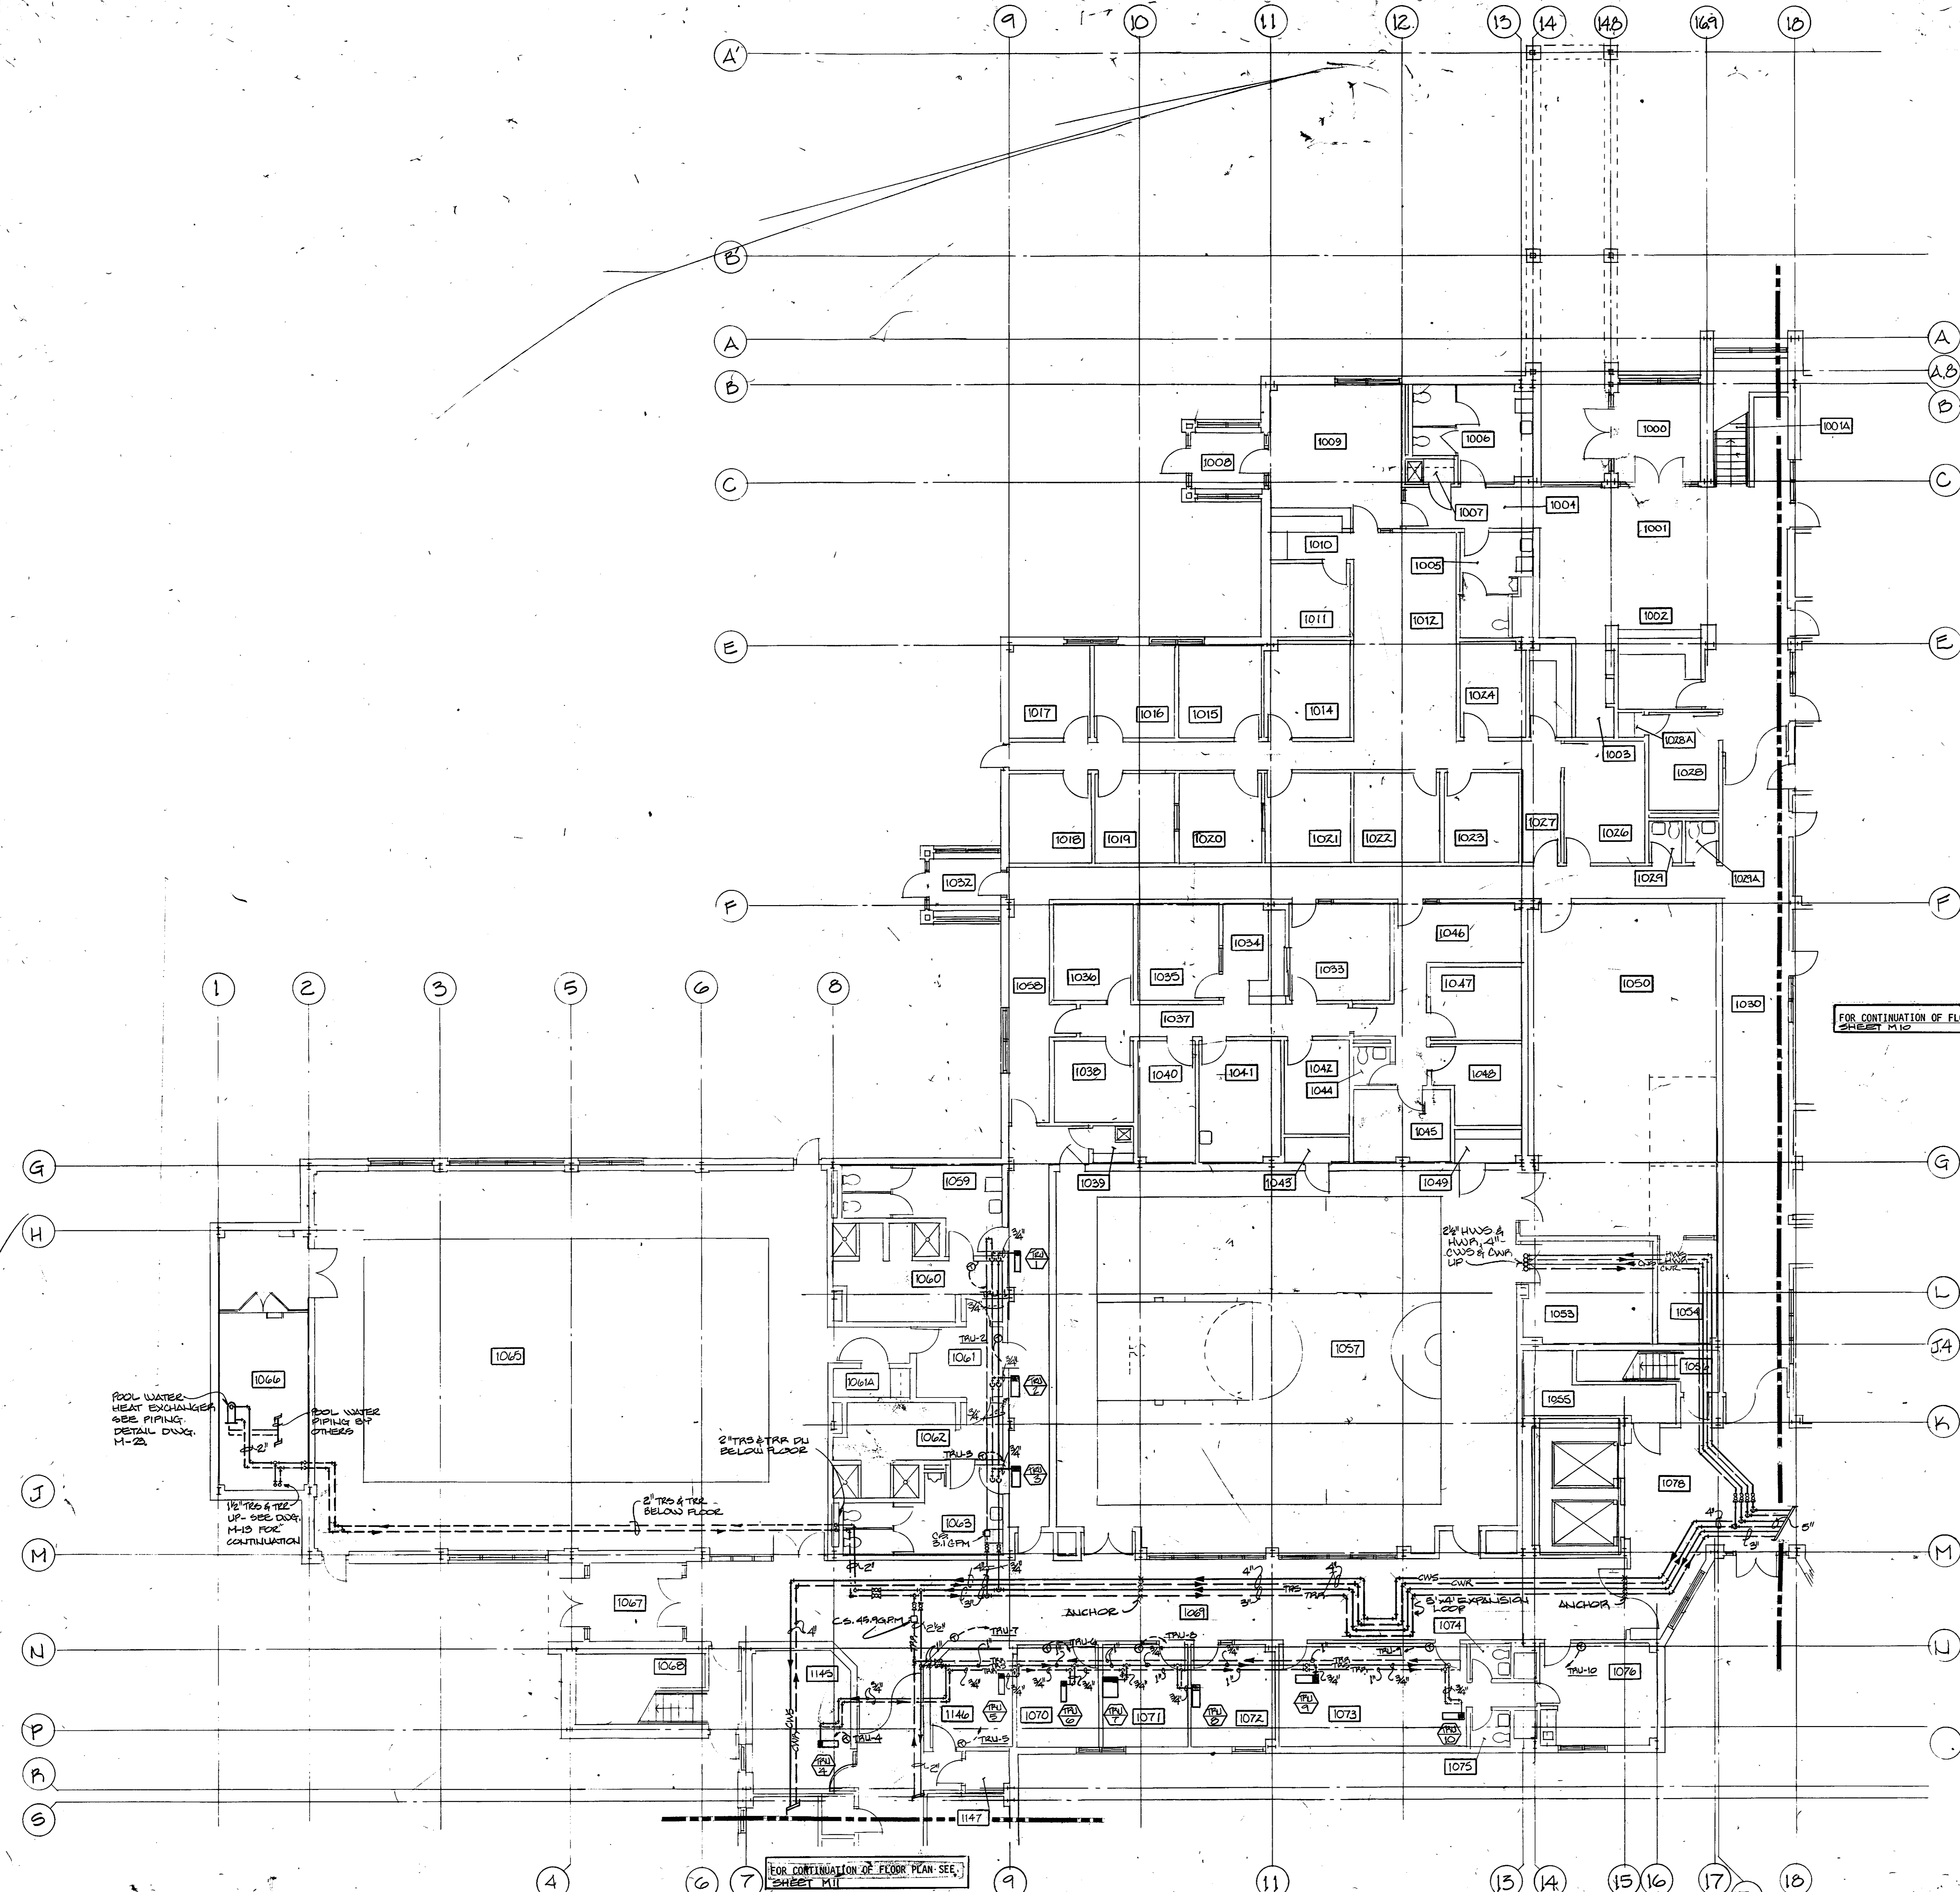


**ROOM SCHEDULE**

1000	MAIN ENTRY VESTIBULE
1001	STAIR NO. 1
1002	RECEPTIONIST
1003	TELEPHONE
1004	CORRIDOR
1005	PUBLIC MALE TOILET
1006	PUBLIC FEMALE TOILET
1007	JANITORS CLOSET
<b>OUTPATIENT</b>	
1008	VESTIBULE
1009	WAITING
1010	RECEPTIONIST
1011	RECORD STORAGE
1012	OPEN WORK AREA
1013	PASSAGE
1014	NURSES TREATMENT OFFICE
1015	SOCIAL WORKERS OFFICE
1016	SOCIAL WORKERS OFFICE
1017	UNIT DIRECTORS OFFICE
1018	PSYCHIATRIST OFFICE
1019	PSYCHOLOGIST OFFICE
1020	THERAPY
1021	PSYCHOLOGIST OFFICE
1022	PSYCHOLOGY TESTING
1023	BIOPHYSICS TEAM
1024	CONSULTANT OFFICE
1025	STORAGE
1026	CONFERENCE ROOM
1027	PASSAGE
<b>COMMUNICATIONS</b>	
1028	MAIL ROOM
1029	STORAGE CLOSET
<b>CIRCULATION</b>	
1029	STAFF MALE TOILET
1029A	STAFF FEMALE TOILET
1030	CORRIDOR
1031	PASSAGE
1032	VESTIBULE
<b>ADMITTING</b>	
1033	WAITING
1034	RECEPTIONIST
1035	ADMITTING CLERK
1036	ADMITTING CLERK
1037	PASSAGE
1038	ADMITTING CLERK
<b>CIRCULATION</b>	
1039	JANITORS CLOSET
1040	WORK ROOM
1041	EXAMINATION
1042	ADMITTING CLERK
1043	ELECTRICAL CLOSET
<b>ADMITTING/ACCOUNTING</b>	
1044	TOILET
1045	RESOURCE INVESTIGATOR
1046	SECRETARY
1047	RESOURCE INVESTIGATOR
1048	RESOURCE INVESTIGATOR
<b>PATIENT ACTIVITY</b>	
1049	STORAGE
1050	PT/OT/ACTIVITY/TREATMENT EQUIP. STOR.
1051	EQUIP./CHAIR STORAGE
1052	ACTIVITY THERAPY OFFICE
<b>CIRCULATION</b>	
1053	ELEV. EQUIPMENT ROOM
1054	STAIR NO. 2
<b>PATIENT ACTIVITY</b>	
1055	GYMNASIUM
1056	CORRIDOR
1057	PATIENT FEMALE ACTIVITY TOILET
1058	SHOWERS/LOCKERS
1059	PASSAGE
1060	WASHER/DRYER
1061	SHOWERS/LOCKERS
1062	PATIENT MALE ACTIVITY TOILET
1063	CORRIDOR
1064	POOL
1065	POOL EQUIPMENT
<b>CIRCULATION</b>	
1066	VESTIBULE
1067	STAIR NO. 3
1068	CORRIDOR
<b>NURSING ACUTE SECURED</b>	
1069	SOCIAL WORKERS OFFICE
1070	PSYCHIATRIST OFFICE
1071	PSYCHOLOGIST OFFICE
1072	STAFF LOCKERS
1073	STAFF FEMALE TOILET
1074	STAFF MALE TOILET
1075	STAFF LOUNGE
<b>CIRCULATION</b>	
1076	ELEVATOR LOBBY
<b>NURSING ACUTE SECURED</b>	
1115	CONFERENCE
1116	COUNSELING ROOM
1117	ELECTRICAL CLOSET

FOR CONTINUATION OF FLOOR PLAN SEE SHEET M12

- GENERAL NOTES:**
- REFER TO SHEET M1 FOR DUCTWORK.
  - ALL ELBOWS, FITTINGS, ETC., IN PIPING ARE NOT NECESSARILY INDICATED TO CLEAR ALL JOB OBSTRUCTIONS.
  - DUE TO LIMITED SPACE AVAILABLE TO INSTALL ALL OF THE MECHANICAL WORK, CLOSE COORDINATION BETWEEN THE VARIOUS TRADES IS OF THE UTMOST IMPORTANCE.

*AS-Built  
6-8-87  
Richard S. Baker*

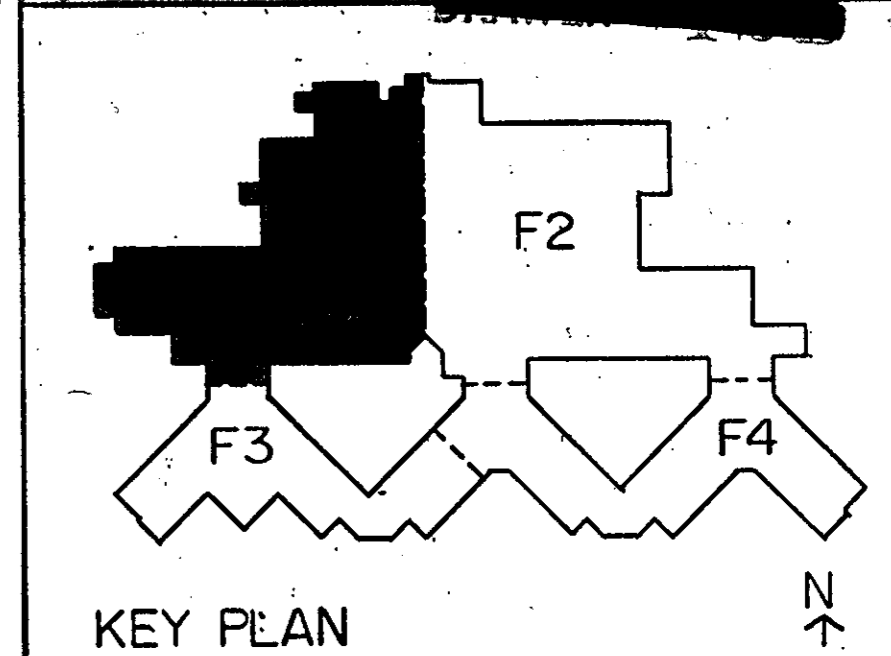

**DRAWING TITLE:**  
PARTIAL FIRST FLOOR  
PIPING - AREA F1

**SCALE:** 1/8" = 1'-0"

**REVISIONS:**

5-21-87	REV. 1
AS-BUILT	REV. 2

FOR REFERENCE ONLY

**SHEET NUMBER:**  
M9

**PROJECT NUMBER:**  
83013

**ISSUE DATE:**  
6-27-85



**KEYED NOTES:**

- 1 GAS LINE DOWN IN WALL. MAKE FINAL CONNECTION TO EQUIPMENT. PROVIDE GAS COCK AT EACH CONNECTION.
- 2 HEATING CONTRACTOR TO CONNECT 3/4" STEAM LINE FROM STEAM GENERATOR TO RADIATORS. VERIFY EXACT LOCATION WITH WATCHEL EQUIPMENT DRAWINGS.
- 3 FIRE FUEL SHUT-OFF VALVE INSTALLED & WIRED BY HEATING CONTRACTOR.


**ROOM SCHEDULE:**

1079	GIFT SHOP
1080	OPEN WORK AREA
1081	DIRECTOR'S OFFICE
1082	TRANS. EQUIP. ROOM
1083	OPEN WORK AREA
1084	RECORD STORAGE
1085	SECURITY OFFICE
1086	ELECTRICAL CLOSET
1087	STORAGE
1088	MECHANICAL ROOM
1089	STAFF DINING
1090	STAFF SERVING
1091	PATIENT DINING
1092	PASSAGE
1093	PASSAGE
1094	FREEZER
1095	FREEZER
1096	DAILY REFRIGERATOR
1097	ELECTRICAL CLOSET
1098	JANITORS CLOSET
1099	JANITORS CLOSET
1100	FREEZER
1101	INDUCTION REFRIGERATOR
1102	RECEIVING
1103	PASSAGE
1104	INGREDIENT ROOM
1105	GENERAL STORAGE
1106	PAPER/CHEMICAL STORAGE
1107	RECEIVING OFFICE
1108	JANITORS CLOSET
1109	JANITORS CLOSET
1110	CORRIDOR
1111	CORRIDOR
1112	FEMALE TOILET
1113	CORRIDOR
1114	MALE TOILET
1115	DISHWASHING AREA
1116	PRODUCTION AREA
1117	ASSEMBLY AREA
1118	EMPLOYEE LOCKER/LOCKERS
1119	FOOD SERVICE MANAGER/DIETITIAN
1120	FOOD SERVICE DIRECTORS OFFICE
1121	DIETITIAN
1122	JANITORS CLOSET
1123	TRASH ROOM
1124	CART WASH
1125	NOISEKEEPING
1126	SUPPLIES STORAGE
1127	CUSTOMER SUPERVISORS OFFICE
1128	TOILET SHOWER
1129	SOILED LINEN
1130	MILK LINEN/CART MAKE-UP
1131	EXCHANGE CART HOLDING
1132	ELECTRICAL ROOM
1133	CIRCULATION
1134	VESTIBULE
1135	STAIR NO. 4
1136	CORRIDOR
1137	CORRIDOR
1138	CORRIDOR
1139	CORRIDOR
1140	PATIENT FEMALE TOILET
1141	PATIENT MALE TOILET
1142	NURSING INTERMEDIATE SHARED SUPPORT
1143	SOCIAL WORKERS OFFICE
1144	PSYCHIATRIST OFFICE
1145	ACTIVITY THERAPY SUPERVISORS OFFICE
1146	UNIT DIRECTORS OFFICE
1147	SECRETARY
1148	NURSE SUPERVISORS OFFICE
1149	SOCIAL WORKERS SUPERVISORS OFFICE
1150	PSYCHIATRIST OFFICE
1151	PSYCHOLOGIST OFFICE
1152	SOCIAL WORKERS OFFICE
1153	NURSING INTERMEDIATE
1154	ELECTRICAL CLOSET
1155	COUNSELING ROOM
1156	CONFERENCE ROOM
1157	ELECTRICAL CLOSET
1158	COUNSELING ROOM
1159	CONFERENCE ROOM
1160	CONFERENCE ROOM

**GENERAL NOTES:**

- 1 REFER TO SHEET M-6 FOR DUCTWORK.
- 2 ALL ELBOWS, FITTINGS, ETC., IN PIPING ARE NOT NECESSARILY INDICATED TO CLEAR ALL JOB OBSTRUCTIONS.
- 3 DUE TO LIMITED SPACE AVAILABLE TO INSTALL ALL OF THE MECHANICAL WORK, CLOSE COORDINATION BETWEEN THE VARIOUS TRADES IS OF THE UTMOST IMPORTANCE.

*AS BUILT  
6-8-87  
Kendall D. ...*

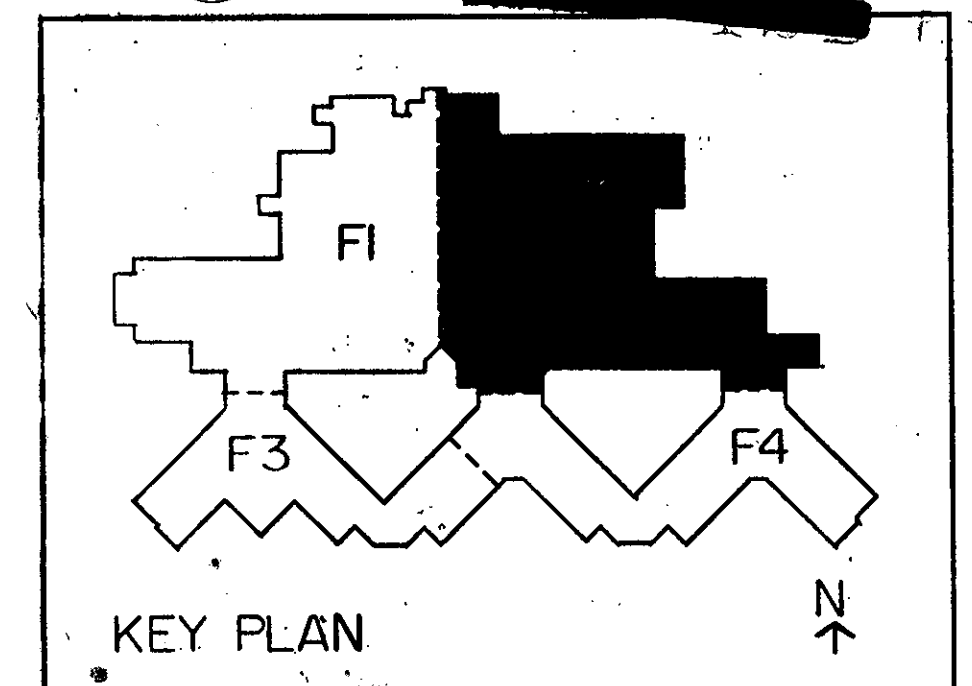


**TRUE NORTH**  
**PLAN NORTH**

**DRAWING TITLE:**  
PARTIAL FIRST FLOOR  
PIPING - AREA F2

**SCALE:** 1/8" = 1'-0"

**REVISIONS:**


**FOR REFERENCE ONLY**

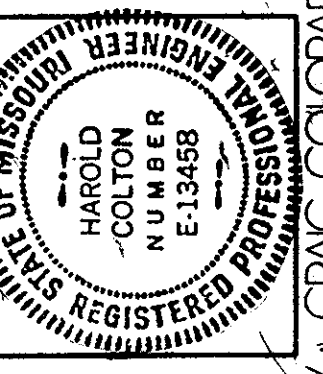


THE CHRISTNER PARTNERSHIP NC ARCHITECTS AND PLANNERS  
20 SOUTH HANLEY RD. CLAYTON, MISSOURI - 63106 314-725-2921 - 11 VICTORY WAY - CRAIG COLORADO - 8625 308-824-9707

**SHEET NUMBER:**  
**M10**

**PROJECT NUMBER:**  
83013

**ISSUE DATE:**  
6-27-85

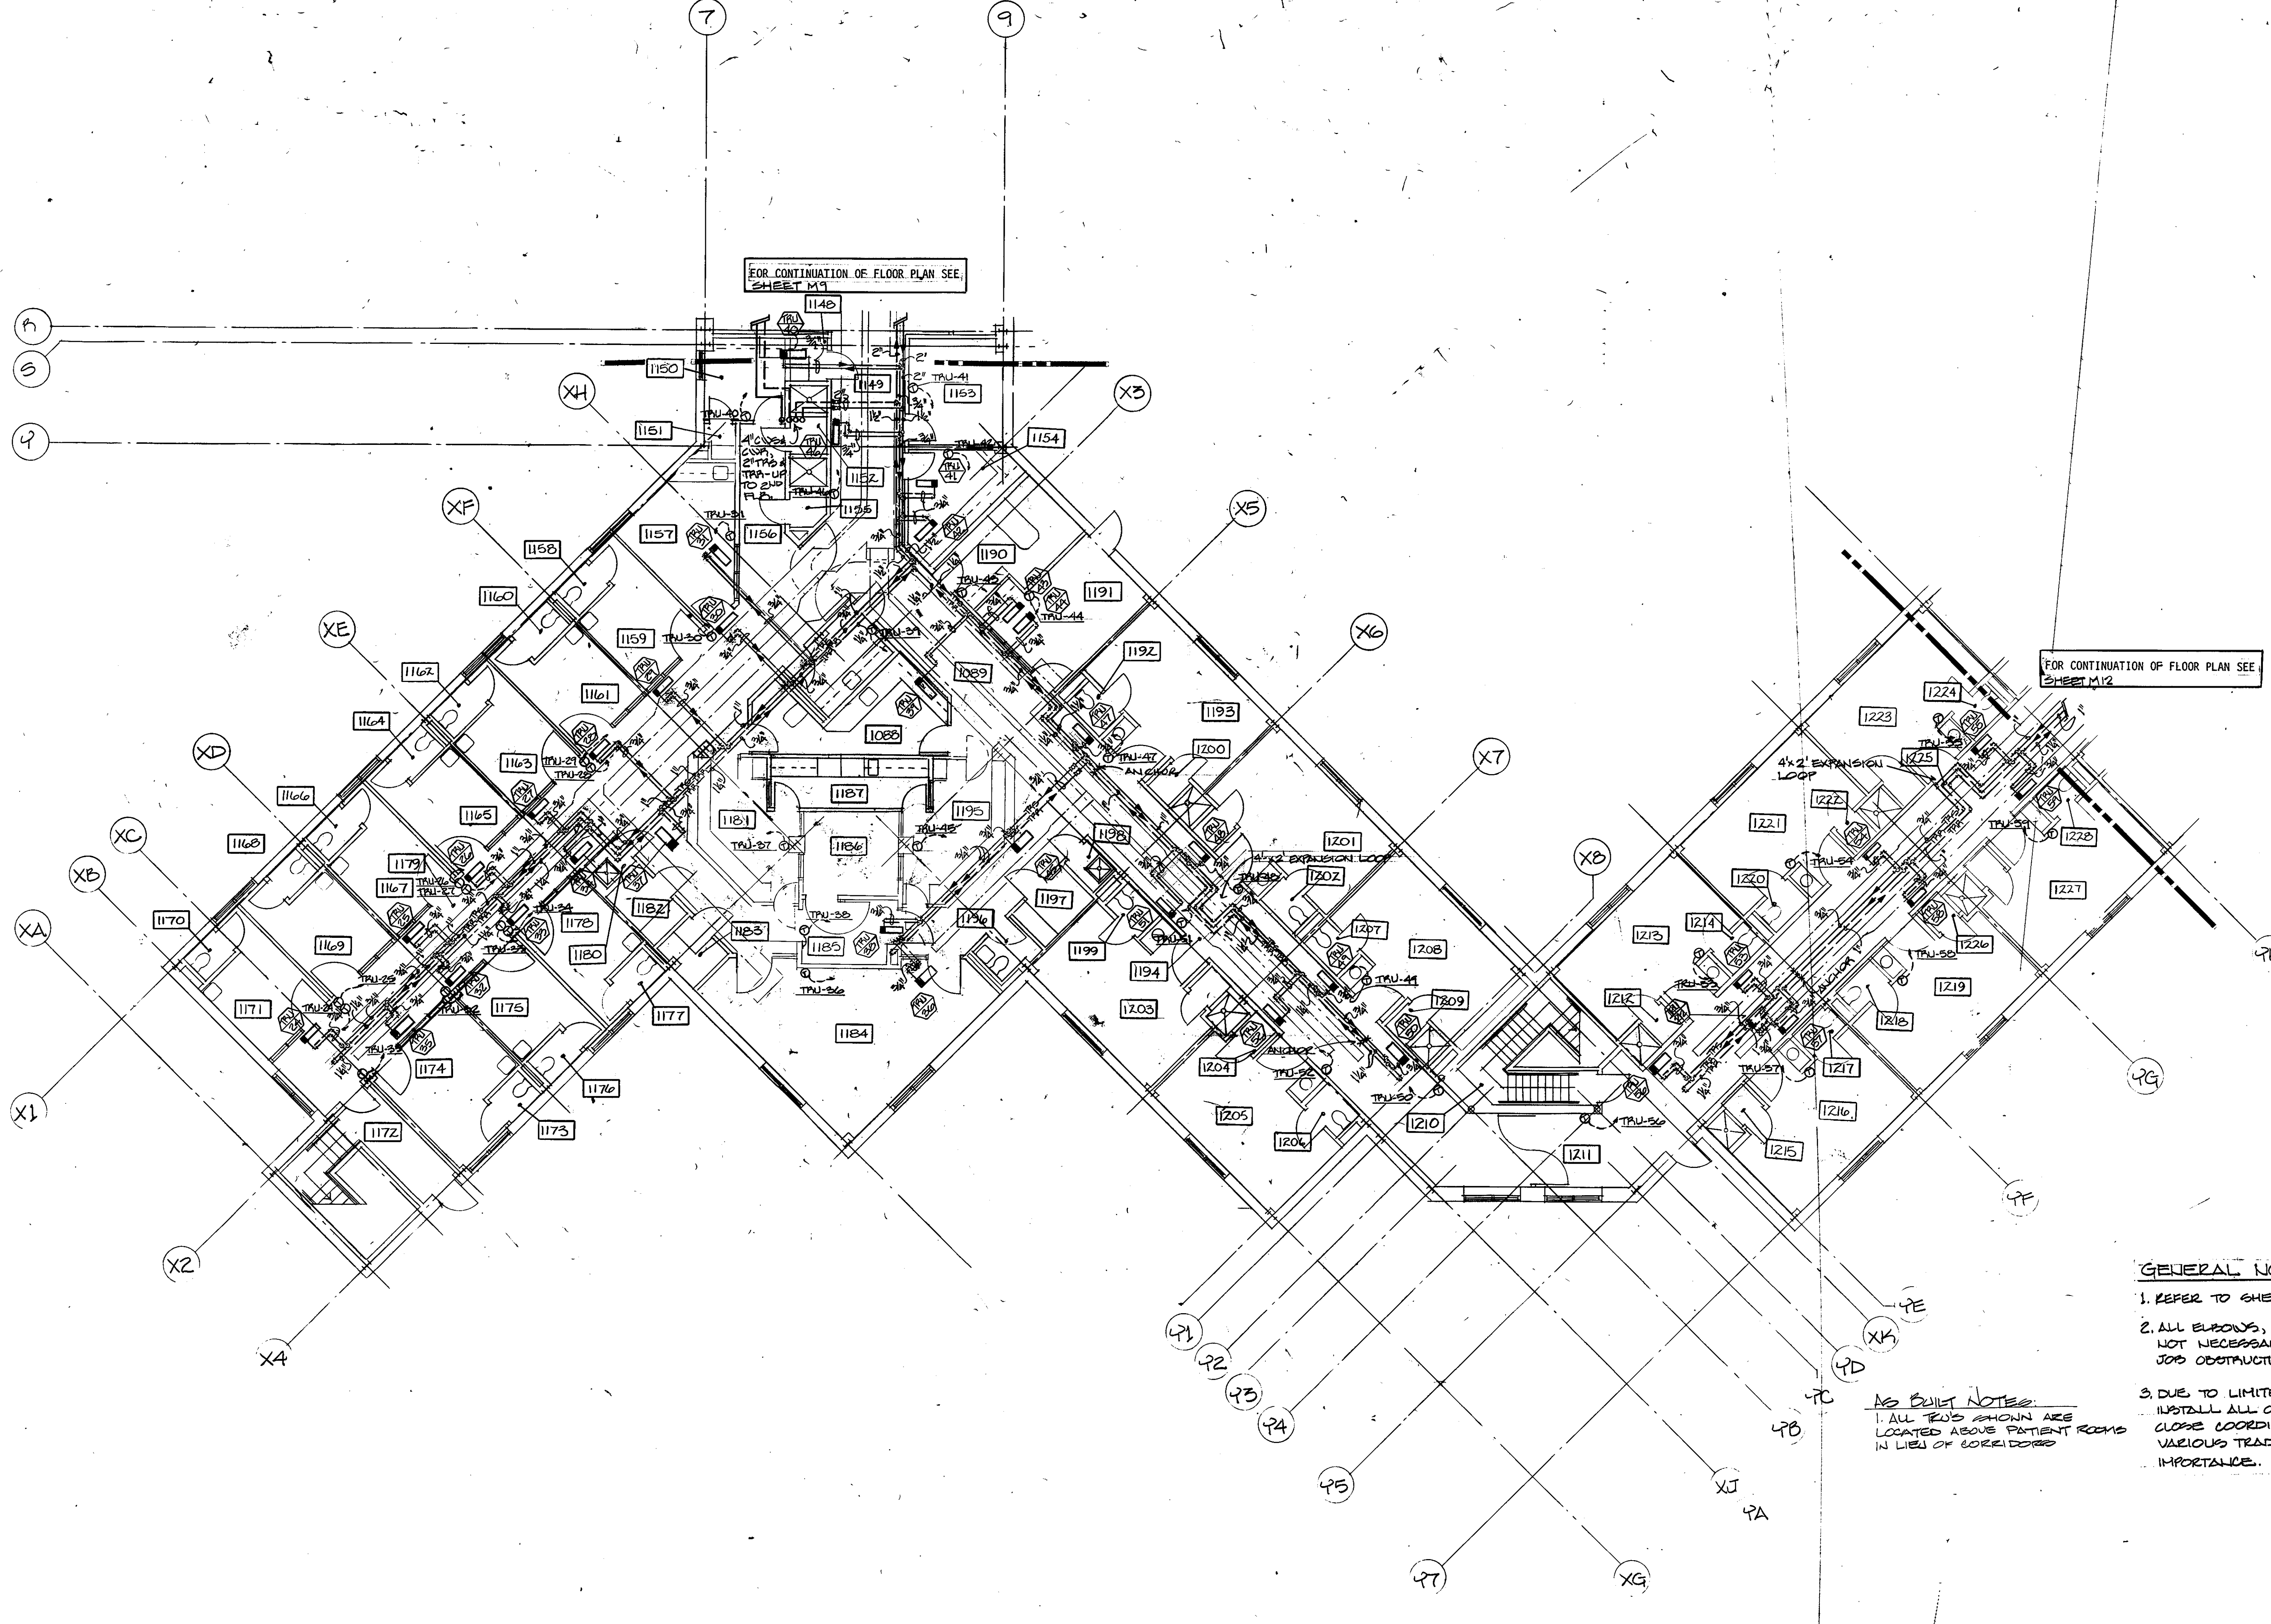


**ROOM SCHEDULE**

1148	TRASH ROOM
1149	CORRIDOR
1150	LAUNDRY
1151	SHOWER ROOM
1152	EXAM/TREATMENT ROOM
1153	LAUNDRY
1154	SHOWER ROOM
1155	PACIENT
1156	PATIENT TOILET
1157	PATIENT BEDROOM (1 BED)
1158	PATIENT TOILET
1159	PATIENT BEDROOM (1 BED)
1160	PATIENT TOILET
1161	PATIENT BEDROOM (1 BED)
1162	PATIENT TOILET
1163	PATIENT BEDROOM (1 BED)
1164	PATIENT TOILET
1165	PATIENT BEDROOM (1 BED)
1166	PATIENT TOILET
1167	PATIENT BEDROOM (1 BED)
1168	PATIENT TOILET
1169	PATIENT BEDROOM (1 BED)
1170	PATIENT TOILET
1171	PATIENT BEDROOM (1 BED)
1172	STAR NO. 5
1173	PATIENT TOILET
1174	PATIENT BEDROOM (1 BED)
1175	PATIENT TOILET
1176	PATIENT BEDROOM (1 BED)
1177	PATIENT TOILET
1178	PATIENT BEDROOM (1 BED)
1179	CORRIDOR
1180	NURSE'S CLOSET
1181	NURSE STATION
1182	LINEN
1183	STORAGE
1184	ACTIVITY ROOM
1185	TOILET/ANTE ROOM
1186	SECLUSION ROOM
1187	MEDICATION PREPARATION
1188	SOLEID UTILITY
1189	CLEAN UTILITY
1190	TUB ROOM
1191	T.V. LOUNGE
1192	PATIENT TOILET
1193	PATIENT BEDROOM (2 BED)
1194	CORRIDOR
1195	NURSE STATION
1196	TOILET
1197	PATIENT TOILET
1198	NURSE'S CLOSET
1199	PATIENT TOILET
1200	PATIENT BEDROOM (2 BED)
1201	PATIENT TOILET
1202	PATIENT BEDROOM (2 BED)
1203	SHOWER ROOM
1204	PATIENT BEDROOM (2 BED)
1205	PATIENT TOILET
1206	PATIENT BEDROOM (2 BED)
1207	PATIENT TOILET
1208	PATIENT BEDROOM (2 BED)
1209	SHOWER ROOM
1210	STAR NO. 4
1211	VESTIBULE
1212	SHOWER ROOM
1213	PATIENT BEDROOM (2 BED)
1214	PATIENT TOILET
1215	SHOWER ROOM
1216	PATIENT BEDROOM (2 BED)
1217	PATIENT TOILET
1218	PATIENT BEDROOM (2 BED)
1219	PATIENT TOILET
1220	PATIENT BEDROOM (2 BED)
1221	SHOWER ROOM
1222	PATIENT TOILET
1223	PATIENT BEDROOM (2 BED)
1224	CORRIDOR
1225	SHOWER ROOM
1226	PATIENT BEDROOM (2 BED)
1227	PATIENT TOILET
1228	PATIENT BEDROOM (2 BED)

- GENERAL NOTES:**
1. REFER TO SHEET M12 FOR DUCTWORK.
  2. ALL ELBOWS, FITTINGS, ETC., IN PIPING ARE NOT NECESSARILY INDICATED TO CLEAR ALL JOBS OBSTRUCTIONS.
  3. DUE TO LIMITED SPACE AVAILABLE TO INSTALL ALL OF THE MECHANICAL WORK, CLOSE COORDINATION BETWEEN THE VARIOUS TRADES IS OF THE UTMOST IMPORTANCE.

**AS BUILT NOTES:**  
 1. ALL TENDS SHOWN ARE LOCATED ABOVE PATIENT ROOMS IN LIEU OF CORRIDORS

*A.S. Billed  
 6-8-87  
 Richard Billed*

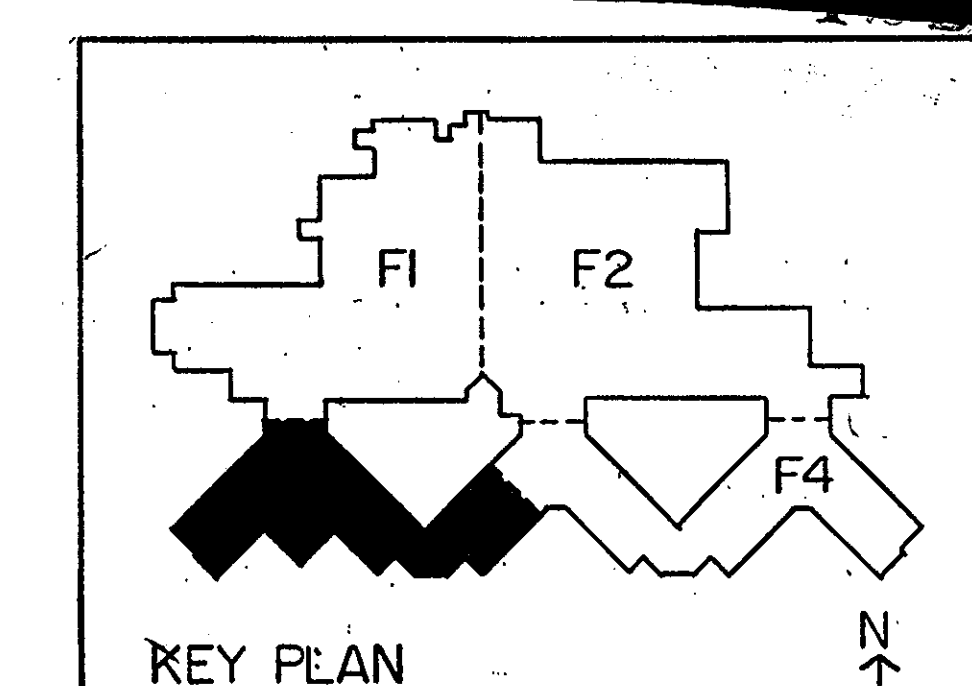

**DRAWING TITLE:**  
 PARTIAL FIRST FLOOR  
 PIPING - AREA F3

**SCALE:** 1/8" = 1'0"

**REVISIONS:**



**FOR REFERENCE ONLY**

**SHEET NUMBER:**  
**M11**

**PROJECT NUMBER:**  
 83013

**ISSUE DATE:**  
 6-27-85

THE CHRISNER PARTNERSHIP INC. ARCHITECTS AND PLANNERS · 20 SOUTH HANLEY RD · CLAYTON, MISSOURI · 63105 · 314-725-2927 · 11 W VICTORY WAY · CRAIG, COLORADO · 81625 · 303-824-9707

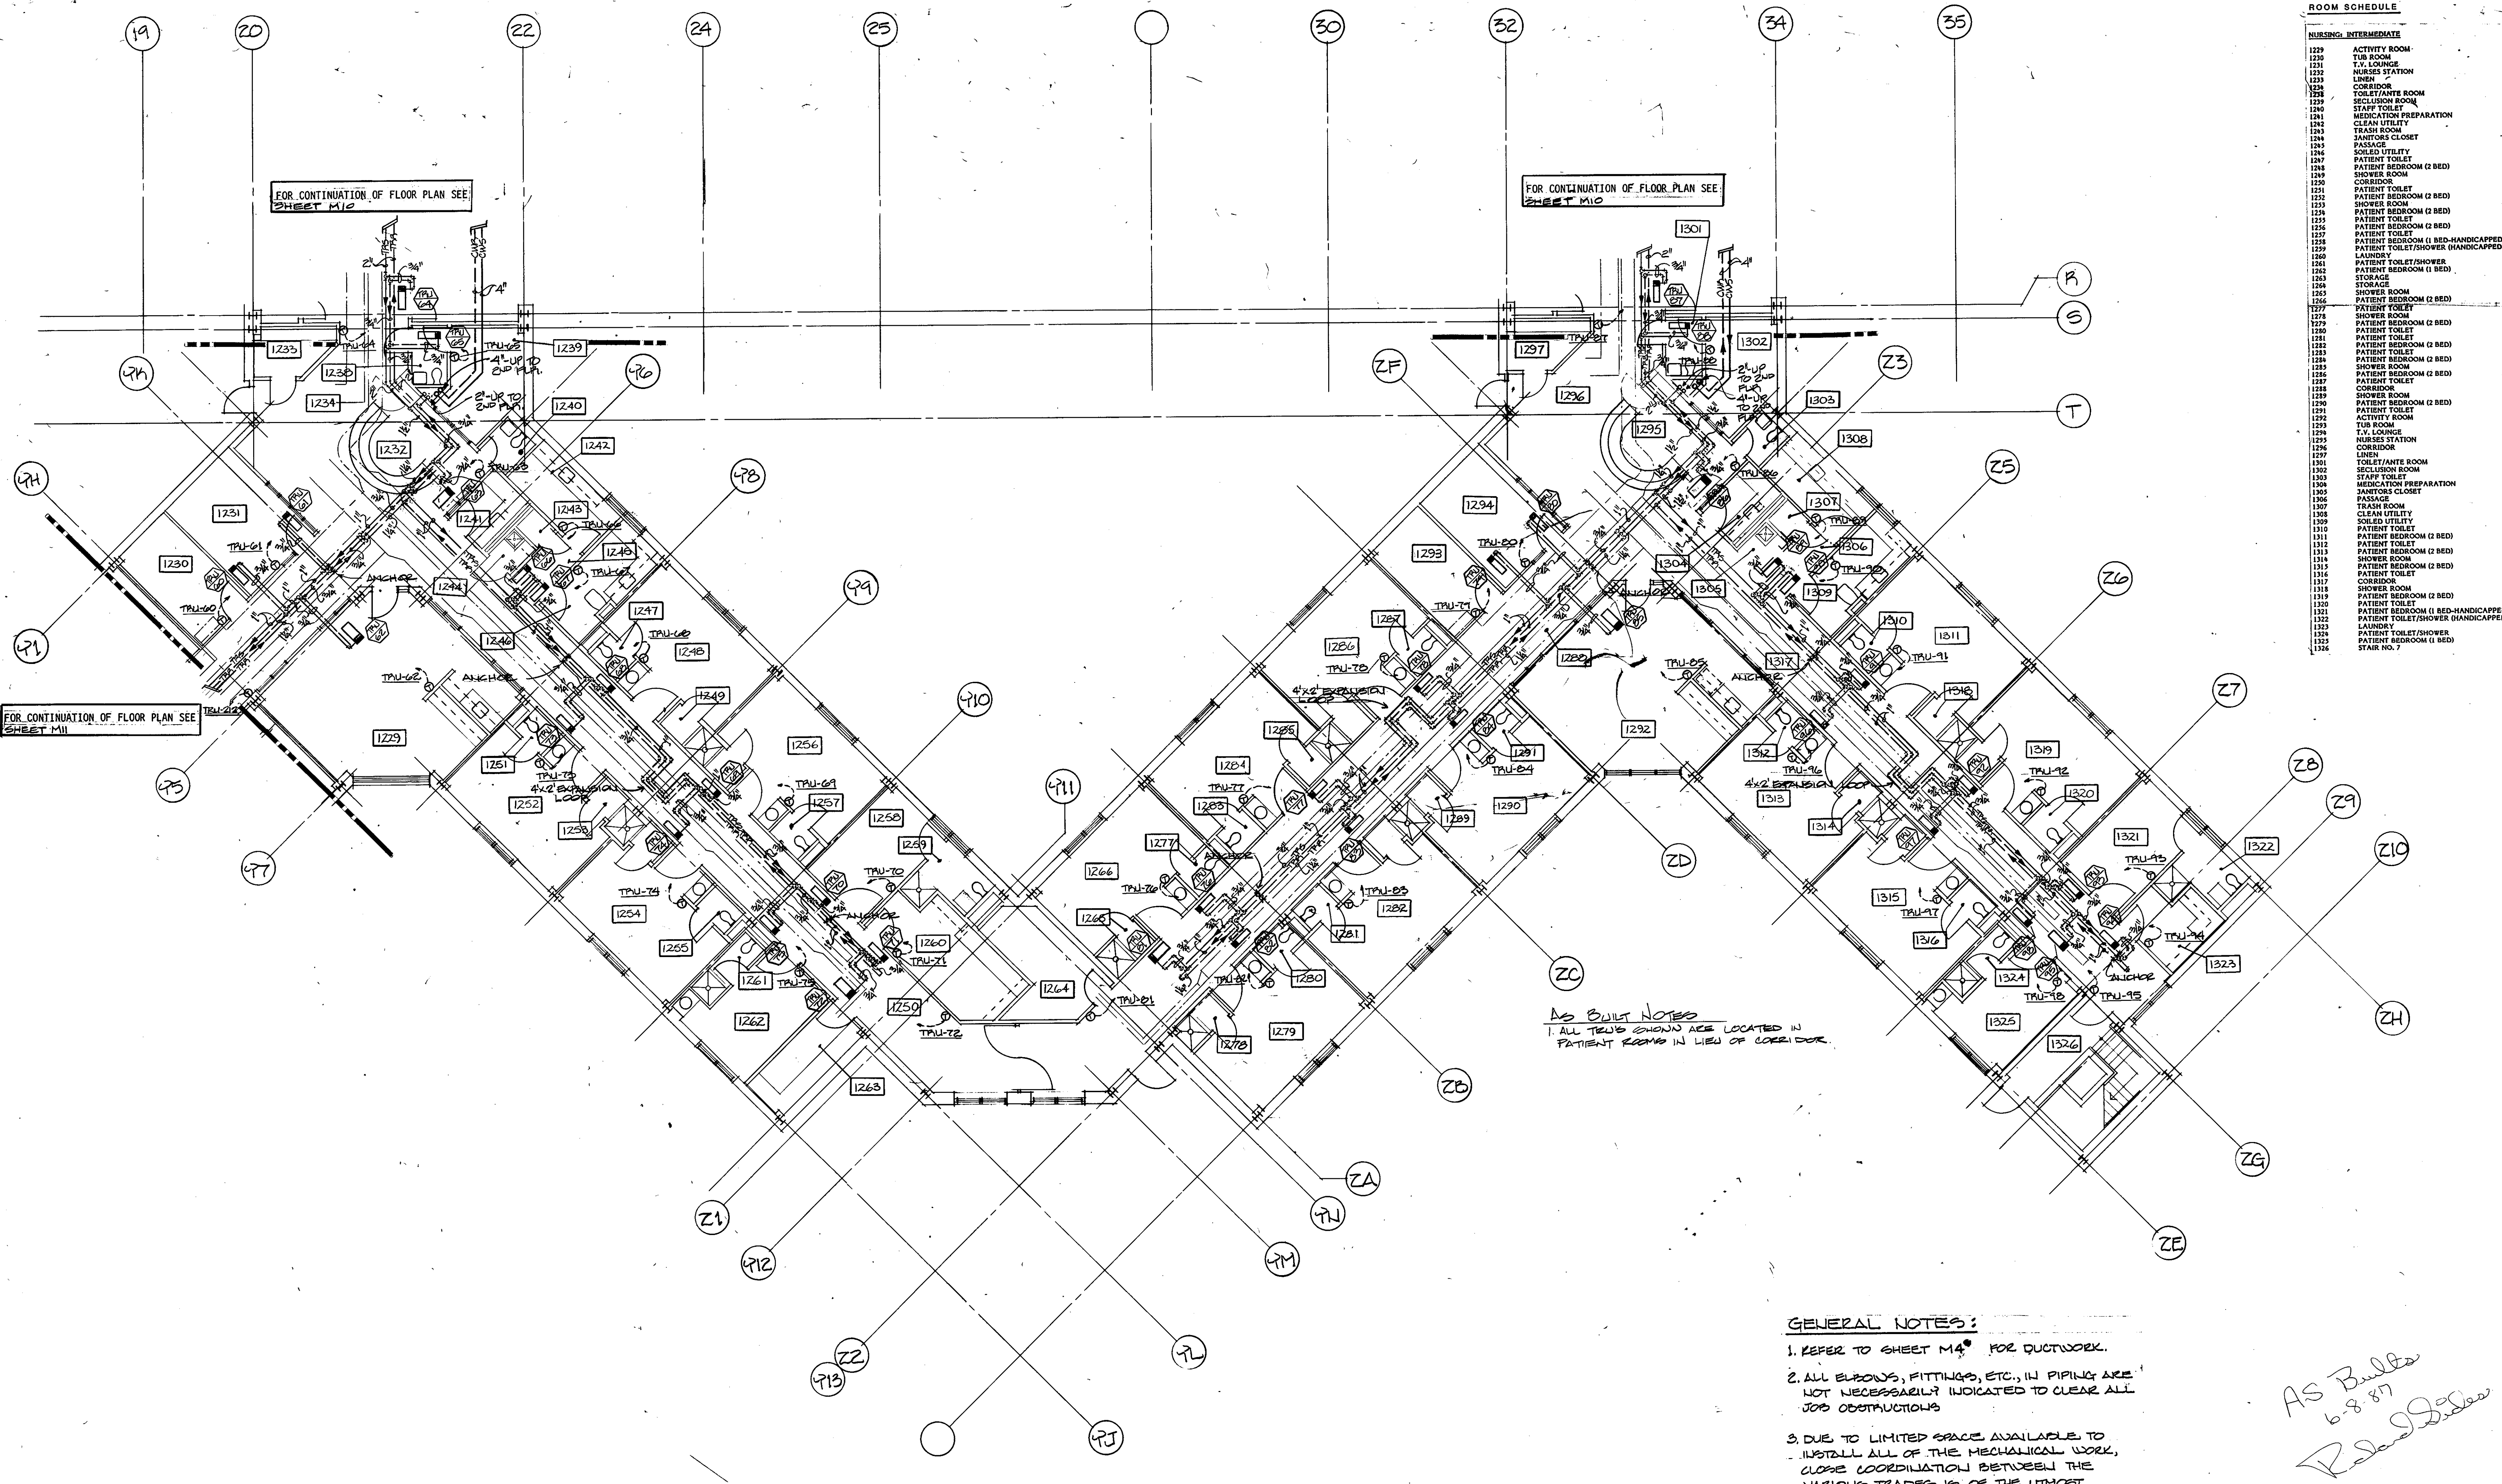


ROOM SCHEDULE	
1229	ACTIVITY ROOM
1230	TUB ROOM
1231	T.V. LOUNGE
1232	NURSE STATION
1233	LINEN - PAT
1234	CORRIDOR
1235	TOILET/ANTE ROOM
1236	SECLUSION ROOM
1237	STAFF TOILET
1238	MEDICATION PREPARATION
1239	CLEAN UTILITY
1240	TRASH ROOM
1241	JANITORS CLOSET
1242	PASSAGE
1243	SOLEID UTILITY
1244	PATIENT TOILET
1245	PATIENT BEDROOM (2 BED)
1246	SHOWER ROOM
1247	CORRIDOR
1248	PATIENT TOILET
1249	PATIENT BEDROOM (2 BED)
1250	SHOWER ROOM
1251	PATIENT TOILET
1252	PATIENT BEDROOM (2 BED)
1253	SHOWER ROOM
1254	PATIENT TOILET
1255	PATIENT BEDROOM (1 BED-HANDICAPPED)
1256	PATIENT TOILET/SHOWER (HANDICAPPED)
1257	LAUNDRY
1258	PATIENT TOILET/SHOWER
1259	PATIENT BEDROOM (1 BED)
1260	STORAGE
1261	SHOWER ROOM
1262	PATIENT BEDROOM (2 BED)
1263	PATIENT TOILET
1264	PATIENT BEDROOM (2 BED)
1265	SHOWER ROOM
1266	PATIENT TOILET
1267	PATIENT BEDROOM (2 BED)
1268	SHOWER ROOM
1269	PATIENT TOILET
1270	PATIENT BEDROOM (2 BED)
1271	ACTIVITY ROOM
1272	TUB ROOM
1273	T.V. LOUNGE
1274	NURSE STATION
1275	CORRIDOR
1276	TOILET/ANTE ROOM
1277	SECLUSION ROOM
1278	STAFF TOILET
1279	PASSAGE
1280	TRASH ROOM
1281	SOLEID UTILITY
1282	PATIENT TOILET
1283	PATIENT BEDROOM (2 BED)
1284	PATIENT TOILET
1285	PATIENT BEDROOM (2 BED)
1286	SHOWER ROOM
1287	PATIENT TOILET
1288	CORRIDOR
1289	SHOWER ROOM
1290	PATIENT BEDROOM (2 BED)
1291	PATIENT TOILET
1292	ACTIVITY ROOM
1293	TUB ROOM
1294	T.V. LOUNGE
1295	NURSE STATION
1296	CORRIDOR
1297	TOILET/ANTE ROOM
1298	SECLUSION ROOM
1299	STAFF TOILET
1300	PASSAGE
1301	TRASH ROOM
1302	SOLEID UTILITY
1303	PATIENT TOILET
1304	PATIENT BEDROOM (2 BED)
1305	PATIENT TOILET
1306	PATIENT BEDROOM (2 BED)
1307	SHOWER ROOM
1308	PATIENT TOILET
1309	PATIENT BEDROOM (2 BED)
1310	SHOWER ROOM
1311	PATIENT TOILET
1312	PATIENT BEDROOM (2 BED)
1313	SHOWER ROOM
1314	PATIENT TOILET
1315	PATIENT BEDROOM (1 BED)
1316	PATIENT TOILET
1317	CORRIDOR
1318	SHOWER ROOM
1319	PATIENT BEDROOM (2 BED)
1320	PATIENT TOILET/SHOWER (HANDICAPPED)
1321	PATIENT TOILET/SHOWER (HANDICAPPED)
1322	LAUNDRY
1323	PATIENT TOILET/SHOWER
1324	PATIENT BEDROOM (1 BED)
1325	PATIENT BEDROOM (1 BED)
1326	STAIR NO. 7

AS BUILT NOTES  
 1. ALL TUBS SHOULD BE LOCATED IN PATIENT ROOMS IN LIEU OF CORRIDOR.

**GENERAL NOTES:**

1. REFER TO SHEET M4 FOR DUCTWORK.
2. ALL ELBOWS, FITTINGS, ETC., IN PIPING ARE NOT NECESSARILY INDICATED TO CLEAR ALL JOB OBSTRUCTIONS.
3. DUE TO LIMITED SPACE AVAILABLE TO INSTALL ALL OF THE MECHANICAL WORK, CLOSE COORDINATION BETWEEN THE VARIOUS TRADES IS OF THE UTMOST IMPORTANCE.

*AS BUILT  
 6-8-87  
 Roland D. [Signature]*

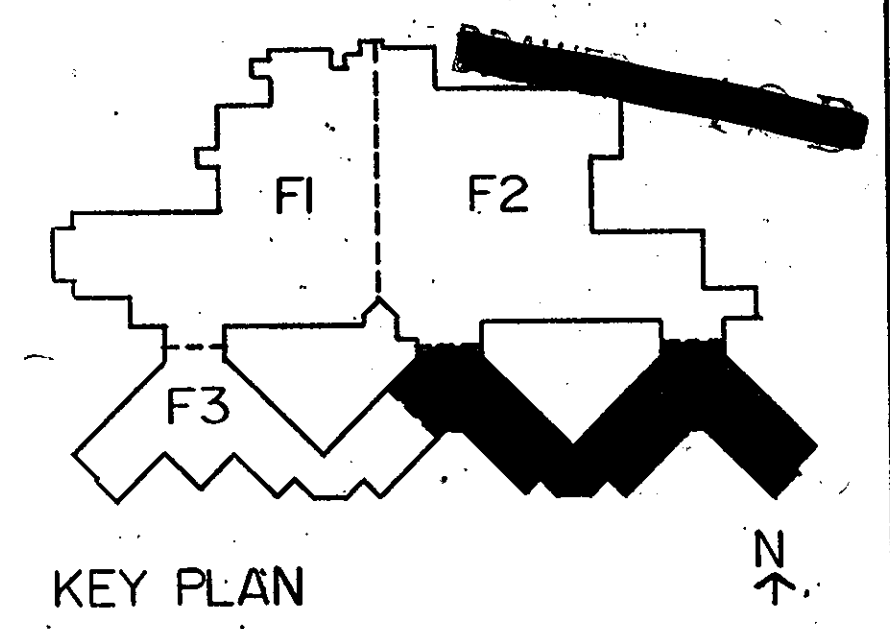

KEY PLAN

DRAWING TITLE:  
**PARTIAL FIRST FLOOR  
 PIPING - AREA F4**

SCALE: 1/8" = 1'-0"


REVISIONS:


**FOR REFERENCE ONLY**

SHEET NUMBER:  
**M12**

PROJECT NUMBER:  
 83013  
 ISSUE DATE:  
 6-27-85

THE CHRISTNER PARTNERSHIP INC. ARCHITECTS AND PLANNERS · 20 SOUTH HANLEY RD · CLAYTON, MISSOURI · 63105 · 314.725.2927 · N W VICTORY WAY · CRAIG, COLORADO · 81625 · 303.824.9707

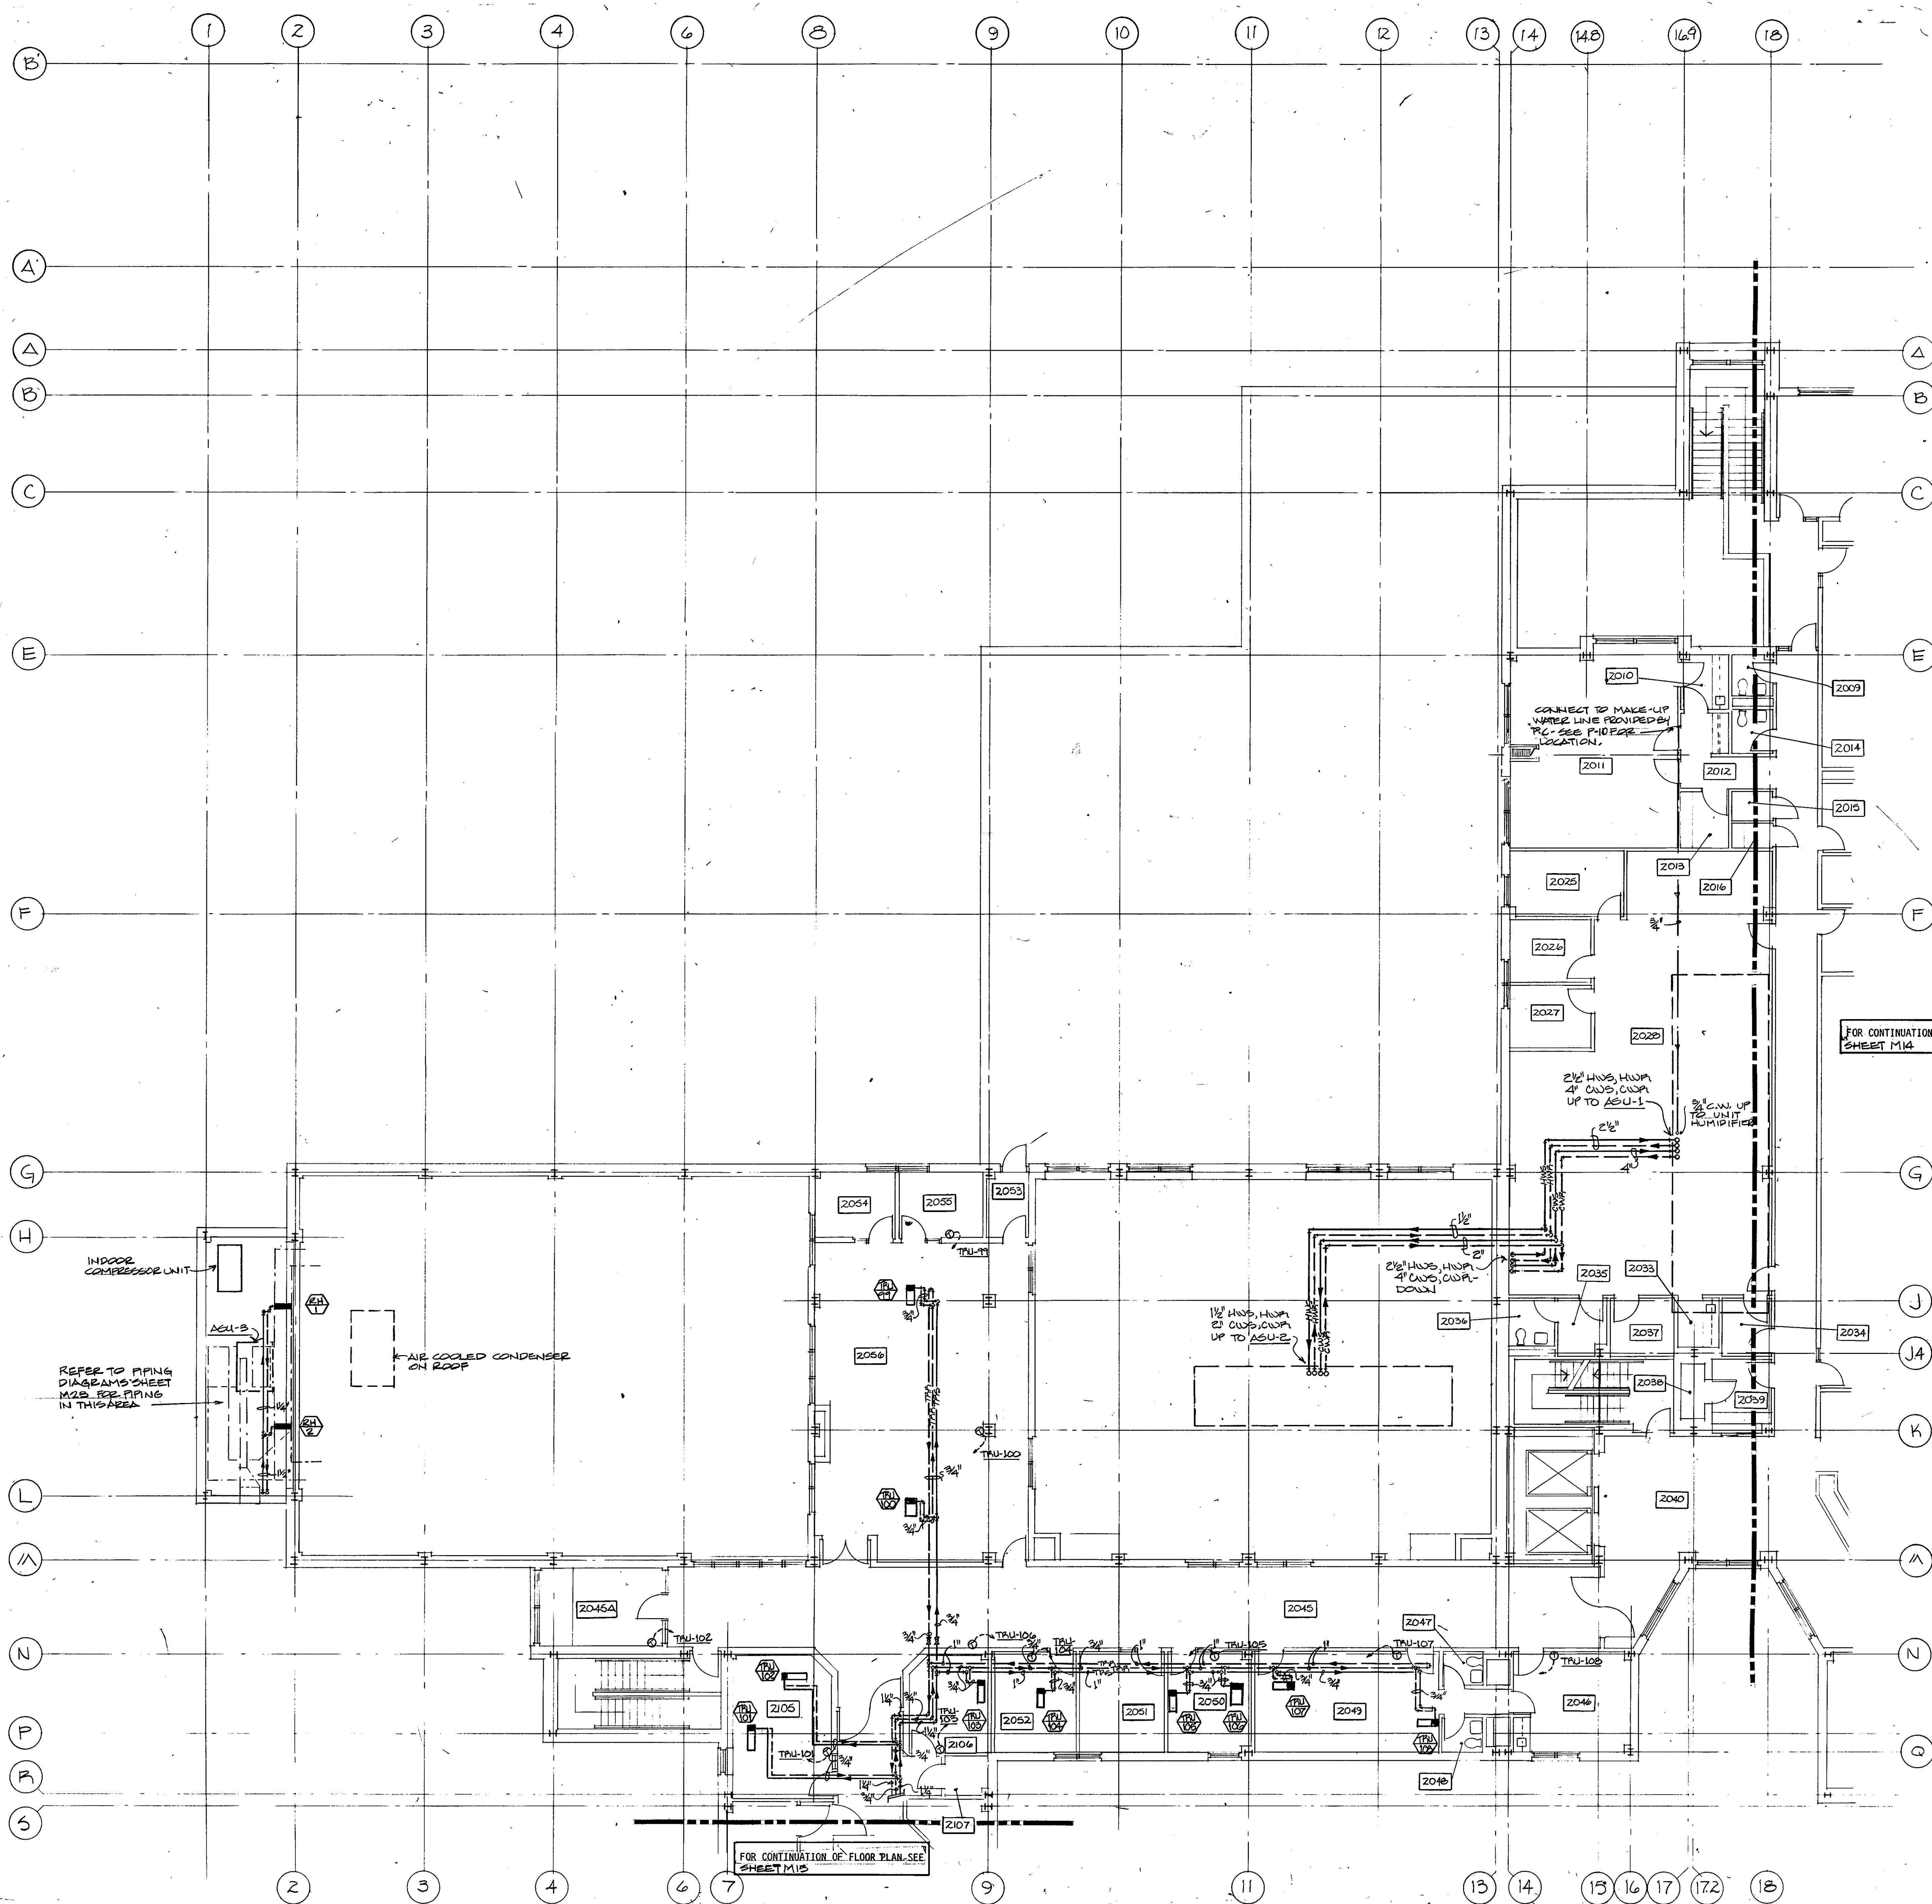


**ROOM SCHEDULE**

2009	MALE TOILET
2010	PARTY
2011	CONFERENCE
2012	PASSAGE
2013	STORAGE
2014	FEMALE TOILET
2015	ELECTRICAL CLOSET
2016	JANITORS CLOSET
<b>PHARMACY</b>	
2022	DIRECTOR
2023	PHARMACEUTICALS
2027	PHARMACEUTICALS
2028	OPEN WORK AREA
2033	COMPOUNDING ROOM
2034	DRUG TRANSFER
2035	LOCKER ROOM
2036	TOILET
2037	CONTROLLED DRUG STORAGE
<b>ACCOUNTING</b>	
2038	VAULT
2039	CASHIER
2040	ELEVATOR LOBBY
<b>CIRCULATION</b>	
2041	CORRIDOR
2042	CONFERENCE ROOM
2043	STAFF BUNDS
2044	STAFF FEMALE TOILET
2045	STAFF MALE TOILET
2046	STAFF LOCKERS
2047	PSYCHOLOGIST OFFICE
2048	PSYCHIATRIST OFFICE
2049	SOCIAL WORKERS OFFICE
2050	STORAGE
<b>PATIENT ACTIVITY</b>	
2054	ACTIVITY THERAPY OFFICE
2055	ACTIVITY THERAPY OFFICE
2056	RECREATION ROOM
<b>NURSING ACUTE</b>	
2103	CONFERENCE ROOM
2104	CONSULTING ROOM
2107	ELECTRICAL CLOSET

FOR CONTINUATION OF FLOOR PLAN SEE SHEET M14

- GENERAL NOTES:**
1. REFER TO SHEET M12 FOR DUCTWORK.
  2. ALL ELBOWS, FITTINGS, ETC., IN PIPING ARE NOT NECESSARILY INDICATED TO CLEAR ALL JOB OBSTRUCTIONS.
  3. DUE TO LIMITED SPACE AVAILABLE TO INSTALL ALL OF THE MECHANICAL WORK, CLOSE COORDINATION BETWEEN THE VARIOUS TRADES IS OF THE UTMOST IMPORTANCE.

*AS-Built  
6-8-87  
R. L. ...*

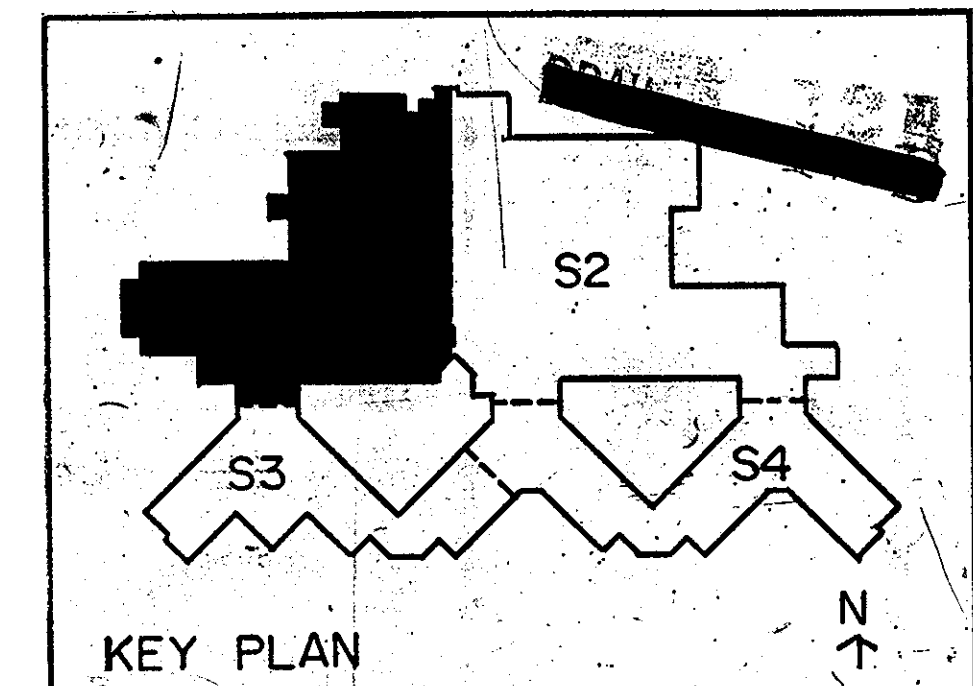

**TRUE NORTH**

**PLAN NORTH**

**DRAWING TITLE:**  
PARTIAL SECOND FLOOR  
PIPING - AREA S1

**SCALE:** 1/8" = 1'-0"

REVISIONS:


FOR CONTINUATION OF FLOOR PLAN SEE SHEET M15

FOR REFERENCE ONLY

SHEET NUMBER:  
**M13**

PROJECT NUMBER:  
83013  
ISSUE DATE:  
6-27-85

THE CHRISNER PARTNERSHIP INC. ARCHITECTS AND PLANNERS · 20 SOUTH HANLEY RD · CLAYTON, MISSOURI · 63106 · 314-726-2927 · 11 W VICTORY WAY · CRAIG, COLORADO · 81625 · 303-824-9107

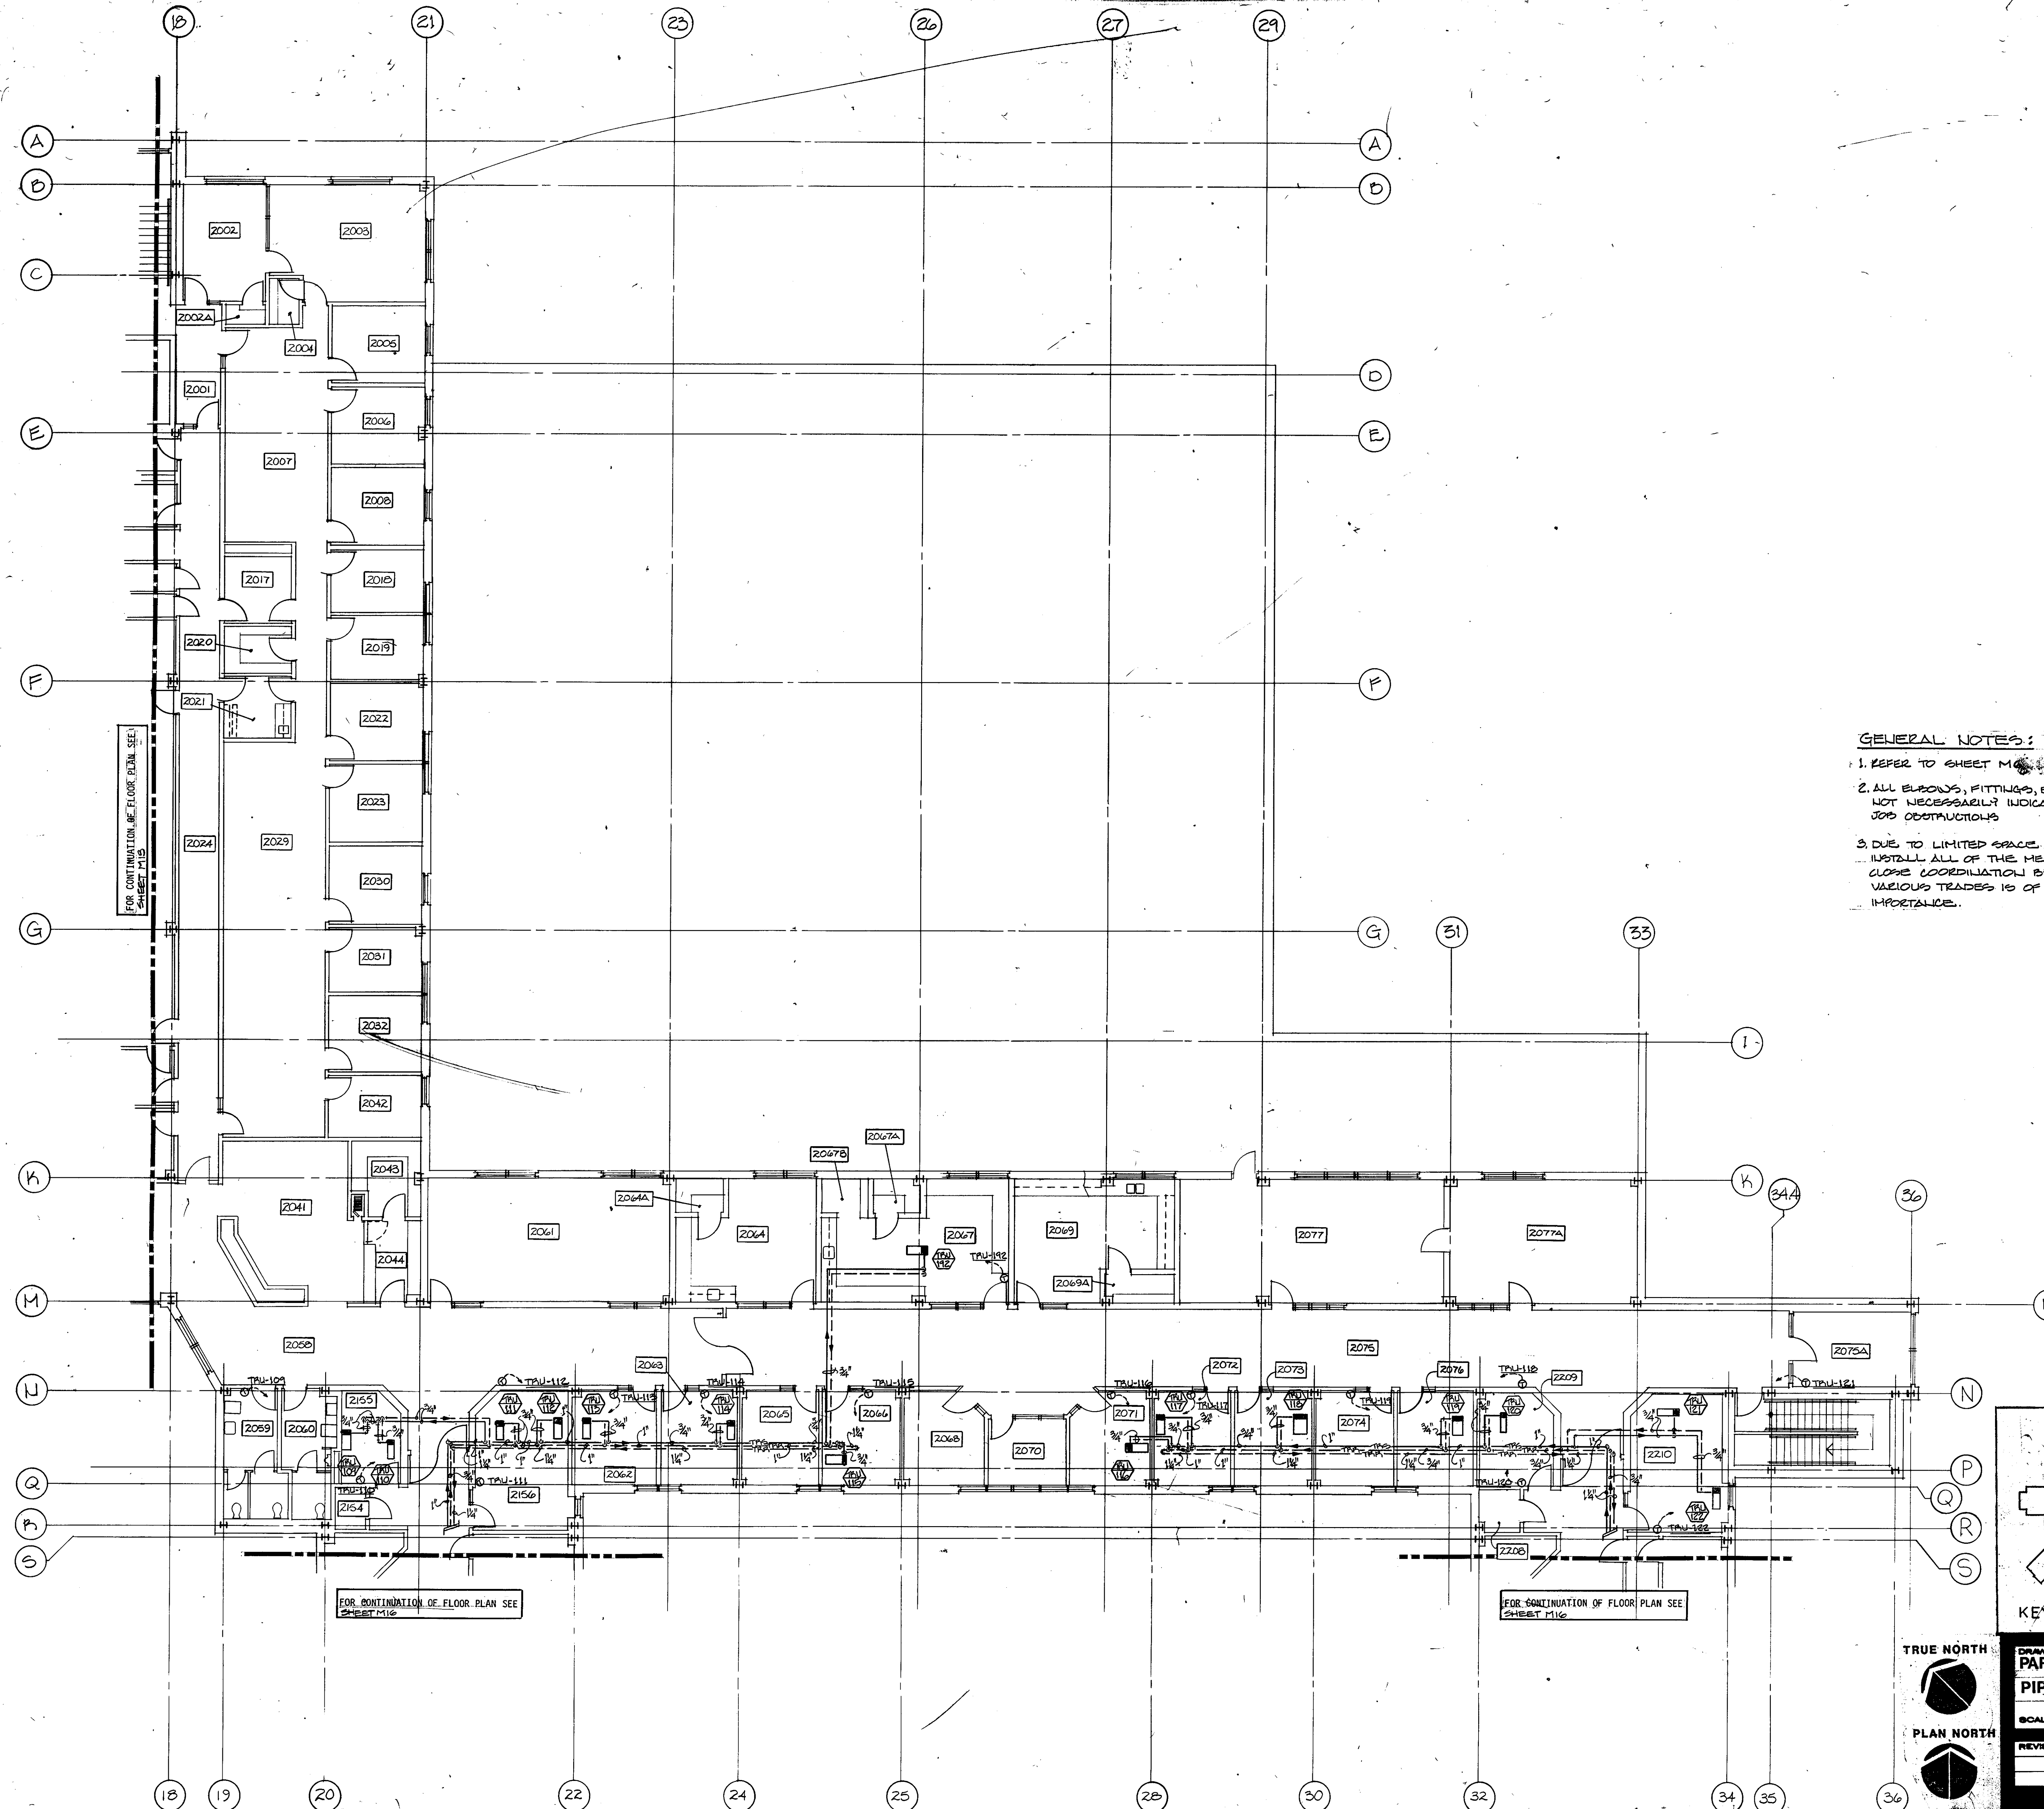


ROOM SCHEDULE	
2001	CORRIDOR
2002	EXECUTIVE SECRETARY
2002A	CLOSET
2004	STORAGE CLOSET
2005	SUPERINTENDENT TREATMENT
2006	CHIEF OF STAFF
2007	OPEN WORK AREA
2008	ASSISTANT SUPERINTENDENT ADMINISTRATOR
2009	COPY
2010	HOSPITAL MANAGEMENT ASSISTANT
2011	OFFICE
2012	SUPPLIES
2013	PHOTOCOPIERS
2014	SOCIAL WORK DIRECTOR
2015	PSYCHOLOGIST DIRECTOR
2016	CORRIDOR
2017	ACTIVITY DIRECTOR
2018	CLINICAL NURSING COORDINATOR
2019	NURSING DIRECTOR
2020	PATIENT SUPPORT
2021	VENDING
2022	ASSISTANT NURSING DIRECTOR
2023	VENDING STORAGE
2024	SEWING
2025	CORRIDOR
2026	PATIENT FEMALE TOILET
2027	PATIENT MALE TOILET
2028	PATIENT ACTIVITY/NURSING, ACUTE SHARED SUPPORT
2029	LIBRARY
2030	SOCIAL WORKERS OFFICE
2031	PSYCHIATRY OFFICE
2032	ARTS AND CRAFTS
2033	STORAGE
2034	PSYCHOLOGIST OFFICE
2035	ACTIVITY THERAPY SUPERVISORS OFFICE
2036	CERAMICS SHOP
2037	STORAGE
2038	STORAGE
2039	UNIT DIRECTORS OFFICE
2040	COMMUNITY LIVING SKILLS
2041	STORAGE
2042	SECRETARY
2043	NURSING SUPERVISORS OFFICE
2044	SOCIAL WORKERS SUPERVISORS OFFICE
2045	PSYCHOLOGIST OFFICE
2046	PSYCHIATRY OFFICE
2047	CORRIDOR
2048	CONFERENCE ROOM
2049	WORKERS OFFICE
2050	WOOD SHOP
2051	SAW ROOM
2156	ELECTRICAL CLOSET
2157	COUNSELING ROOM
2158	CONFERENCE ROOM
2209	ELECTRICAL CLOSET
2209	COUNSELING ROOM
2210	CONFERENCE ROOM

**GENERAL NOTES:**

- REFER TO SHEET M15 FOR DUCTWORK.
- ALL ELBOWS, FITTINGS, ETC., IN PIPING ARE NOT NECESSARILY INDICATED TO CLEAR ALL JOB OBSTRUCTIONS.
- DUE TO LIMITED SPACE AVAILABLE TO INSTALL ALL OF THE MECHANICAL WORK, CLOSE COORDINATION BETWEEN THE VARIOUS TRADES IS OF THE UTMOST IMPORTANCE.


A-50 Builders  
6-8-87  
Zelma  
Zelma

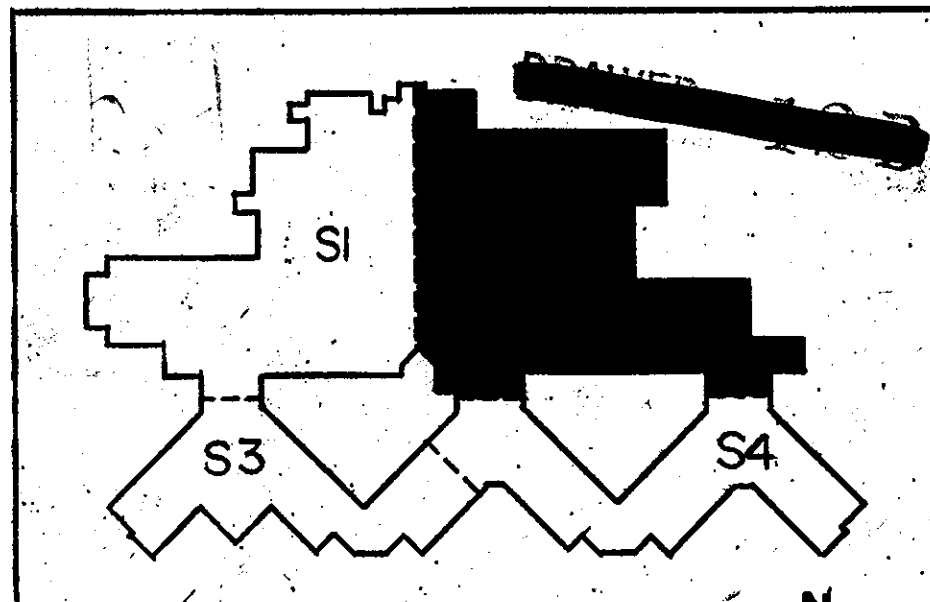

DRAWING TITLE:  
PARTIAL SECOND FLOOR  
PIPING - AREA S2  
SCALE: 1/8" = 1'-0"  
REVISIONS:


FOR REFERENCE ONLY

SHEET NUMBER:  
**M14**  
PROJECT NUMBER:  
83013  
ISSUE DATE:  
6-27-85

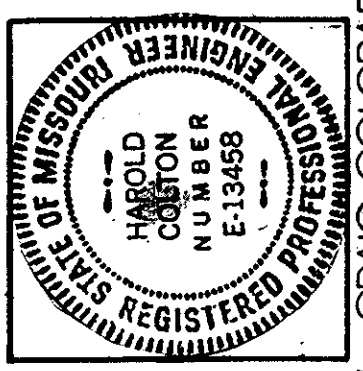

THE CHRISTNER PARTNERSHIP INC. ARCHITECTS AND PLANNERS. 20 SOUTH HANLEY RD. CLAYTON, MISSOURI - 63105 314-725-2927 - 11 VICTORY WAY - CRAIG, COLORADO - 81625 303-824-9707


ROOM SCHEDULE	
<b>NURSING ACUTE</b>	
2078	LAUNDRY ROOM
2079	PATIENT TOILET/SHOWER (HANDICAPPED)
2080	PATIENT BEDROOM (1 BED-HANDICAPPED)
2081	PATIENT BEDROOM (2 BEDROOM)
2082	PATIENT BEDROOM (2 BEDROOM)
2083	PATIENT BEDROOM (2 BED)
2084	PATIENT TOILET/SHOWER
2085	PATIENT BEDROOM (2 BED)
2086	PATIENT TOILET
2087	PATIENT BEDROOM (2 BED)
2088	CORRIDOR
2089	SHOWER ROOM
2090	PATIENT BEDROOM (2 BED)
2091	PATIENT BEDROOM (2 BED)
2092	PATIENT TOILET
2093	PATIENT BEDROOM (2 BED)
2094	PATIENT TOILET
2095	SOILED UTILITY ROOM
2096	TRASH ROOM
2097	CLEAN UTILITY ROOM
2098	PASSAGE
2100	JANITORS CLOSET
2101	MEDICATION PREPARATION
2102	NURSES STATION
2103	TOILET
2104	TOILET/CHANGE ROOM
2105	TOILET
2106	CORRIDOR
2107	TOILET/CHANGE ROOM
2108	LINEA
2109	LINEA
2110	TUB ROOM
2111	ACTIVITY ROOM
2112	PATIENT TOILET
2113	PATIENT BEDROOM (2 BED)
2114	SHOWER ROOM
2115	CORRIDOR
2116	PATIENT TOILET
2117	PATIENT BEDROOM (2 BED)
2118	SHOWER ROOM
2119	SHOWER ROOM
2120	PATIENT BEDROOM (2 BED)
2121	PATIENT TOILET
2122	PATIENT BEDROOM (2 BED)
2123	PATIENT TOILET
2124	PATIENT TOILET
2125	PATIENT TOILET
2126	PATIENT BEDROOM (2 BED)
2127	PATIENT BEDROOM (2 BED)
2128	SHOWER ROOM
2129	PATIENT TOILET
2130	PATIENT BEDROOM (2 BED)
2131	SHOWER ROOM
2132	SHOWER ROOM
2133	PATIENT BEDROOM (2 BED)
2134	PATIENT BEDROOM (2 BED)
2135	PATIENT TOILET
2136	PATIENT BEDROOM (2 BED)
2137	SHOWER ROOM
2138	PATIENT BEDROOM (2 BED)
2139	PATIENT TOILET
2140	SHOWER ROOM
2141	PATIENT BEDROOM (2 BED)
2142	PATIENT TOILET
2143	PATIENT TOILET
2144	SHOWER ROOM
2145	PATIENT BEDROOM (2 BED)
2146	SHOWER ROOM
2147	PATIENT TOILET
2148	PATIENT TOILET

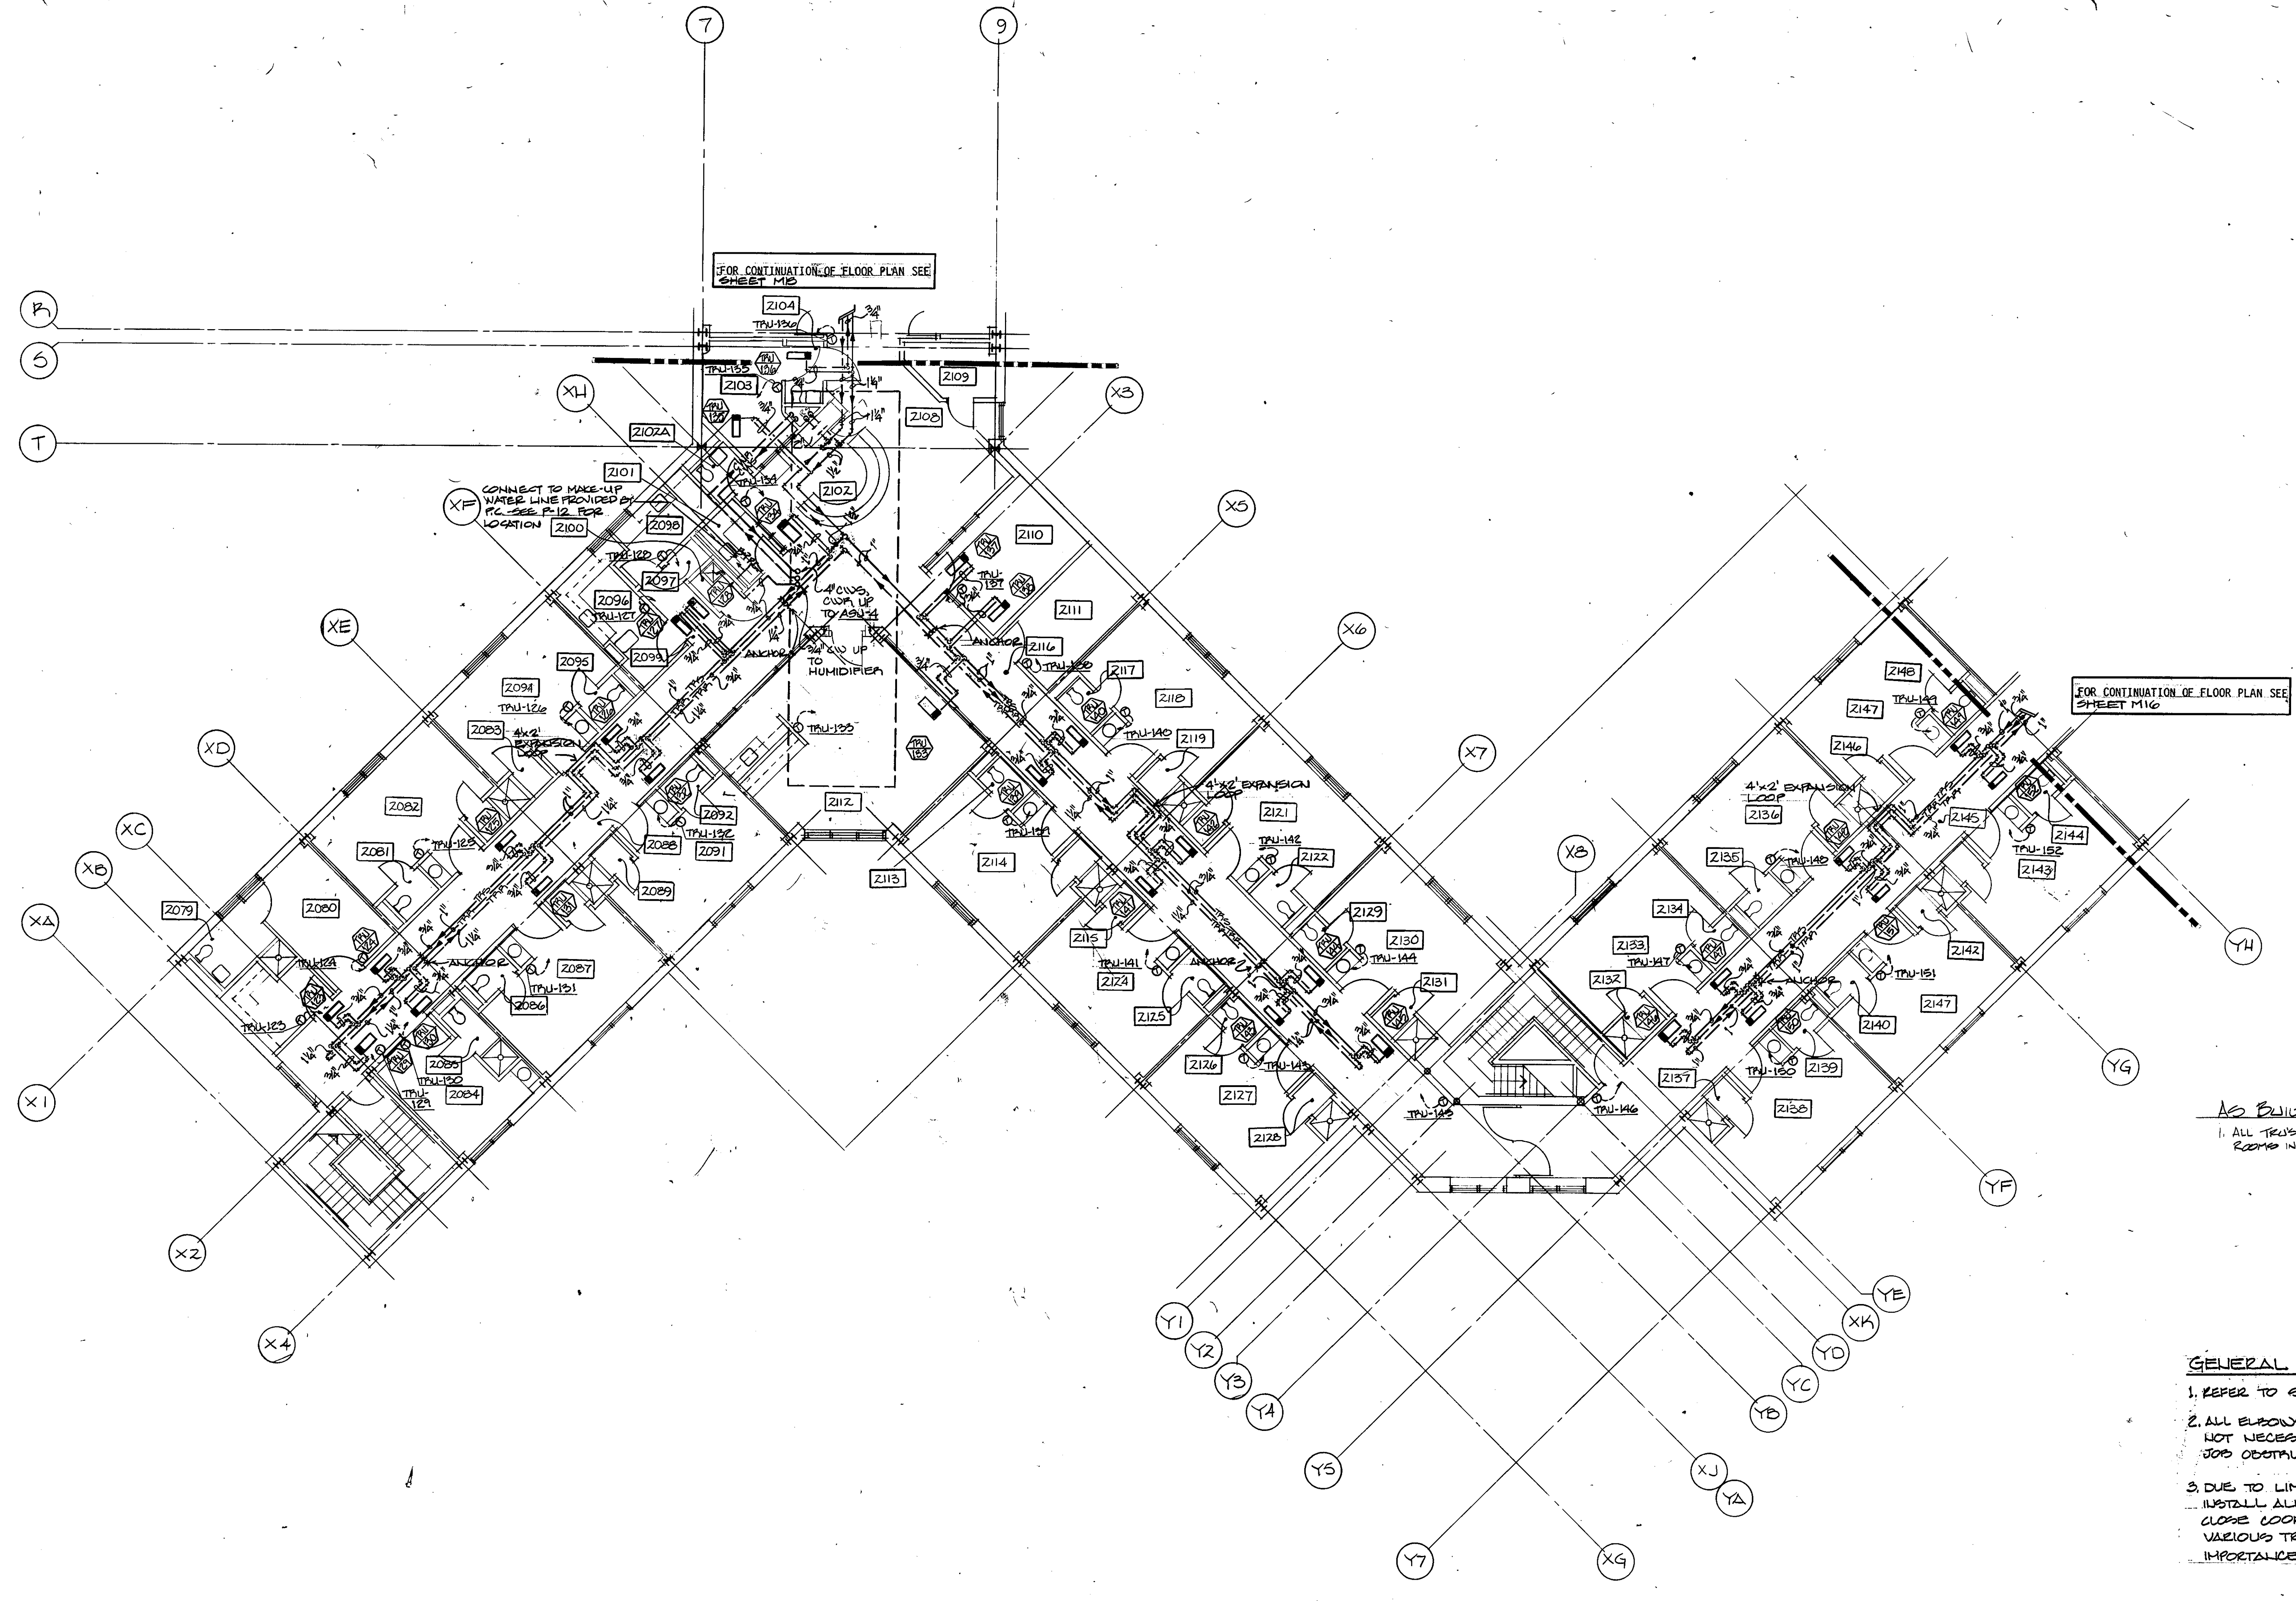

**AS BUILT NOTES**  
 1. ALL TRUS SHOWN ARE LOCATED OVER PATIENT ROOMS IN HULL OF CORRIDOR.

**GENERAL NOTES:**  
 1. REFER TO SHEET M11 FOR DUCTWORK.  
 2. ALL ELBOWS, FITTINGS, ETC., IN PIPING ARE NOT NECESSARILY INDICATED TO CLEAR ALL 300 OBSTRUCTIONS.  
 3. DUE TO LIMITED SPACE AVAILABLE TO INSTALL ALL OF THE MECHANICAL WORK, CLOSE COORDINATION BETWEEN THE VARIOUS TRADES IS OF THE UTMOST IMPORTANCE.

*Aso Built  
 6-8-87  
 [Signature]*

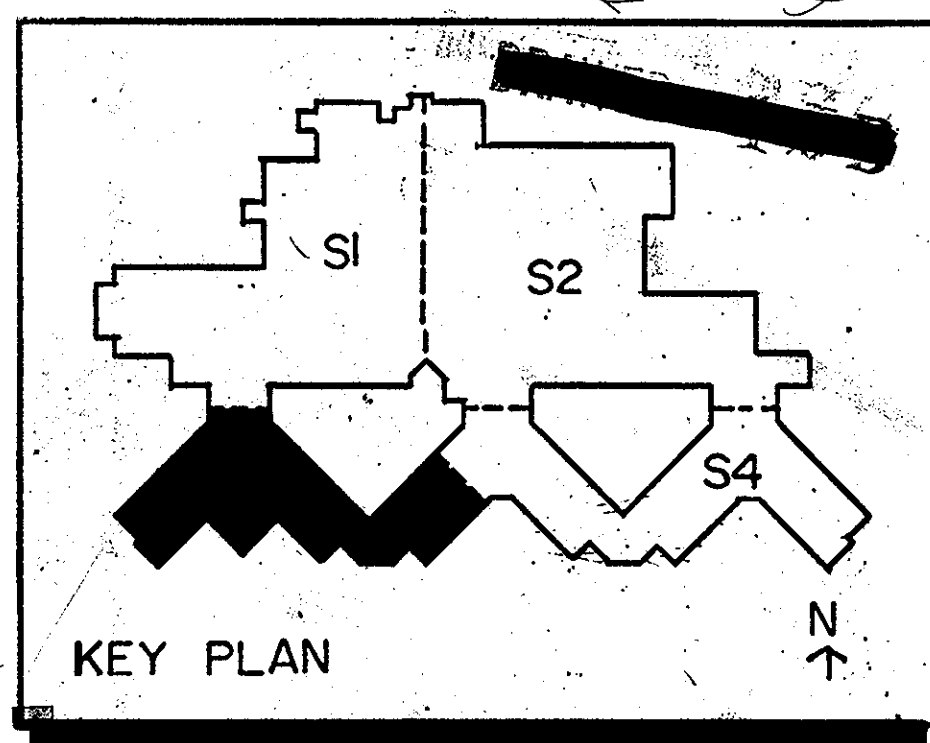


TRUE NORTH  
 PLAN NORTH

**DRAWING TITLE:**  
 PARTIAL SECOND FLOOR  
 PIPING - AREA S3  
**SCALE:** 1/8" = 1'-0"  
**REVISIONS:**

**FOR REFERENCE ONLY**


**SHEET NUMBER:**  
**M15**  
**PROJECT NUMBER:**  
 83013  
**ISSUE DATE:**  
 6-27-85

THE CHRISNER PARTNERSHIP INC ARCHITECTS AND PLANNERS · 20 SOUTH HANLEY RD · CLAYTON MASSACHUSETTS 01963 · 314-725-2927 · 11 W VICTORY WAY · CRAIG COLORADO 81625 · 303-824-9707  
 HAROLD COLTIER E 13485  
 REGISTERED PROFESSIONAL ENGINEER  
 STATE OF MISSOURI

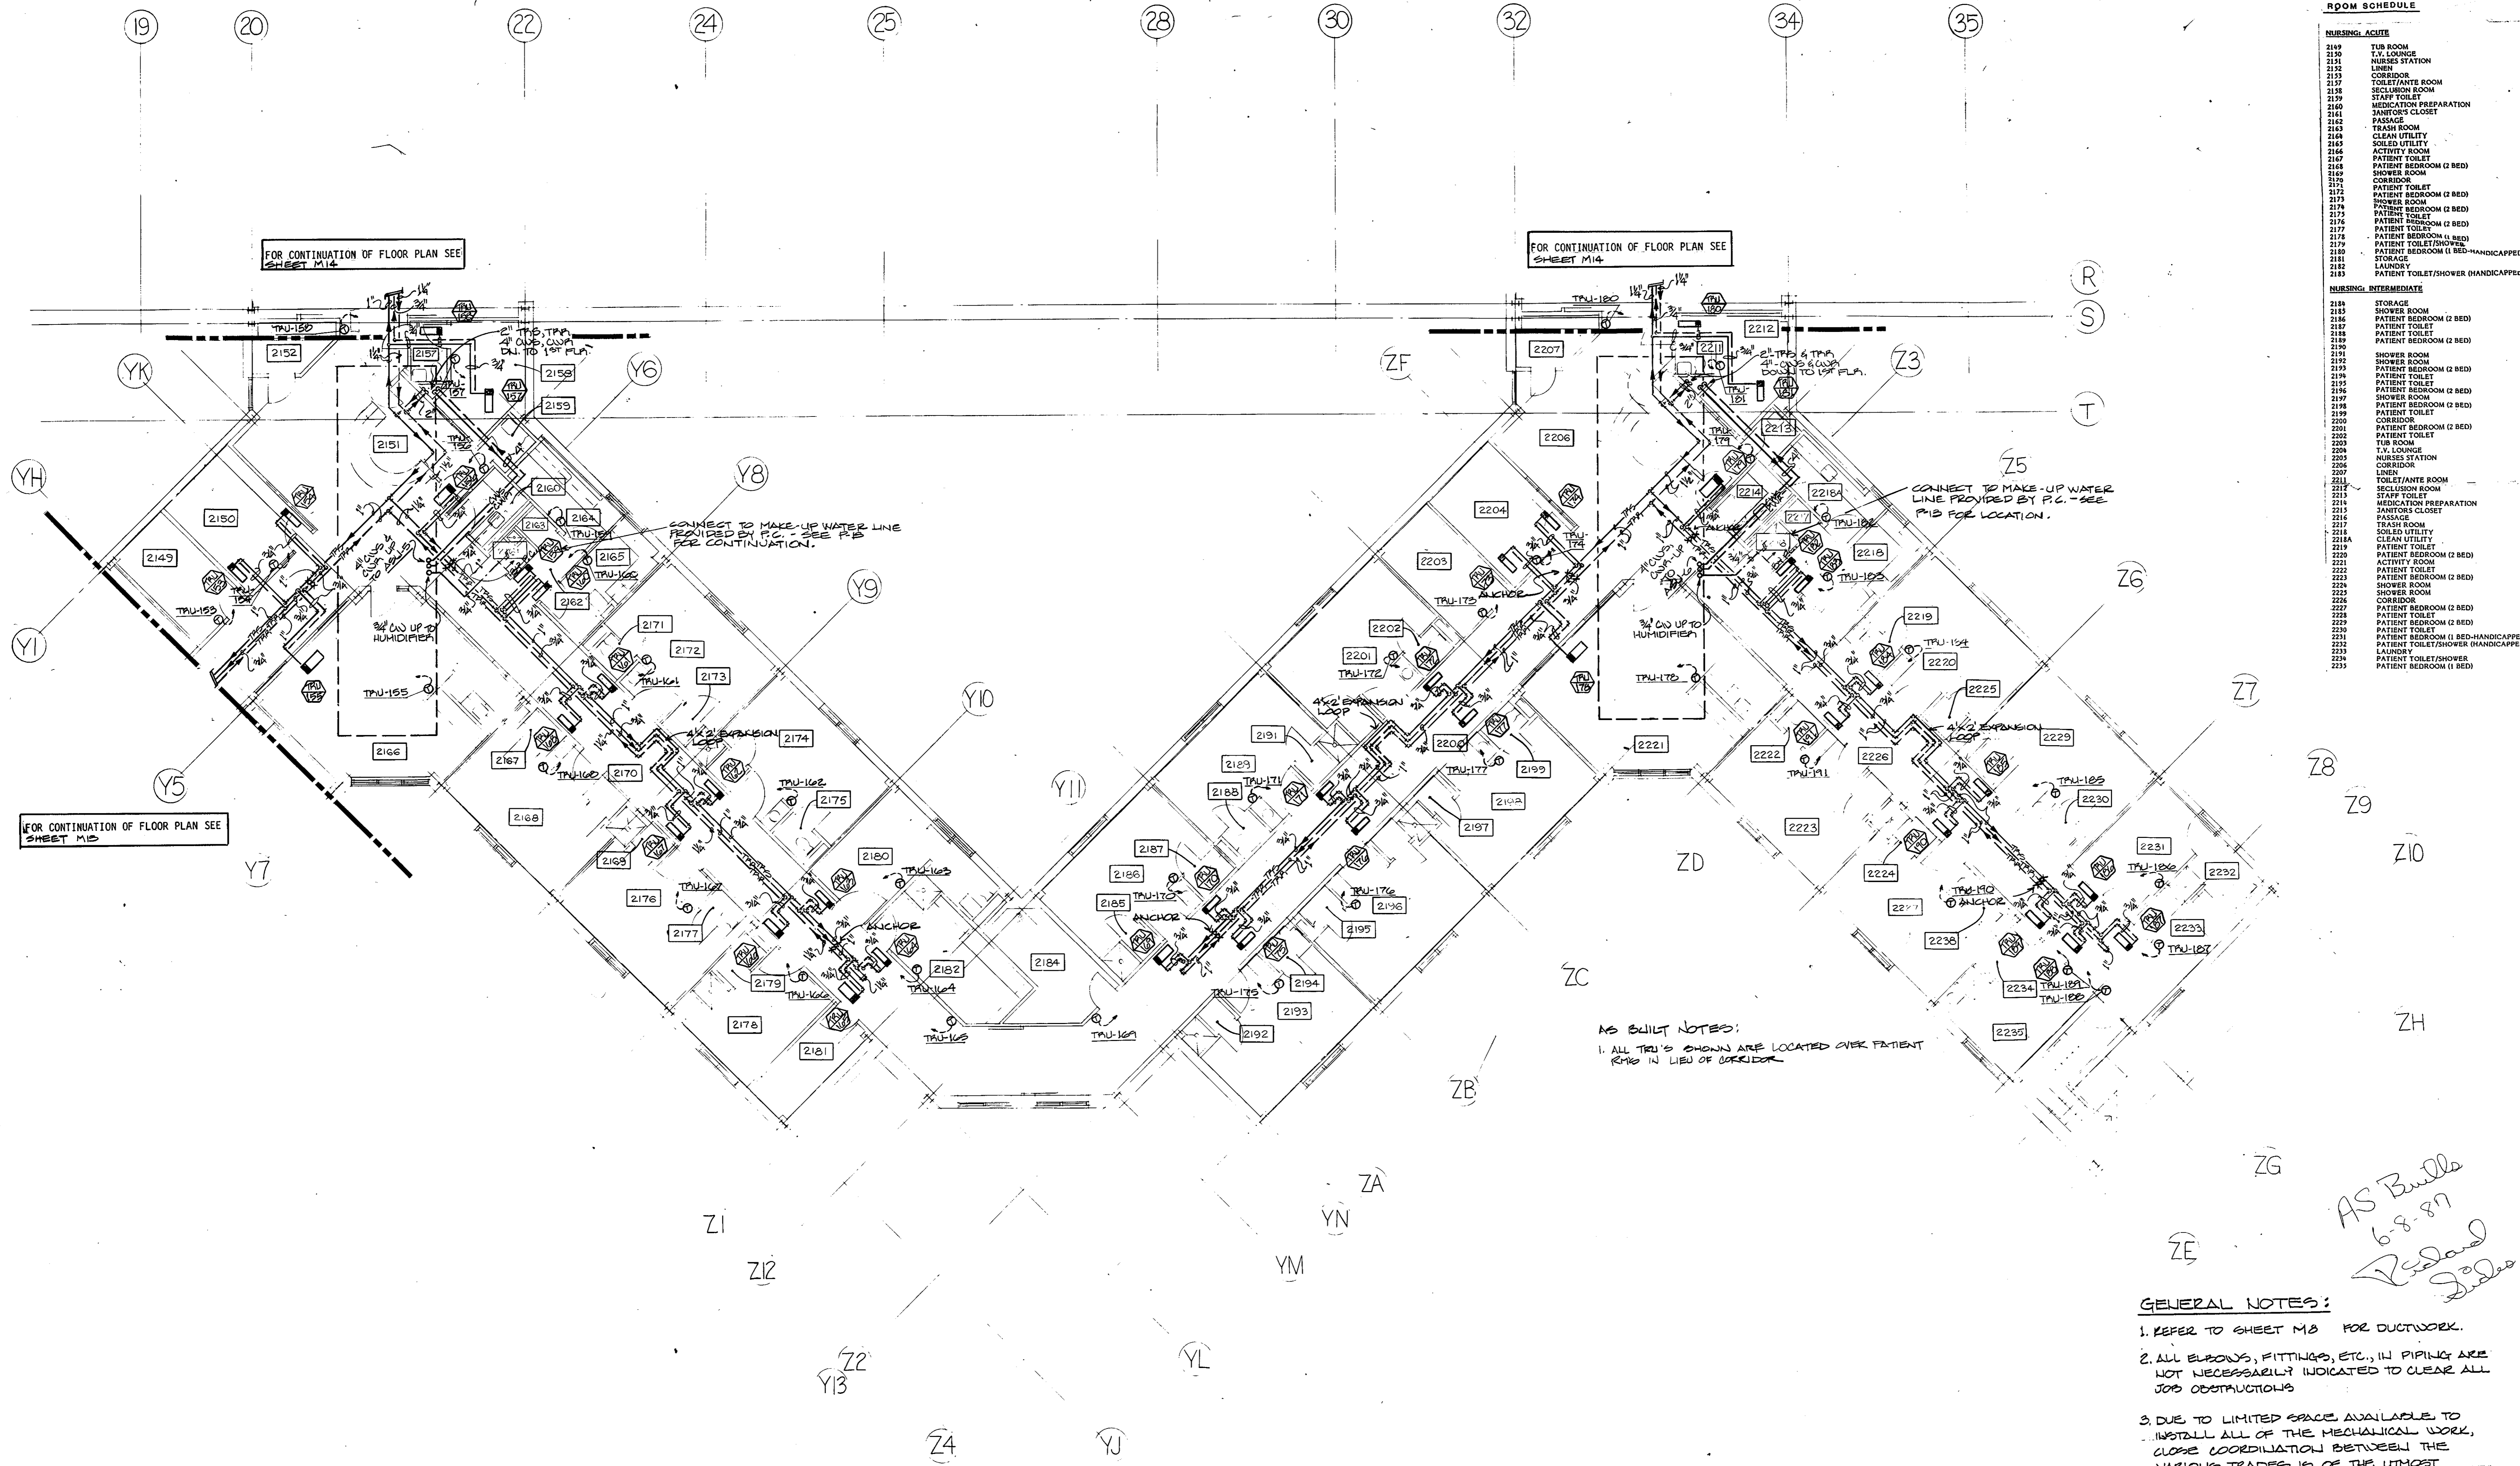

ROOM SCHEDULE	
<b>NURSING ACUTE</b>	
2119	TUB ROOM
2120	T.V. LOUNGE
2121	NURSE STATION
2122	LINEN
2123	CORRIDOR
2124	TOILET/ANTE ROOM
2125	SECLUSION ROOM
2126	STAFF TOILET
2127	MEDICATION PREPARATION
2128	JANITOR'S CLOSET
2129	PASSAGE
2130	TRASH ROOM
2131	CLEAN UTILITY
2132	SOLEID UTILITY
2133	PATIENT TOILET
2134	PATIENT BEDROOM (2 BED)
2135	SHOWER ROOM
2136	PATIENT TOILET
2137	PATIENT BEDROOM (2 BED)
2138	CORRIDOR
2139	PATIENT TOILET
2140	PATIENT BEDROOM (2 BED)
2141	PATIENT TOILET
2142	PATIENT BEDROOM (2 BED)
2143	PATIENT TOILET
2144	PATIENT BEDROOM (2 BED)
2145	PATIENT TOILET
2146	PATIENT BEDROOM (1 BED)
2147	PATIENT TOILET/SHOWER
2148	PATIENT BEDROOM (1 BED-HANDICAPPED)
2149	STORAGE
2150	PATIENT TOILET/SHOWER (HANDICAPPED)
2151	PATIENT TOILET/SHOWER (HANDICAPPED)
<b>NURSING INTERMEDIATE</b>	
2218	STORAGE
2219	SHOWER ROOM
2220	PATIENT BEDROOM (2 BED)
2221	PATIENT TOILET
2222	PATIENT BEDROOM (2 BED)
2223	PATIENT TOILET
2224	PATIENT BEDROOM (2 BED)
2225	SHOWER ROOM
2226	PATIENT BEDROOM (2 BED)
2227	PATIENT TOILET
2228	PATIENT BEDROOM (2 BED)
2229	PATIENT TOILET
2230	PATIENT BEDROOM (2 BED)
2231	PATIENT TOILET
2232	PATIENT BEDROOM (1 BED-HANDICAPPED)
2233	PATIENT TOILET/SHOWER (HANDICAPPED)
2234	LAUNDRY
2235	PATIENT TOILET/SHOWER
2236	PATIENT BEDROOM (1 BED)

- GENERAL NOTES:**
- REFER TO SHEET M8 FOR DUCTWORK.
  - ALL ELBOWS, FITTINGS, ETC., IN PIPING ARE NOT NECESSARILY INDICATED TO CLEAR ALL JOB OBSTRUCTIONS.
  - DUE TO LIMITED SPACE AVAILABLE TO INSTALL ALL OF THE MECHANICAL WORK, CLOSE COORDINATION BETWEEN THE VARIOUS TRADES IS OF THE UTMOST IMPORTANCE.

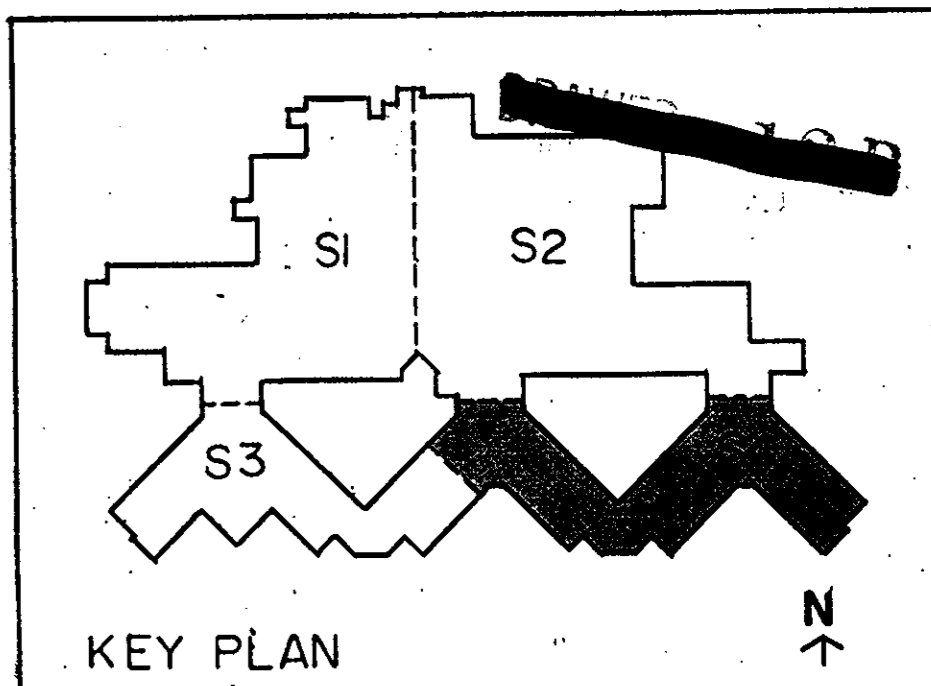

TRUE NORTH  
PLAN NORTH

DRAWING TITLE:  
**PARTIAL SECOND FLOOR  
PIPING - AREA S4**

SCALE: 1/8" = 1'-0"

REVISIONS:


THE CHRISTNER PARTNERSHIP, INC. ARCHITECTS AND PLANNERS  
20 SOUTH HANLEY RD. CLAYTON, MISSOURI 63105 314-725-2927 11 W. VICTORY WAY, CRAIG, COLORADO 81625 303-824-9707


STATE OF MISSOURI  
OFFICE OF ADMINISTRATION  
DIVISION OF DESIGN & CONSTRUCTION  
JOHN ASHCROFT  
GOVERNOR

STATE PROJECT NUMBER: 09-655-4-0001(E)

PROJECT NUMBER:  
83013  
ISSUE DATE:  
6-27-85

FOR REFERENCE ONLY  
FARMINGTON STATE COLLEGE  
CONVERSION AND CONSTRUCTION OF FARMINGTON STATE COMPLEX

AS BUILT  
6-8-87  
R. J. D. J. J.


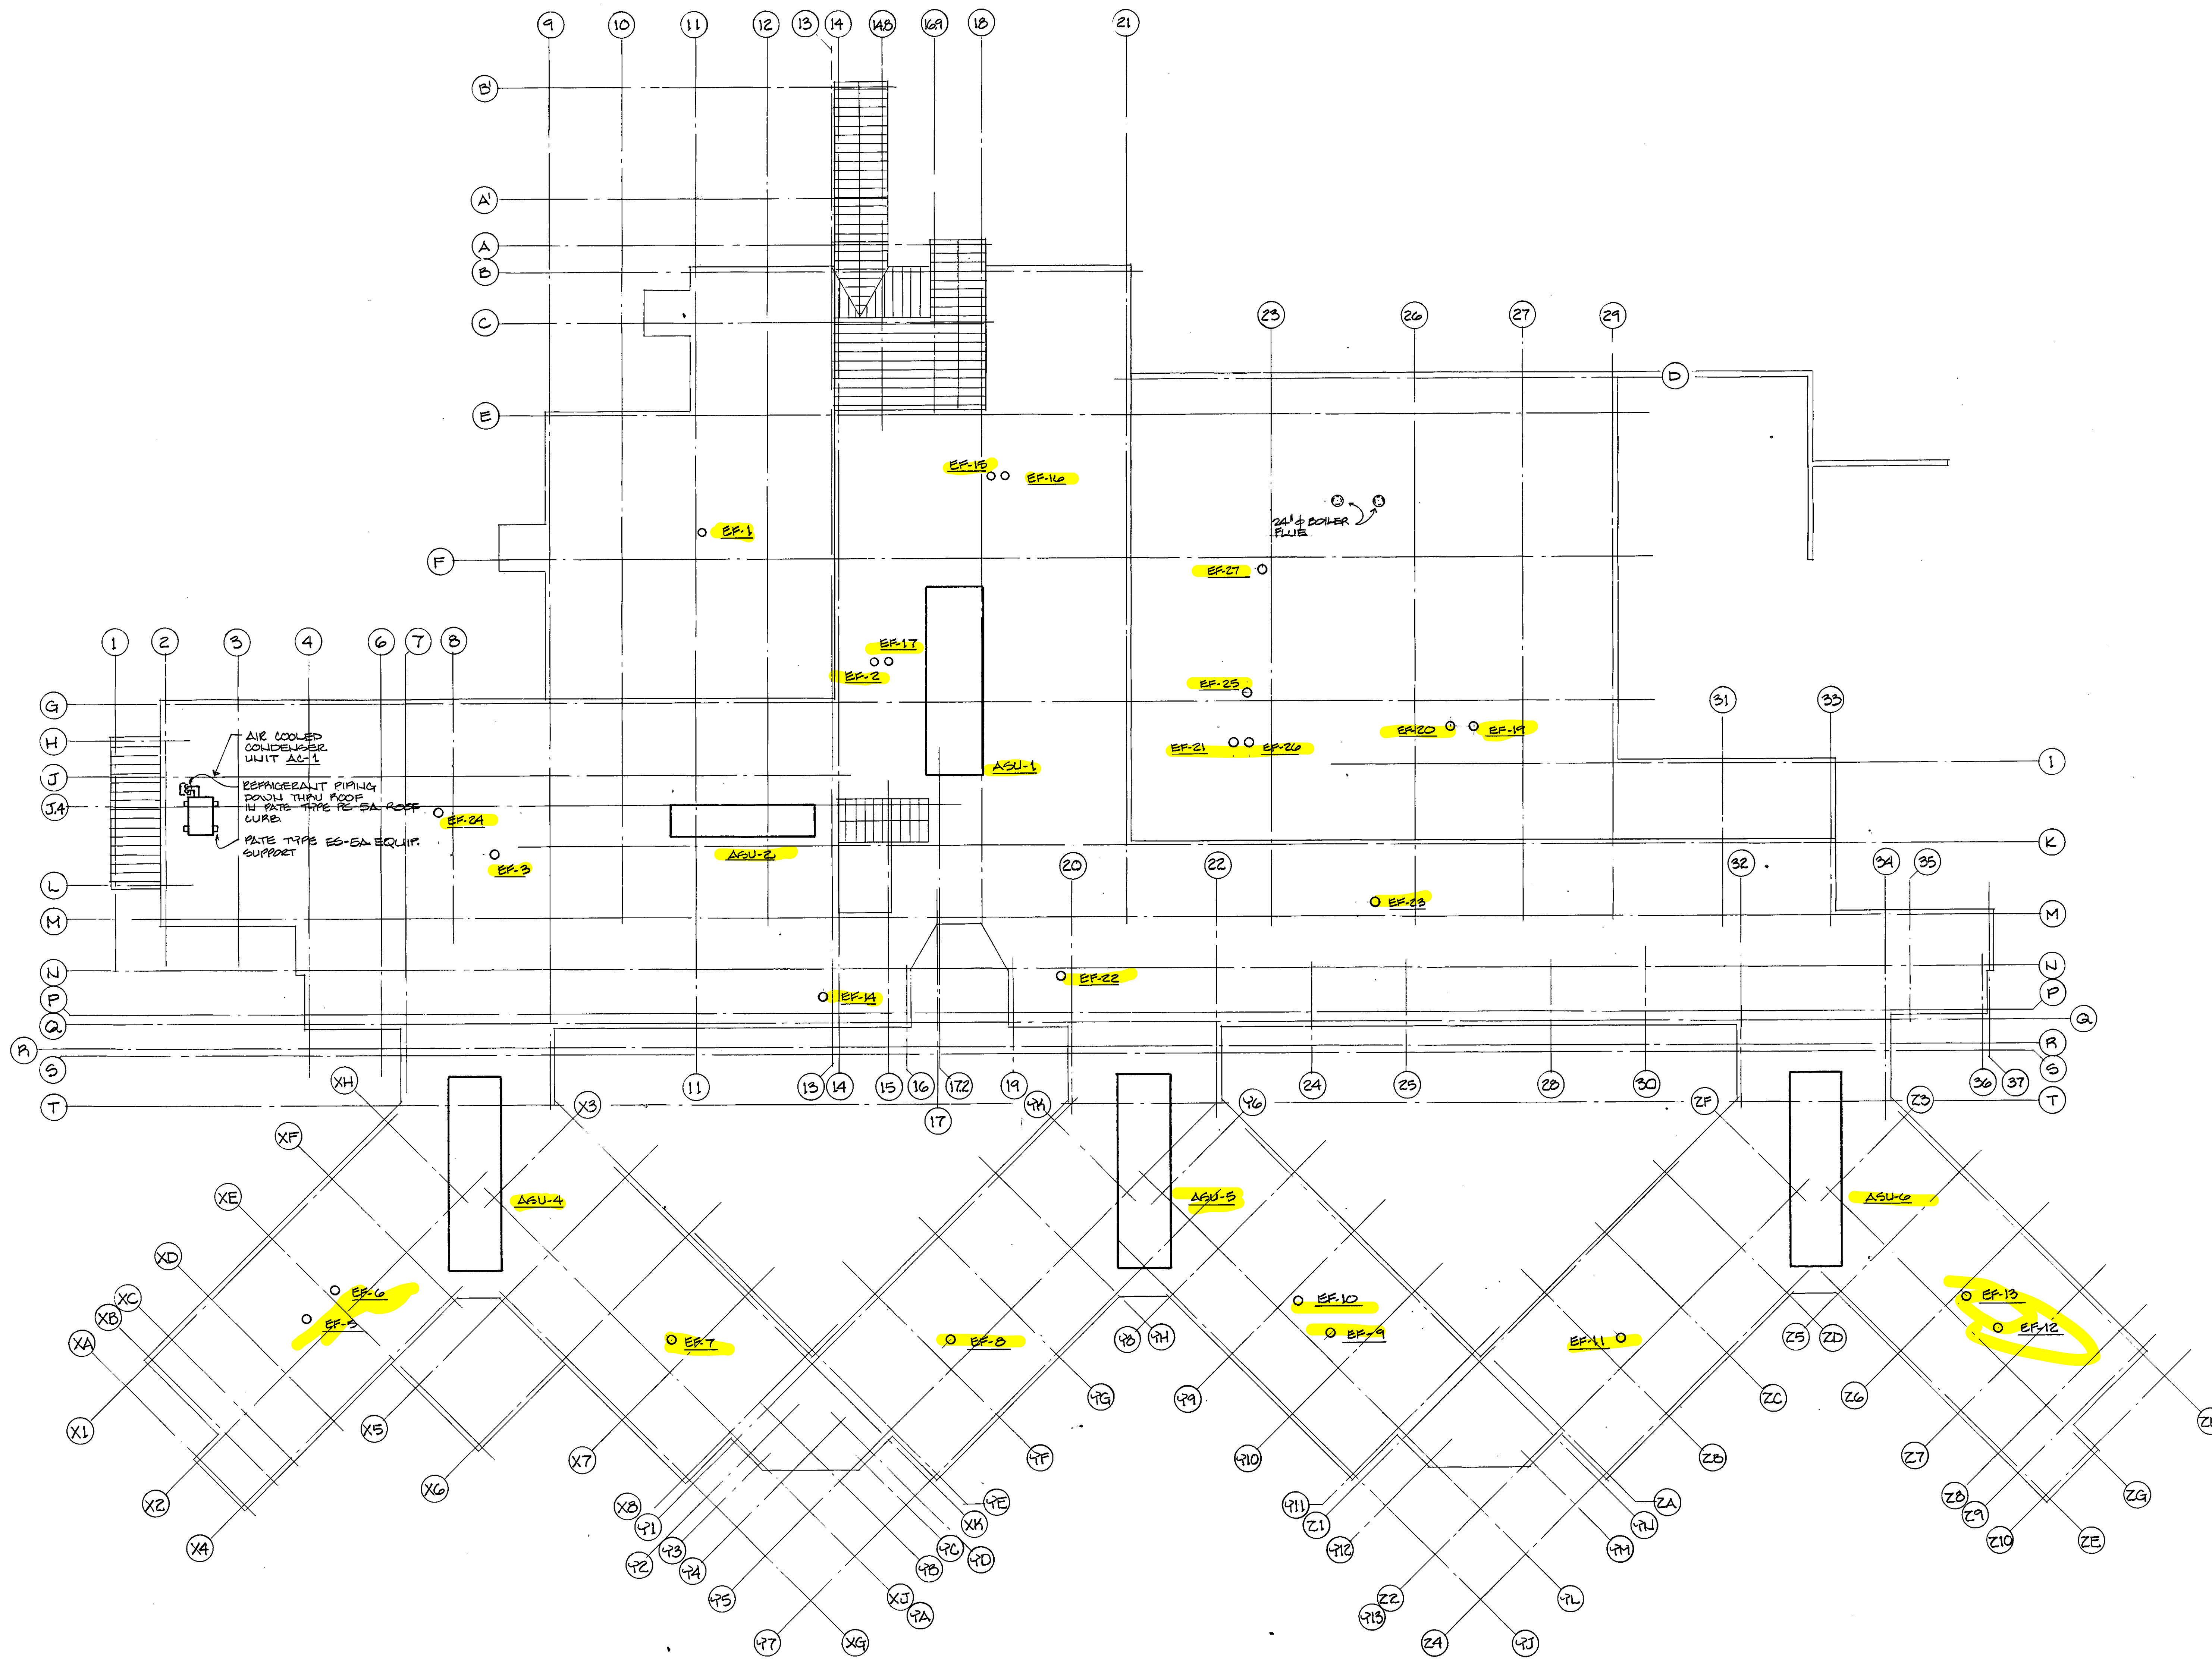


AS Builds  
6-8-87  
Richard  
Dicker


DRAWING TITLE:	
ROOF PLAN	
SCALE: 1/16"=1'-0"	
REVISIONS:	

SHEET NUMBER:	M17
PROJECT NUMBER:	83013
ISSUE DATE:	6-27-85


FOR REFERENCE ONLY

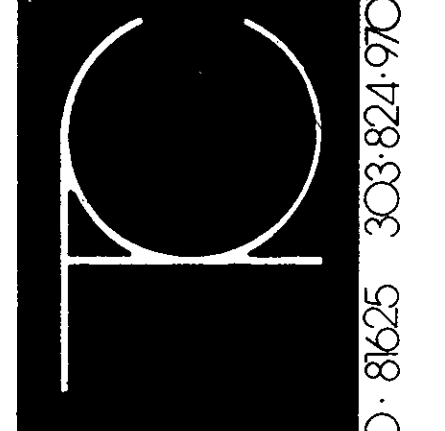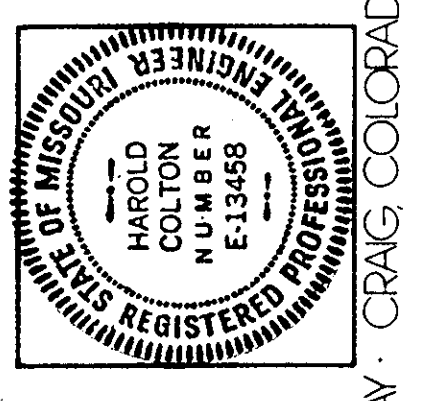




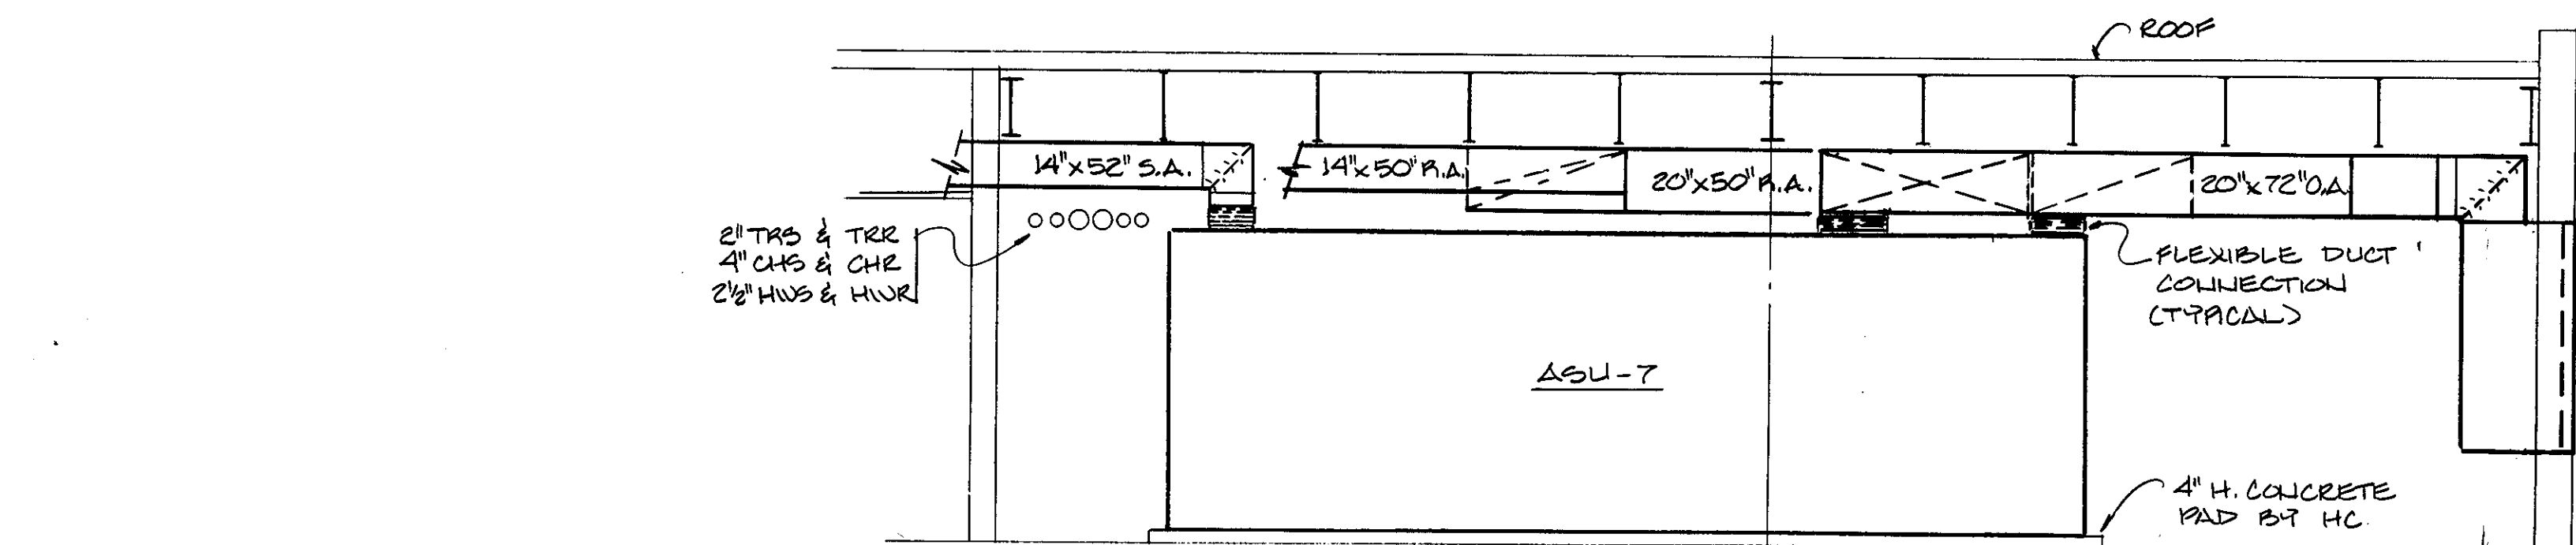


SECTION 2  
SCALE: 1/4" = 1'-0"  
M-18

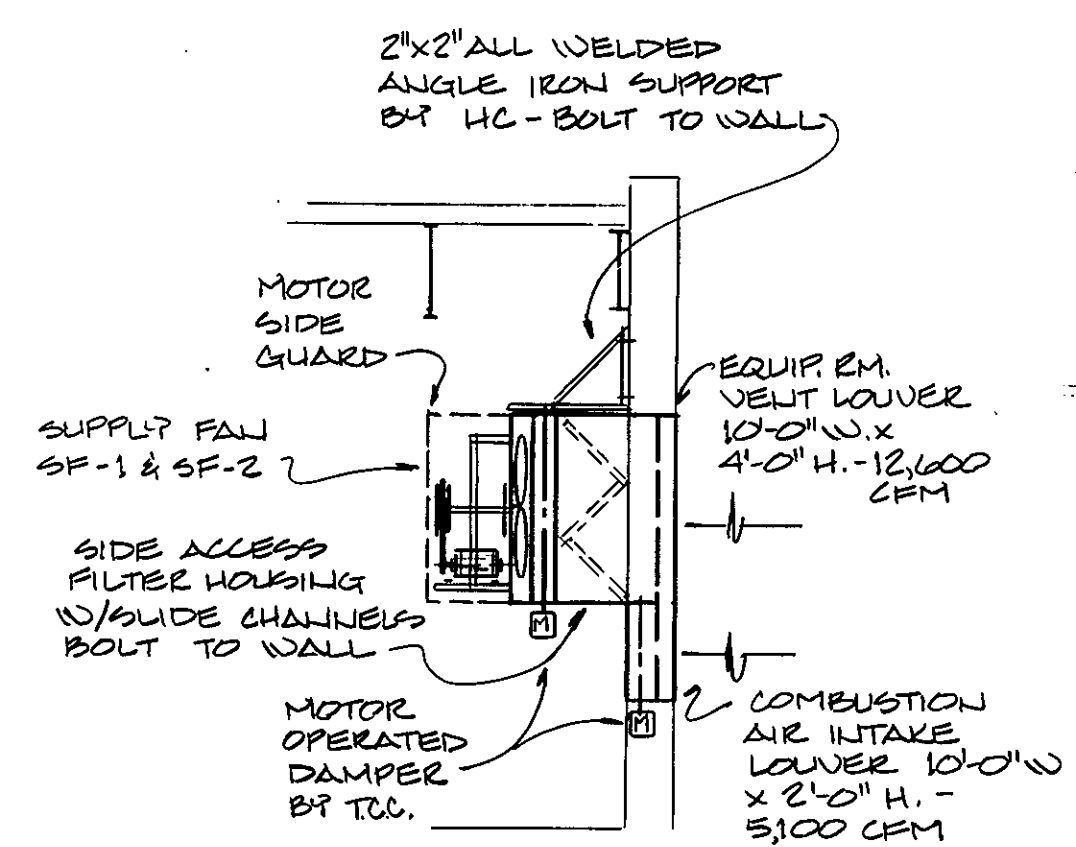

SECTION 3  
SCALE: 1/4" = 1'-0"  
M-18

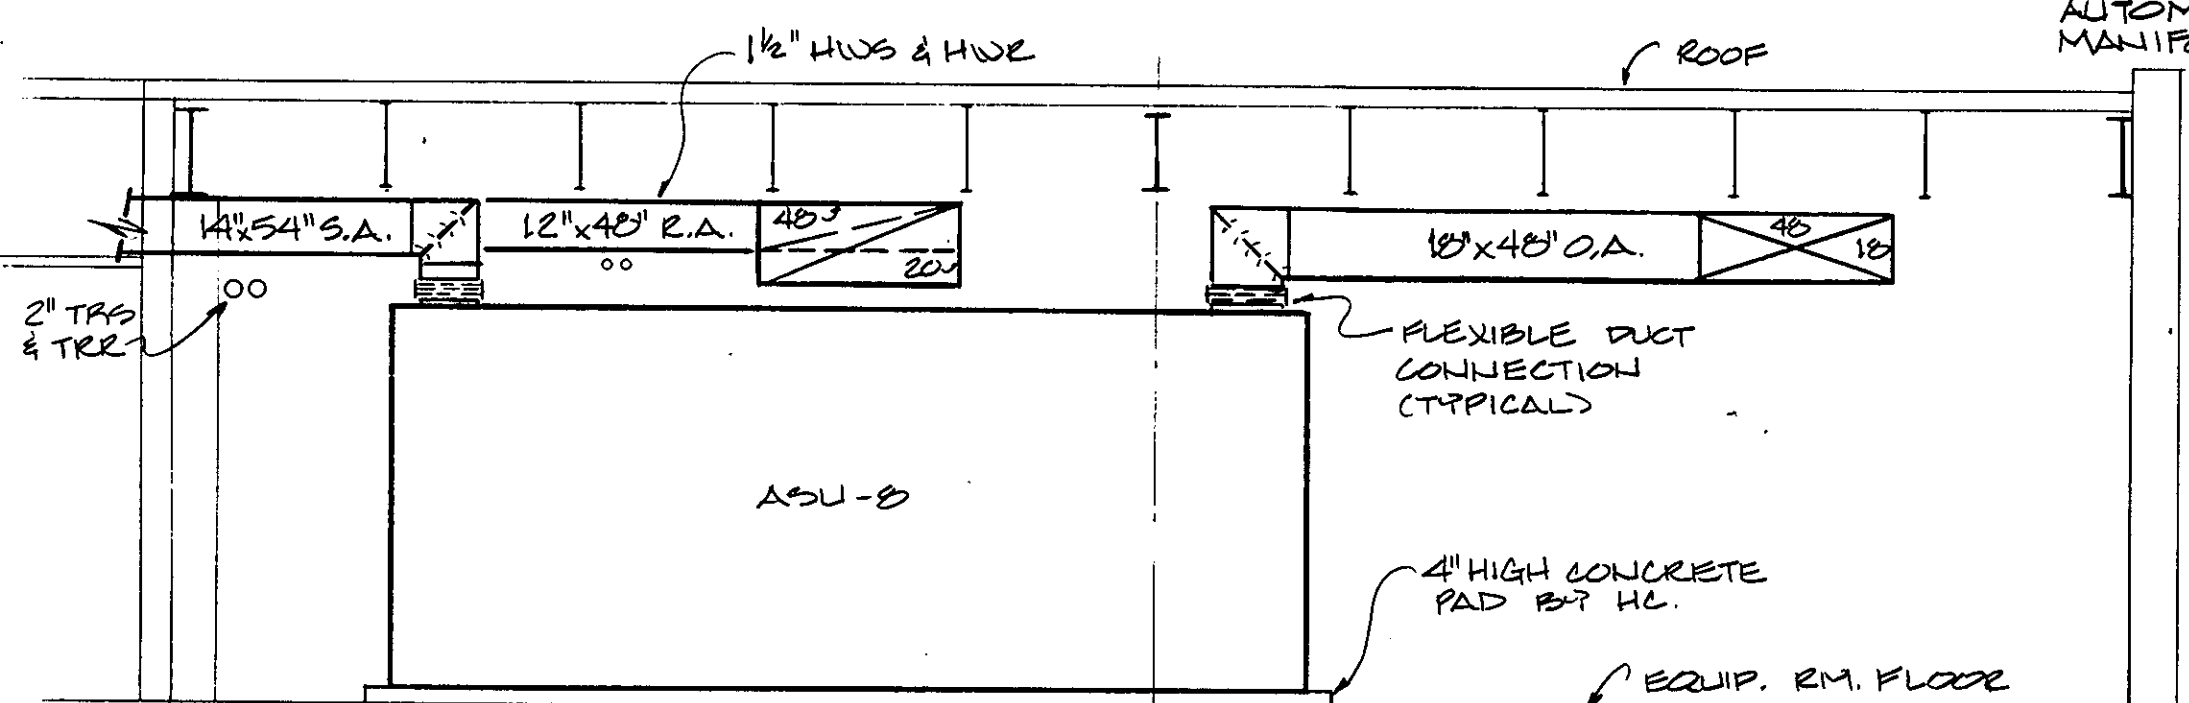

SECTION 1  
SCALE: 1/4" = 1'-0"  
M-18

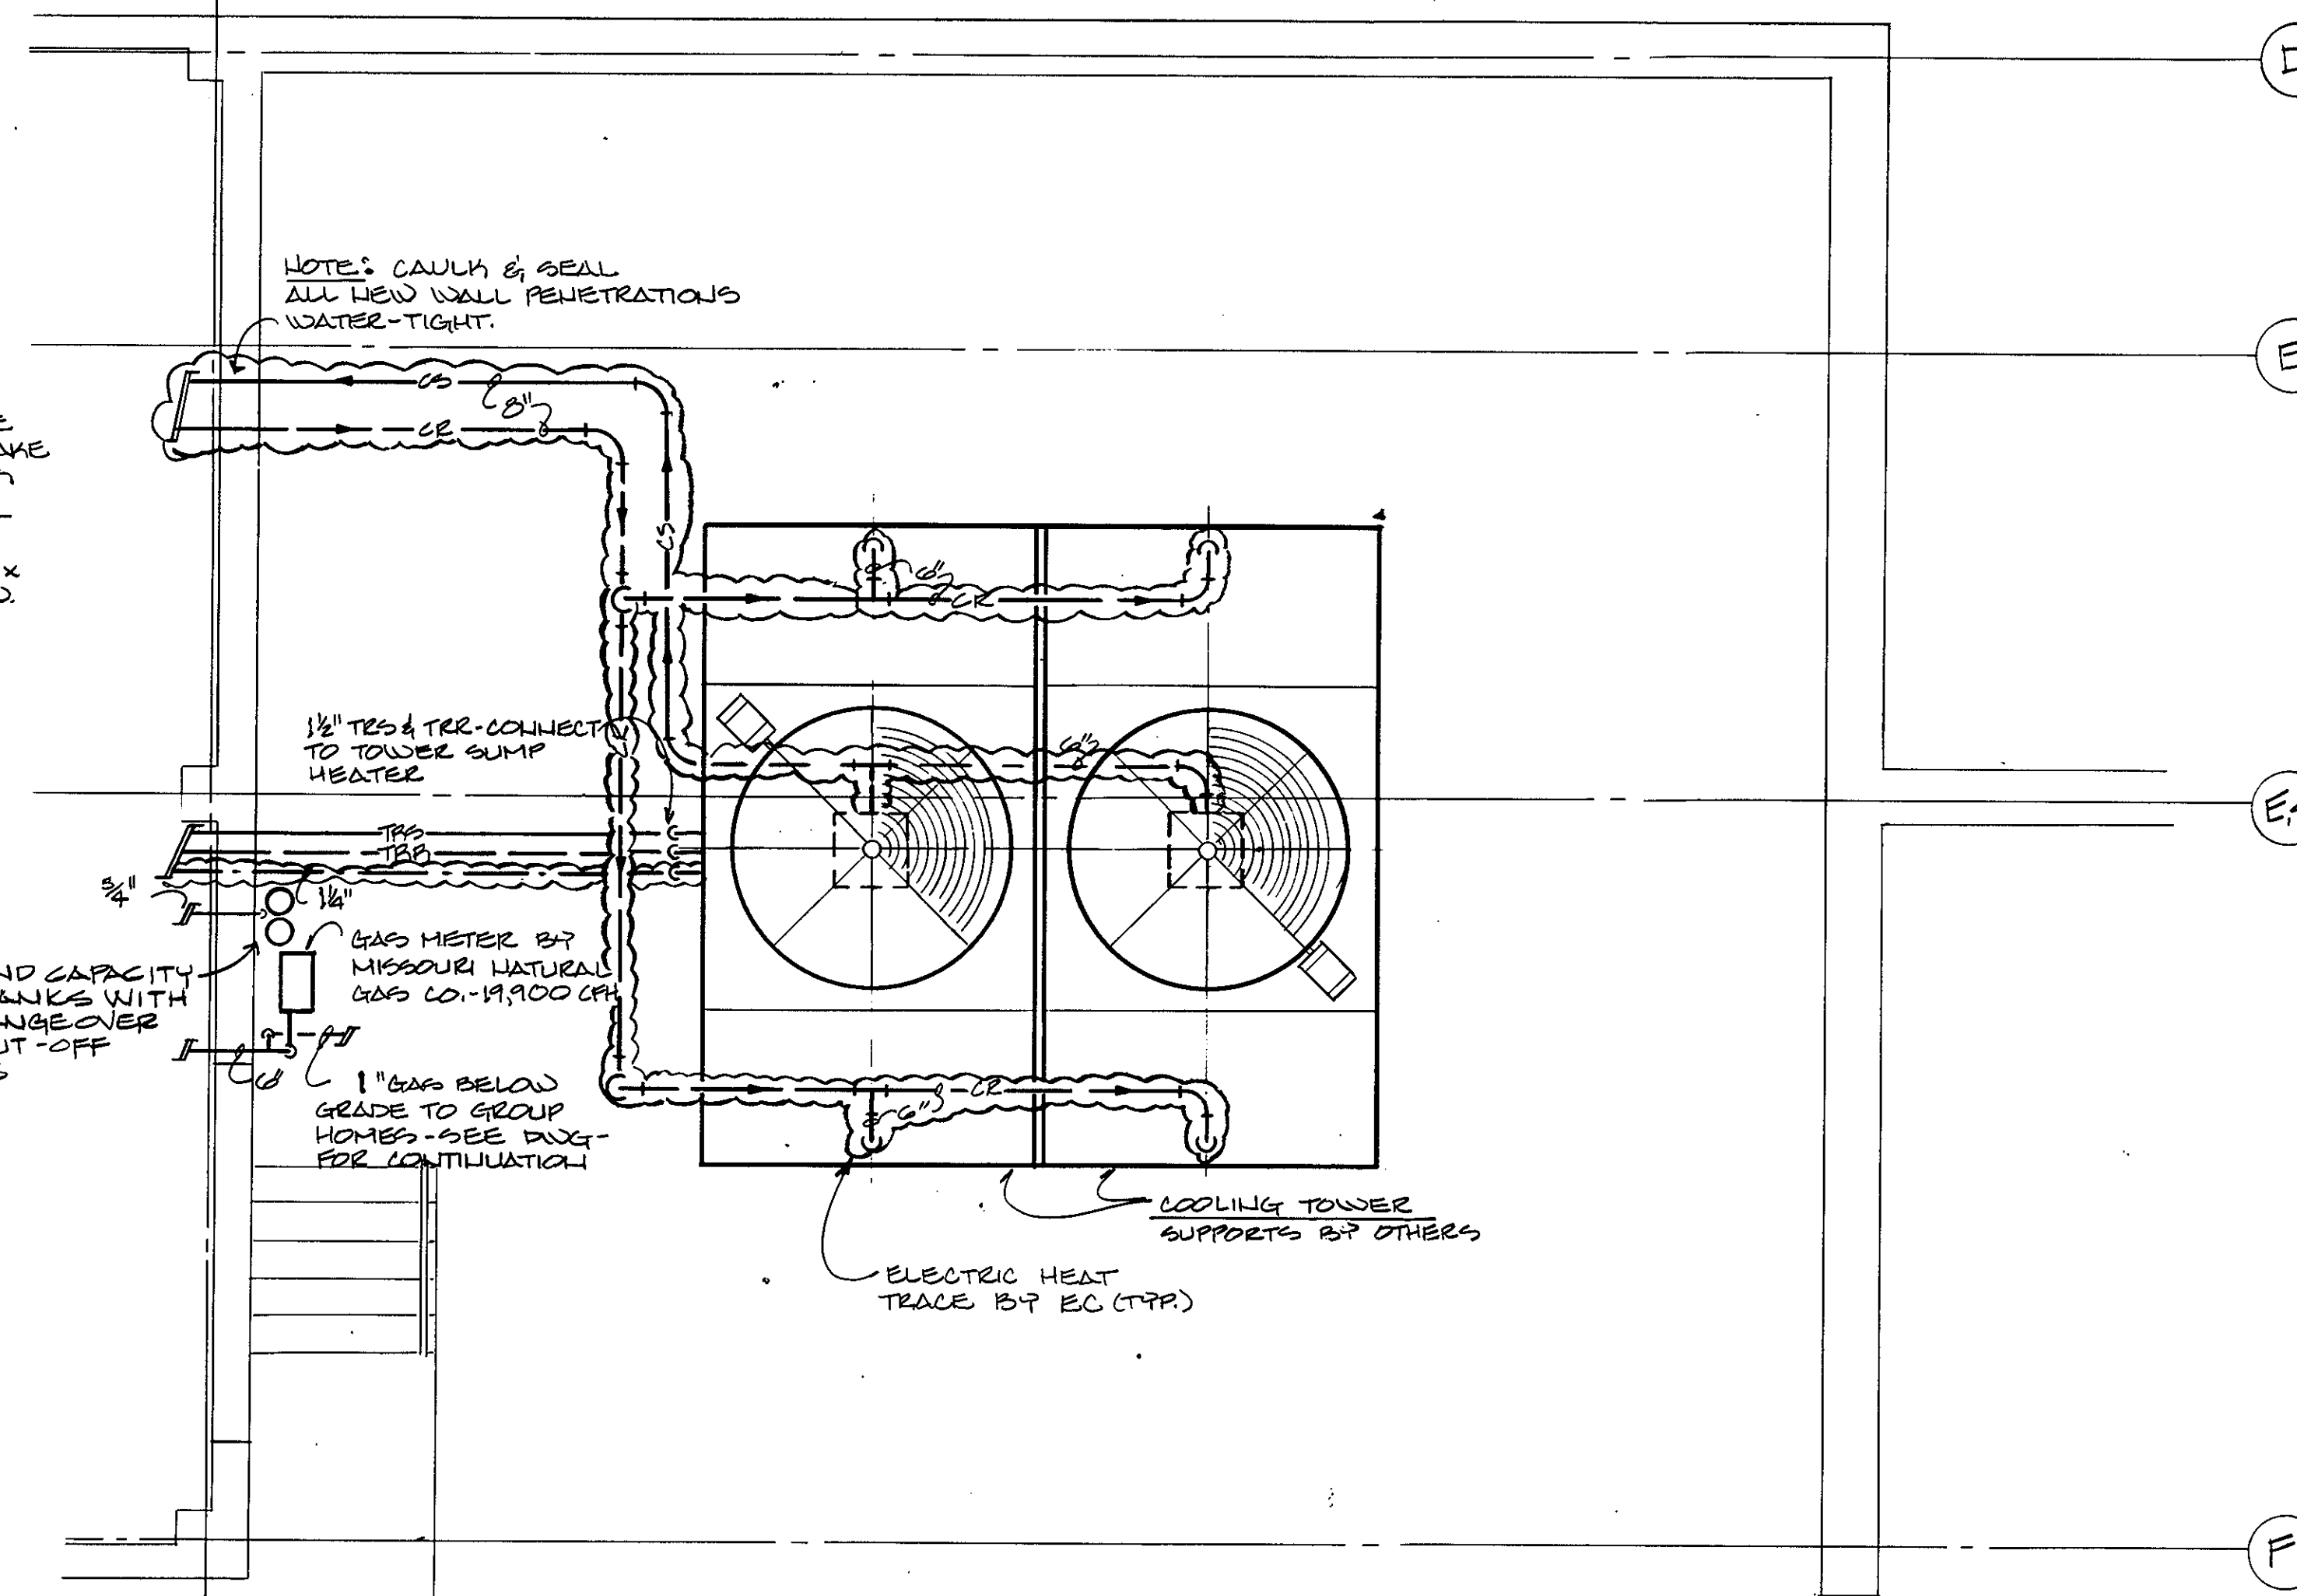

MECHANICAL EQUIPMENT ROOM PLAN


SCALE: 1/4" = 1'-0"



DRIVING TITLE:  
**MECHANICAL EQUIPMENT ROOM**

SCALE: 1/4" = 1'-0"

REVISIONS:

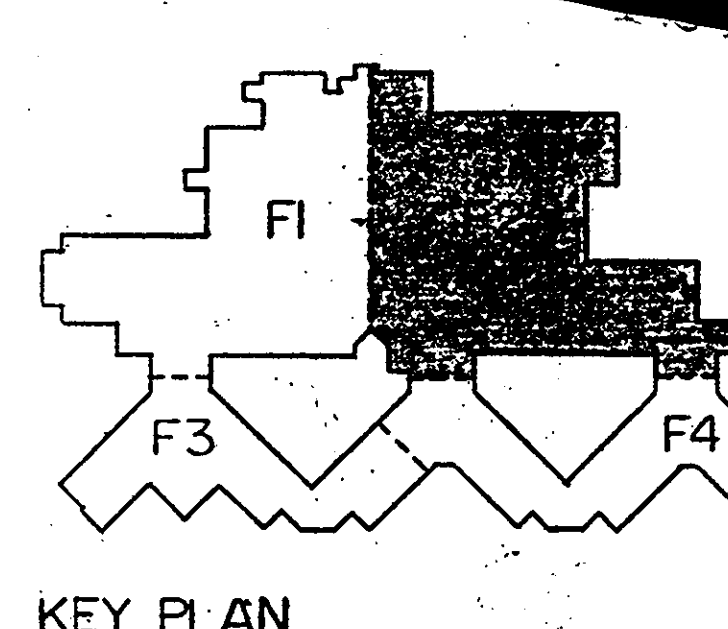*AS Built 6-8-87  
P. Deland  
J. Jones*

THE CHRISNER PARTNERSHIP INC. ARCHITECTS AND PLANNERS  
20 SOUTH HANLEY RD. CLAYTON, MISSOURI 63105 314-725-2927 11 W VICTORY WAY, CRAGO, COLORADO 81625 303-824-9707

**FOR REFERENCE ONLY**


**M18**

SHEET NUMBER: M18



PROJECT NUMBER: 83013

ISSUE DATE: 6-27-85

REGISTERED PROFESSIONAL ENGINEER  
STATE OF MISSOURI  
LICENSE NUMBER: E-13489

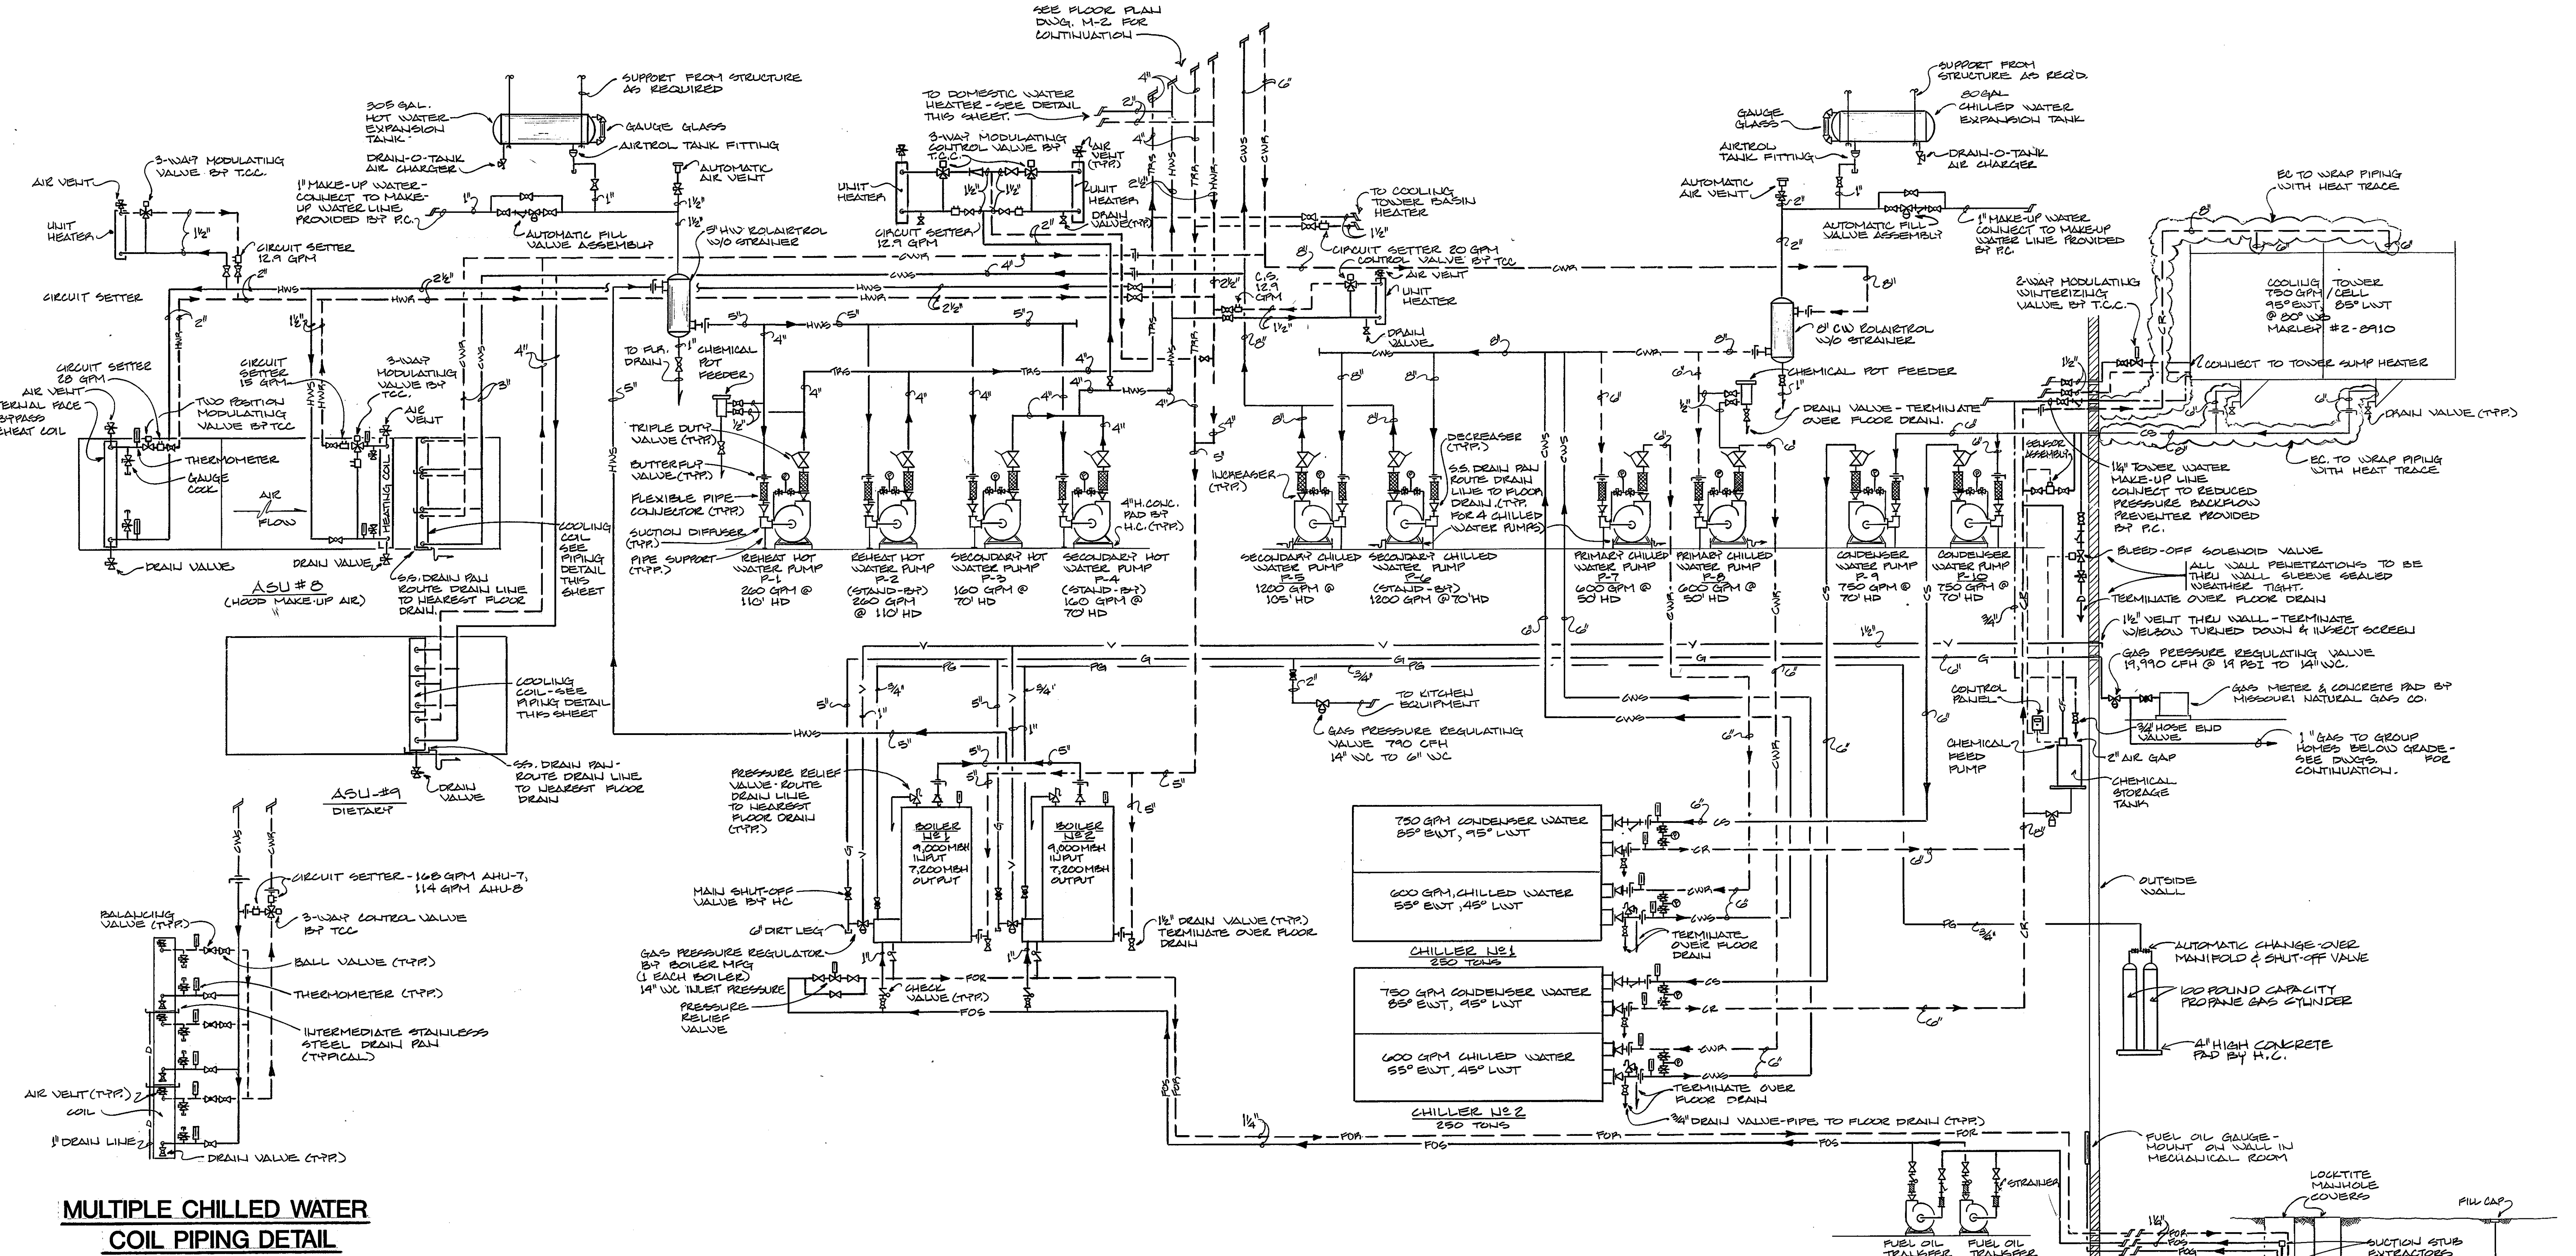

**MULTIPLE CHILLED WATER COIL PIPING DETAIL**

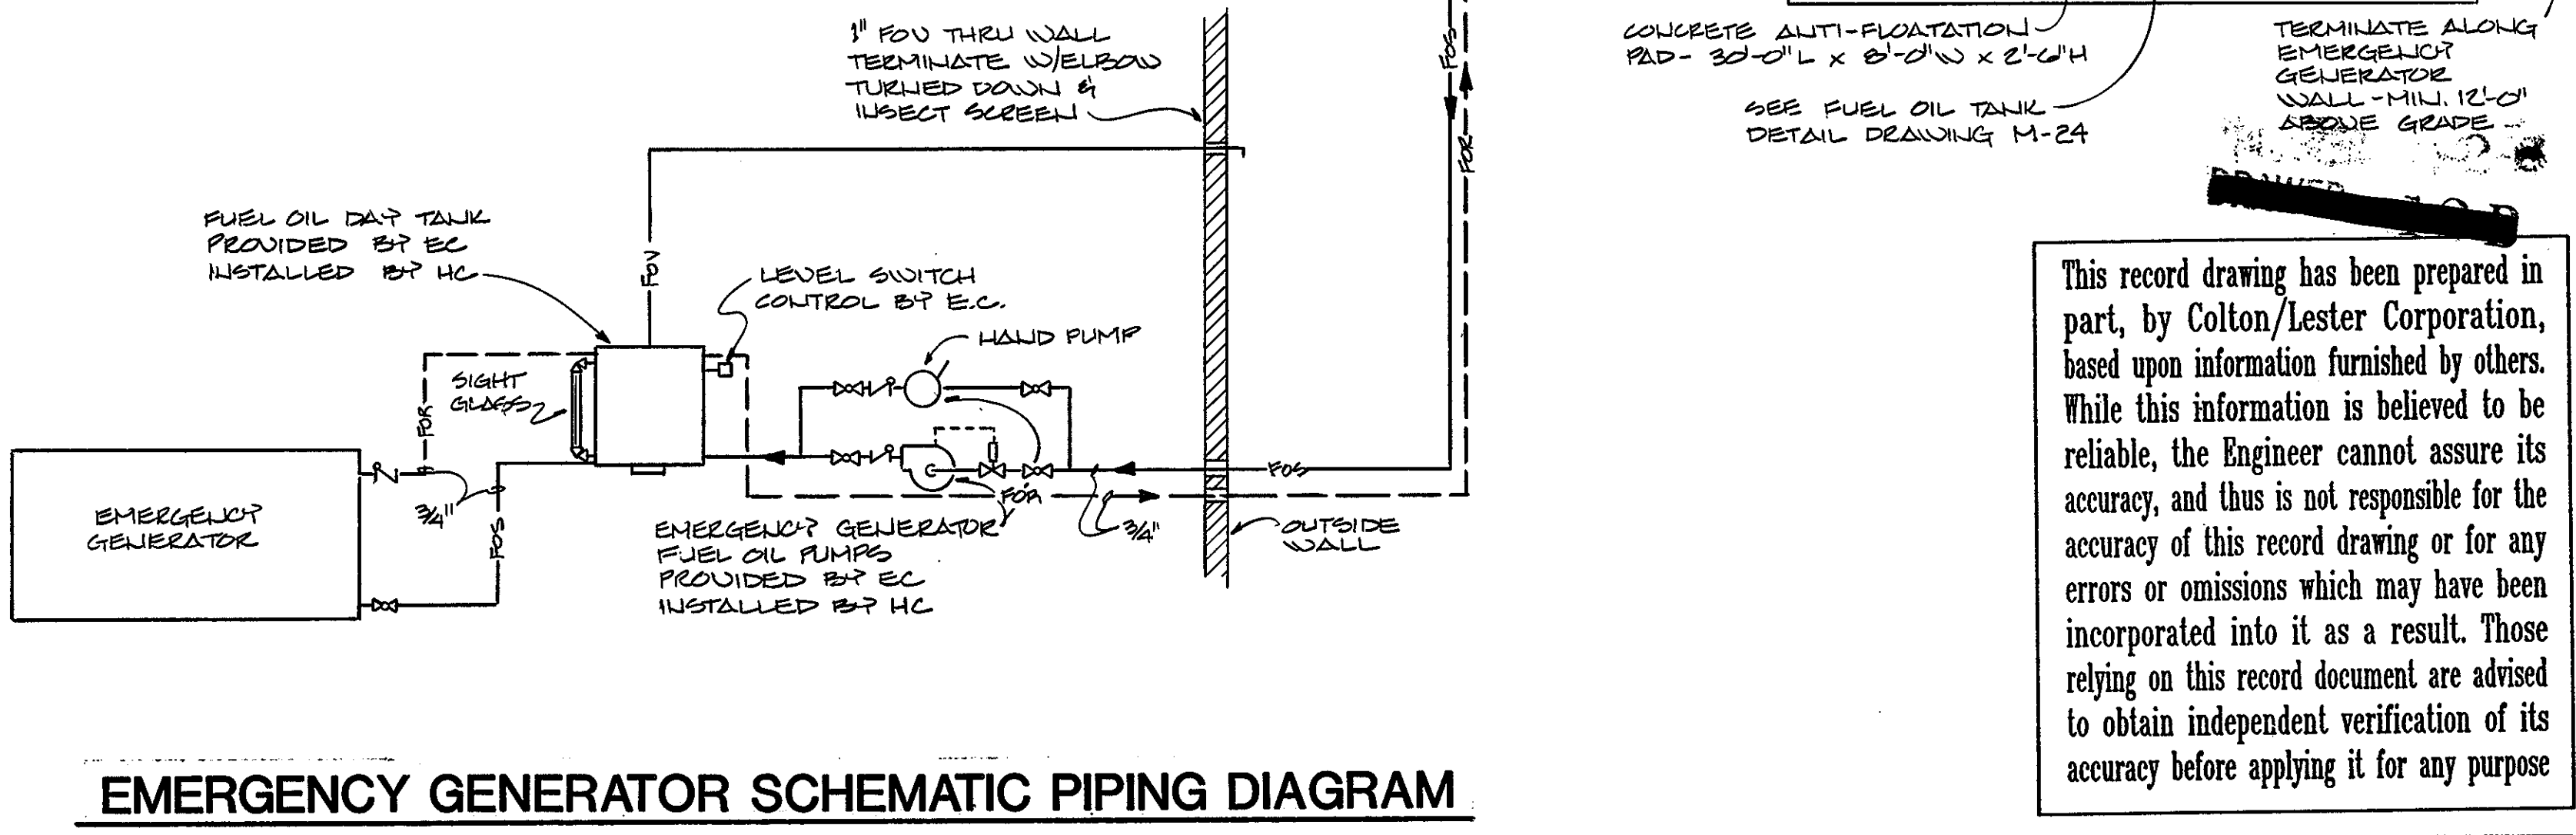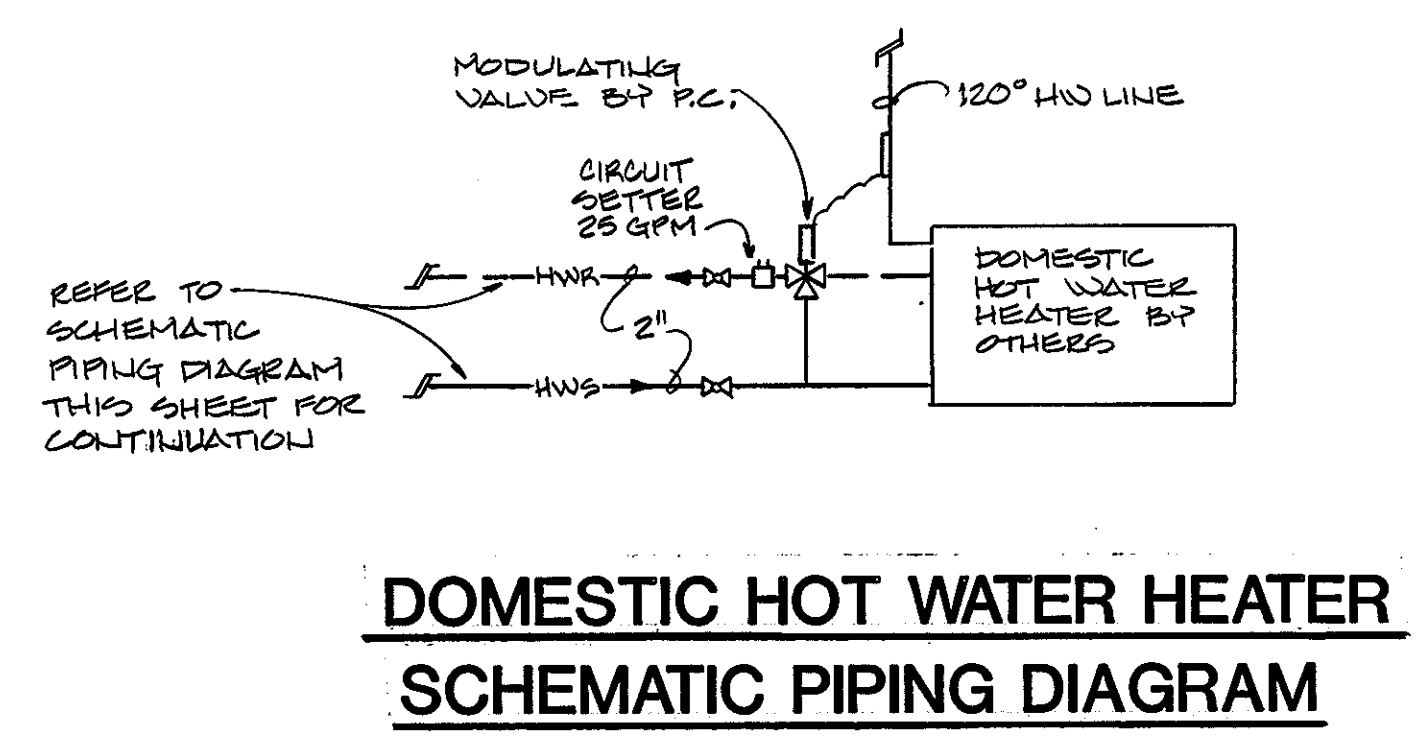

This record drawing has been prepared in part, by Colton/Lester Corporation, based upon information furnished by others. While this information is believed to be reliable, the Engineer cannot assure its accuracy, and thus is not responsible for any errors or omissions which may have been incorporated into it as a result. Those relying on this record document are advised to obtain independent verification of its accuracy before applying it for any purpose.

DRAWING TITLE: <b>HVAC PIPING DIAGRAM</b>	
SCALE: NONE	
REVISIONS:	
<b>RECORD DRAWING</b>	

**NEW DELICATUDIC HOSPITAL**  
**FOR REFERENCE ONLY**  
 CONVERSION AND CONSTRUCTION OF FARMINGTON STATE COMPLEX

STATE PROJECT NUMBER: 09-665-4-0001(E)

**THE CHRISNER PARTNERSHIP INC. ARCHITECTS AND PLANNERS**  
 20 SOUTH HANLEY RD. CLAYTON, MISSOURI 63105 314.725.2927 - 11 W. VICTORY WAY, CRAIG, COLORADO 81625 303.824.9707

ARCHITECTS AND PLANNERS  
 ARCHITECTURE PLANNING CONSULTING  
 PROJECT MANAGERS  
 HERCULES CONSTRUCTION COMPANY  
 COLTON-LESTER CORPORATION  
 W. MIT SENTER & ASSOCIATES  
 FOOD SERVICE CONSULTANTS

DEPARTMENT OF MENTAL HEALTH  
 OFFICE OF ADMINISTRATION  
 ROBERT C. HELLEN CONSTRUCTION  
 ACTING DIRECTOR

STATE OF MISSOURI  
 JOHN ASHCROFT  
 GOVERNOR

PAUL R. AHR PHD MPA



TERMINAL REHEAT UNIT SCHEDULE table with columns: MARK, MANUFACTURER, SIZE, CFM, AIR TEMP. ENT., LVB., BTUH, DUCT SIZE, ROWS, S.P., WATER ENT., LVB., GPM, P.D.

TERMINAL REHEAT UNIT SCHEDULE table with columns: MARK, MANUFACTURER, SIZE, CFM, AIR TEMP. ENT., LVB., BTUH, DUCT SIZE, ROWS, S.P., WATER ENT., LVB., GPM, P.D.


VAV BOX SCHEDULE table with columns: MARK, MANUFACTURER, MODEL, SIZE, CFM, INLET SIZE, DISCHARGE, REMARKS

This record drawing has been prepared in part, by Colton/Lester Corporation, based upon information furnished by others. While this information is believed to be reliable, the Engineer cannot assure its accuracy, and thus is not responsible for any errors or omissions which may have been incorporated into it as a result. Those relying on this record document are advised to obtain independent verification of its accuracy before applying it for any purpose.


DRAWING TITLE: SCHEDULES SCALE: NONE REVISIONS RECORD DRAWING

Professional seals and logos for THE CHRISTNER PARTNERSHIP INC. ARCHITECTS AND PLANNERS, ENGINEER, ARCHITECT, and other credentials.



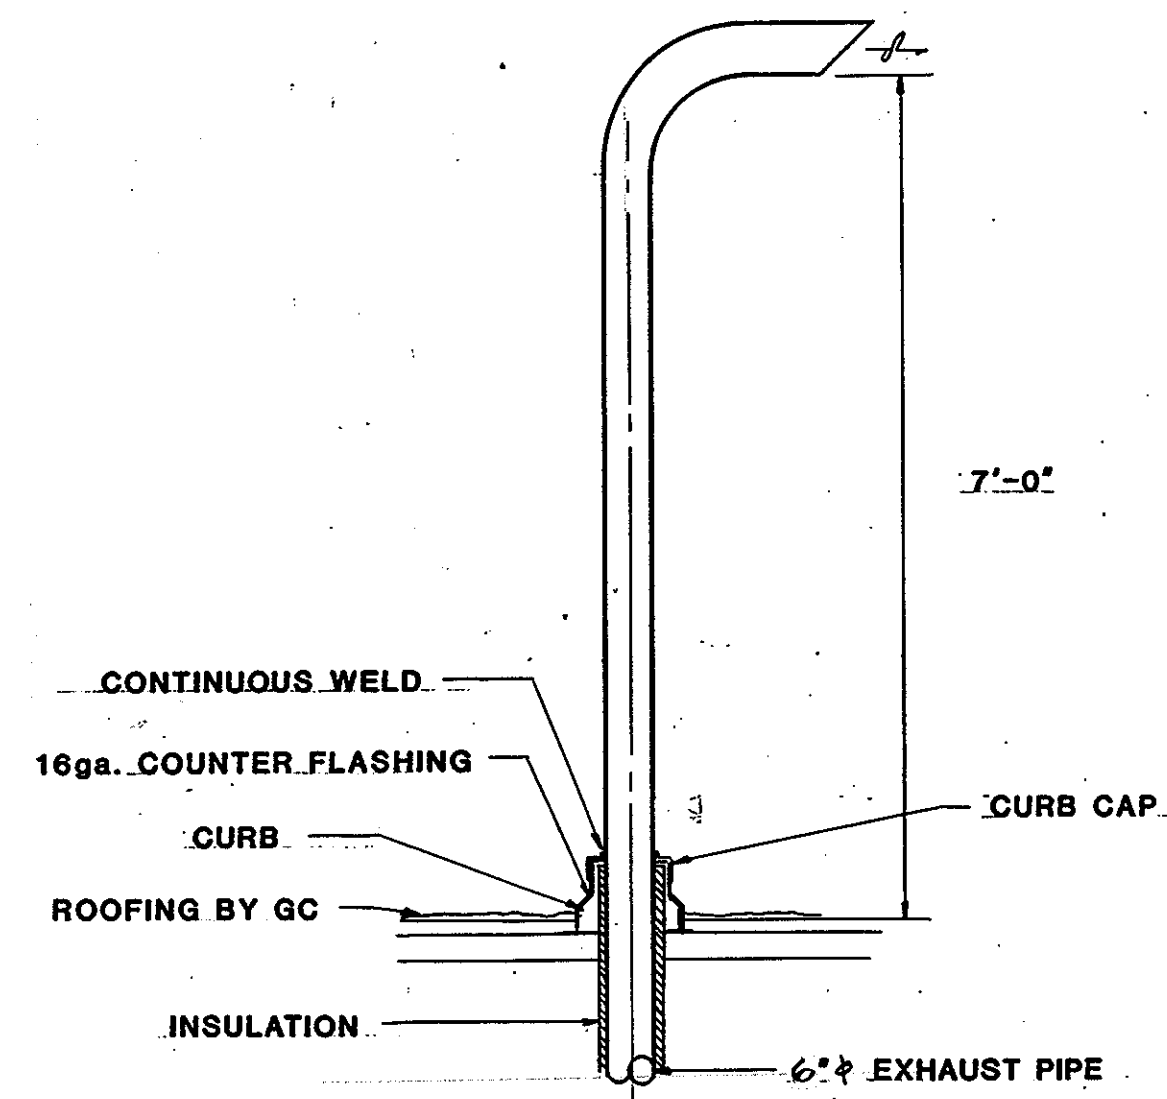


**EMERGENCY GENERATOR EXHAUST PIPE DETAIL**  
no scale.

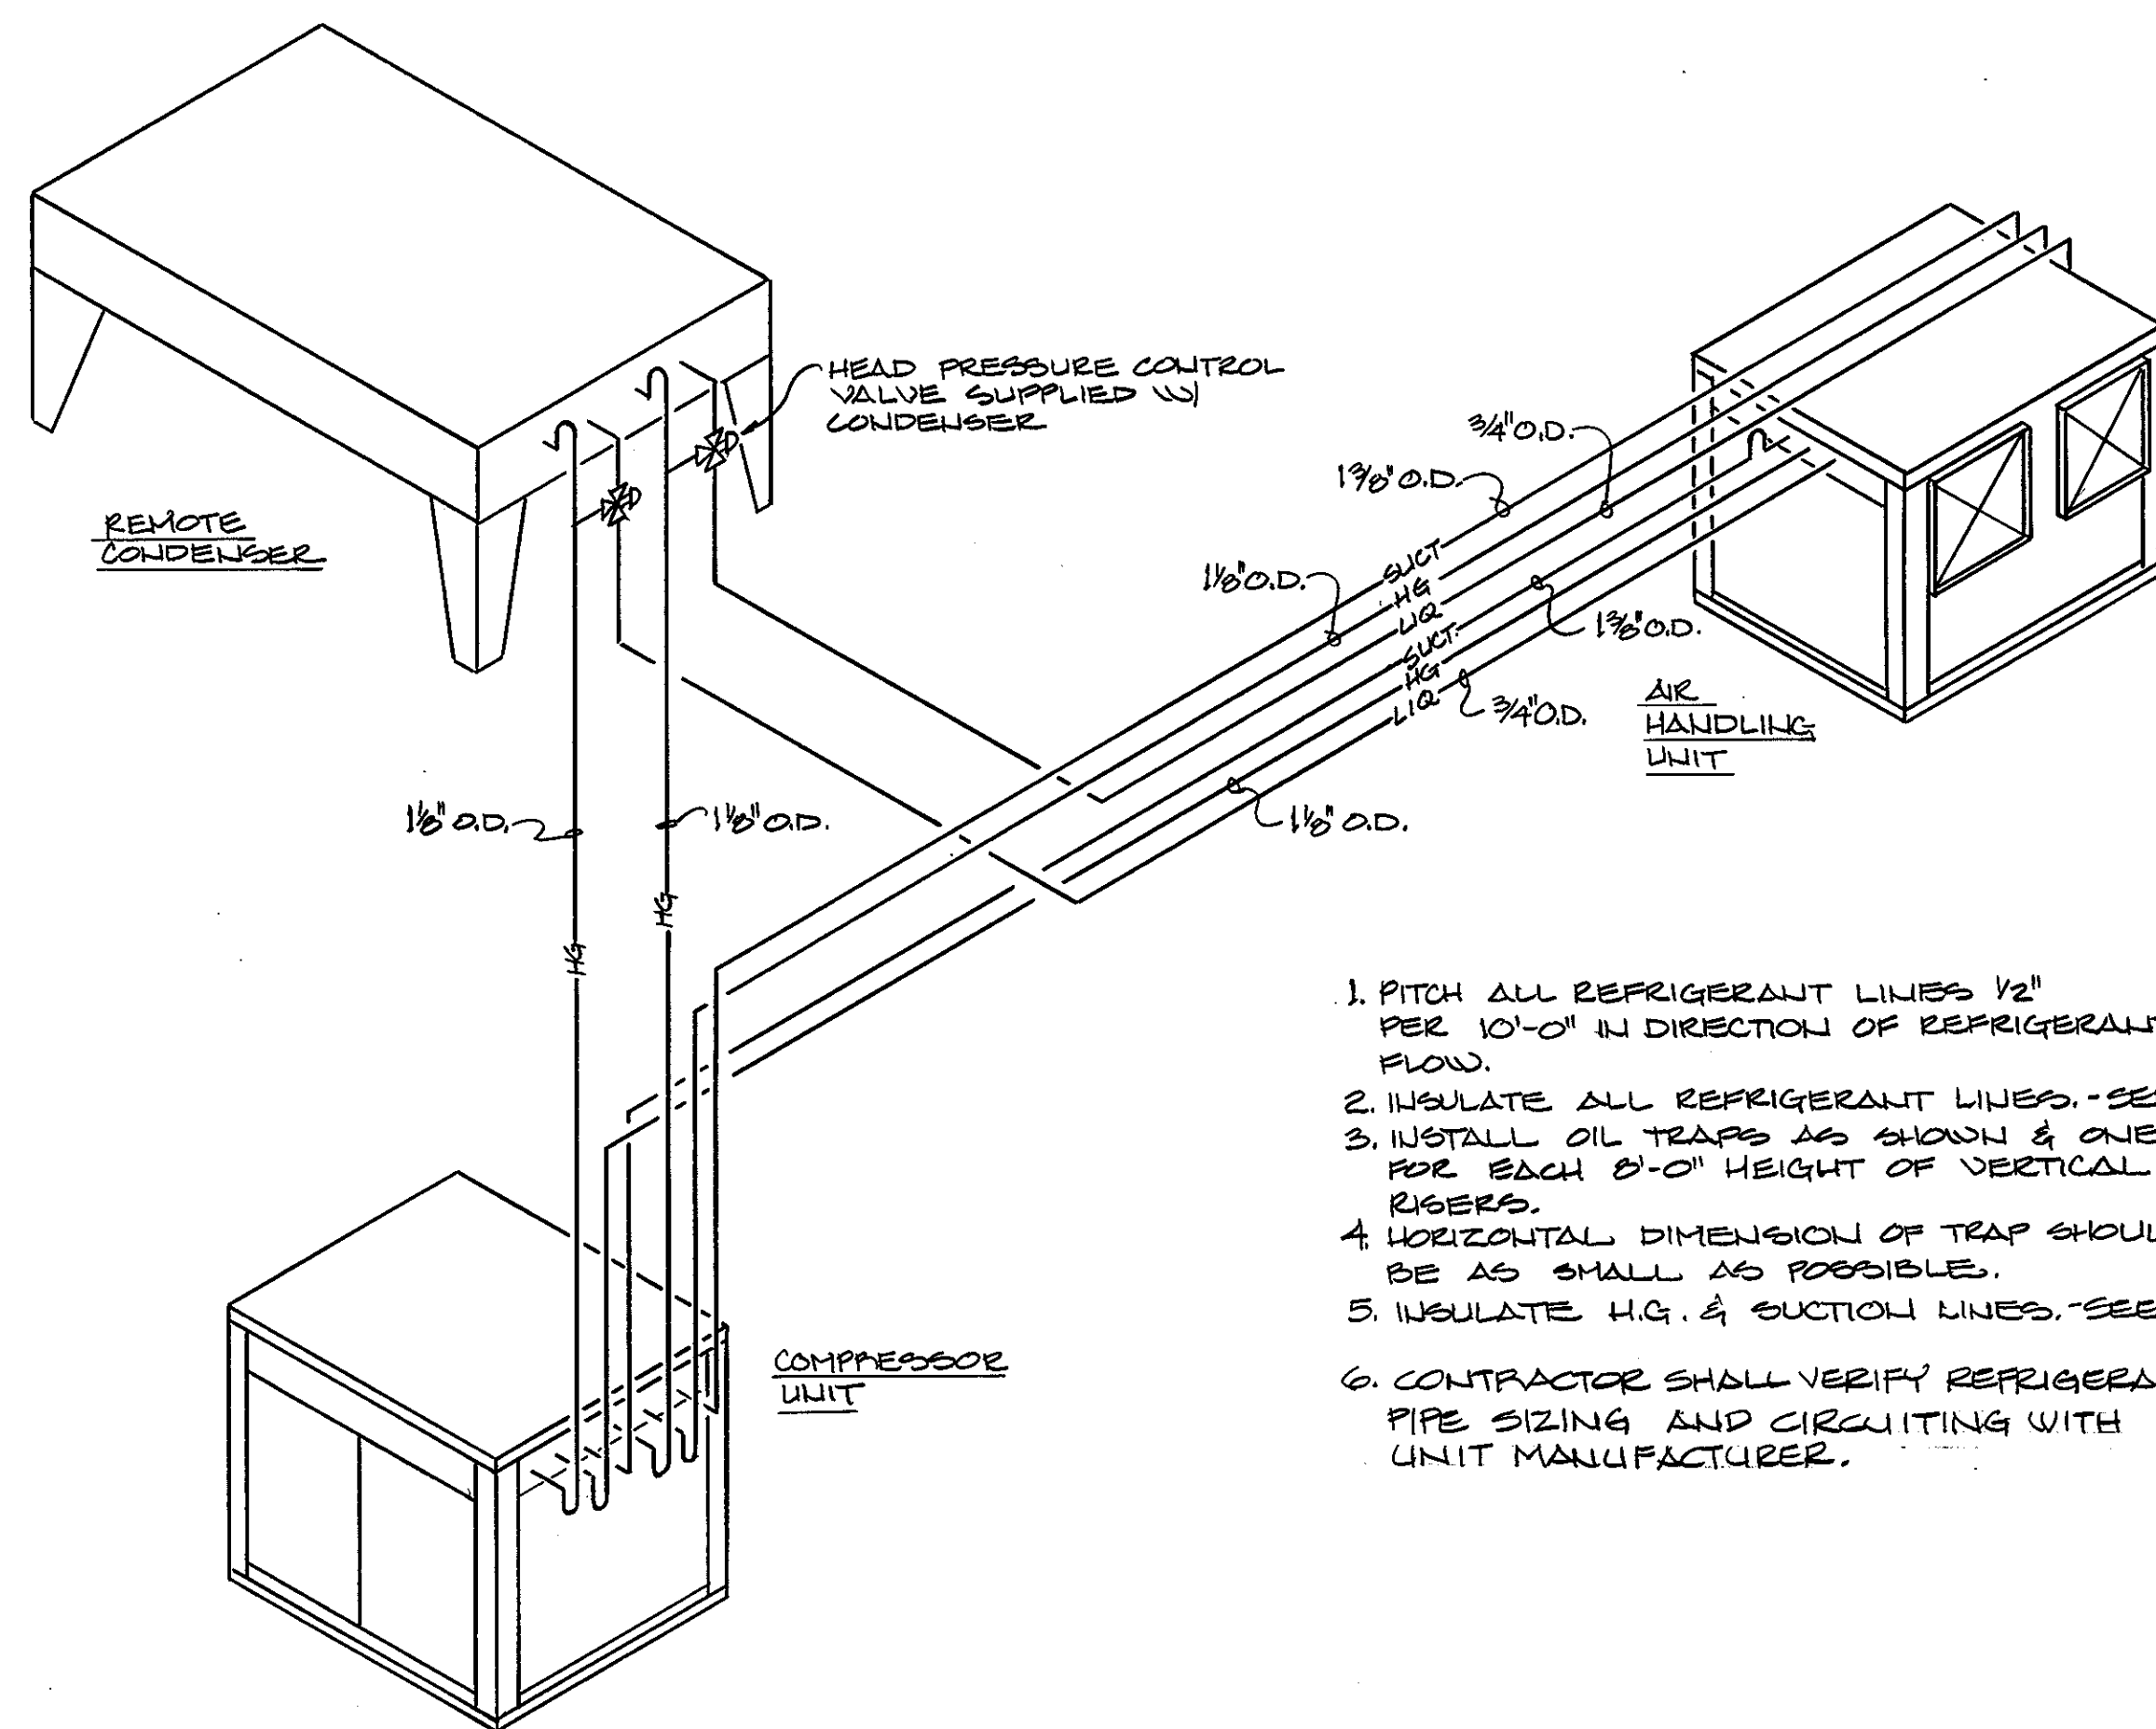


**POOL AIR HANDLING SYSTEM PIPING DIAGRAM**  
NOT TO SCALE


1. PITCH ALL REFRIGERANT LINES 1/2" PER 10'-0" IN DIRECTION OF REFRIGERANT FLOW.
2. INSULATE ALL REFRIGERANT LINES - SEE SPEC.
3. INSTALL OIL TRAPS AS SHOWN & ONE FOR EACH 8'-0" HEIGHT OF VERTICAL ROISES.
4. HORIZONTAL DIMENSION OF TRAP SHOULD BE AS SMALL AS POSSIBLE.
5. INSULATE H.G. & DUCTION LINES - SEE SPEC.
6. CONTRACTOR SHALL VERIFY REFRIGERANT PIPE SIZING AND CIRCUITING WITH UNIT MANUFACTURER.

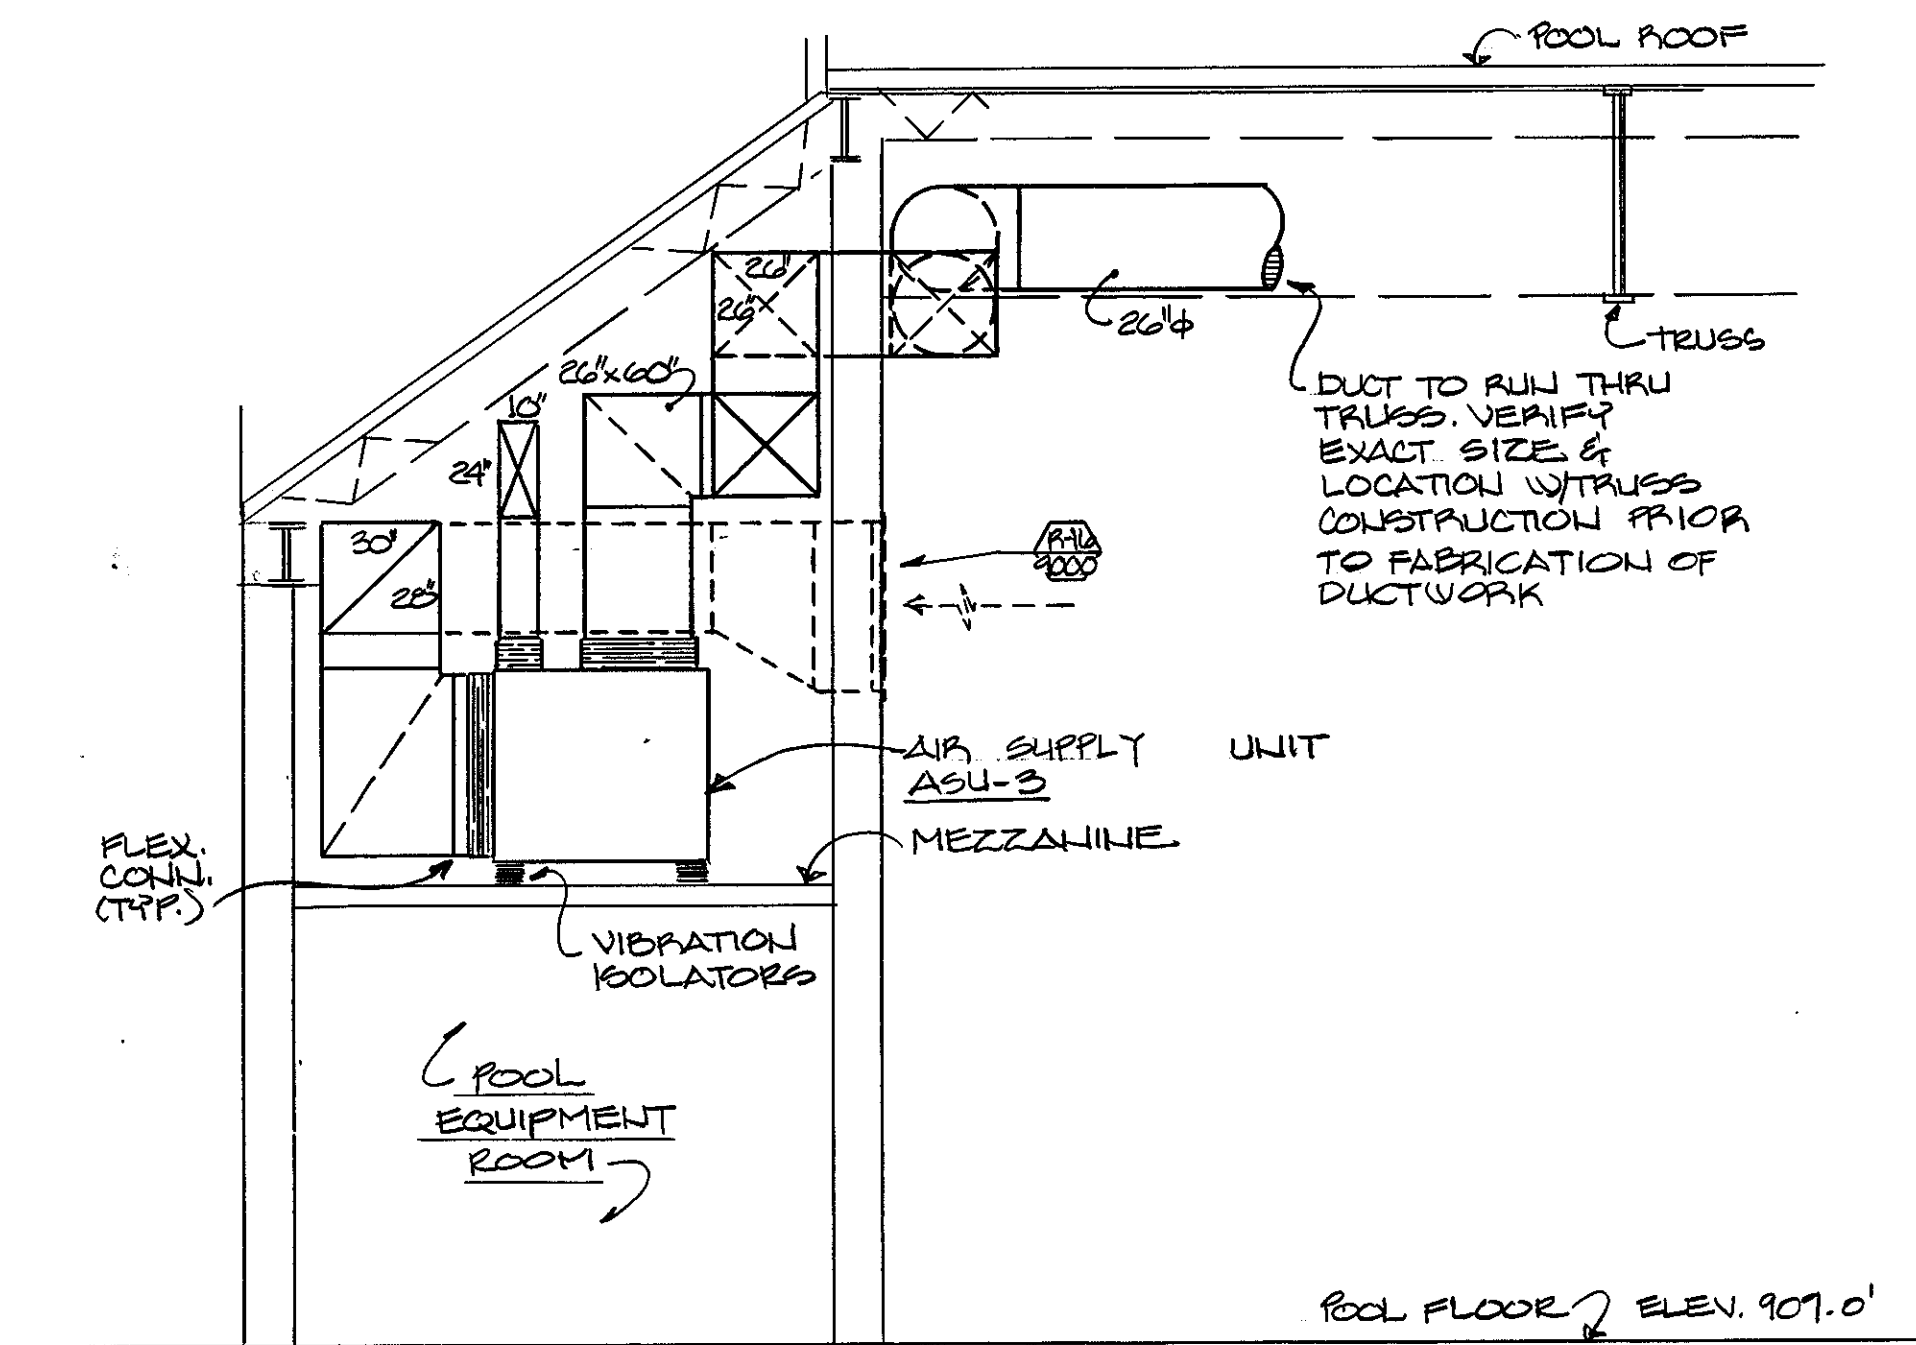


**SECTION 1**  
SCALE: 1/4" = 1'-0"

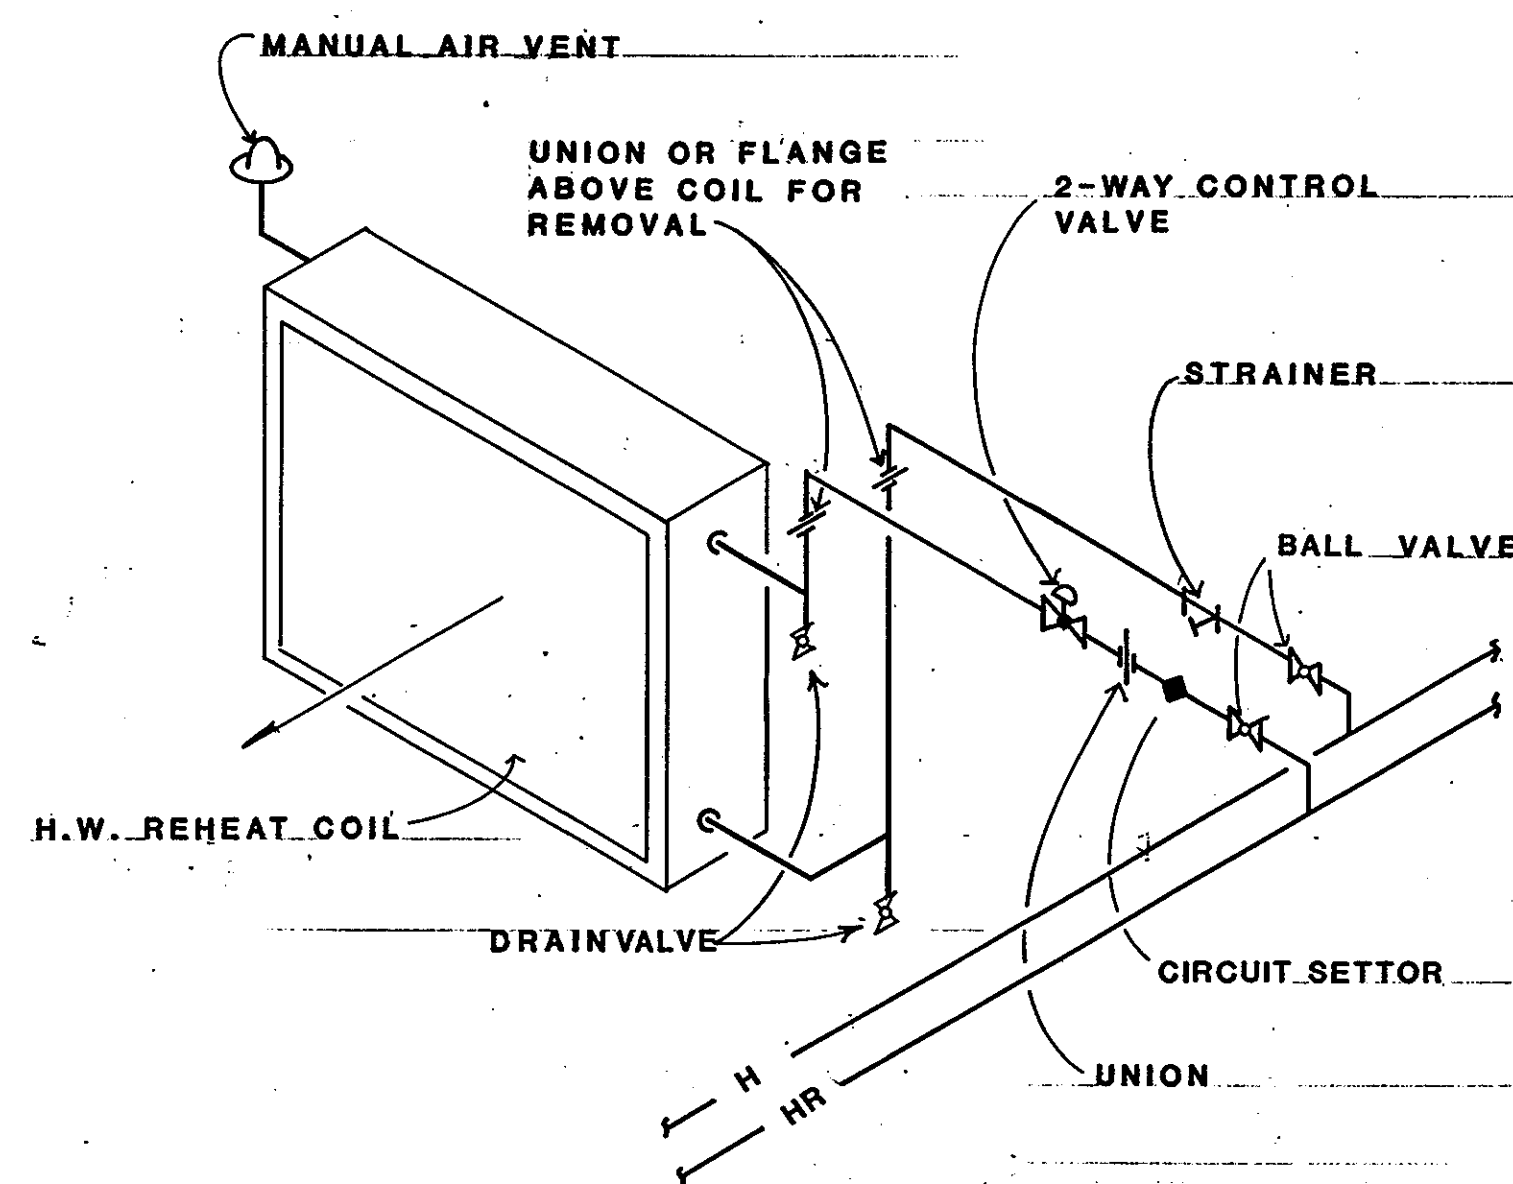

**MAKE-UP AIR COIL PIPING DETAIL**  
NOT TO SCALE

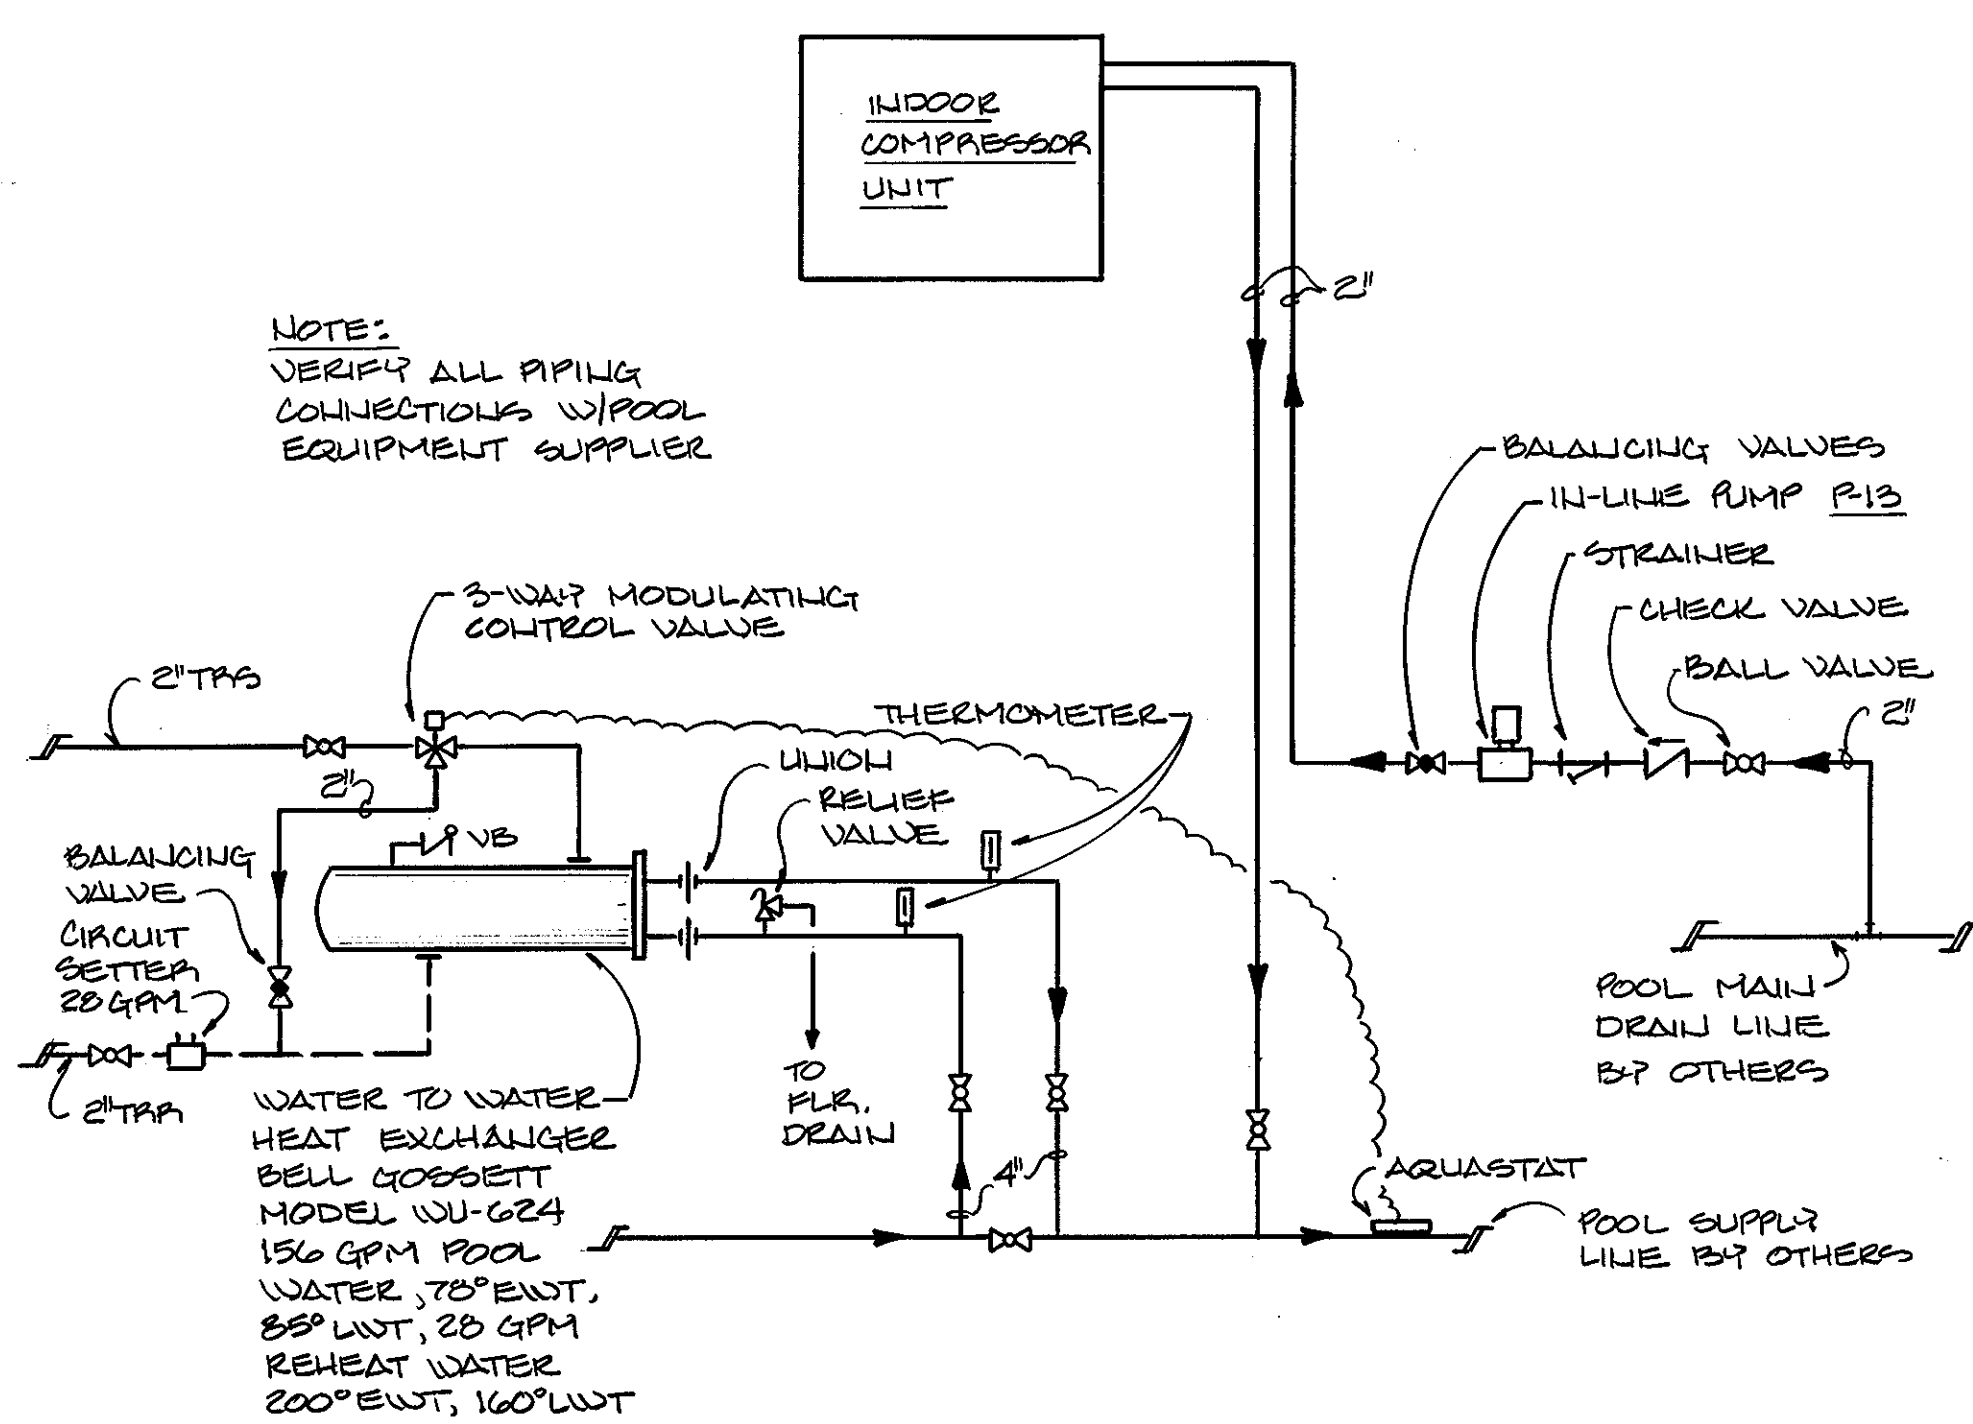

**POOL HEATER PIPING SCHEMATIC**  
SCALE: 1/4" = 1'-0"

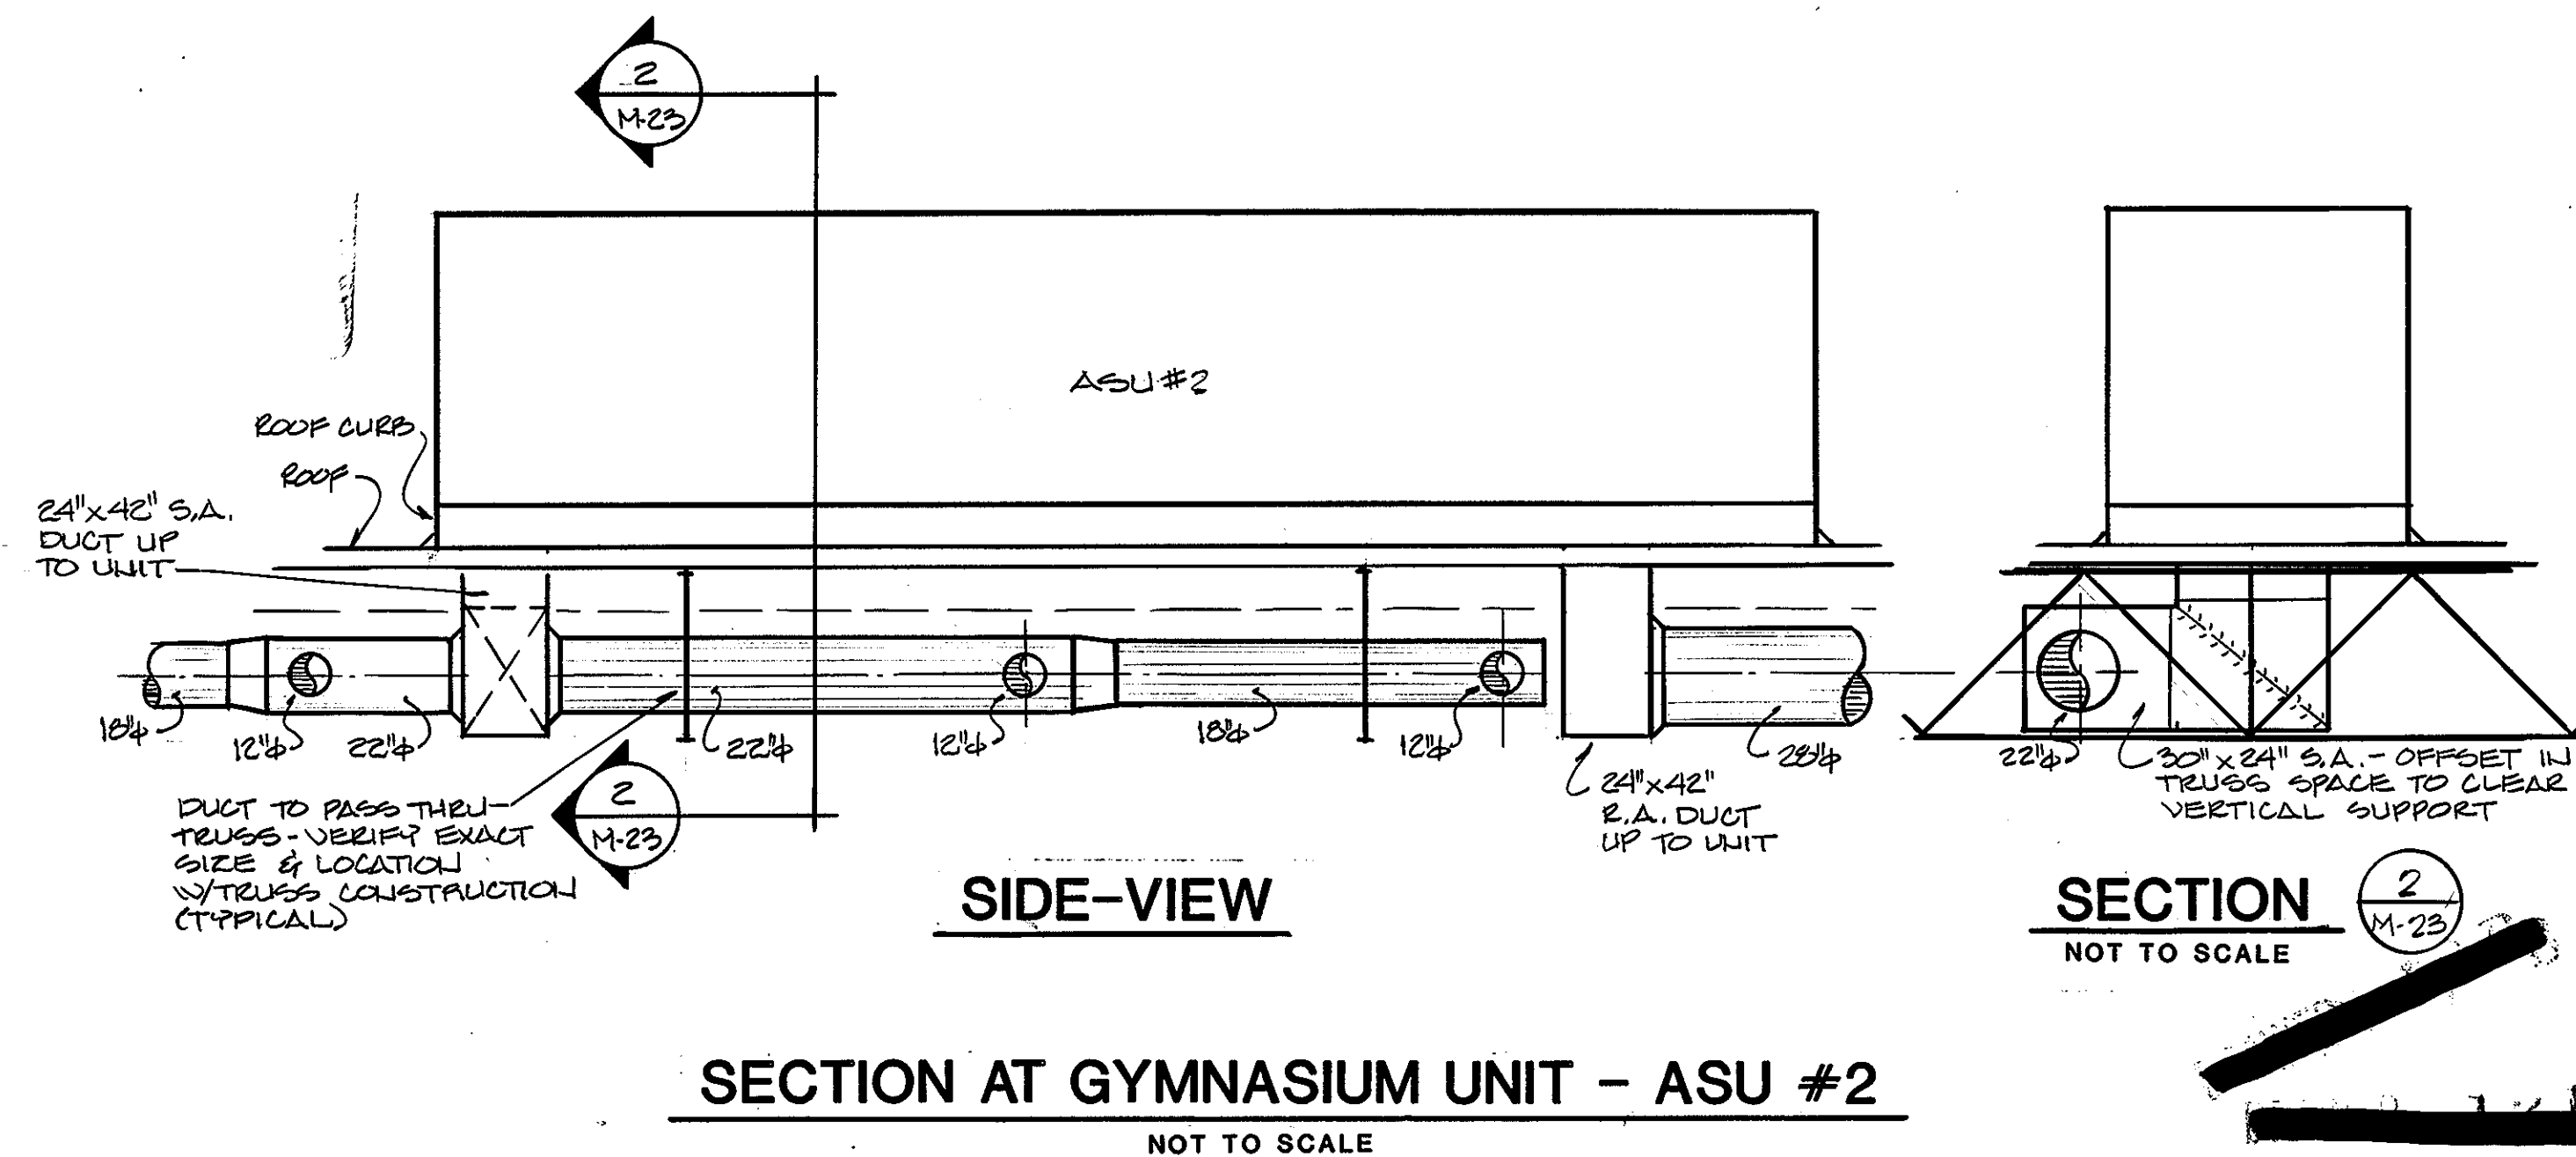


**SECTION AT GYMNASIUM UNIT - ASU #2**  
NOT TO SCALE

This record drawing has been prepared in part, by Colton/Lester Corporation, based upon information furnished by others. While this information is believed to be reliable, the Engineer cannot assure its accuracy, and thus is not responsible for the accuracy of this record drawing or for any errors or omissions which may have been incorporated into it as a result. Those relying on this record document are advised to obtain independent verification of its accuracy before applying it for any purpose.

DRAWING TITLE:	
<b>DETAILS</b>	
SCALE: AS NOTED	
REVISIONS:	
<b>RECORD DRAWING</b>	

SHEET NUMBER:	
<b>M23</b>	
PROJECT NUMBER:	
83013	
ISSUE DATE:	
6-27-85	

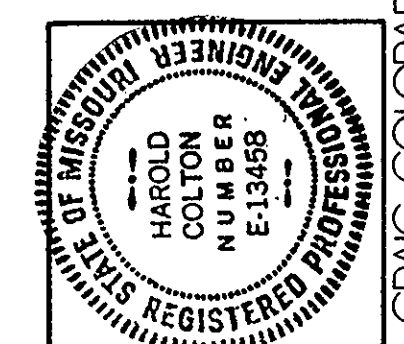


ARCHITECTS AND PLANNERS  
THE CHRISNER PARTNERSHIP INC.  
STONE, MARRAZZINI & PATTERSON  
HEROLES CONSTRUCTION COMPANY  
COLTON-LESTER CORPORATION  
W. MIT SARTER & ASSOCIATES  
ARCHITECTURE PLANNING CONSULTING  
PROJECT MANAGERS  
CONSULTING ENGINEERS  
FOOD SERVICE CONSULTANTS

DEPARTMENT OF MENTAL HEALTH  
Paul R. Ahr, PhD, MPA  
OFFICE OF ADMINISTRATION  
JAMES C. HELLER  
ACTING DIRECTOR

STATE OF MISSOURI  
JOHN ASHCROFT  
GOVERNOR

**NEW DELTA CLINICAL HOSPITAL**  
**FOR REFERENCE ONLY**  
FAIRMONT  
CONVERSION AND CONSTRUCTION OF FARMINGTON STATE COMPLEX  
STATE PROJECT NUMBER: 09-656-4-90(1E)


THE CHRISNER PARTNERSHIP INC. ARCHITECTS AND PLANNERS · 20 SOUTH HANLEY RD. · CLAYTON, MISSOURI · 63106 · 314-725-2927 · 11 W. VICTORY WAY · CRAIG, COLORADO · 81625 · 303-824-9707

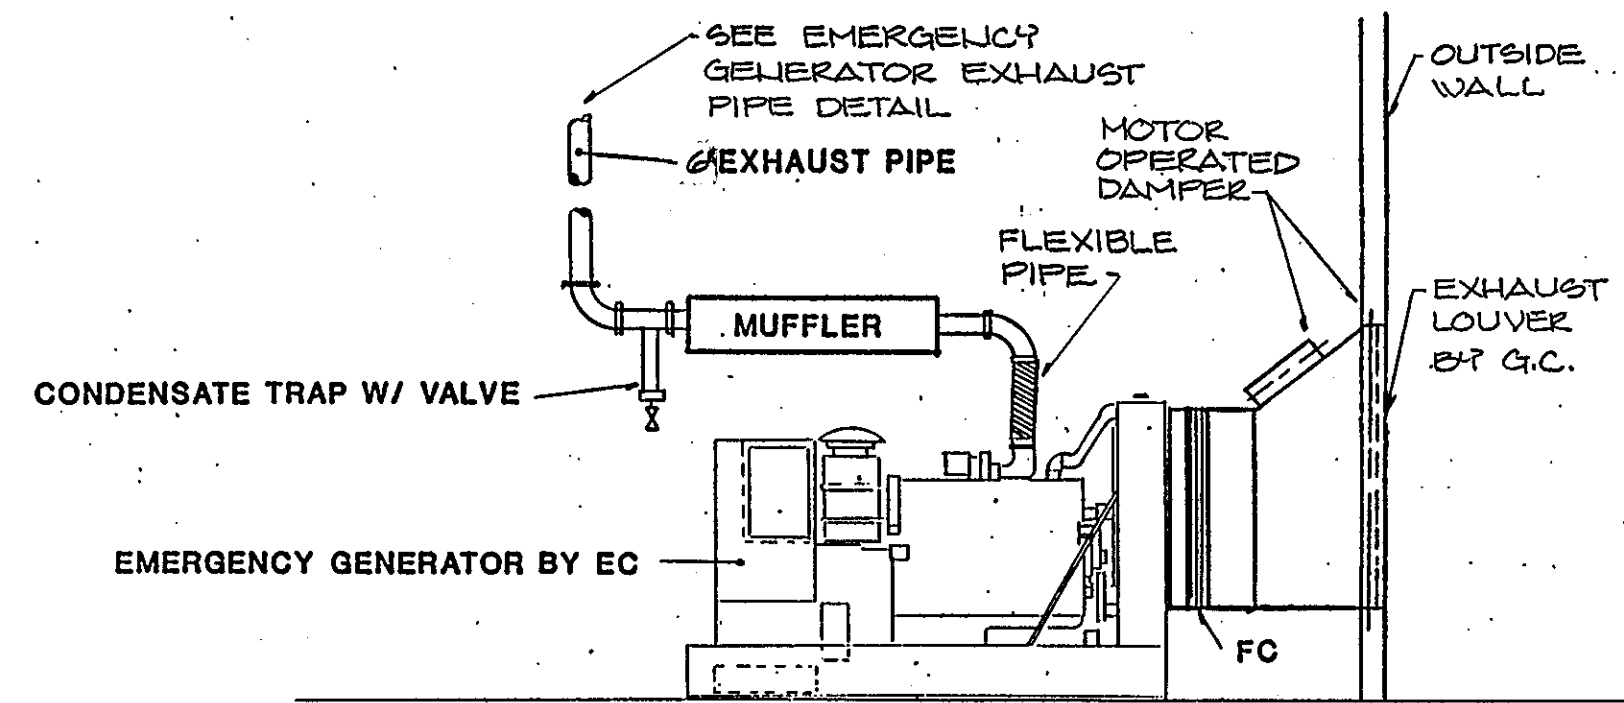

NOTE:  
MUFFLER AND FLEXIBLE PIPE ARE PROVIDED BY EC, INSTALLED BY MC


**EMERGENCY GENERATOR DETAIL**

NOT TO SCALE

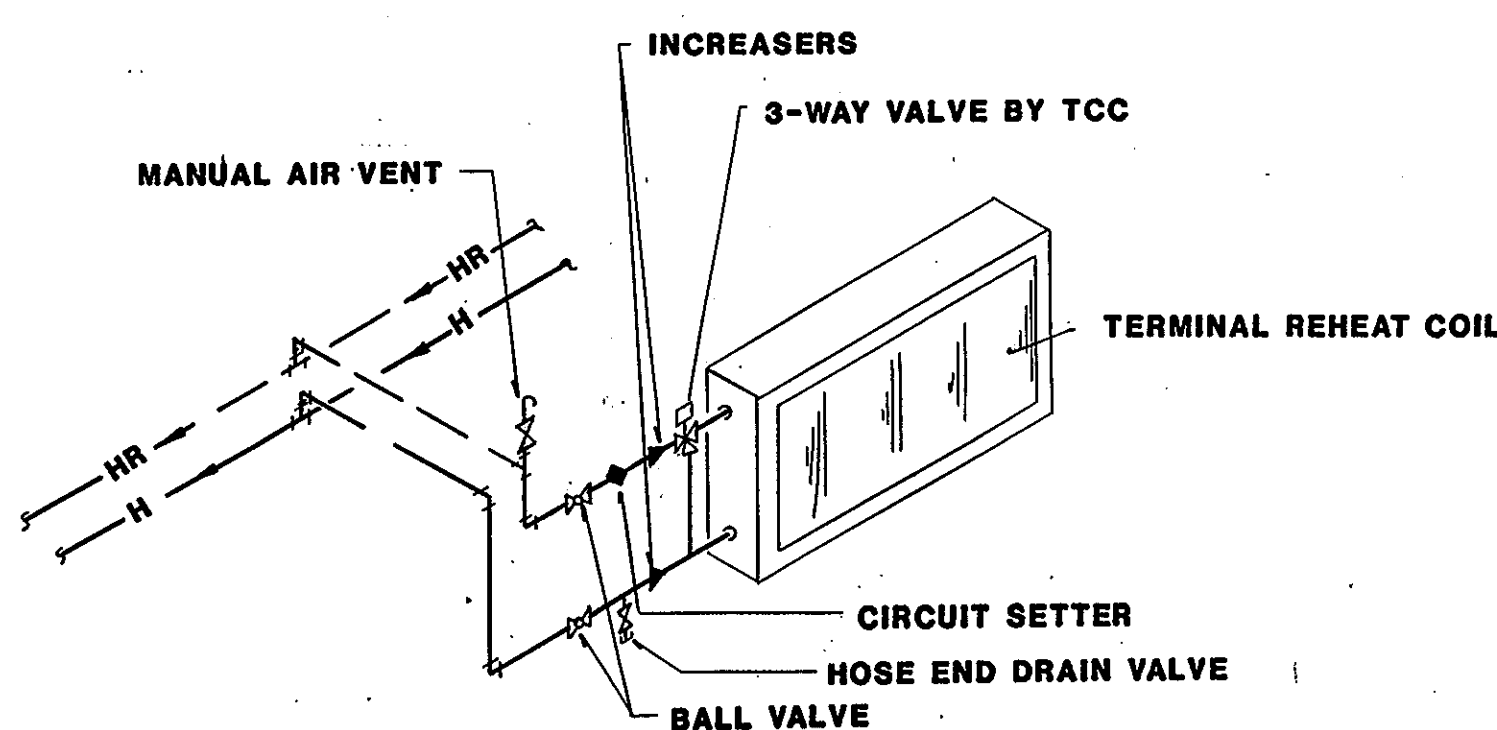


**TERMINAL REHEAT COIL DETAIL**

NOT TO SCALE

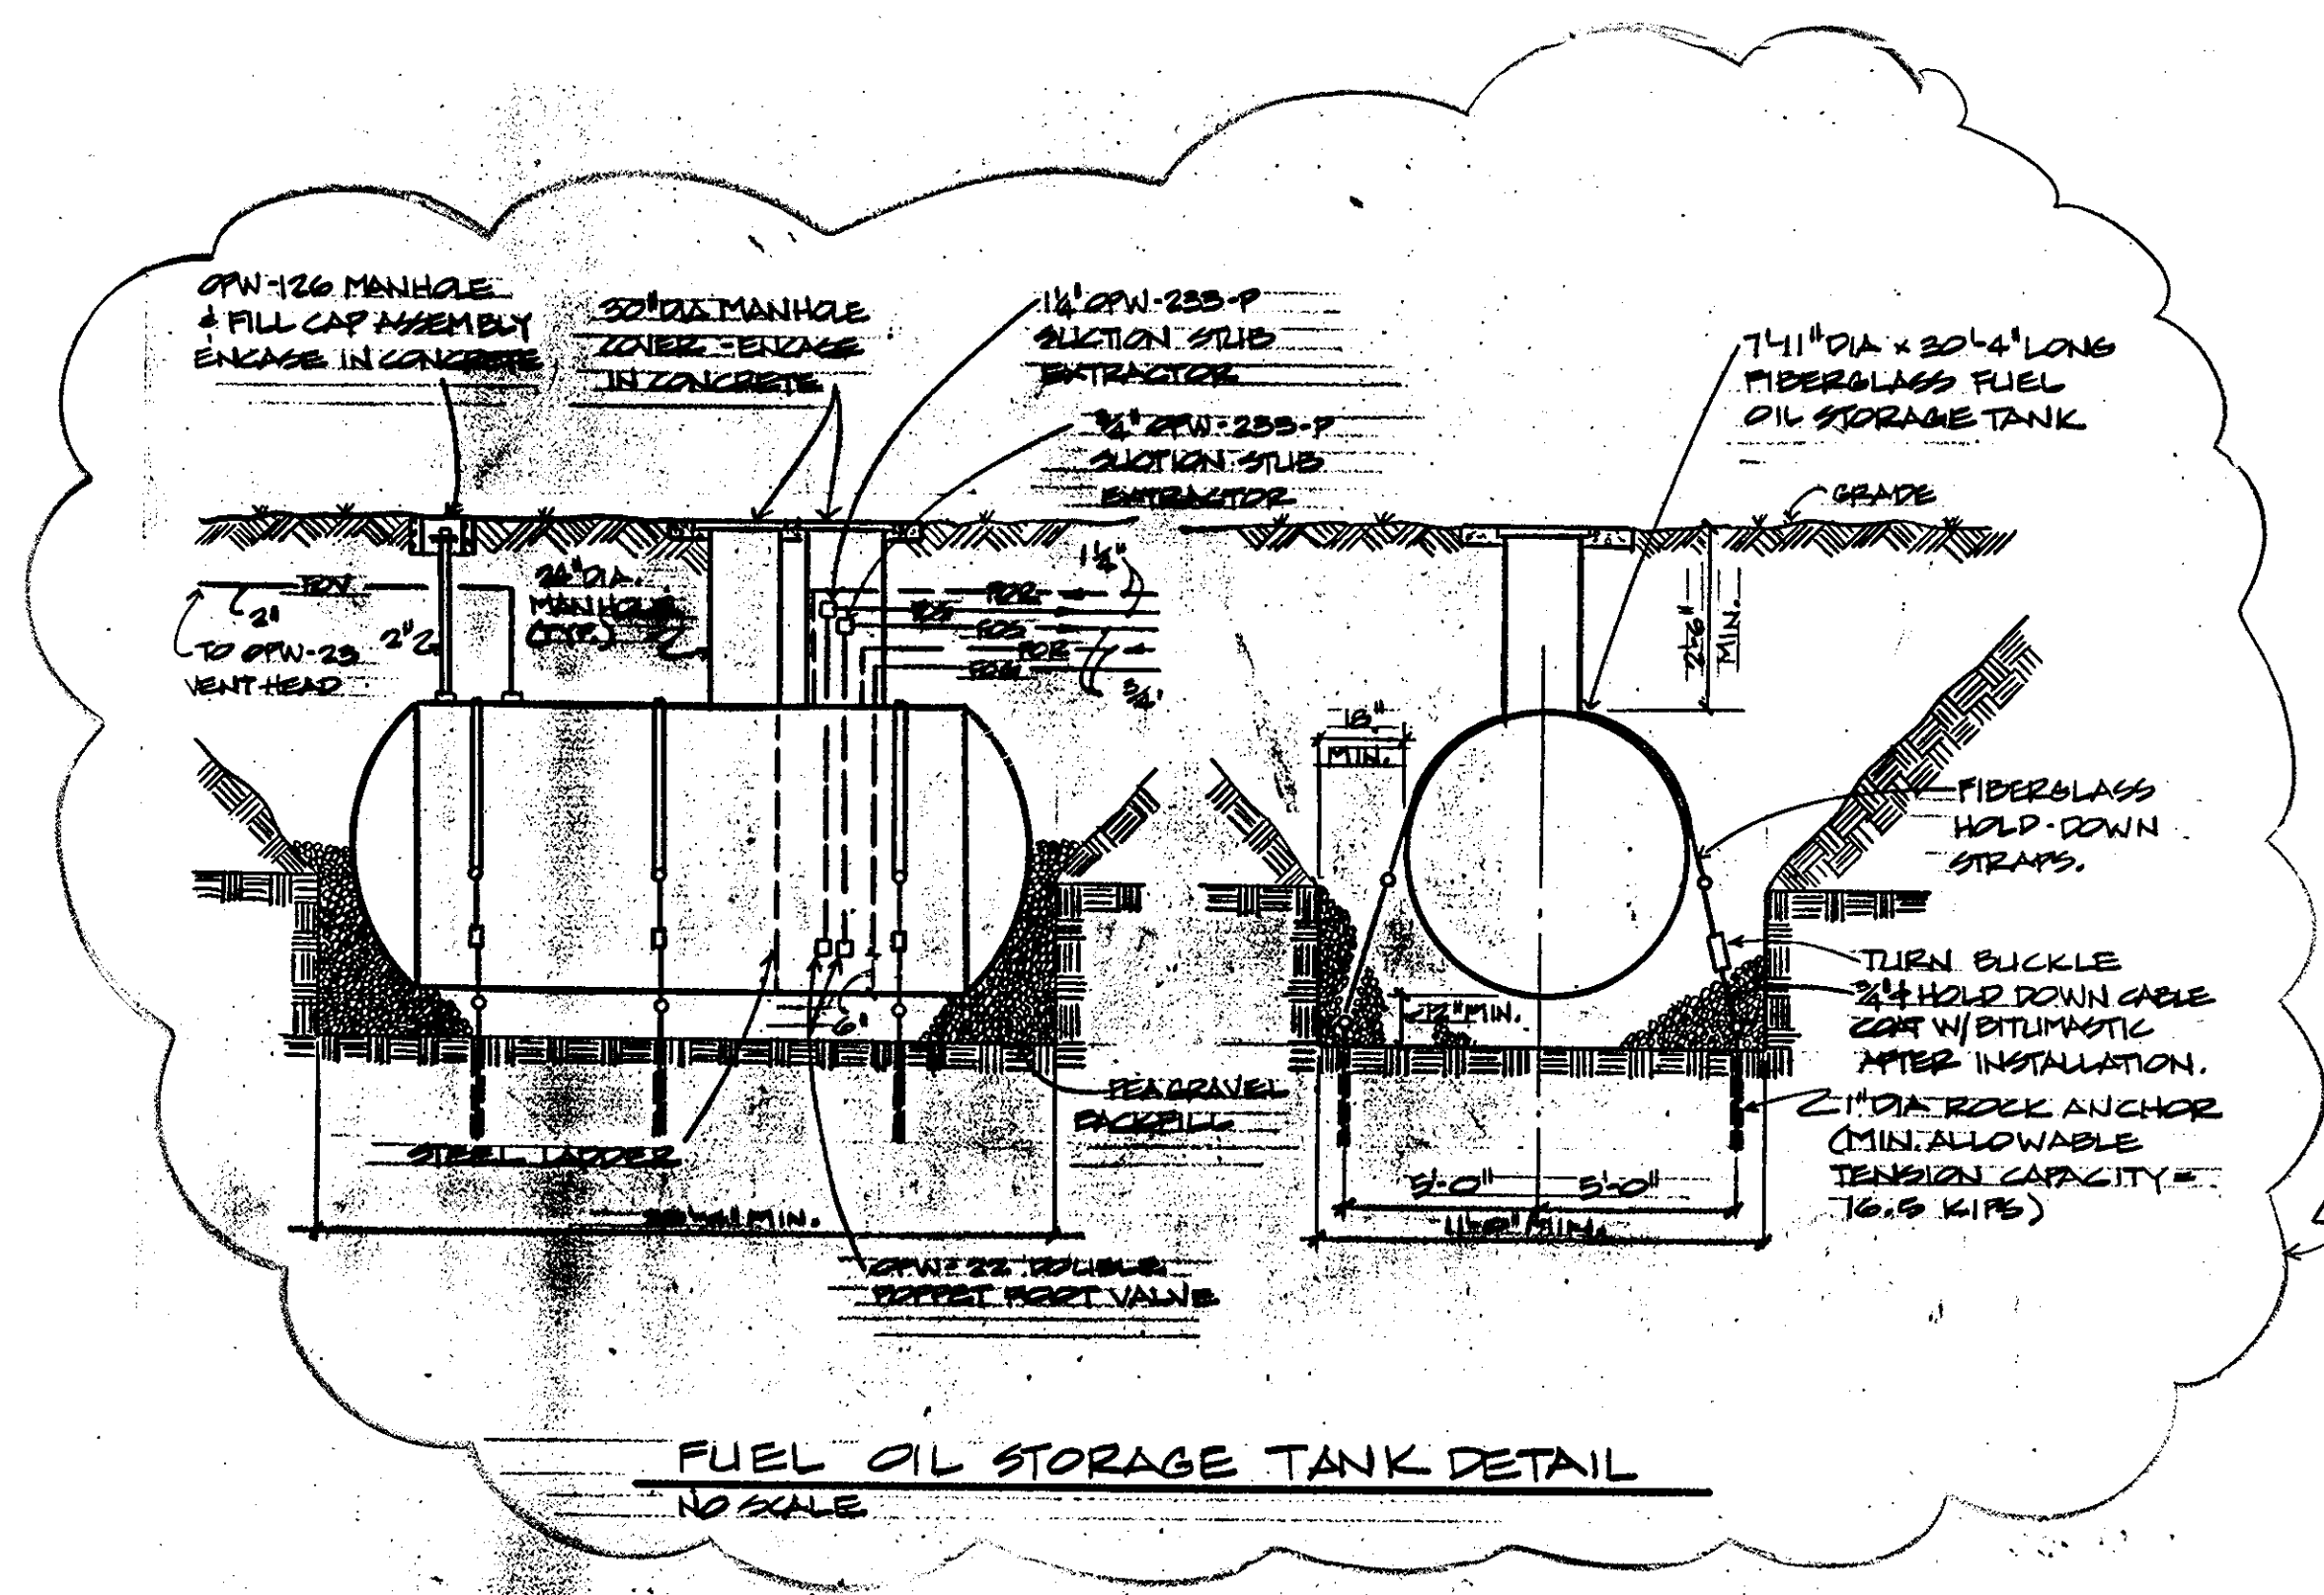

**FUEL OIL STORAGE TANK DETAIL**

NO SCALE

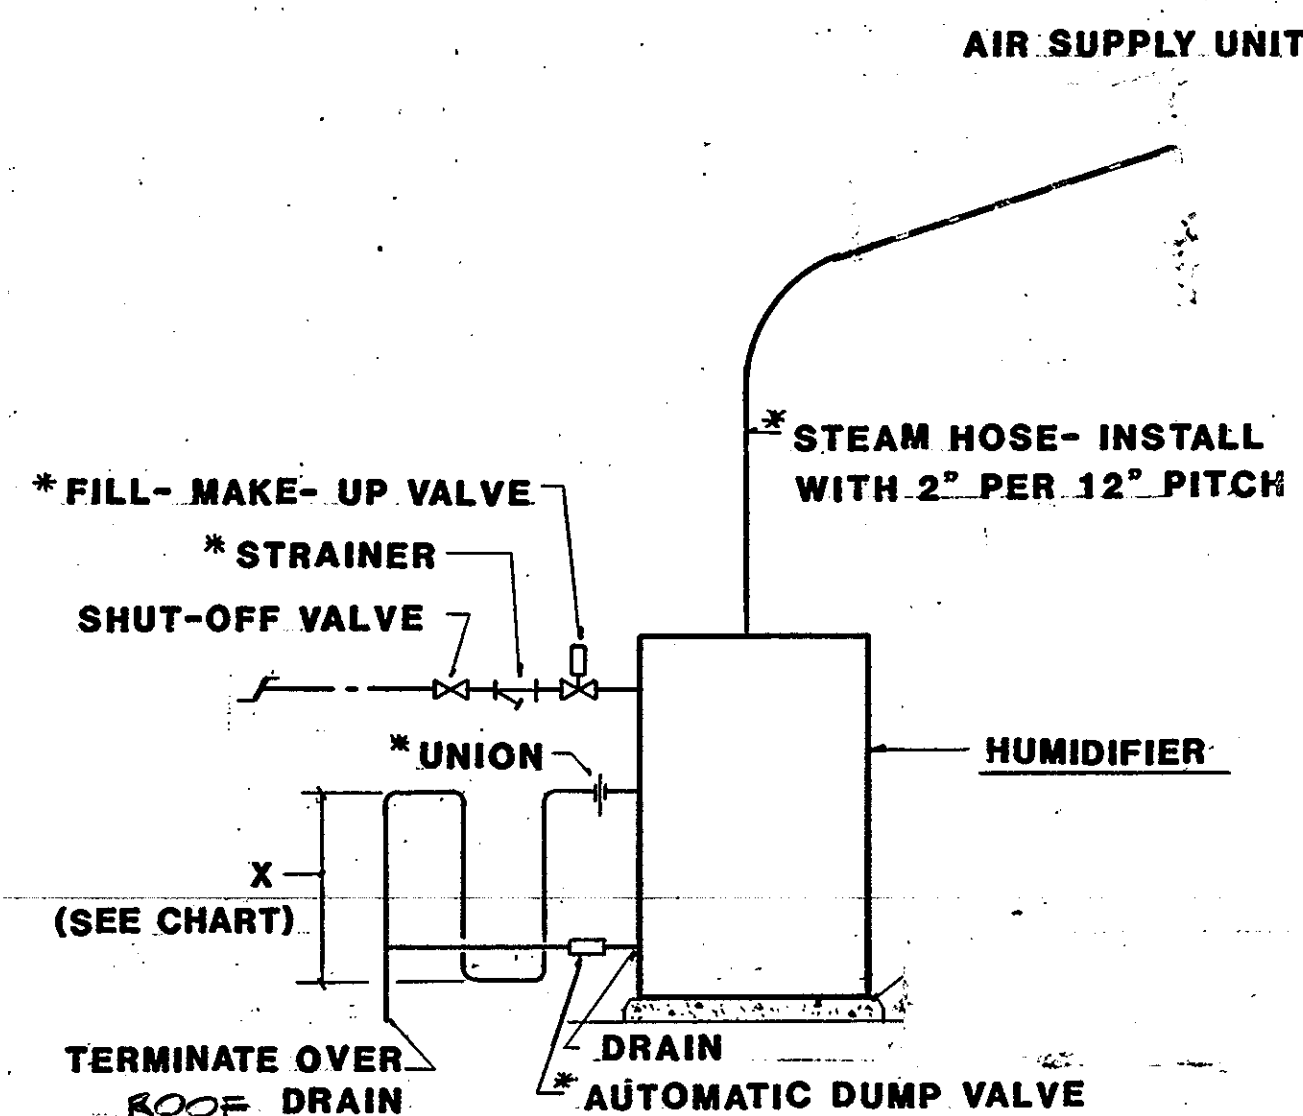


\* FURNISHED WITH HUMIDIFIER  
INSTALLED BY HEATING CONTRACTOR

**HUMIDIFIER PIPING DETAIL**


NOT TO SCALE

DIMENSION X	
H-1	10
H-2	18
H-3	14
H-4	7

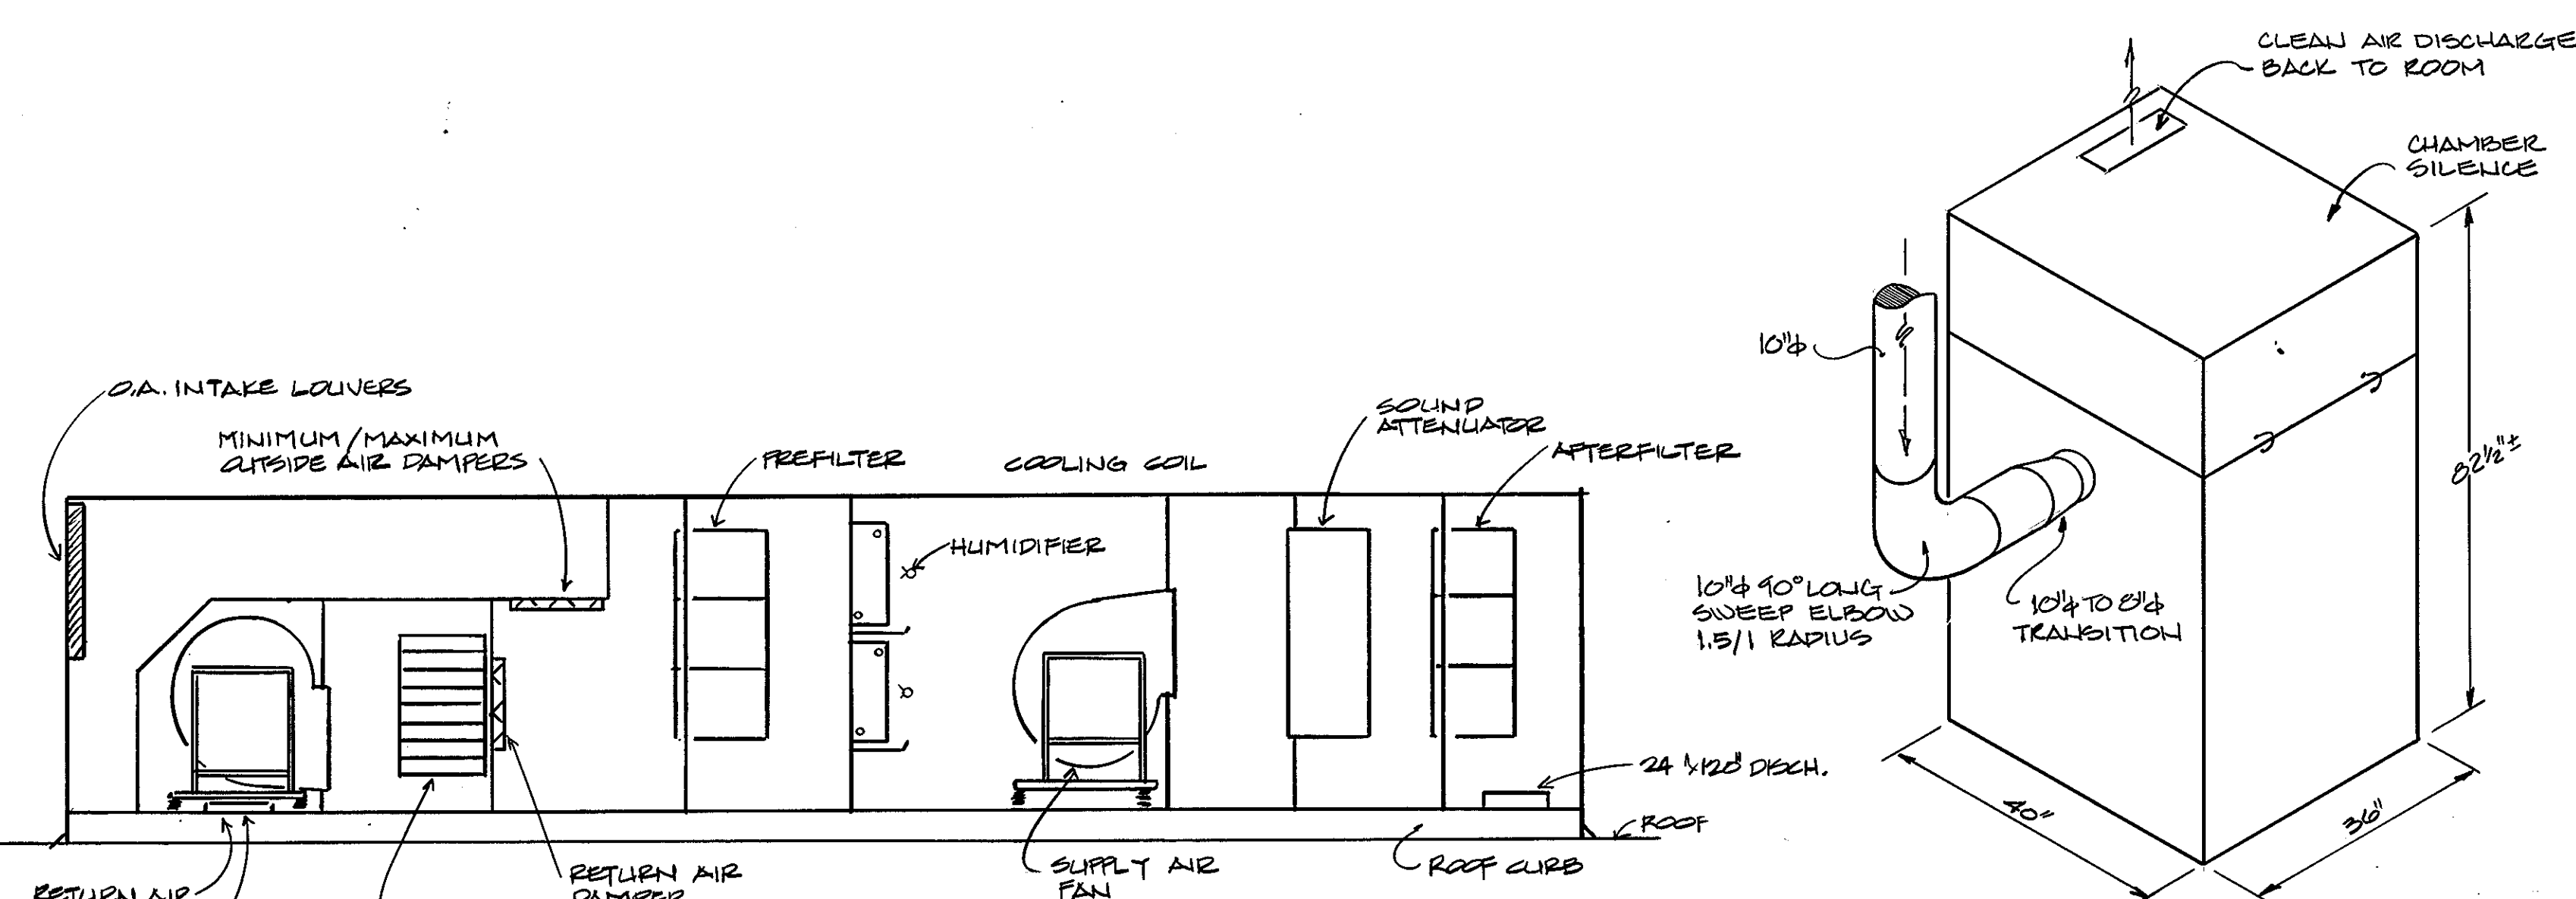


**ASU-4,5,6 DETAIL**

NO SCALE

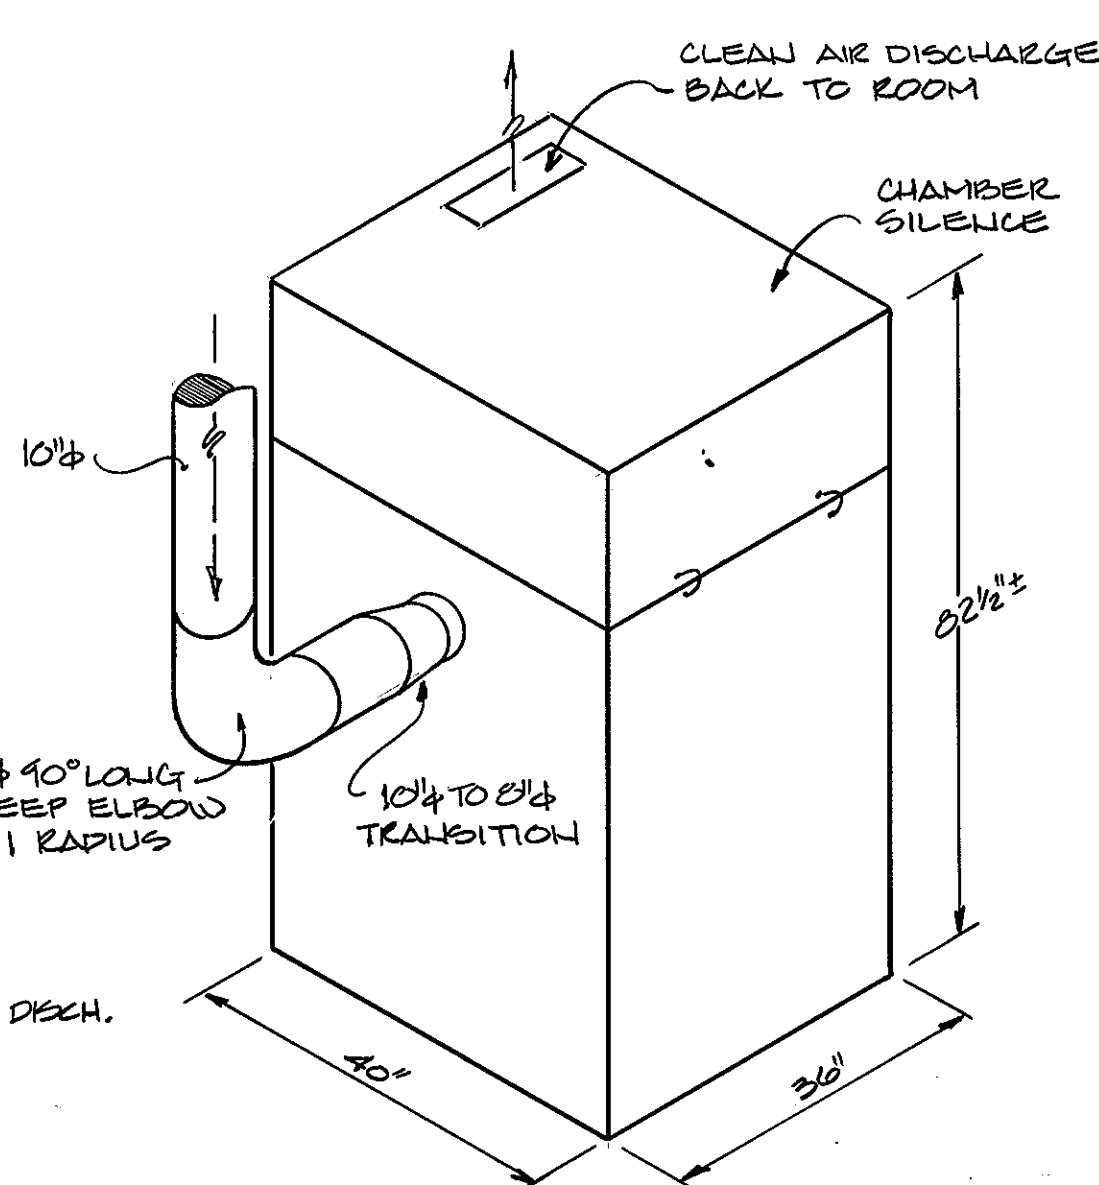

**DUST COLLECTOR DETAIL**

NOT TO SCALE

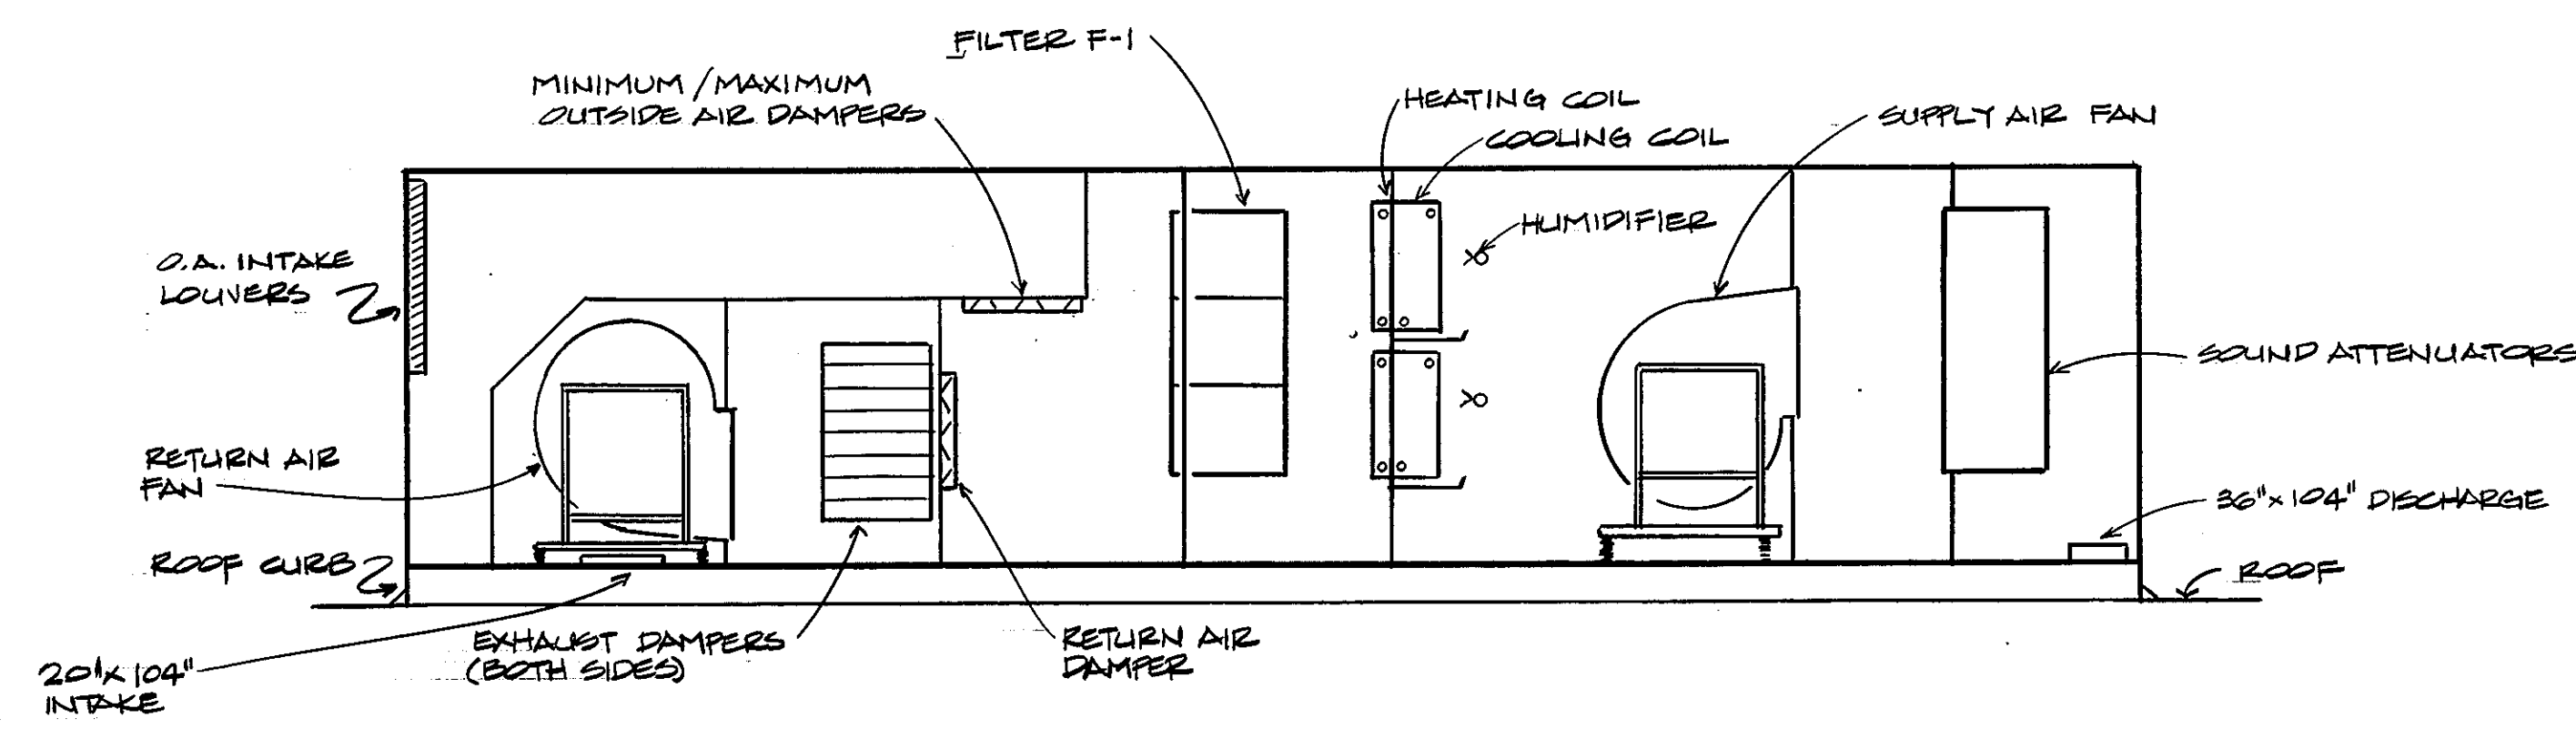

**ASU-1 DETAIL**

NO SCALE

This record drawing has been prepared in part, by Colton/Lester Corporation, based upon information furnished by others. While this information is believed to be reliable, the Engineer cannot assure its accuracy, and thus is not responsible for any errors or omissions which may have been incorporated into it as a result. Those relying on this record document are advised to obtain independent verification of its accuracy before applying it for any purpose

DRAWING TITLE: DETAILS  
SCALE: NONE  
REVISIONS:  
1/24/26  
**RECORD DRAWING**

SHEET NUMBER: M24  
PROJECT NUMBER: 83013  
ISSUE DATE: 6-27-85

THE CHRSINER PARTNERSHIP INC.  
ARCHITECTS AND PLANNERS  
303-824-9707







ARCHITECTS AND PLANNERS  
STONE, MARRACON & PRATERSON  
HEROLDES CONSTRUCTION COMPANY  
COLTON-LESTER CORPORATION  
W. MIT SENTER & ASSOCIATES

DEPARTMENT OF MENAL HEALTH  
PAUL R. ARI, PHD MPA

OFFICE OF ADMINISTRATION  
JOHN ASHCROFT  
GOVERNOR



NEW YORK STATE  
FOR REFERENCE ONLY  
CONVERSION AND CONSTRUCTION OF FARMINGTON STATE COMPLEX

THE CHRSINER PARTNERSHIP INC. ARCHITECTS AND PLANNERS

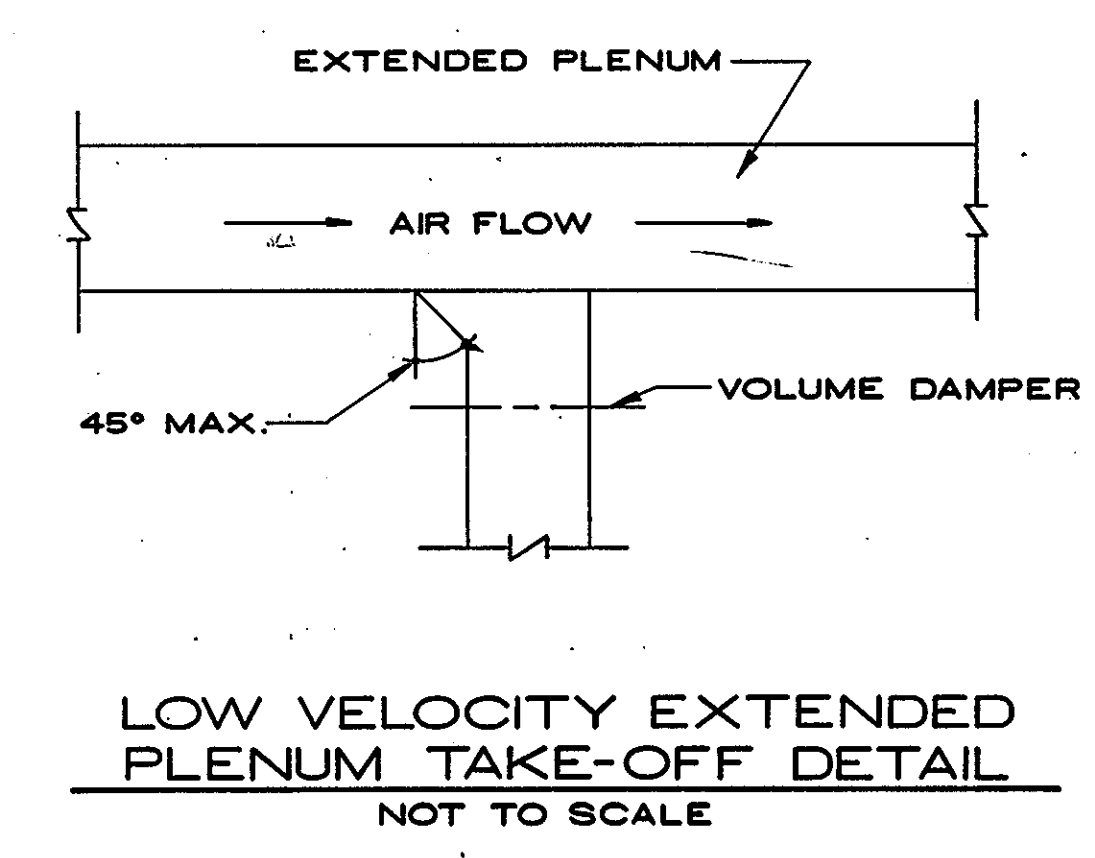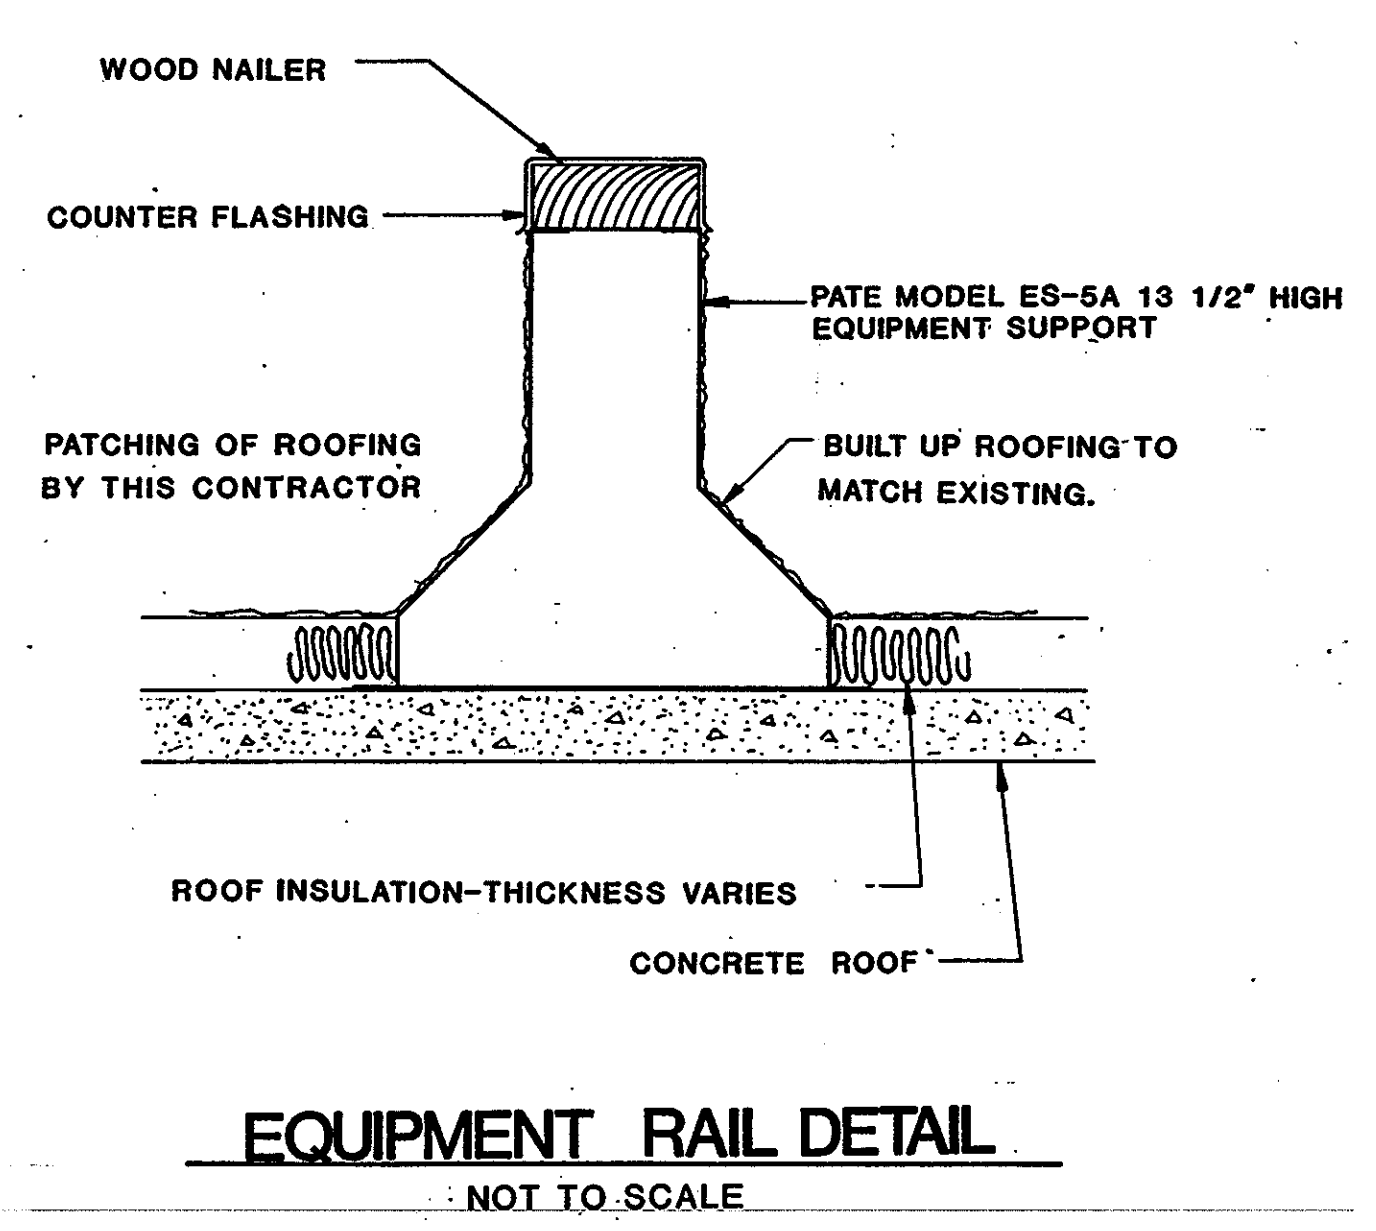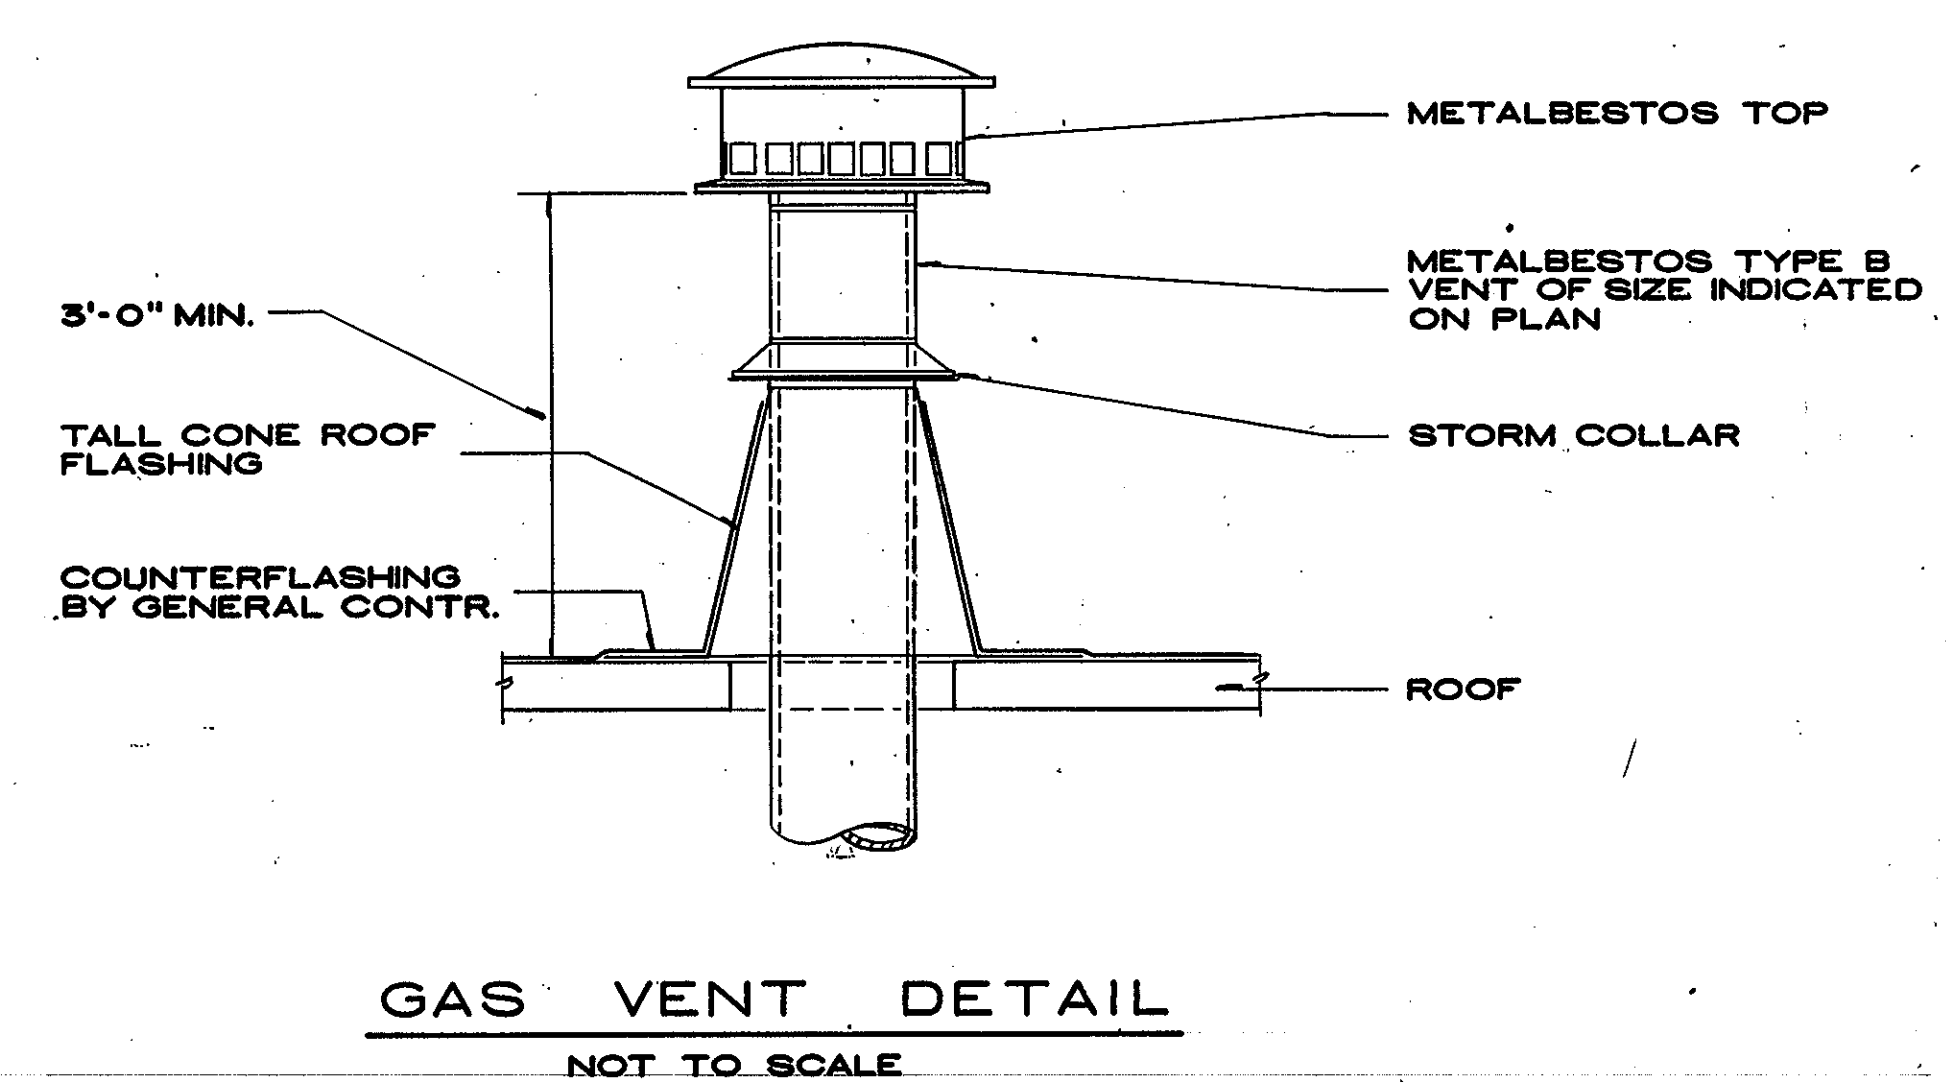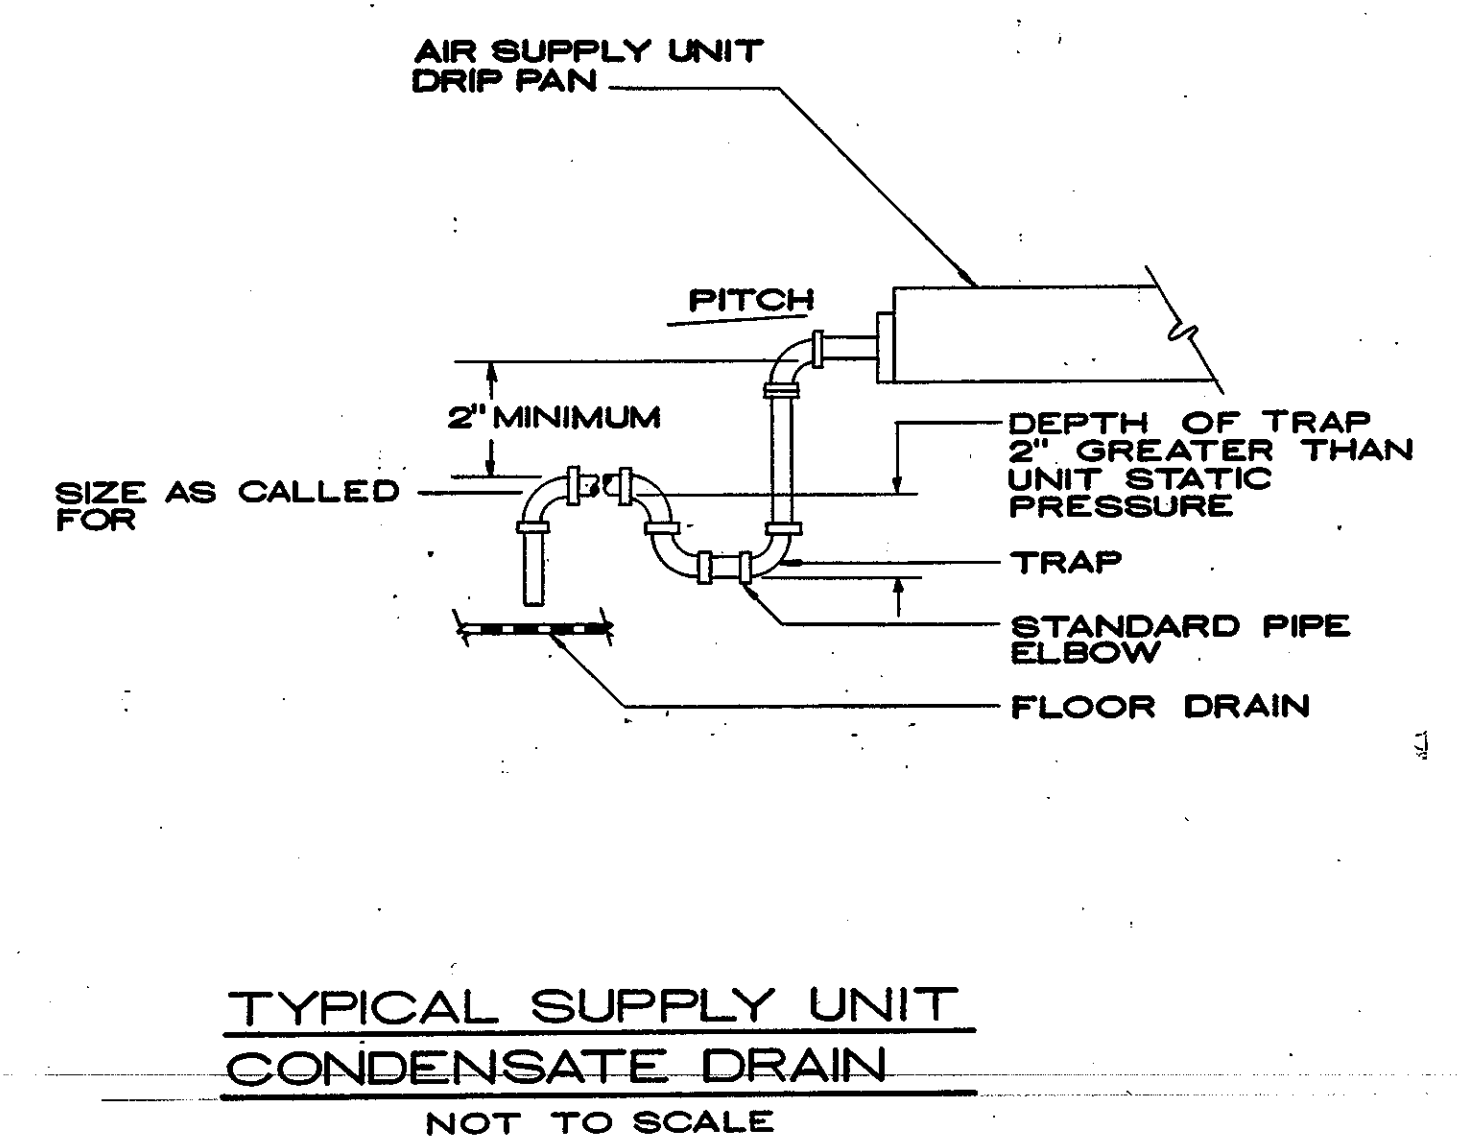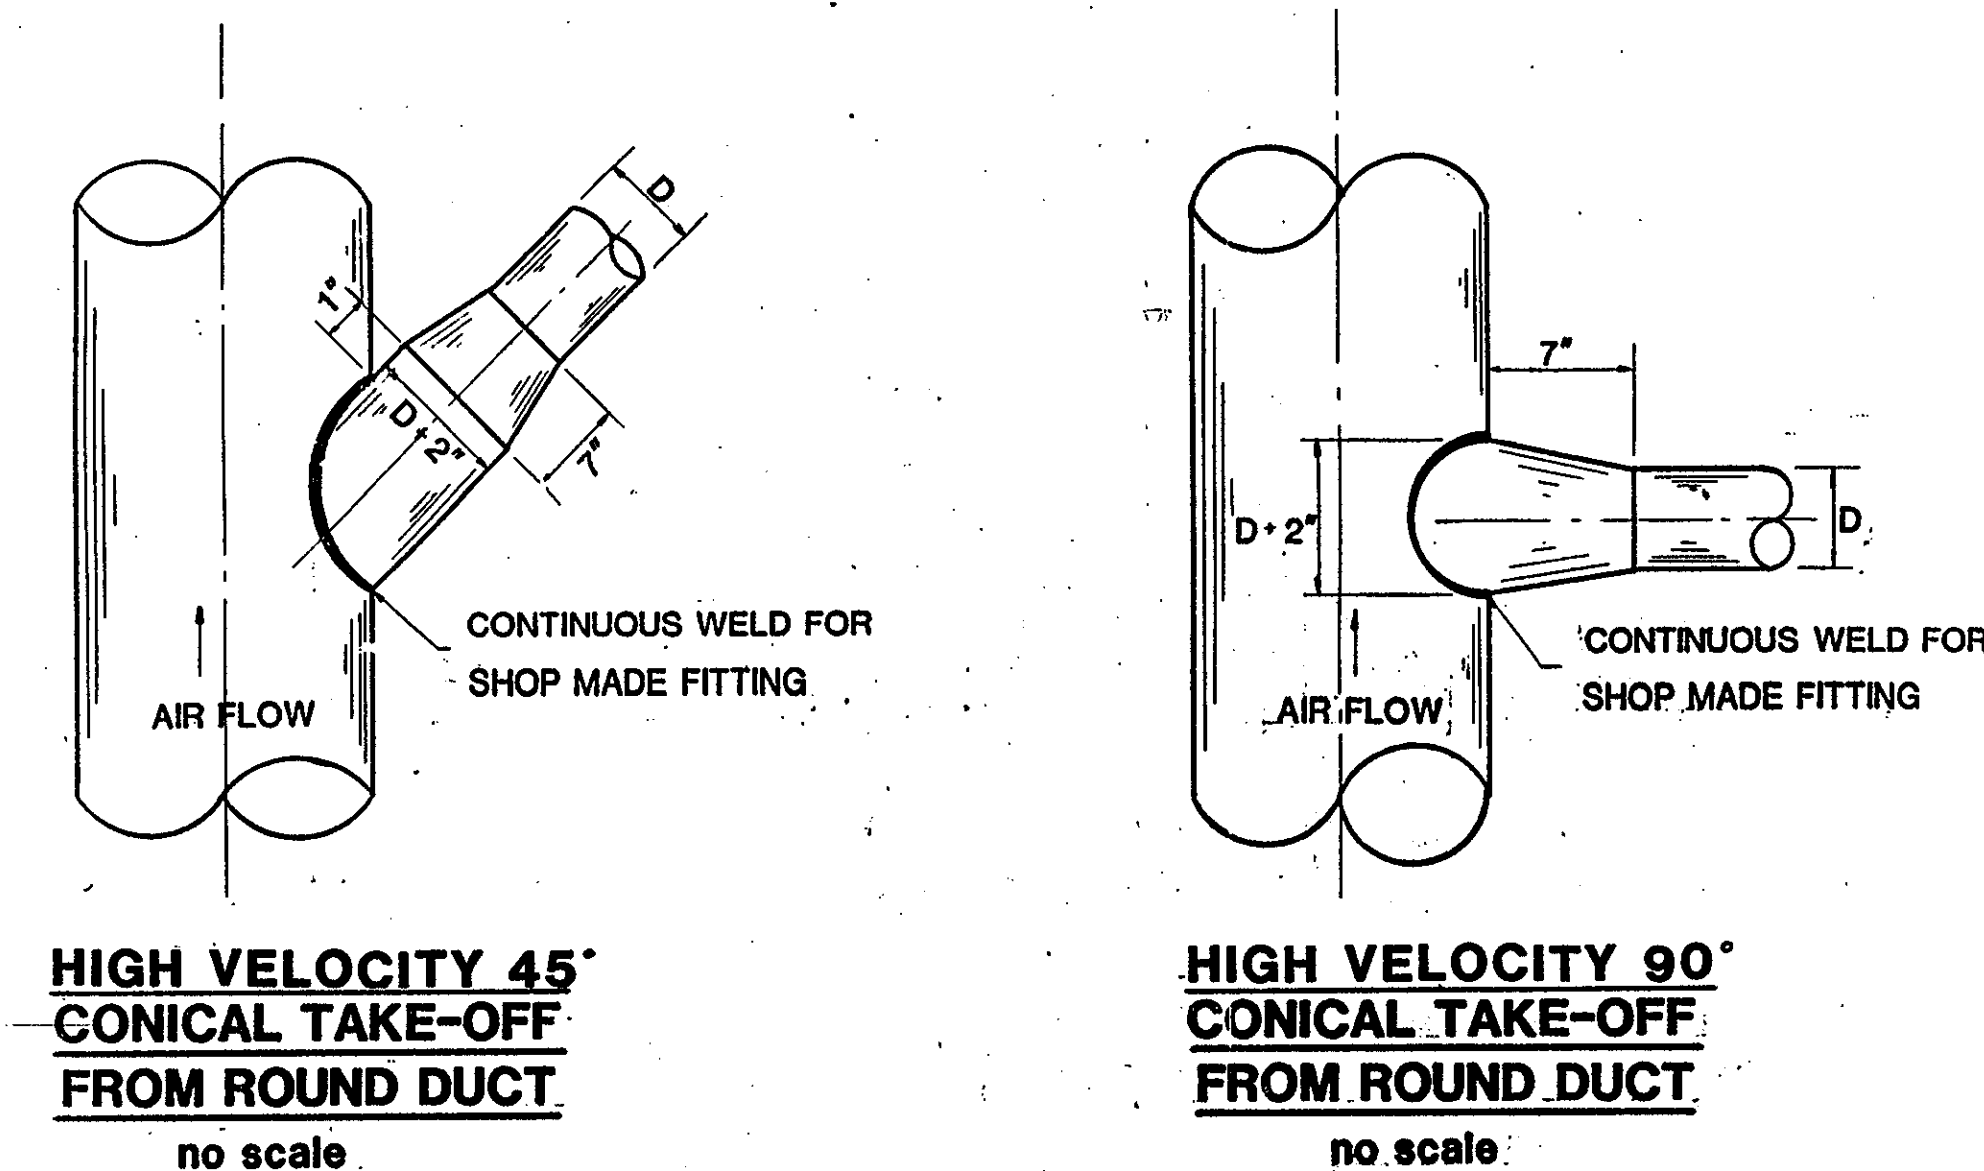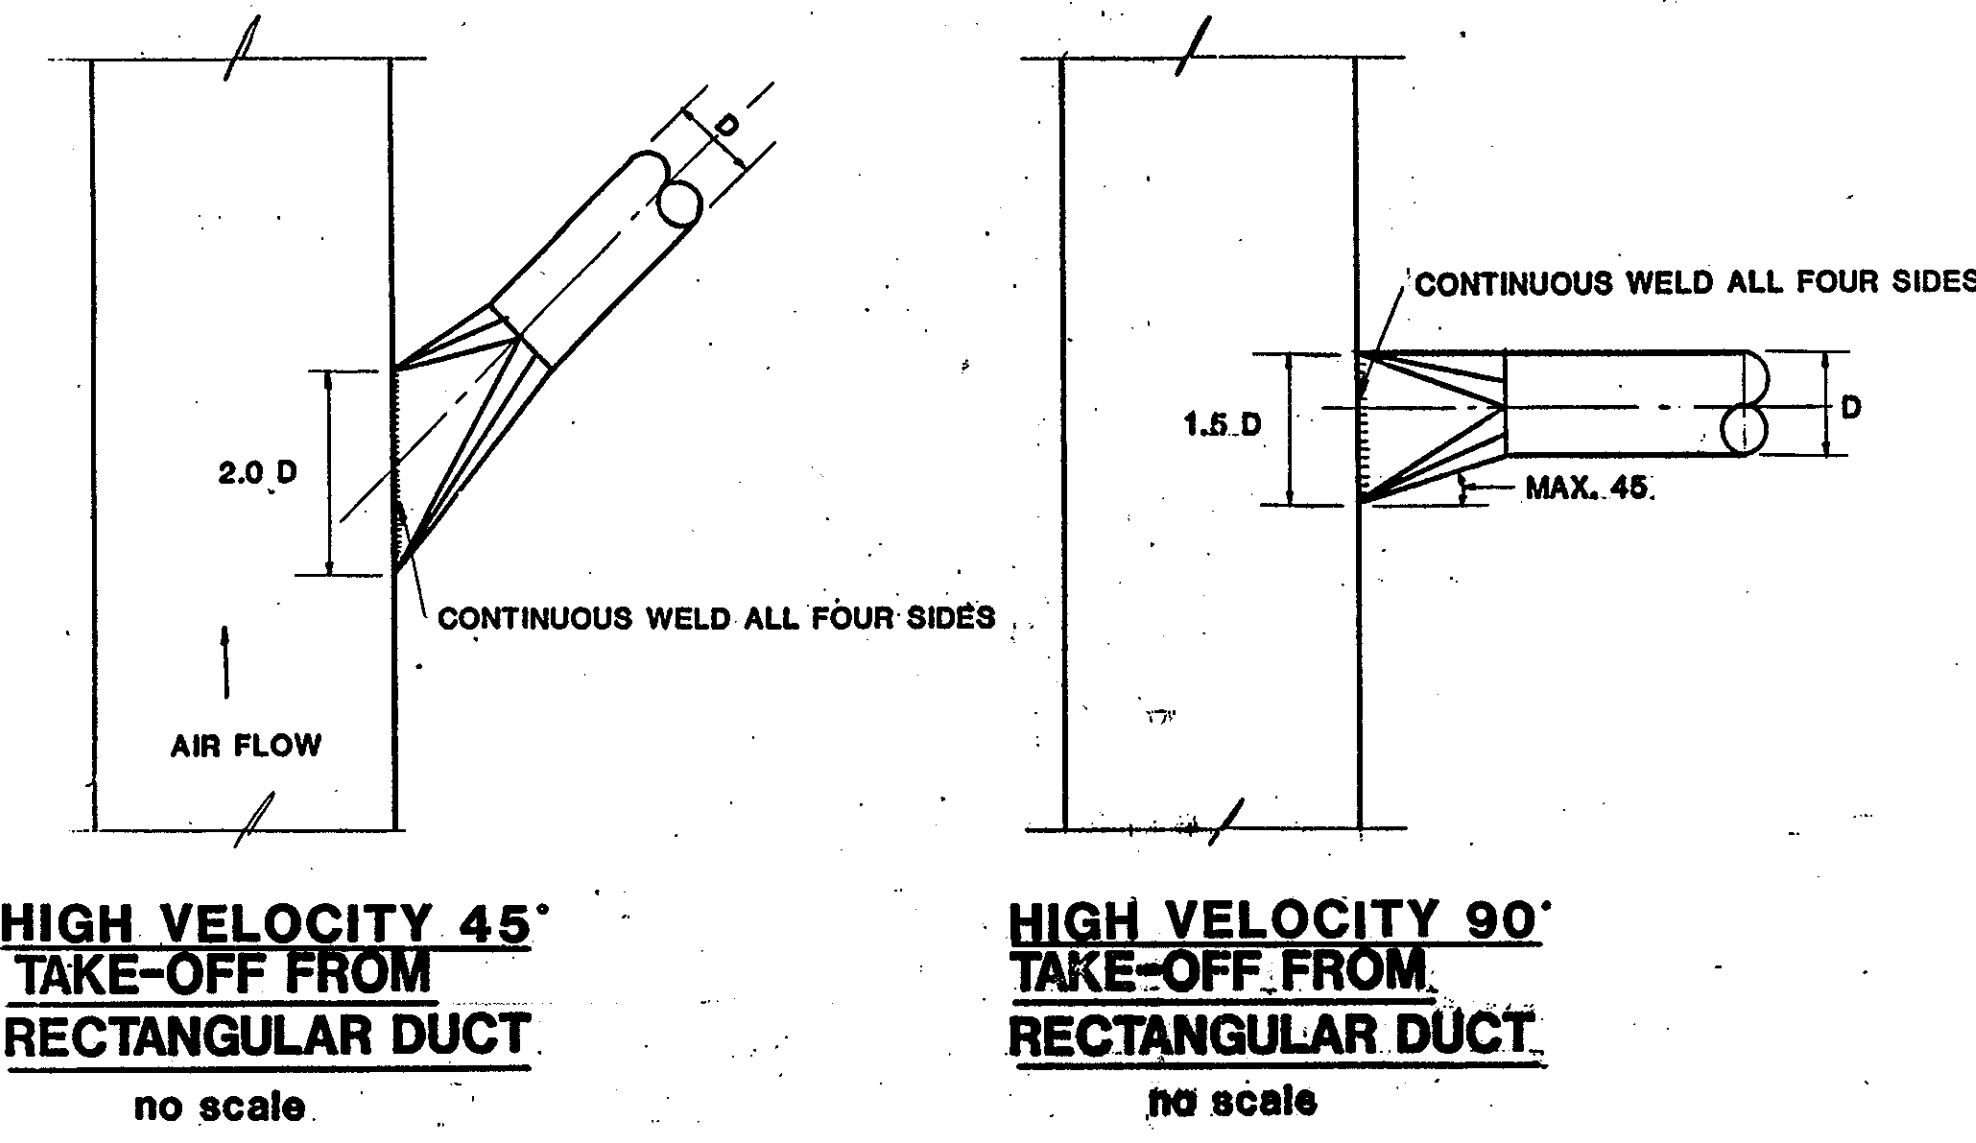

This record drawing has been prepared in part, by Colton/Lester Corporation, based upon information furnished by others. While this information is believed to be reliable, the Engineer cannot assure its accuracy, and thus is not responsible for the accuracy of this record drawing or for any errors or omissions which may have been incorporated into it as a result. Those relying on this record document are advised to obtain independent verification of its accuracy before applying it for any purpose.

DRAWING TITLE: <b>DETAILS</b>	
SCALE: NONE	
REVISIONS:	
<b>RECORD DRAWING</b>	

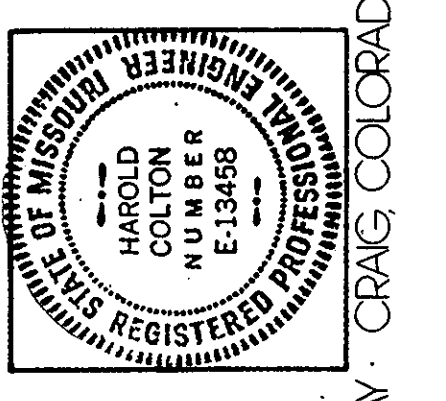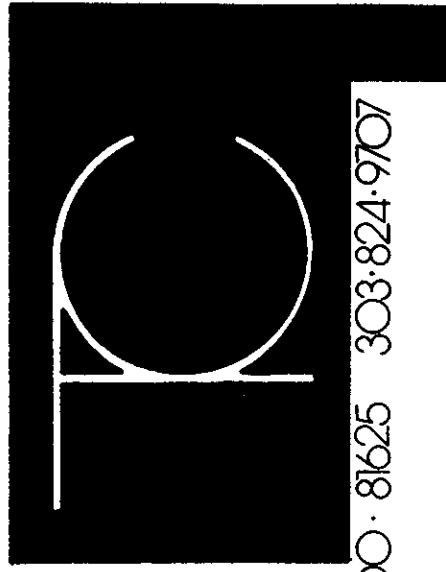

ARCHITECTS AND PLANNERS  
THE CHRSTNER PARTNERSHIP, INC.  
STONE, MARRACINI & PATTERSON  
ARCHITECTURE PLANNING CONSULTING  
PROJECT MANAGERS  
PERICLES CONSTRUCTION COMPANY  
CONSULTING ENGINEERS  
COLTON-LESTER CORPORATION  
FOOD SERVICE CONSULTANTS  
W. MITCHELL & ASSOCIATES

DEPARTMENT OF MENTAL HEALTH  
OFFICE OF ADMINISTRATION  
DIVISION OF DESIGN & CONSTRUCTION  
ACTING DIRECTOR  
*Paul R. Ayr*  
PAUL R. AYR, PH.D. M.P.A.

STATE OF MISSOURI  
GOVERNOR  
*John Ashcroft*  
JOHN ASHCROFT  
GOVERNOR

**NEW! AVAILABLE IN DIGITAL FORM**  
**FOR REFERENCE ONLY**  
FARMINGTON, MISSOURI  
CONVERSION AND CONSTRUCTION OF FARMINGTON STATE COMPLEX  
STATE PROJECT NUMBER: 00-055-27-0001(E)

SHEET NUMBER:  
**M25**  
PROJECT NUMBER:  
83013  
ISSUE DATE:  
6-27-85

THE CHRSTNER PARTNERSHIP, INC. ARCHITECTS AND PLANNERS, 20 SOUTH HAWLEY RD., CLAYTON, MISSOURI 63105 314.725.2927 - 11 W. VICTORY WAY, CRAIG, COLORADO 81625 303-824-9707