

REPLACE COOLING TOWERS

SAINT LOUIS FORENSIC TREATMENT CENTER - NORTH

SAINT LOUIS, MISSOURI

OWNER: STATE OF MISSOURI
MICHAEL L. PARSON,
GOVERNOR

DEPARTMENT OF
OFFICE OF ADMINISTRATION

DESIGNER: BERNHARD TME
Mechanical / Plumbing / Electrical

PROJECT NUMBER: M2015-01

PROJECT MANAGEMENT: OFFICE OF ADMINISTRATION
DIVISION OF FACILITIES MANAGEMENT,
DESIGN AND CONSTRUCTION

SITE NUMBER: 7391
ASSET NUMBER: 6517391002

STATE OF MISSOURI
MICHAEL L. PARSON,
GOVERNOR

These design drawings have been altered to indicate as-built information supplied by the construction contractor. The Engineer-of-Record is not responsible for the accuracy of said information. A record of as-designed drawings are maintained by the Owner.

Bernhard TME
Engineering

BERNHARD TME ENGINEERING
622 Emerson Road, Suite 250
St. Louis, MO 63141 • 314-727-8760
MO Certificate of Authority No. 2009021478



OFFICE OF ADMINISTRATION
DIVISION OF FACILITIES
MANAGEMENT,
DESIGN AND CONSTRUCTION

DEPARTMENT OF
MENTAL HEALTH

REPLACE COOLING TOWERS
SAINT LOUIS FORENSIC
TREATMENT CENTER - NORTH
SAINT LOUIS, MISSOURI

PROJECT # M2015-01
SITE # 7391
ASSET # 6517391002

REVISION: _____
DATE: _____
REVISION: _____
DATE: _____
REVISION: _____
DATE: _____
ISSUE DATE: 02/14/2023

CAD DWG FILE: M2015-01 G-001.DWG
DRAWN BY: JBM
CHECKED BY: EGU
DESIGNED BY: NJS

SHEET TITLE:

COVER SHEET

SHEET NUMBER:

G-001

SHEET 1 OF 15
FEBRUARY 14, 2023

DRAWING SET - SHEET LIST INDEX

GENERAL:

G-001 COVER SHEET / SHEET LIST INDEX

MECHANICAL SHEETS:

M-001 SYMBOLS AND ABBREVIATION

MD-101 PARTIAL ROOF PLAN - COOLING TOWER DEMOLITION
MD-102 PARTIAL FIRST FLOOR PLAN - MAIN MECHANICAL DEMOLITION

MD-201 CONDENSER WATER DEMOLITION FLOW DIAGRAM

M-101 PARTIAL ROOF PLAN - COOLING TOWER NEW WORK
M-102 PARTIAL FIRST FLOOR PLAN - MAIN MECHANICAL NEW WORK

M-201 MODIFIED CONDENSER WATER FLOW DIAGRAM
M-202 CONDENSER WATER POINTS LIST SCHEDULE
M-203 SCHEDULES AND DETAILS

ELECTRICAL SHEETS:

E-001 SYMBOLS AND ABBREVIATION

ED-101 PARTIAL ROOF PLAN - COOLING TOWER DEMOLITION
ED-102 PARTIAL FIRST FLOOR PLAN - MAIN MECHANICAL DEMOLITION

E-101 PARTIAL ROOF PLAN - COOLING TOWER NEW WORK
E-102 PARTIAL FIRST FLOOR PLAN - MAIN MECHANICAL NEW WORK

PLUMBING SYMBOLS

SAN		SANITARY SEWER BELOW GRADE
SAN		SANITARY SEWER ABOVE GRADE
ST		STORM SEWER BELOW GRADE
ST		STORM SEWER ABOVE GRADE
		SLOPE IN DIRECTION OF ARROW (SEE PLANS FOR % OF SLOPE)
V		VENT
CW		COLD WATER
HW		HOT WATER
HWC		HOT WATER CIRCULATING

MECHANICAL SYMBOLS AND ABBREVIATIONS

ABV	ABOVE	GPM	GALLONS PER MINUTE
AD	ACCESS DOOR	GV	GAUGE VALVE
AFF	ABOVE FINISHED FLOOR	HGR	HANGER
AHU	AIR HANDLING UNIT	HOA	HAND OFF AUTO
ALT	ALTERNATE	HP	HORSEPOWER
AP	ACCESS PANEL	HTG	HEATING
APPROX	APPROXIMATE	HWR	HEATING WATER RETURN
AS	AIR SEPARATOR	HWS	HEATING WATER SUPPLY
AUTO	AUTOMATIC	HX	HEAT EXCHANGER
AV	AIR VENT	ID	INSIDE DIAMETER
BHP	BRAKE HORSEPOWER	LAT	LEAVING AIR TEMPERATURE
BLDG	BUILDING	LWT	LEAVING WATER TEMPERATURE
BM	BEAM	MAX	MAXIMUM
BOD	BOTTOM OF DUCT	MBH	BTU x 1000
BOP	BOTTOM OF PIPE	MPC	MECHANICAL PIPE COUPLING
BOT	BOTTOM	MECH	MECHANICAL
BSMT	BASEMENT	MIN	MINIMUM
BTU	BRITISH THERMAL UNIT	NC	NORMALLY CLOSED
BTUH	BRITISH THERMAL UNIT PER HOUR	NIC	NOT IN CONTRACT
BV	BALANCE VALVE	NO	NORMALLY OPEN
CF	CHEMICAL FEED	NOM	NOMINAL
CH	CHILLER	NTS	NOT TO SCALE
CHV	CHECK VALVE	OPNG	OPENING
CLG	CEILING	P	PUMP
COM	COMMON	PD	PRESSURE DROP
CONC	CONCRETE	PR	PRESSURE REGULATOR
COND	CONDENSATE	PRV	PRESSURE REDUCING VALVE
CWR	CONDENSER WATER RETURN	R	REDUCER
CWS	CONDENSER WATER SUPPLY	RA	RETURN AIR
CT	COOLING TOWER	REQD	REQUIRED
CTE	CONNECT TO EXISTING	REV	REVISION
CV	CONTROL VALVE	RF	RETURN FAN
CHWR	CHILLED WATER RETURN	RH	RELATIVE HUMIDITY
CHWS	CHILLED WATER SUPPLY	RM	ROOM
DDC	DIRECT DIGITAL CONTROL	RPM	REVOLUTIONS PER MINUTE
DIA	DIAMETER	RTU	ROOF TOP UNIT
DIS	DISCHARGE	RV	RELIEF VALVE
DN	DOWN	SEC	SECTION
DP	DIFFERENTIAL PRESSURE	SP	STATIC PRESSURE
DR	DRAIN LINE	SPEC	SPECIFICATIONS
DV	DRAIN VALVE	STR	STRAINER
DWG	DRAWING	SUC	SUCTION
EAT	ENTERING AIR TEMPERATURE	SUD	SUCTION DIFFUSER
EC	ELECTRIC CONTRACTOR	SV	SERVICE VALVE
EF	EXHAUST FAN	T	THERMOSTAT
EFF	EFFICIENCY	TB	TESTING AND BALANCING
EQUIP	EQUIPMENT	TH	THERMOMETER
EWT	ENTERING WATER TEMPERATURE	TSP	TOTAL STATIC PRESSURE
ET	EXPANSION TANK	TW	THERMOMETER WELL
EX	EXISTING	TYP	TYPICAL
EXH	EXHAUST AIR	U	UNIT HEATER
F	FLANGE CONNECTION	VFD	VARIABLE FREQUENCY DRIVE
F	DEGREE FAHRENHEIT	WTR	WATER
FC	FLEXIBLE CONNECTION	w/	WITH
FLR	FLOOR	w/o	WITHOUT
FRD	FIRE RATED DAMPER		

	EXISTING EQUIPMENT, DUCTWORK OR PIPING
	EXISTING EQUIPMENT, DUCTWORK OR PIPING TO BE REMOVED
	NEW EQUIPMENT, DUCTWORK OR PIPING
	CONNECT TO THE EXISTING EQUIPMENT DESIGNATION (CONTRACTOR SHALL FIELD VERIFY SIZE INDICATED)
	KEYED NOTE DESIGNATION
	DEMOLITION KEYED NOTE DESIGNATION
	EQUIPMENT TYPE
	EQUIPMENT DESIGNATION
	EQUIPMENT NUMBER

CWS		CWS	CONDENSER WATER SUPPLY
CWR		CWR	CONDENSER WATER RETURN
CHWS		CHWS	CHILLED WATER SUPPLY
CHWR		CHWR	CHILLED WATER RETURN
DR		DR	GRAVITY DRAIN PIPE
HWS		HWS	HEATING WATER SUPPLY
HWR		HWR	HEATING WATER RETURN
BV			BALANCE VALVE
CHV			CHECK VALVE
CV			TWO WAY CONTROL VALVE
3-CV			THREE WAY CONTROL VALVE
F			FLANGE CONNECTION OR BLIND FLANGE
FM			PIPE FLOW METER
MC			MECHANICAL PIPE COUPLING
PF			PIPE FLEX CONNECTION
PR			PRESSURE REGULATING VALVE
PRV			PRESSURE REDUCING VALVE
ER			ECCENTRIC PIPE REDUCER
R			PIPE REDUCER
STR			STRAINER
ST			STEAM TRAP
SV			SERVICE VALVE
TV			TRIPLE DUTY VALVE
AV			PIPE AIR VENT
CAP			PIPE CAP
DV			DRAIN VALVE
FL			DIRECTION OF FLOW IN PIPE
GA			GAUGE WITH GAUGE VALVE
GV			GAUGE VALVE
RBPB			REDUCED PRESSURE BACKFLOW PREVENTER
RV			RELIEF VALVE
U			UNION
TH			THERMOMETER
TH			THERMOMETER WELL
DN			PIPE LINE, TURNED DOWN
UP			PIPE LINE, TURNED UP
			PIPE RUNOUT OFF THE BOTTOM
			PIPE RUNOUT OFF THE TOP
			PUMP SYMBOL
			PUMP SYMBOL w/ SUCTION DIFFUSER

GENERAL DEMOLITION AND NEW WORK NOTES:

- REMOVE EQUIPMENT, PIPING AND DUCTWORK AS INDICATED INCLUDING HANGERS, RODS, BRACKETS, ANCHOR BOLTS, SEISMIC BRACES AND CABLES AND OTHER ASSOCIATED SUPPORTS, BASES, ACCESSORIES AND SPECIALTIES.
- CAP ALL OPEN ENDS OF EXISTING PIPE THAT REMAIN IN SERVICE. WHERE PIPING IS REMOVED TO EXISTING SERVICE VALVES, CAP SERVICE VALVES USING CAP, PLUGS, OR BLIND FLANGES.
- PATCH HOLES IN WALLS AND PARTITIONS WHERE PIPING AND DUCTWORK ARE REMOVED. WALL AND PARTITION PATCHES SHALL MATCH EXISTING CONSTRUCTION AND FIRE RATING INCLUDING LEVEL OF SURFACE FINISH. PATCH CLAY TILE AND BRICK WALLS, FULL THICKNESS WITH BRICK AND/OR MASONRY PRODUCTS. PATCHES EXPOSED TO VIEW SHALL BE PATCHED TO MATCH SURROUNDINGS.
- PATCH HOLES IN FLOOR WHERE PIPING AND DUCTWORK ARE REMOVED. PROVIDE CONCRETE OR GROUT INFILL WITH REINFORCING STEEL. PROVIDE FORMS AS REQUIRED. SURFACE FINISH AND FIRE RATING SHALL MATCH EXISTING SURROUNDINGS.
- THE PLANS INDICATE, GENERALLY, THE DESIGN AND ARRANGEMENT OF DUCTWORK, PIPING, EQUIPMENT, AND ACCESSORIES, AND ARE DIAGRAMMATIC IN NATURE. THE EXACT LOCATION OF THESE ITEMS IS SUBJECT TO CHANGE DUE TO FIELD CONDITIONS WHICH SHALL BE VERIFIED BY THE CONTRACTOR. IF REQUIRED, THESE CHANGES SHALL BE MADE IN COMPLIANCE WITH THE INTERNATIONAL PLUMBING AND MECHANICAL CODES, AND WITHOUT ADDITIONAL COST TO THE OWNER.
- EQUIPMENT SHALL BE INSTALLED, AND ADEQUATE CLEARANCES FOR MAINTENANCE AND REPLACEMENT SHALL BE PROVIDED, IN ACCORDANCE WITH THE MANUFACTURERS INSTALLATION INSTRUCTIONS AND RECOMMENDATIONS.
- IT IS THE CONTRACTOR'S RESPONSIBILITY TO LOCATE SHUT-OFF VALVES REQUIRED FOR TIE-INS AND TO ISOLATE AND DRAIN PIPING TO BE DEMOLISHED. THE SHUT-OFF DATE AND DURATION OF SHUT-OFF PERIOD SHALL BE APPROVED BY OWNER PRIOR TO SHUT OFF.
- CONTRACTOR SHALL PROTECT ALL EXISTING FLOOR, WALL AND CEILING SURFACES IN AREAS OF WORK AND EQUIPMENT AND PERSONNEL ACCESS. CONTRACTOR SHALL PROVIDE PLASTIC FLOOR PROTECTION FILM AND MASONITE RIGID BOARDS FOR FINISHED FLOOR IN AREAS OF WORK AND ACCESS INCLUDING CORRIDORS AND TOILETS. CONTRACTOR SHALL REPAIR OR REPLACE DAMAGED FLOOR, WALL AND CEILING SURFACES AND BUILDING COMPONENTS.
- CONTRACTOR SHALL PATCH EXISTING FIRE RESISTIVE MATERIAL WHERE HANGERS, BRACKETS, SUPPORTS, CLIPS, ANCHORS, EQUIPMENT, WALLS, ETC. ARE REMOVED OR INSTALLED AS PART OF THIS PROJECT. FIRE RESISTIVE MATERIAL SHALL BE COMPATIBLE AND OF EQUAL FIRE RATED PROTECTION AND THICKNESS OF EXISTING MATERIAL.
- MAINTAIN MINIMUM ELECTRICAL CLEARANCES ABOVE AND IN FRONT OF ALL ELECTRICAL PANELS AND EQUIPMENT. SEE ELECTRICAL PLANS.

STATE OF MISSOURI MICHAEL L. PARSON, GOVERNOR

These design drawings have been altered to indicate as-built information supplied by the construction contractor. The Engineer-of-Record is not responsible for the accuracy of said information. A record of as-designed drawings are maintained by the Owner.



BERNHARD TME ENGINEERING
622 Emerson Road, Suite 250
St. Louis, MO 63141 • 314-727-8760
MO Certificate of Authority No. 2009021478



OFFICE OF ADMINISTRATION DIVISION OF FACILITIES MANAGEMENT, DESIGN AND CONSTRUCTION DEPARTMENT OF MENTAL HEALTH

REPLACE COOLING TOWERS
SAINT LOUIS FORENSIC
TREATMENT CENTER - NORTH
SAINT LOUIS, MISSOURI

PROJECT # M2015-01
SITE # 7391
ASSET # 6517391002

REVISION: _____
DATE: _____
REVISION: _____
DATE: _____
REVISION: _____
DATE: _____
ISSUE DATE: 02/14/2023

CAD DWG FILE: M2015-01 M-001.DWG
DRAWN BY: JBM
CHECKED BY: EGU
DESIGNED BY: NJS

SHEET TITLE:

SYMBOLS AND ABBREVIATIONS

SHEET NUMBER:

M-001

SHEET 2 OF 15
FEBRUARY 14, 2023

These design drawings have been altered to indicate as-built information supplied by the construction contractor. The Engineer-of-Record is not responsible for the accuracy of said information. A record of as-designed drawings are maintained by the Owner.



BERNHARD TME ENGINEERING
622 Emerson Road, Suite 250
St. Louis, MO 63141 • 314-727-8760
MO Certificate of Authority No. 2009021478



OFFICE OF ADMINISTRATION
DIVISION OF FACILITIES
MANAGEMENT,
DESIGN AND CONSTRUCTION
DEPARTMENT OF
MENTAL HEALTH

REPLACE COOLING TOWERS
SAINT LOUIS FORENSIC
TREATMENT CENTER - NORTH
SAINT LOUIS, MISSOURI

PROJECT # M2015-01
SITE # 7391
ASSET # 6517391002

REVISION: _____
DATE: _____
REVISION: _____
DATE: _____
REVISION: _____
DATE: _____
ISSUE DATE: 02/14/2023

CAD DWG FILE: M2015-01 MD-102.DWG
DRAWN BY: JBM
CHECKED BY: EGU
DESIGNED BY: NJS


SHEET TITLE:

PARTIAL FIRST FLR.
PLAN - MAIN EQUIP.
ROOM DEMO

SHEET NUMBER:

MD-102

SHEET 4 OF 15
FEBRUARY 14, 2023

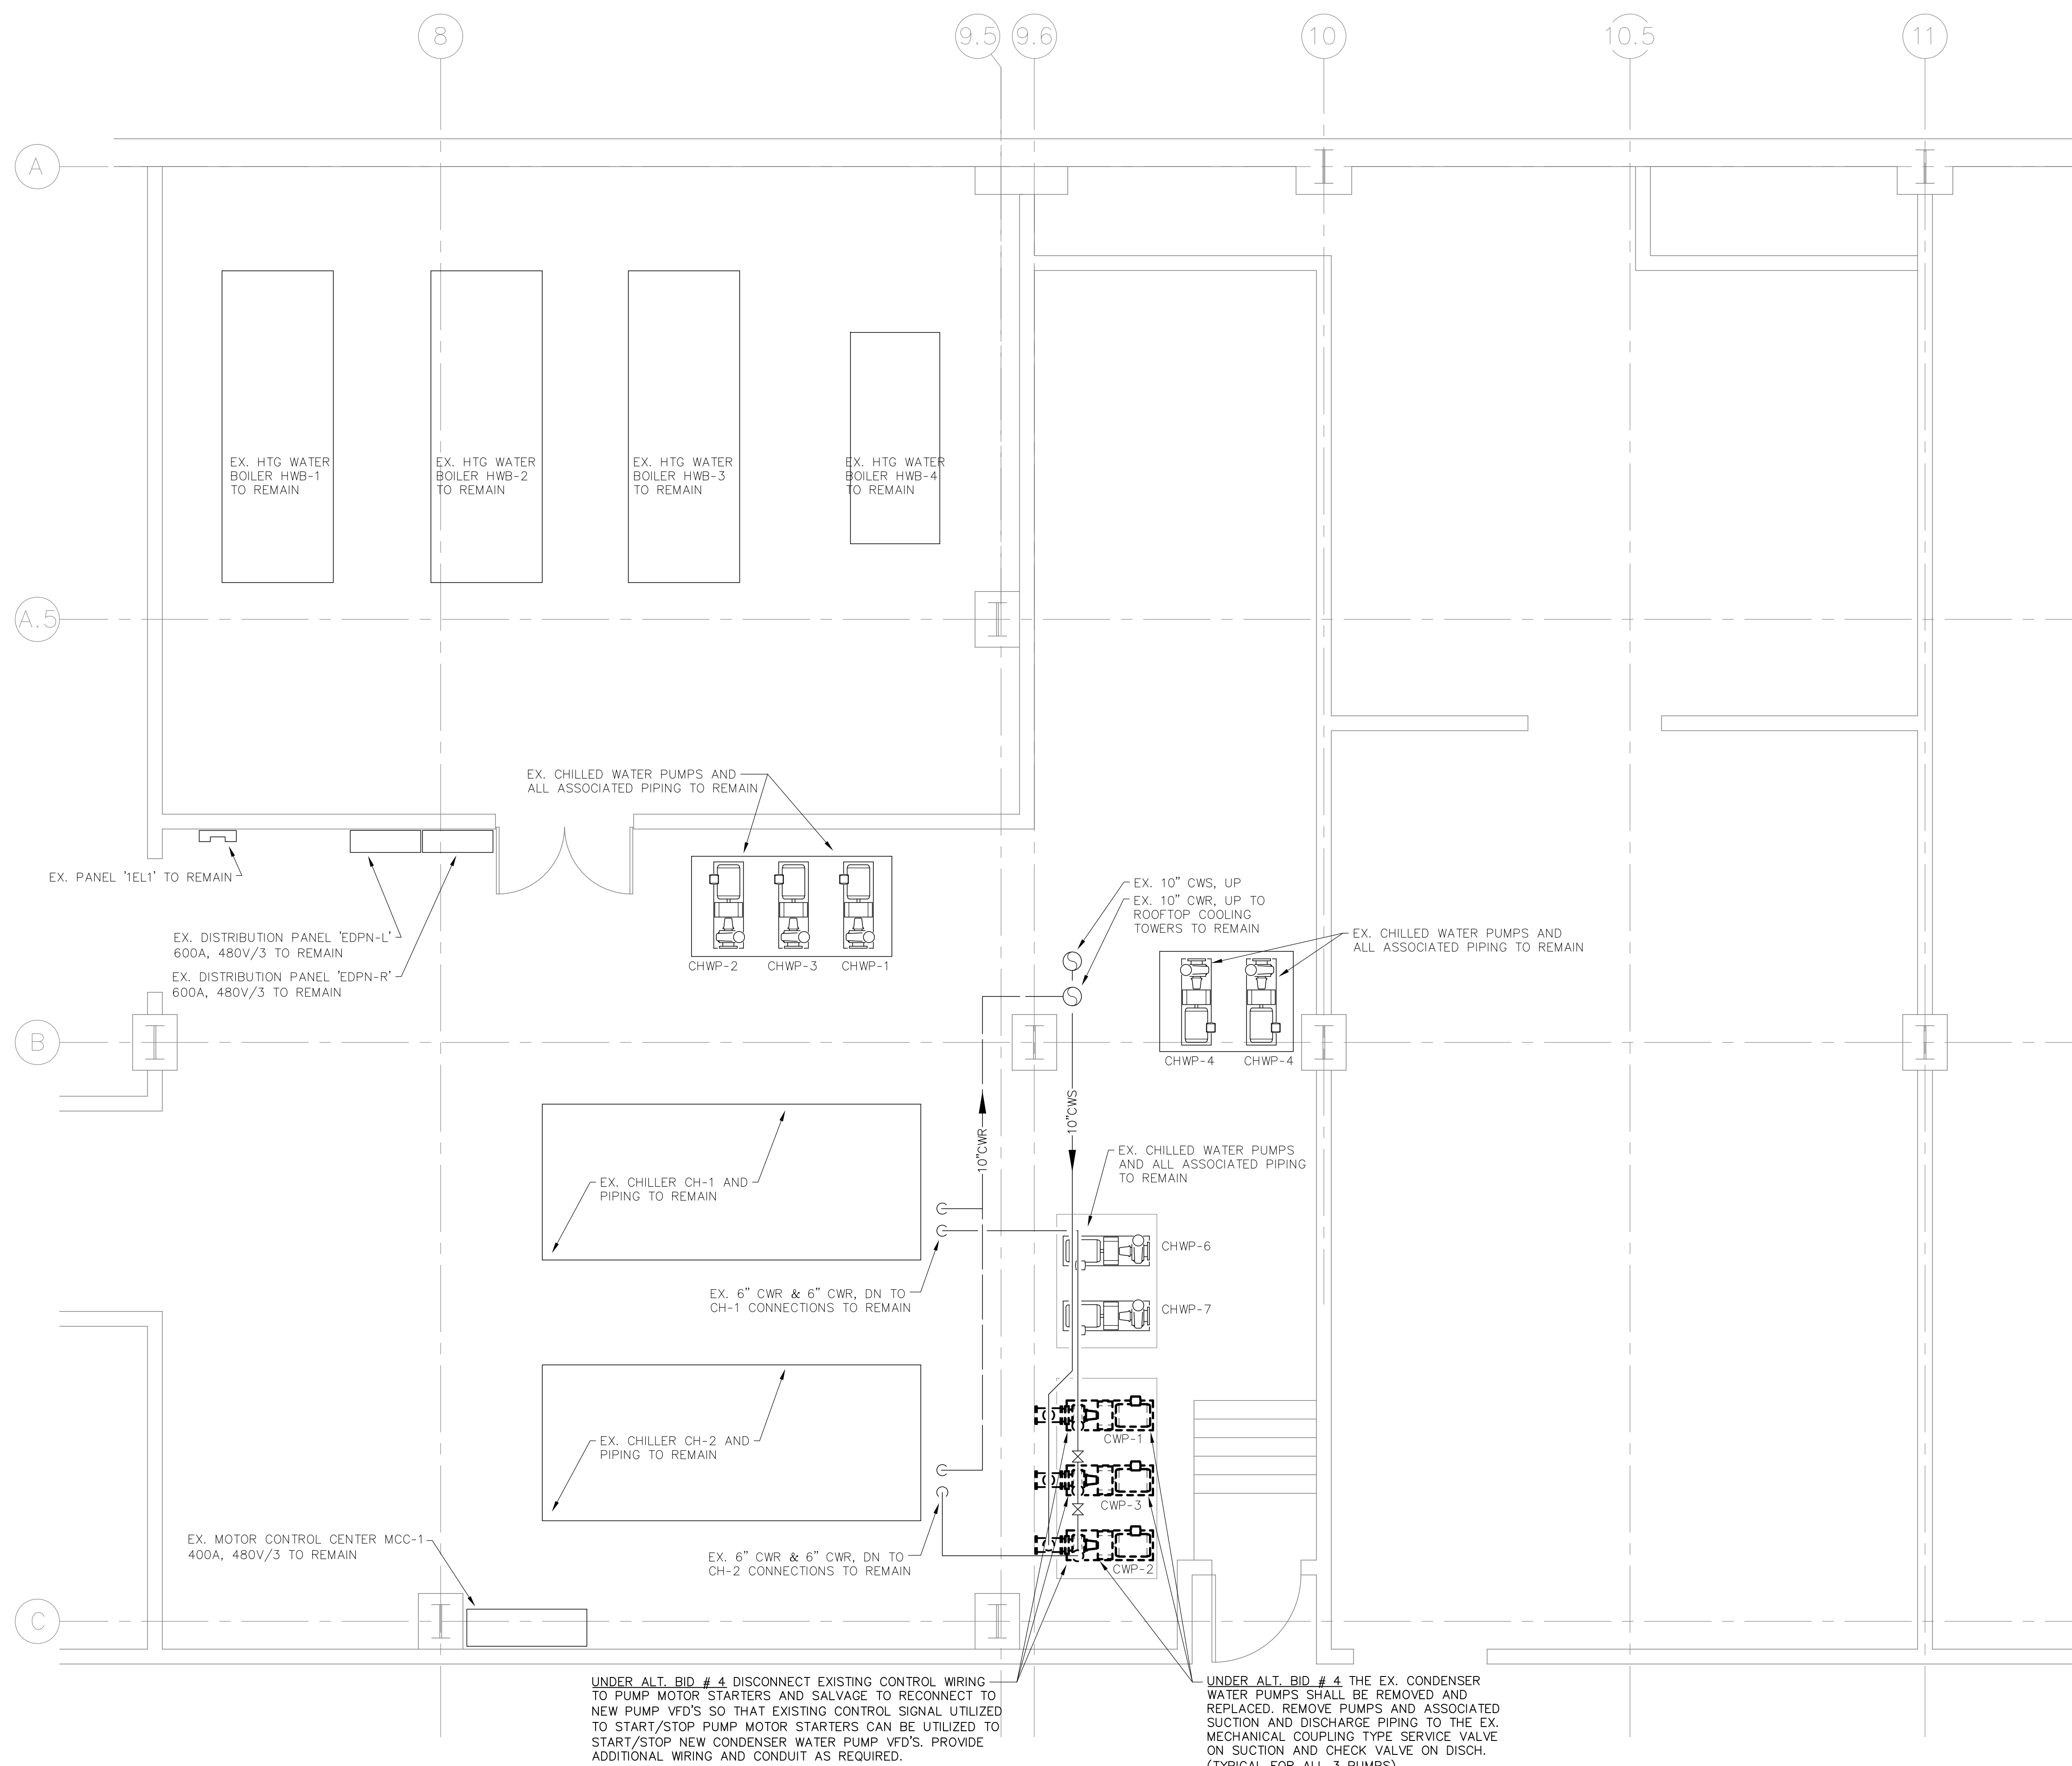


PARTIAL FIRST FLOOR PLAN - MAIN MECHANICAL DEMOLITION
SCALE: 1/4"=1'-0" MECHANICAL (ALT BID # 4)

M2015-01 MD-102.dwg, . 2/14/2023 11:40 AM, jmaron

These design drawings have been altered to indicate as-built information supplied by the construction contractor. The Engineer-of-Record is not responsible for the accuracy of said information. A record of as-designed drawings are maintained by the Owner.



BERNHARD TME ENGINEERING
622 Emerson Road, Suite 250
St. Louis, MO 63141 • 314-727-8760
MO Certificate of Authority No. 2009021478

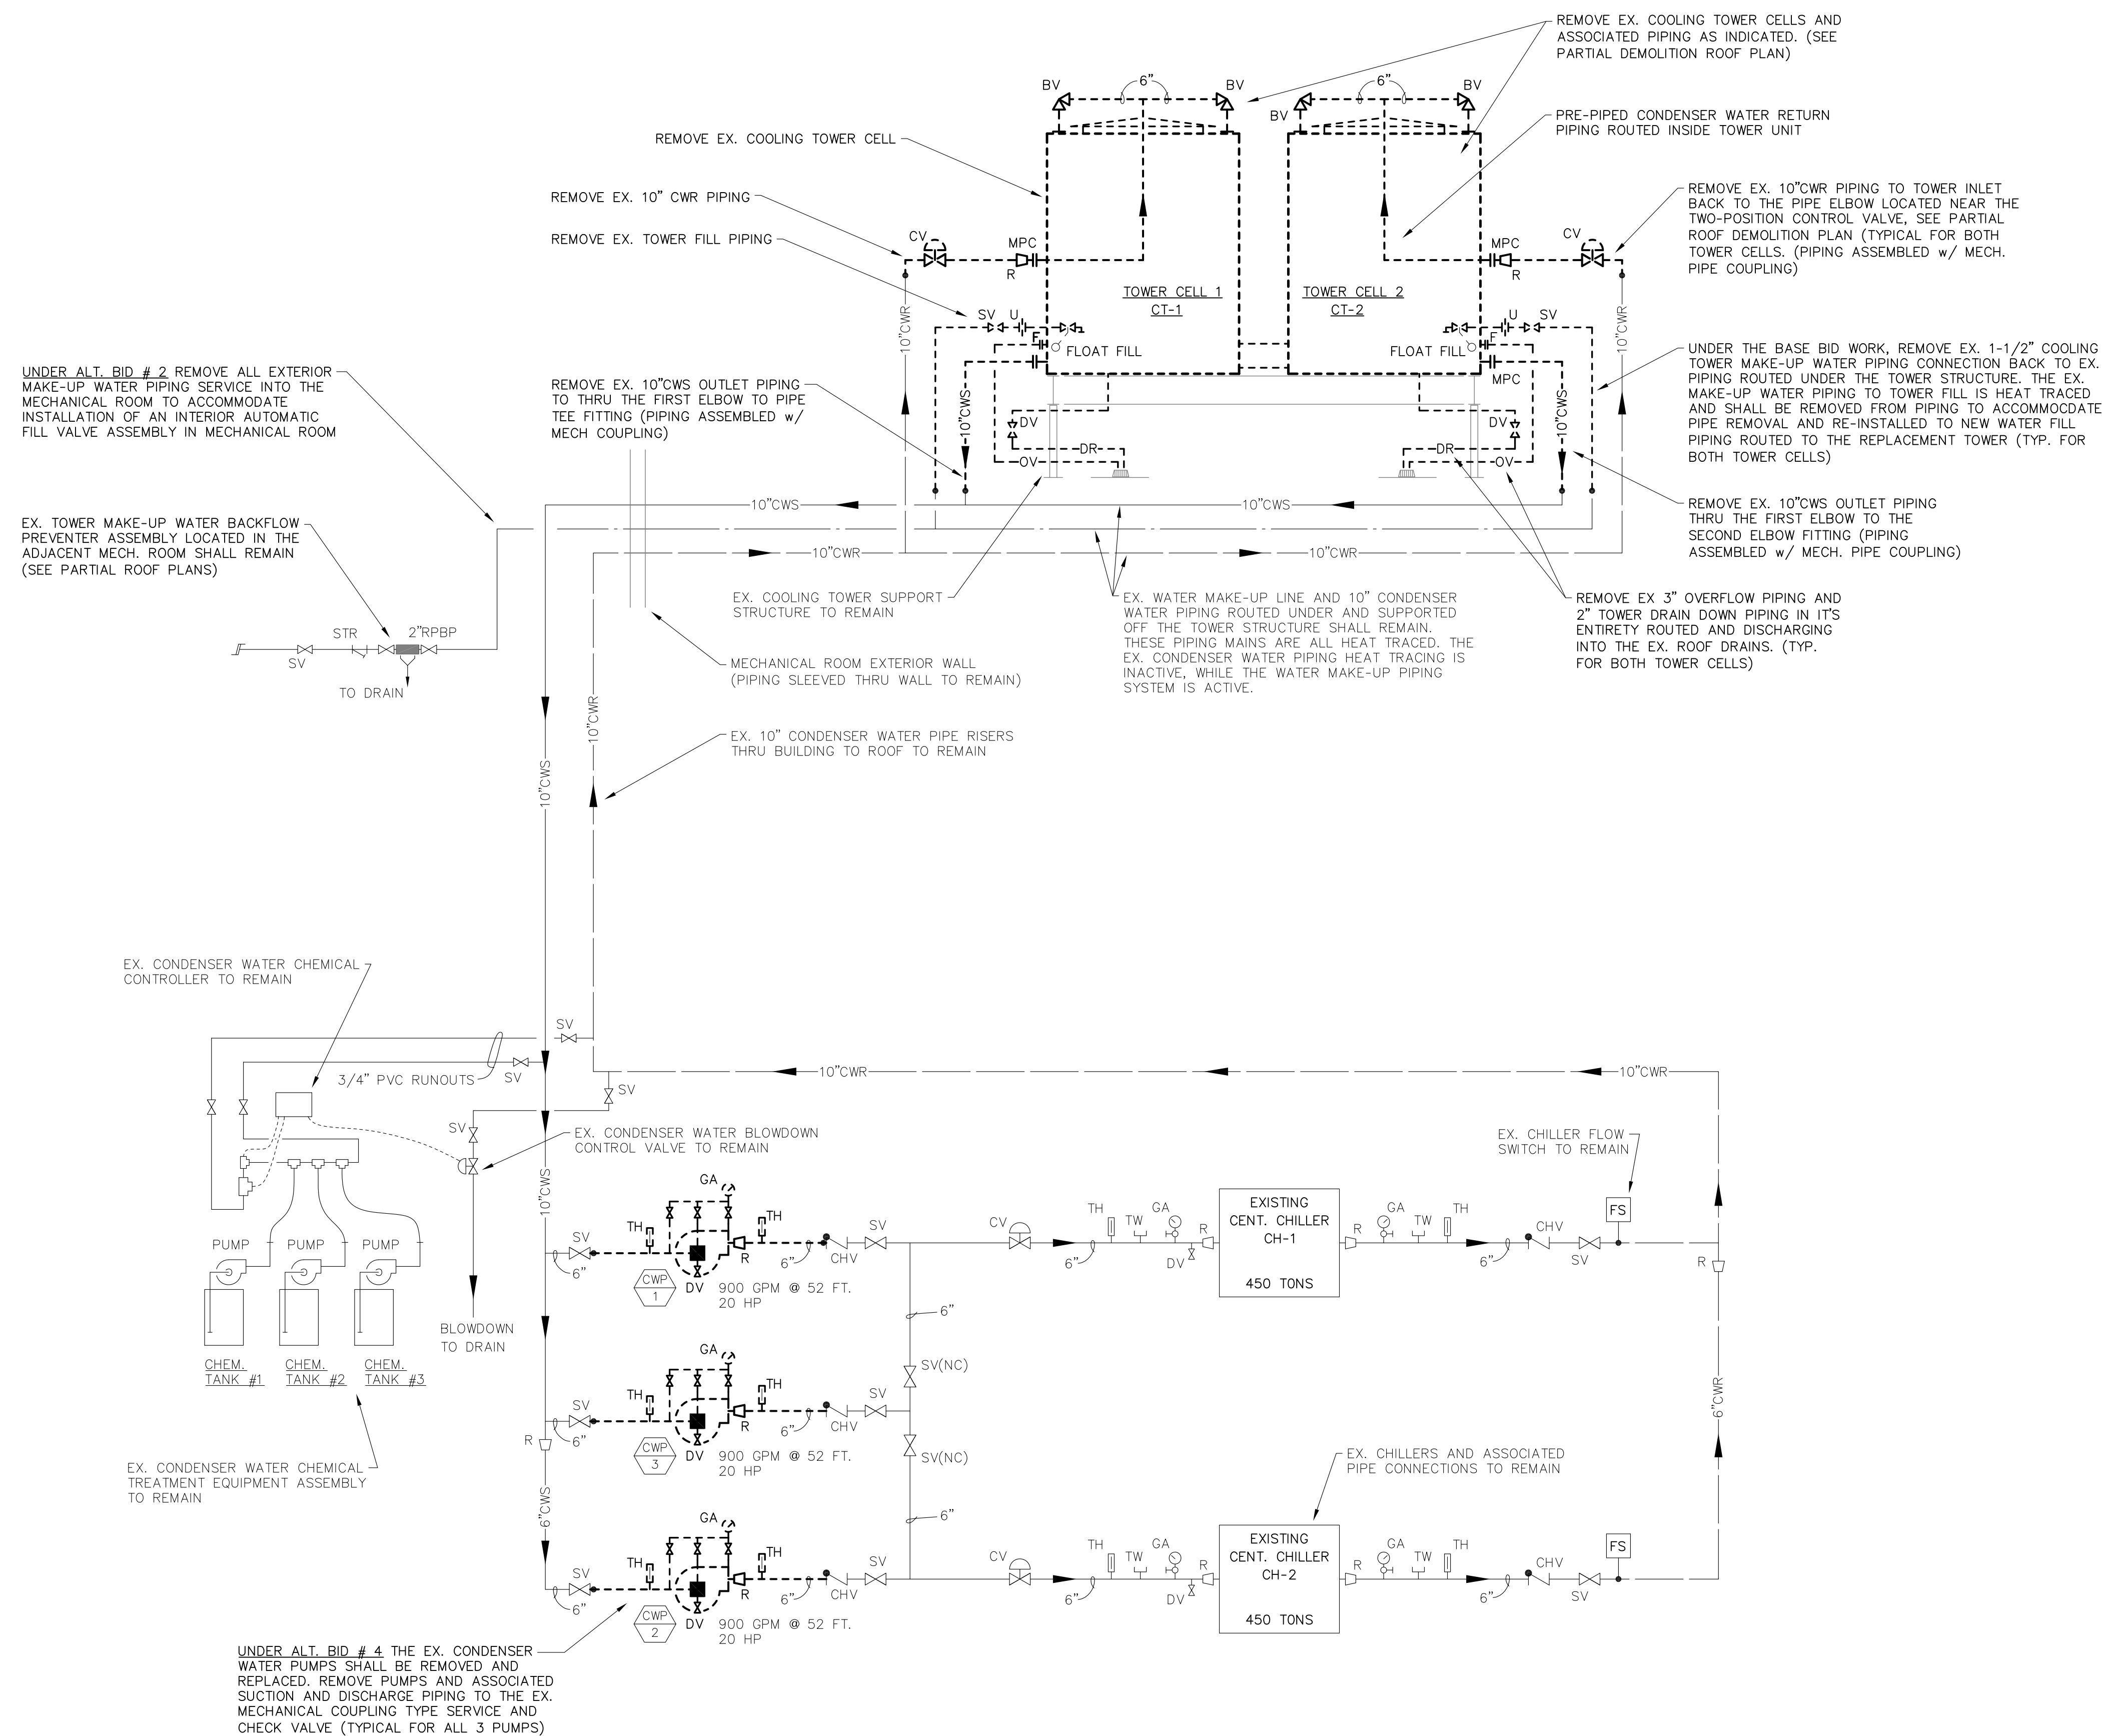

EXISTING CONDENSER WATER DEMOLITION FLOW DIAGRAM

NO SCALE

OFFICE OF ADMINISTRATION
DIVISION OF FACILITIES
MANAGEMENT,
DESIGN AND CONSTRUCTION
DEPARTMENT OF
MENTAL HEALTH

REPLACE COOLING TOWERS
SAINT LOUIS FORENSIC
TREATMENT CENTER - NORTH
SAINT LOUIS, MISSOURI

PROJECT # M2015-01
SITE # 7391
ASSET # 6517391002

REVISION: _____
DATE: _____
REVISION: _____
DATE: _____
REVISION: _____
DATE: _____
ISSUE DATE: 02/14/2023

CAD DWG FILE: M2015-01 MD-201.DWG
DRAWN BY: JBM
CHECKED BY: EGU
DESIGNED BY: NJS

SHEET TITLE:

EX. CONDENSER
WATER DEMOLITION
FLOW DIAGRAM

SHEET NUMBER:

MD-201

SHEET 5 OF 15
FEBRUARY 14, 2023

M2015-01 MD-201.dwg, . 2/14/2023 11:40 AM, jmaron

These design drawings have been altered to indicate as-built information supplied by the construction contractor. The Engineer-of-Record is not responsible for the accuracy of said information. A record of as-designed drawings are maintained by the Owner.



BERNHARD TME ENGINEERING
622 Emerson Road, Suite 250
St. Louis, MO 63141 • 314-727-8760
MO Certificate of Authority No. 2009021478



OFFICE OF ADMINISTRATION
DIVISION OF FACILITIES
MANAGEMENT,
DESIGN AND CONSTRUCTION
DEPARTMENT OF
MENTAL HEALTH

REPLACE COOLING TOWERS
SAINT LOUIS FORENSIC
TREATMENT CENTER - NORTH
SAINT LOUIS, MISSOURI

PROJECT # M2015-01
SITE # 7391
ASSET # 6517391002

REVISION: _____
DATE: _____
REVISION: _____
DATE: _____
REVISION: _____
DATE: _____
ISSUE DATE: 02/14/2023


CAD DWG FILE: M2015-01 M-101.DWG
DRAWN BY: JBM
CHECKED BY: EGU
DESIGNED BY: NJS

SHEET TITLE:
**PARTIAL ROOF
PLAN - NEW WORK**

SHEET NUMBER:

M-101

SHEET 6 OF 15
FEBRUARY 14, 2023

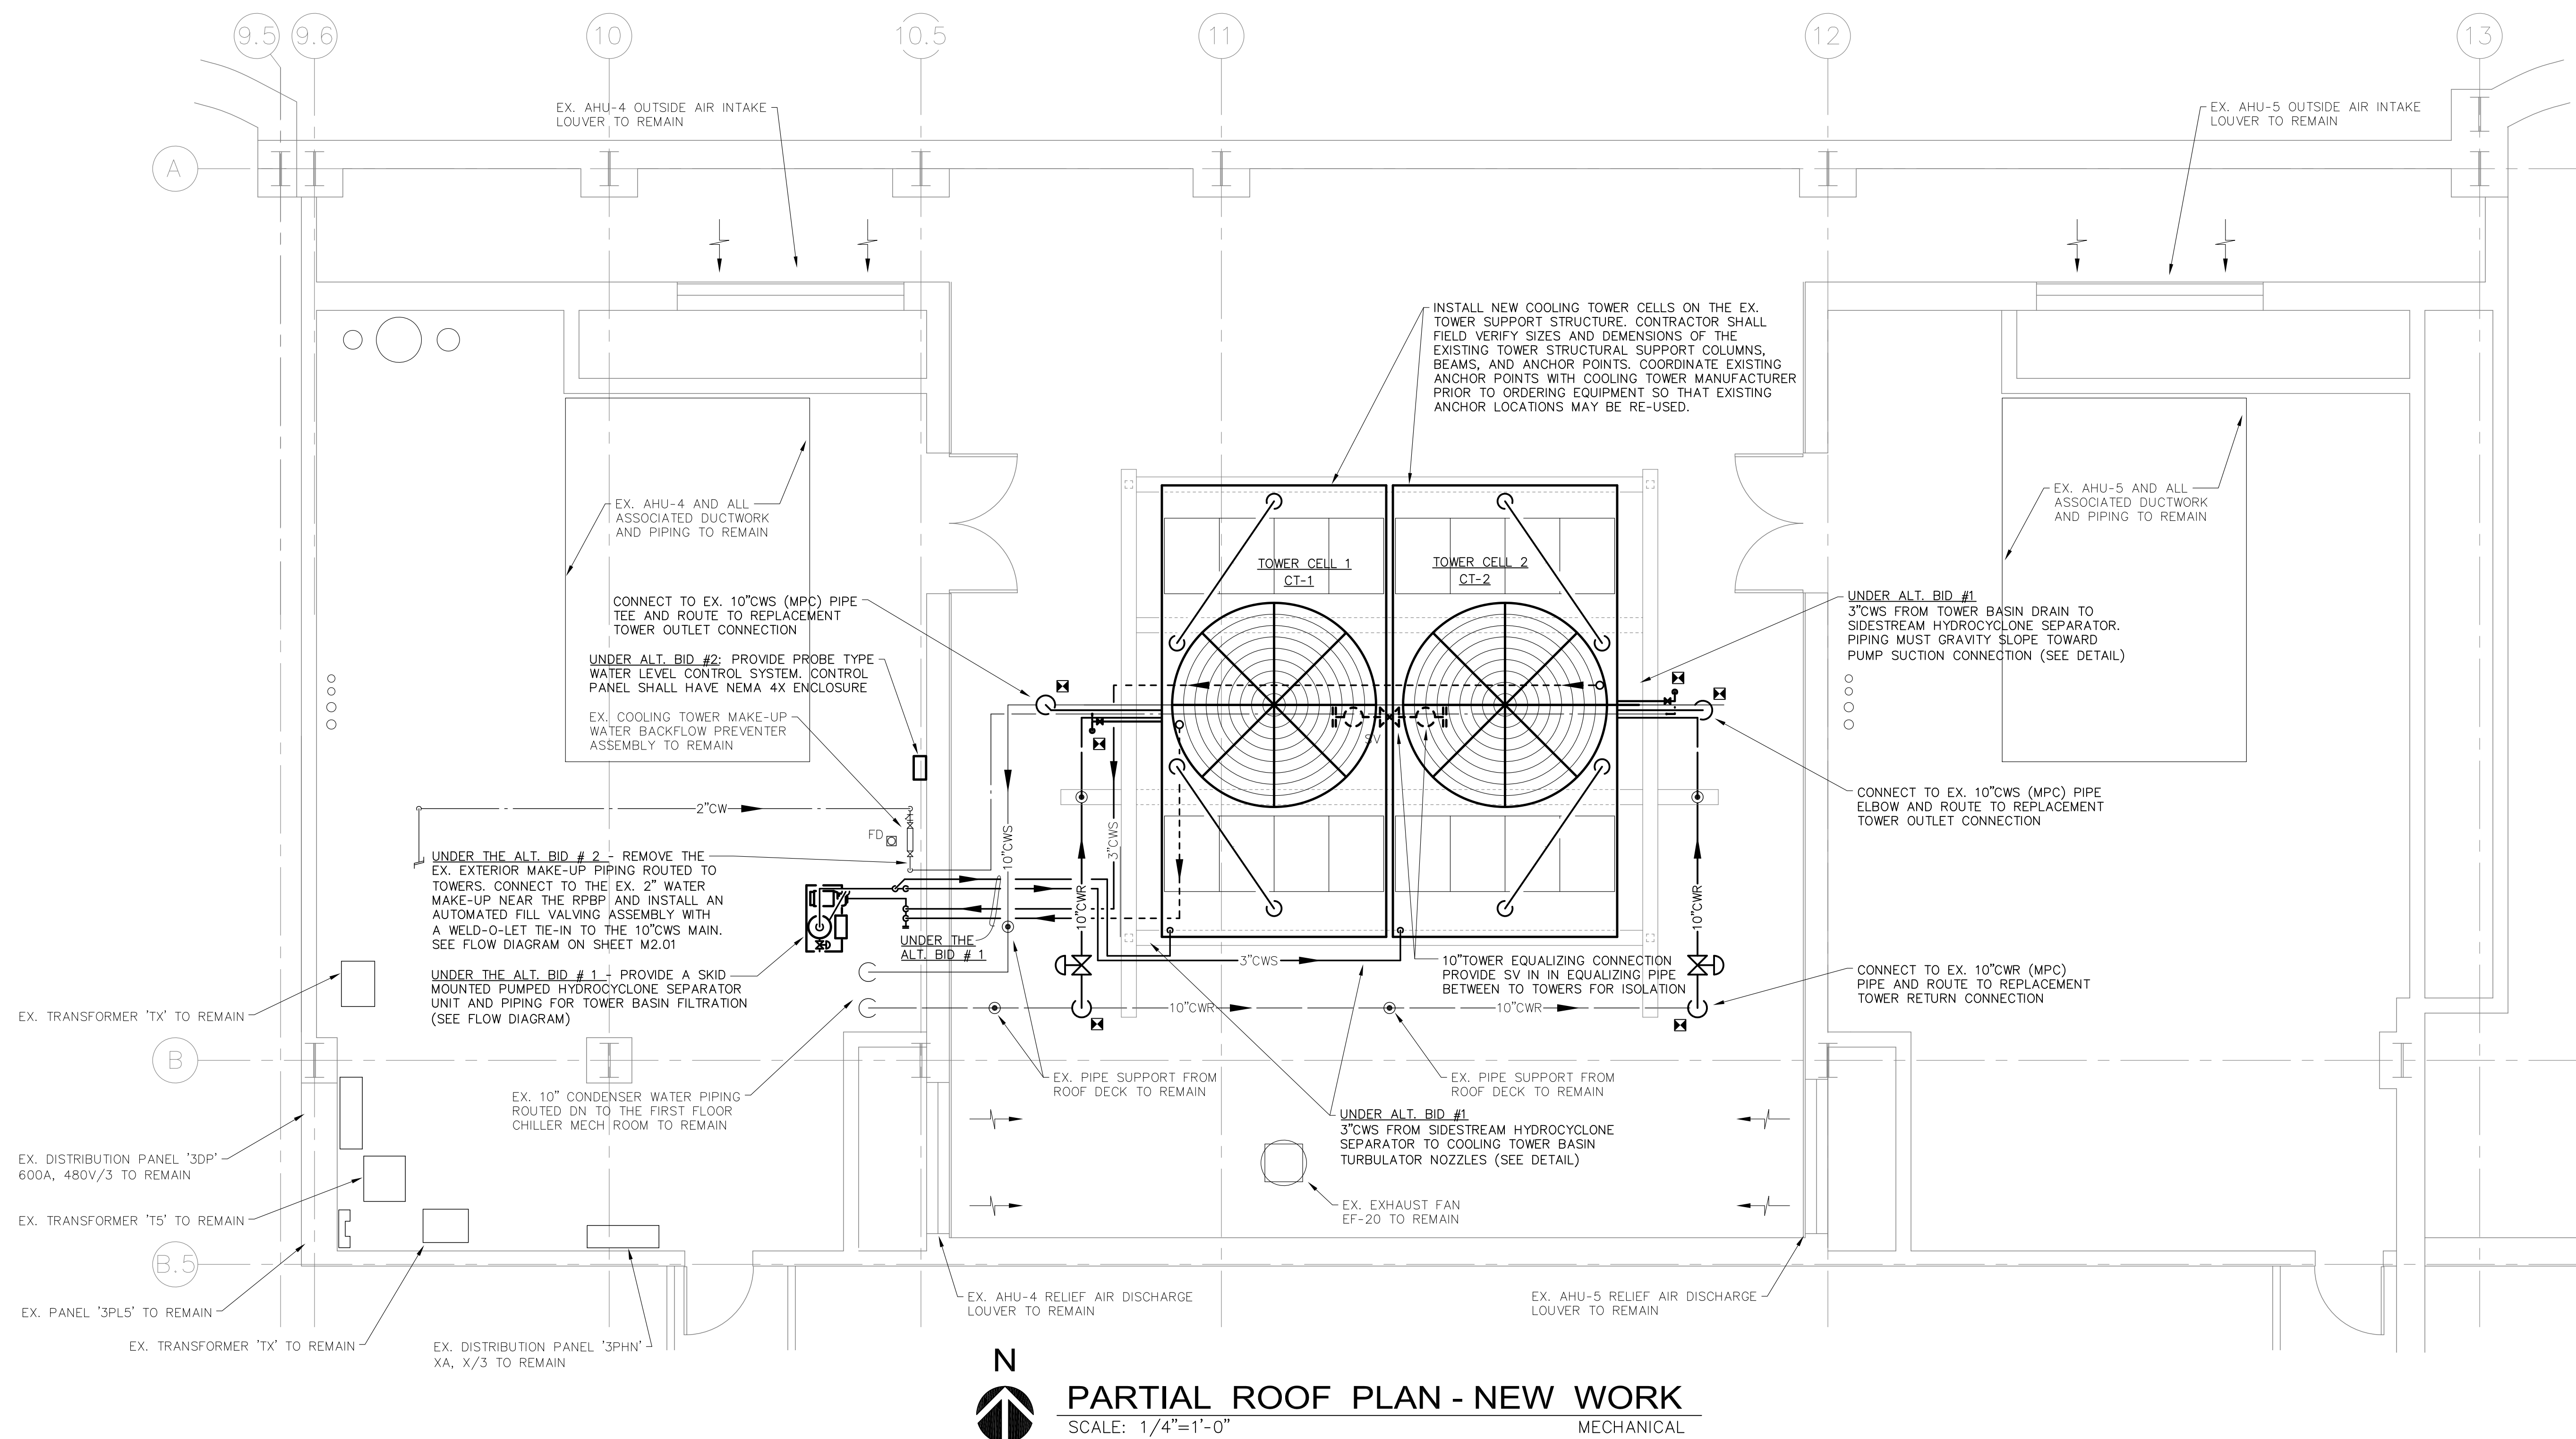

PARTIAL ROOF PLAN - NEW WORK
SCALE: 1/4"=1'-0"
MECHANICAL

M2015-01 M-101.dwg, 2/14/2023 11:38 AM, jbm

These design drawings have been altered to indicate as-built information supplied by the construction contractor. The Engineer-of-Record is not responsible for the accuracy of said information. A record of as-designed drawings are maintained by the Owner.



BERNHARD TME ENGINEERING
622 Emerson Road, Suite 250
St. Louis, MO 63141 • 314-727-8760
MO Certificate of Authority No. 2009021478



OFFICE OF ADMINISTRATION
DIVISION OF FACILITIES
MANAGEMENT,
DESIGN AND CONSTRUCTION
DEPARTMENT OF
MENTAL HEALTH

REPLACE COOLING TOWERS
SAINT LOUIS FORENSIC
TREATMENT CENTER - NORTH
SAINT LOUIS, MISSOURI

PROJECT # M2015-01
SITE # 7391
ASSET # 6517391002

REVISION: _____
DATE: _____
REVISION: _____
DATE: _____
REVISION: _____
DATE: _____
ISSUE DATE: 02/14/2023

CAD DWG FILE: M2015-01 M-102.DWG
DRAWN BY: JBM
CHECKED BY: EGU
DESIGNED BY: NJS


SHEET TITLE:

PARTIAL FIRST FLR.
PLAN - MAIN EQUIP.
ROOM - NEW WORK

SHEET NUMBER:

M-102

SHEET 7 OF 15
FEBRUARY 14, 2023

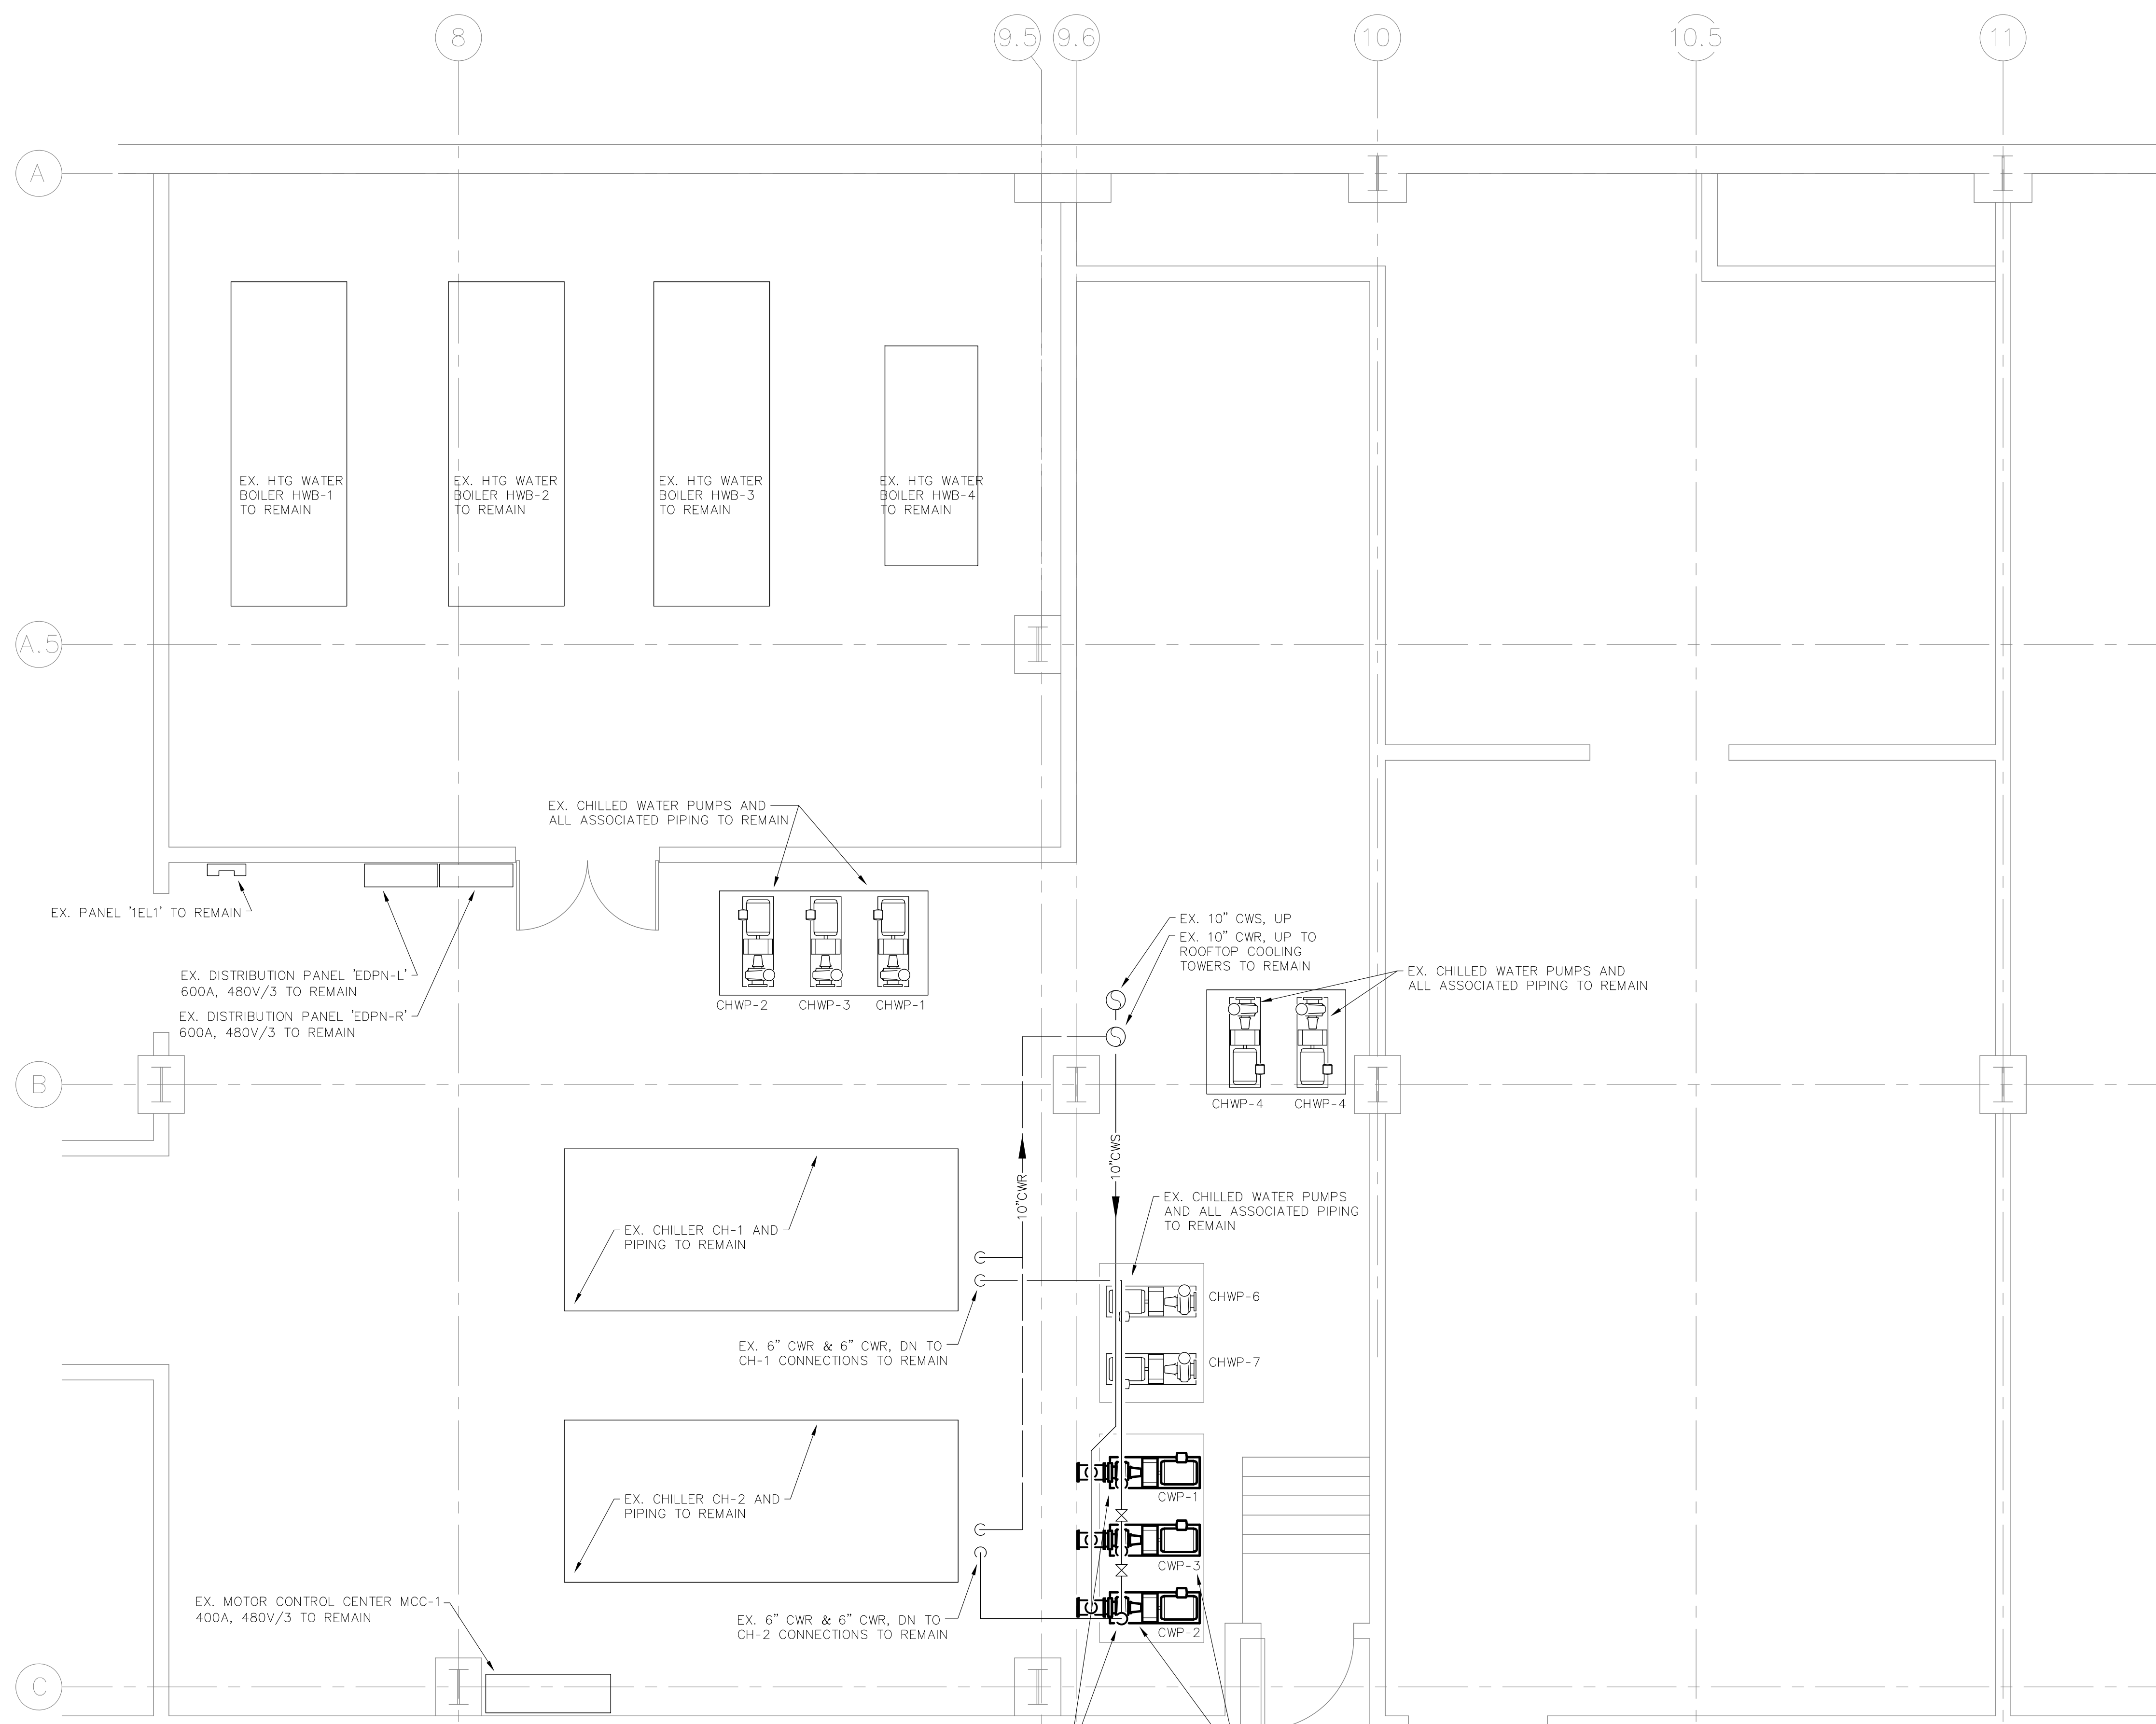

PARTIAL FIRST FLOOR PLAN - MAIN MECHANICAL NEW WORK

SCALE: 1/4"=1'-0"

MECHANICAL (ALT BID # 4)

UNDER ALT. BID # 4 RECONNECT EXISTING CONTROL WIRING TO NEW PUMP VFD'S SO THAT EXISTING CONTROL SIGNAL UTILIZED TO START/STOP PUMP MOTOR STARTERS CAN BE UTILIZED TO START/STOP NEW CONDENSER WATER PUMP VFD'S. PROVIDE ADDITIONAL WIRING AND CONDUIT AS NEEDED.

UNDER ALT. BID # 4 THE EX. CONDENSER WATER PUMPS SHALL BE REMOVED AND REPLACED. REMOVE PUMPS AND ASSOCIATED SUCTION AND DISCHARGE PIPING TO THE EX. MECHANICAL COUPLING TYPE SERVICE AND CHECK VALVE (TYPICAL FOR ALL 3 PUMPS)

These design drawings have been altered to indicate as-built information supplied by the construction contractor. The Engineer-of-Record is not responsible for the accuracy of said information. A record of as-designed drawings are maintained by the Owner.



BERNHARD TME ENGINEERING
622 Emerson Road, Suite 250
St. Louis, MO 63141 • 314-727-8760
MO Certificate of Authority No. 2009021478



OFFICE OF ADMINISTRATION
DIVISION OF FACILITIES
MANAGEMENT,
DESIGN AND CONSTRUCTION
DEPARTMENT OF
MENTAL HEALTH

REPLACE COOLING TOWERS
SAINT LOUIS FORENSIC
TREATMENT CENTER - NORTH
SAINT LOUIS, MISSOURI

PROJECT # M2015-01
SITE # 7391
ASSET # 6517391002

REVISION: _____
DATE: _____
REVISION: _____
DATE: _____
REVISION: _____
DATE: _____
ISSUE DATE: 02/14/2023

CAD DWG FILE: M2015-01 M-201.DWG
DRAWN BY: JBM
CHECKED BY: EGU
DESIGNED BY: NJS


SHEET TITLE:

MODIFIED
CONDENSER WATER
FLOW DIAGRAM

SHEET NUMBER:

M-201

SHEET 8 OF 15
FEBRUARY 14, 2023

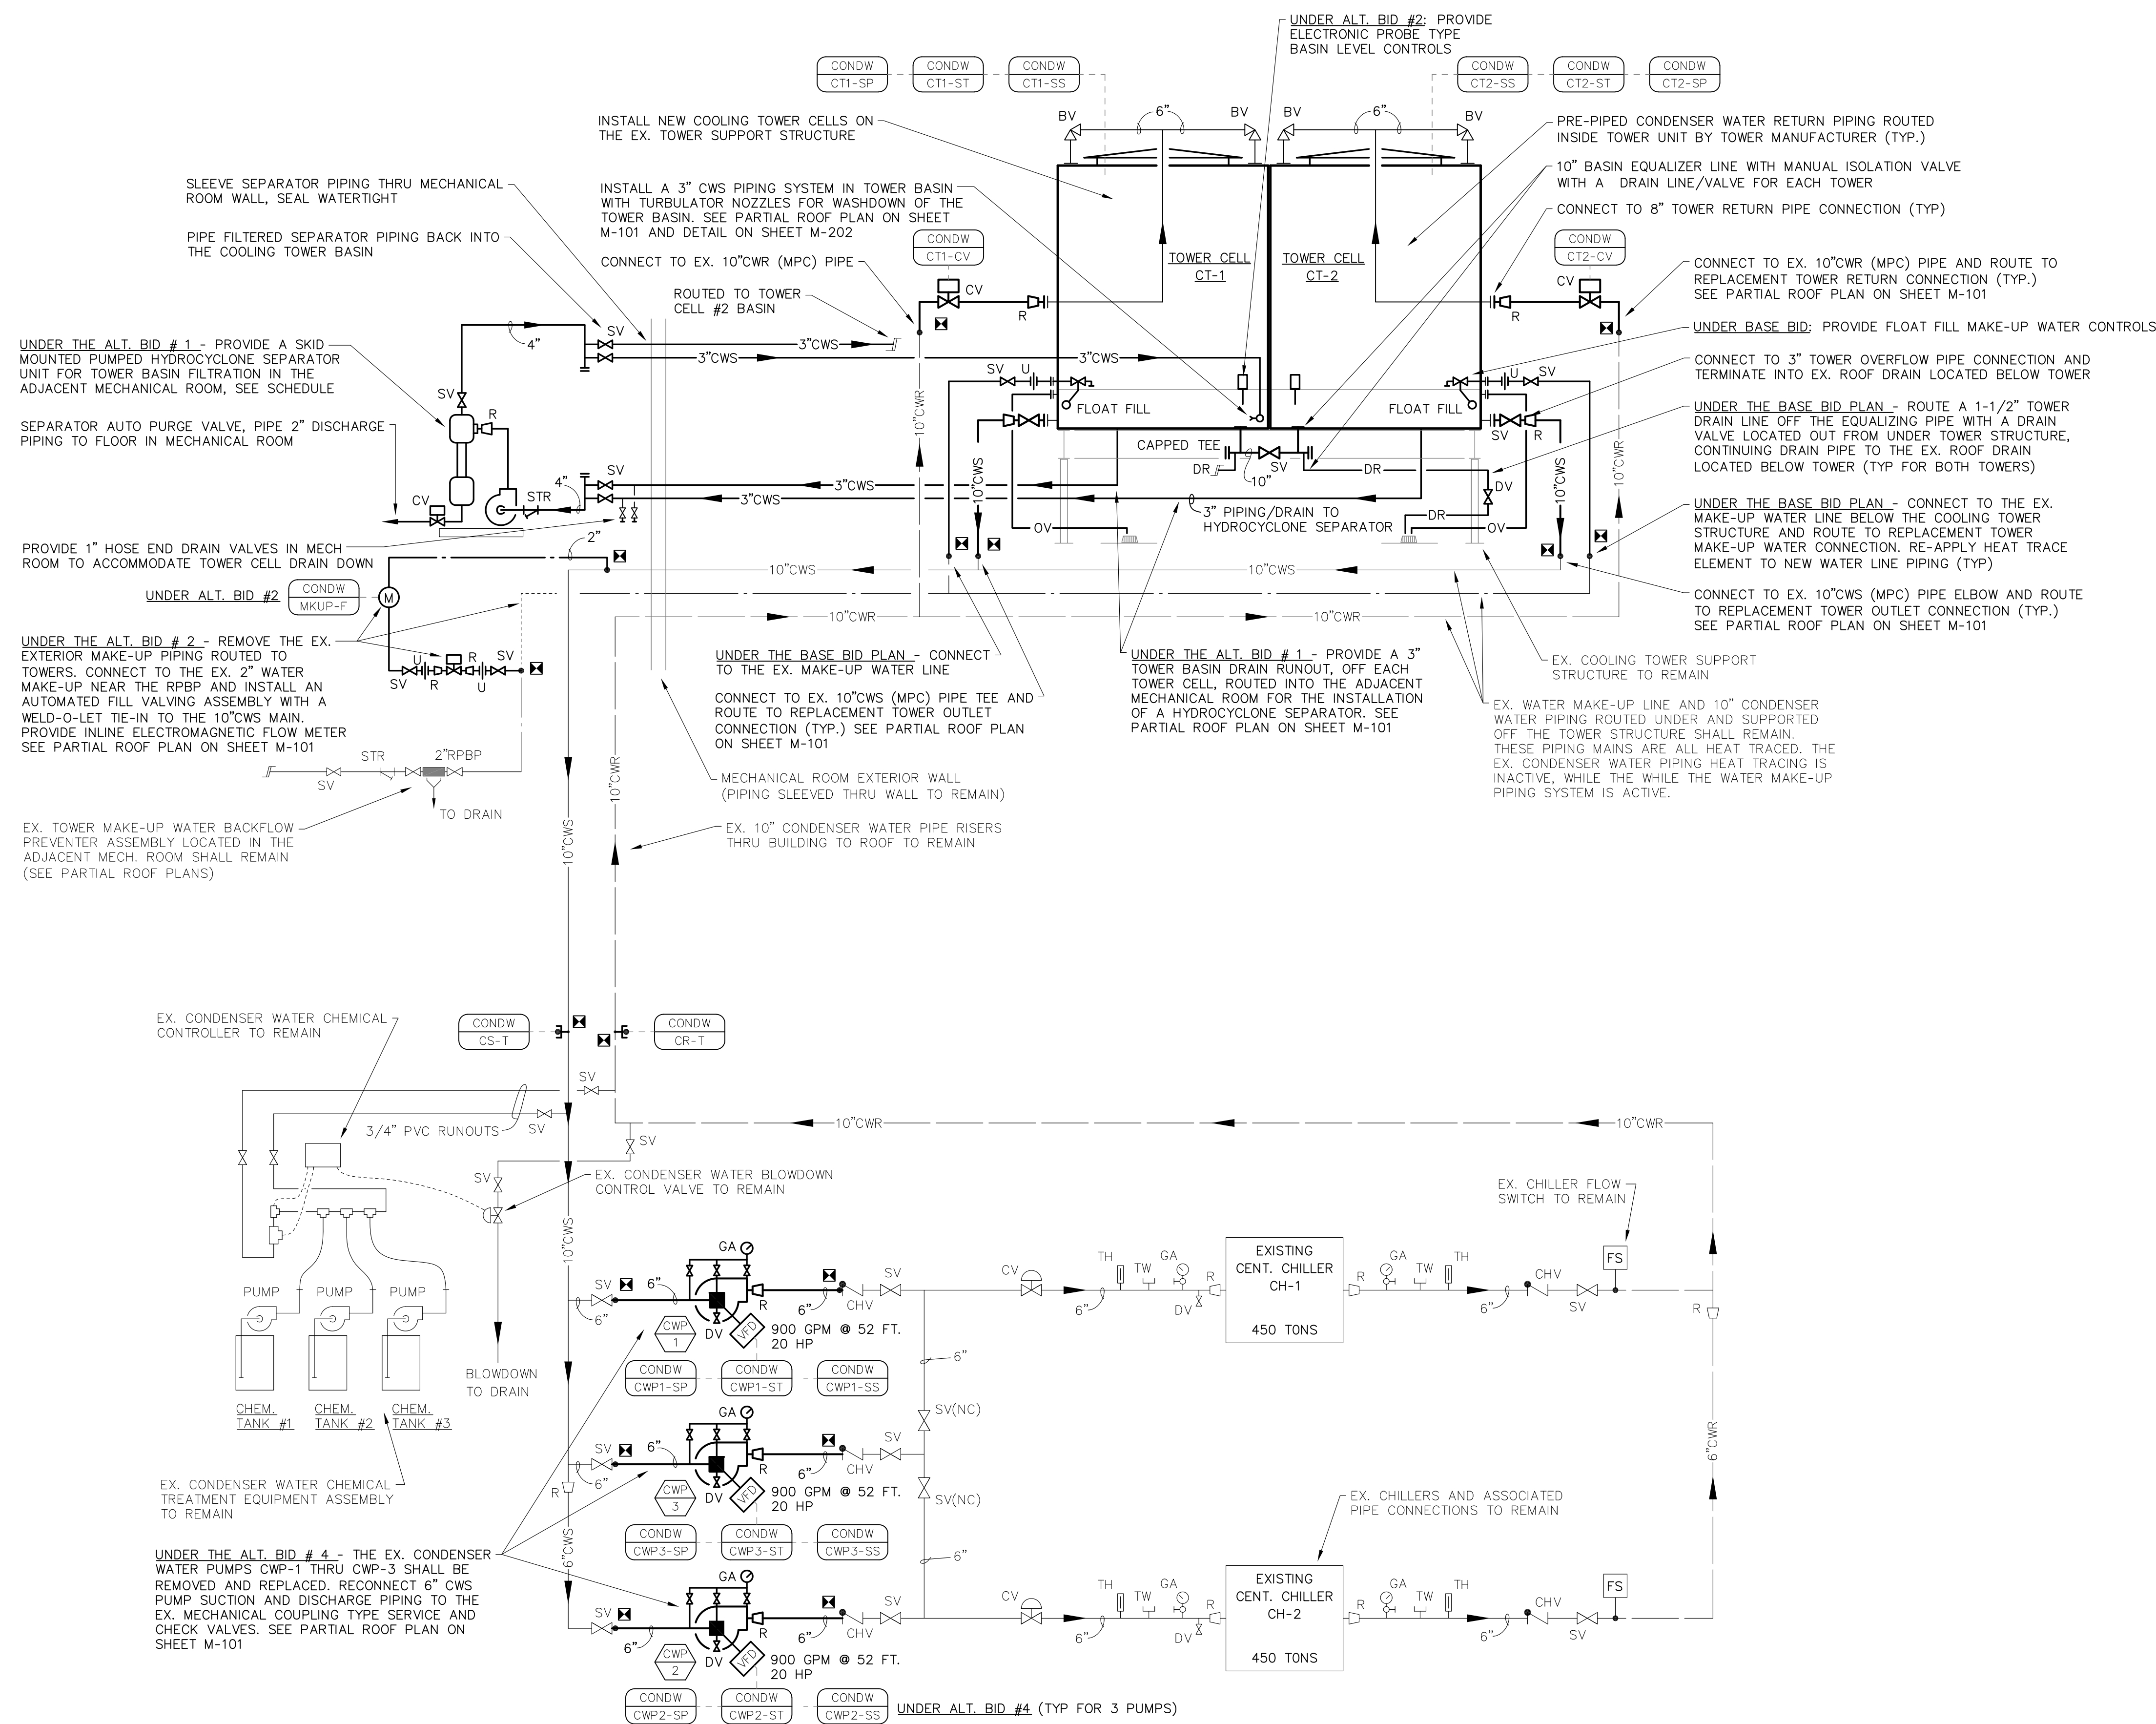

MODIFIED CONDENSER WATER FLOW DIAGRAM

NO SCALE

These design drawings have been altered to indicate as-built information supplied by the construction contractor. The Engineer-of-Record is not responsible for the accuracy of said information. A record of as-designed drawings are maintained by the Owner.

TEMPERATURE CONTROL POINTS LIST SCHEDULES																			
POINT NAME			POINT DESCRIPTION						ALARM			TREND			FIELD DEVICE DESCRIPTION				
POINT DESIGNATION	CONTROLLER NAME	INPUT OUTPUT TYPE	DESCRIPTION	TYPE	SET POINT	UNITS	MONITOR	ADJUST	NOTIFY	THRESHOLD	TREND	FREQUENCY	ARCHIVE	INSTRUMENT TYPE	SIGNAL	RANGE	NOTES		
CT1-SS	CONDW	DO	COOLING TOWER FAN START/STOP COMMAND	COMMAND	-	ON/OFF	X	OVERRIDE	-	-	X	COS	1 WEEK	RELAY	CONTACT	ON/OFF			
CT1-ST	CONDW	DI	COOLING TOWER FAN STATUS	STATUS	-	RUNNING/NOT RUNNING	X	OVERRIDE	X	START=OFF=WHEN CMD=ON	X	COS	1 WEEK	CURRENT SENSING RELAY	CONTACT	OPEN/CLOSED			
CT1-SPD	CONDW	AO	COOLING TOWER FAN SPEED COMMAND	COMMAND	-	% SPEED	X	OVERRIDE	-	-	X	15 MIN.	1 WEEK	DIRECT CONNECTION TO VFD	4-20 MA	0 TO 100%			
CT2-SS	CONDW	DO	COOLING TOWER FAN START/STOP COMMAND	COMMAND	-	ON/OFF	X	OVERRIDE	-	-	X	COS	1 WEEK	RELAY	CONTACT	ON/OFF			
CT2-ST	CONDW	DI	COOLING TOWER FAN STATUS	STATUS	-	RUNNING/NOT RUNNING	X	OVERRIDE	X	START=OFF=WHEN CMD=ON	X	COS	1 WEEK	CURRENT SENSING RELAY	CONTACT	OPEN/CLOSED			
CT2-SPD	CONDW	AO	COOLING TOWER FAN SPEED COMMAND	COMMAND	-	% SPEED	X	OVERRIDE	-	-	X	15 MIN.	1 WEEK	DIRECT CONNECTION TO VFD	4-20 MA	0 TO 100%			
CWP1-SS	CONDW	DO	CONDENSER WATER PUMP CWP-1 START/STOP COMMAND	COMMAND	-	ON/OFF	X	OVERRIDE	-	-	X	COS	1 WEEK	RELAY	CONTACT	ON/OFF	ALTERNATE BID #4		
CWP1-ST	CONDW	DI	CONDENSER WATER CWP-1 PUMP STATUS	STATUS	-	RUNNING/NOT RUNNING	X	OVERRIDE	X	START=OFF=WHEN CMD=ON	X	COS	1 WEEK	CURRENT SENSING SWITCH	CONTACT	OPEN/CLOSED	ALTERNATE BID #4		
CWP1-SPD	CONDW	AO	CONDENSER WATER PUMP CWP-1 SPEED COMMAND	COMMAND	-	% SPEED	X	OVERRIDE	-	-	X	15 MIN.	1 WEEK	DIRECT CONNECTION TO VFD	4-20 MA	0 TO 100%	ALTERNATE BID #4		
CWP2-SS	CONDW	DO	CONDENSER WATER PUMP CWP-2 START/STOP COMMAND	COMMAND	-	ON/OFF	X	OVERRIDE	-	-	X	COS	1 WEEK	RELAY	CONTACT	ON/OFF	ALTERNATE BID #4		
CWP2-ST	CONDW	DI	CONDENSER WATER CWP-2 PUMP STATUS	STATUS	-	RUNNING/NOT RUNNING	X	OVERRIDE	X	START=OFF=WHEN CMD=ON	X	COS	1 WEEK	CURRENT SENSING SWITCH	CONTACT	OPEN/CLOSED	ALTERNATE BID #4		
CWP2-SPD	CONDW	AO	CONDENSER WATER PUMP CWP-2 SPEED COMMAND	COMMAND	-	% SPEED	X	OVERRIDE	-	-	X	15 MIN.	1 WEEK	DIRECT CONNECTION TO VFD	4-20 MA	0 TO 100%	ALTERNATE BID #4		
CWP3-SS	CONDW	DO	CONDENSER WATER PUMP CWP-3 START/STOP COMMAND	COMMAND	-	ON/OFF	X	OVERRIDE	-	-	X	COS	1 WEEK	RELAY	CONTACT	ON/OFF	ALTERNATE BID #4		
CWP3-ST	CONDW	DI	CONDENSER WATER CWP-3 PUMP STATUS	STATUS	-	RUNNING/NOT RUNNING	X	OVERRIDE	X	START=OFF=WHEN CMD=ON	X	COS	1 WEEK	CURRENT SENSING SWITCH	CONTACT	OPEN/CLOSED	ALTERNATE BID #4		
CWP3-SPD	CONDW	AO	CONDENSER WATER PUMP CWP-3 SPEED COMMAND	COMMAND	-	% SPEED	X	OVERRIDE	-	-	X	15 MIN.	1 WEEK	DIRECT CONNECTION TO VFD	4-20 MA	0 TO 100%	ALTERNATE BID #4		
CT-CV	CONDW	DO	COOLING TOWER CT-1 ISOLATION CONTROL VALVE	COMMAND	-	OPEN/CLOSE	X	OVERRIDE	-	-	X	COS	1 WEEK	ELECTRIC CONTROL VALVE ACTUATOR	CONTACT	OPEN/CLOSE			
CT-CV	CONDW	DO	COOLING TOWER CT-2 ISOLATION CONTROL VALVE	COMMAND	-	OPEN/CLOSE	X	OVERRIDE	-	-	X	COS	1 WEEK	ELECTRIC CONTROL VALVE ACTUATOR	CONTACT	OPEN/CLOSE			
CS1-T	CONDW	AI	CONDENSER WATER SUPPLY TEMPERATURE	TEMPERATURE	-	DEGREES F	X	OVERRIDE	-	-	X	15 MIN.	1 WEEK	RIGID RTD OR THERMISTOR TEMPERATURE SENSOR WITH THERMOWELL	OHMS	-30 TO 250 F			
CR1-T	CONDW	AI	CONDENSER WATER RETURN TEMPERATURE	TEMPERATURE	-	DEGREES F	X	OVERRIDE	-	-	X	15 MIN.	1 WEEK	RIGID RTD OR THERMISTOR TEMPERATURE SENSOR WITH THERMOWELL	OHMS	-30 TO 250 F			
MKUP-F	CONDW	AI	CONDENSER MAKE-UP WATER FLOW	FLOW	-	GPM	X	OVERRIDE	-	-	X	15 MIN.	1 WEEK	ELECTROMAGNETIC FLOW METER WITH TRANSMITTER	4-20MA	0-100 GPM	ALTERNATE BID #2		

POINTS LIST SYMBOLS AND ABBREVIATIONS
 DI DIGITAL INPUT TO BAS
 DO DIGITAL OUTPUT TO BAS
 AI ANALOG INPUT TO BAS
 AO ANALOG OUTPUT TO BAS
 NET NETWORKED POINTS
 HW HARD WIRED INTERLOCK/SAFETY
 COS CHANGE OF STATE

POINTS LIST NOTES



BERNHARD TME ENGINEERING
 622 Emerson Road, Suite 250
 St. Louis, MO 63141 • 314-727-8760
 MO Certificate of Authority No. 2009021478



OFFICE OF ADMINISTRATION
 DIVISION OF FACILITIES
 MANAGEMENT,
 DESIGN AND CONSTRUCTION
 DEPARTMENT OF
 MENTAL HEALTH

REPLACE COOLING TOWERS
 SAINT LOUIS FORENSIC
 TREATMENT CENTER - NORTH
 SAINT LOUIS, MISSOURI

PROJECT # M2015-01
 SITE # 7391
 ASSET # 6517391002

REVISION: _____
 DATE: _____
 REVISION: _____
 DATE: _____
 REVISION: _____
 DATE: _____
 ISSUE DATE: 02/14/2023

CAD DWG FILE: M2015-01 M-202.DWG
 DRAWN BY: JBM
 CHECKED BY: EGU
 DESIGNED BY: NJS

SHEET TITLE:
**CONDENSER WATER
 POINTS LIST
 SCHEDULE**

SHEET NUMBER:
M-202
 SHEET 9 OF 15
 FEBRUARY 14, 2023

These design drawings have been altered to indicate as-built information supplied by the construction contractor. The Engineer-of-Record is not responsible for the accuracy of said information. A record of as-designed drawings are maintained by the Owner.



BERNHARD TME ENGINEERING
622 Emerson Road, Suite 250
St. Louis, MO 63141 • 314-727-8760
MO Certificate of Authority No. 2009021478



OFFICE OF ADMINISTRATION
DIVISION OF FACILITIES
MANAGEMENT,
DESIGN AND CONSTRUCTION
DEPARTMENT OF
MENTAL HEALTH

REPLACE COOLING TOWERS
SAINT LOUIS FORENSIC
TREATMENT CENTER - NORTH
SAINT LOUIS, MISSOURI

PROJECT # M2015-01
SITE # 7391
ASSET # 6517391002

REVISION: _____
DATE: _____
REVISION: _____
DATE: _____
REVISION: _____
DATE: _____
ISSUE DATE: 02/14/2023

CAD DWG FILE: M2015-01 M-203.DWG
DRAWN BY: JBM
CHECKED BY: EGU
DESIGNED BY: NJS

SHEET TITLE:
SCHEDULES AND
DETAILS

SHEET NUMBER:

M-203

SHEET 10 OF 15
FEBRUARY 14, 2023

COOLING TOWER SCHEDULE

TOWER DESIGNATION	MANUFACTURER / MODEL NUMBER	WATER FLOW (GPM)	BHP	ENTERING WATER (F)	LEAVING WATER (F)	AMBIENT WET BULB (F)	MAXIMUM STATIC LIFT (FEET)	NOZZLES ΔP (PSI)	MOTOR DATA				REMARKS
									HP	RPM	VOLTS/PH	VFD	
CT-1 & 2	MARLEY NC8405PAN	1800	11.92(x2)	100	85	78	12.3	-	15(x2)	1800	480/3	YES	NOTE 1 & 2

NOTE 1. UNDER BASE BID: PROVIDE TOWERS WITH 304 STAINLESS STEEL HOT & COLD BASINS, GALVANIZED STEEL STRUCTURAL COMPONENTS, FRP CASING PANELS & AIR INLET LOUVERS, PVC FILL & DRIFT ELIMINATORS, AND MECHANICAL FLOAT VALVE FOR BASIN LEVEL (MAKE-UP WATER) CONTROL.
NOTE 2. UNDER ALTERNATE BID #3: ALL STRUCTURAL STEEL COMPONENTS SHALL BE CONSTRUCTED FROM 304 STAINLESS STEEL


PUMP SCHEDULE (ALT. BID #4)

PUMP DESIGNATION	SERVICE	MANUFACTURER MODEL NUMBER	LOCATION	TYPE	BHP	PUMP DATA				MOTOR DATA				REMARKS
						WATER FLOW (GPM)	HEAD (FEET)	IMPELLER DIA. (IN)	NPSHA (FEET)	HP	RPM	VOLTS/PH	VFD	
CWP-1	CONDENSER WATER PUMP	B & G e-1510 5BD	MECH ROOM	BASE MOUNTED	14.4	900	50	8.375	-	15	1715	480/3	YES	ALT. BID # 4
CWP-2	CONDENSER WATER PUMP	B & G e-1510 5BD	MECH ROOM	BASE MOUNTED	14.4	900	50	8.375	-	15	1715	480/3	YES	ALT. BID # 4
CWP-3	CONDENSER WATER PUMP	B & G e-1510 5BD	MECH ROOM	BASE MOUNTED	14.4	900	50	8.375	-	15	1715	480/3	YES	ALT. BID # 4


SEPARATOR SCHEDULE (ALT. BID #1)

DESIGNATION	SERVICE	MANUFACTURER MODEL NUMBER	LOCATION	TYPE	WATER FLOW (GPM)	PUMP MOTOR DATA				REMARKS
						HP	RPM	VOLTS/PH	VFD	
S-1	CONDENSER WATER SYSTEM	EVOQUA LCS340	MECH ROOM	SIDESTREAM HYDROCYCLONE SEPARATOR	260	7.5	1800	480/3	NO	NOTE 1, 2, & 4

NOTE 1. PROVIDE WITH CONTROL PANEL, SEPARATOR CONTROL VALVE AND AUTO PURGE CONTROL VALVE
NOTE 2. PROVIDE WITH 1/4" TURBULATOR NOZZLES (28 PER BASIN)
NOTE 3. PROVIDE WITH STAINLESS STEEL SKID BASE
NOTE 4. PROVIDE WITH CIRCULATING PUMP.

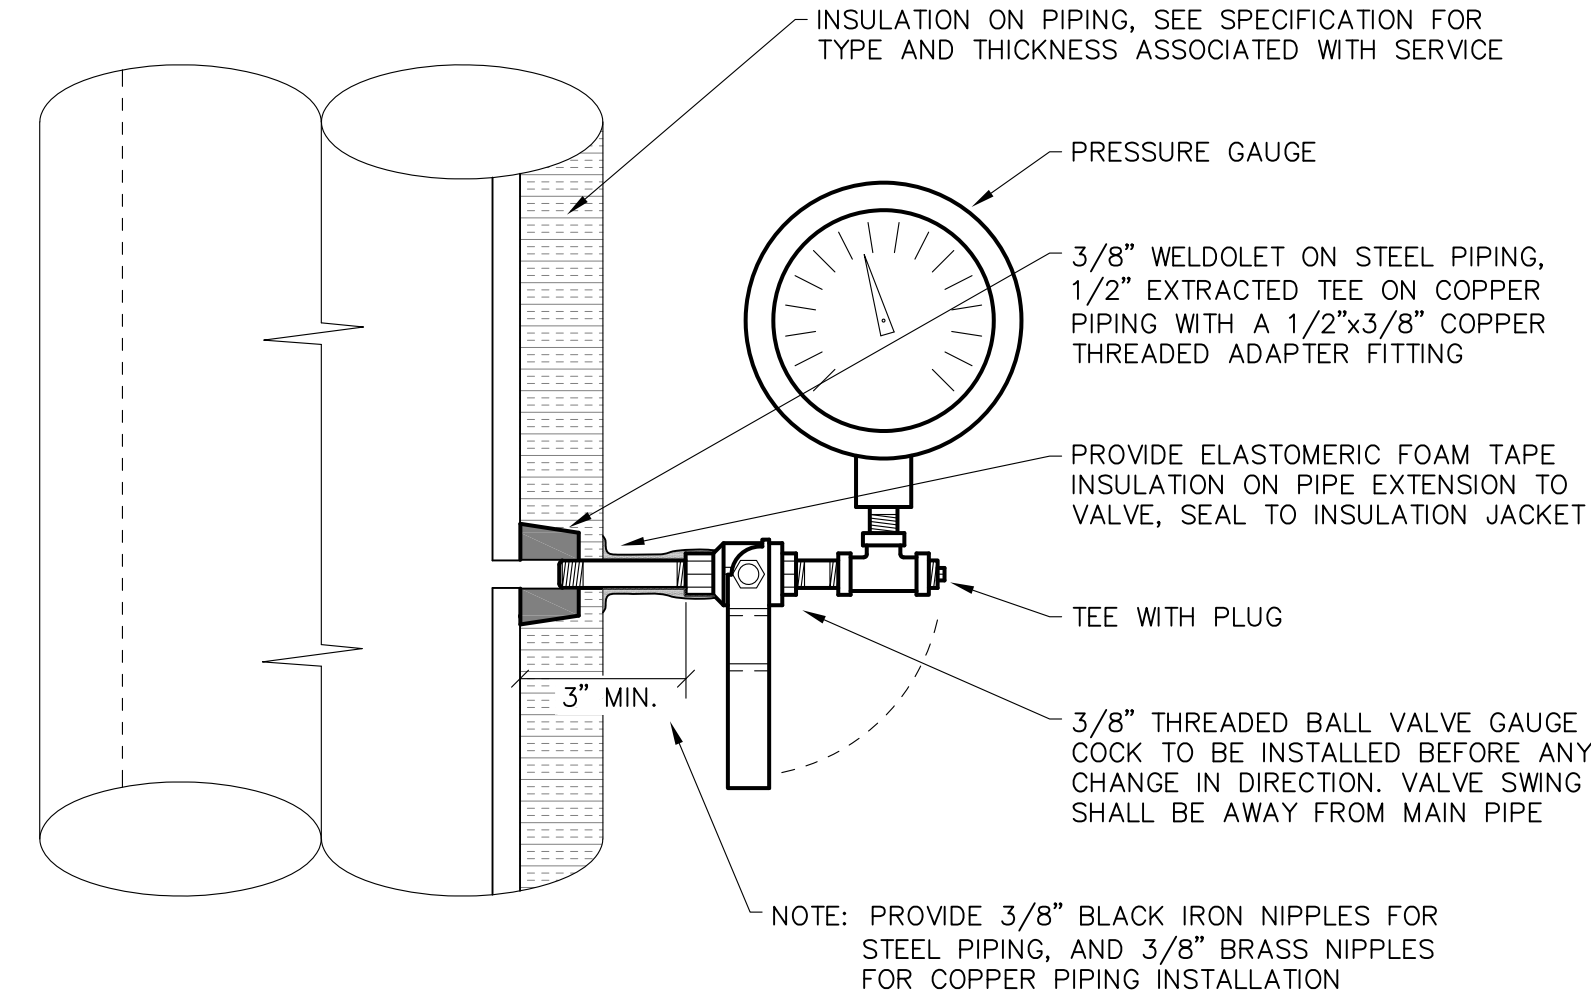


PRESSURE GAUGE INSTALLATION DETAIL
NO SCALE

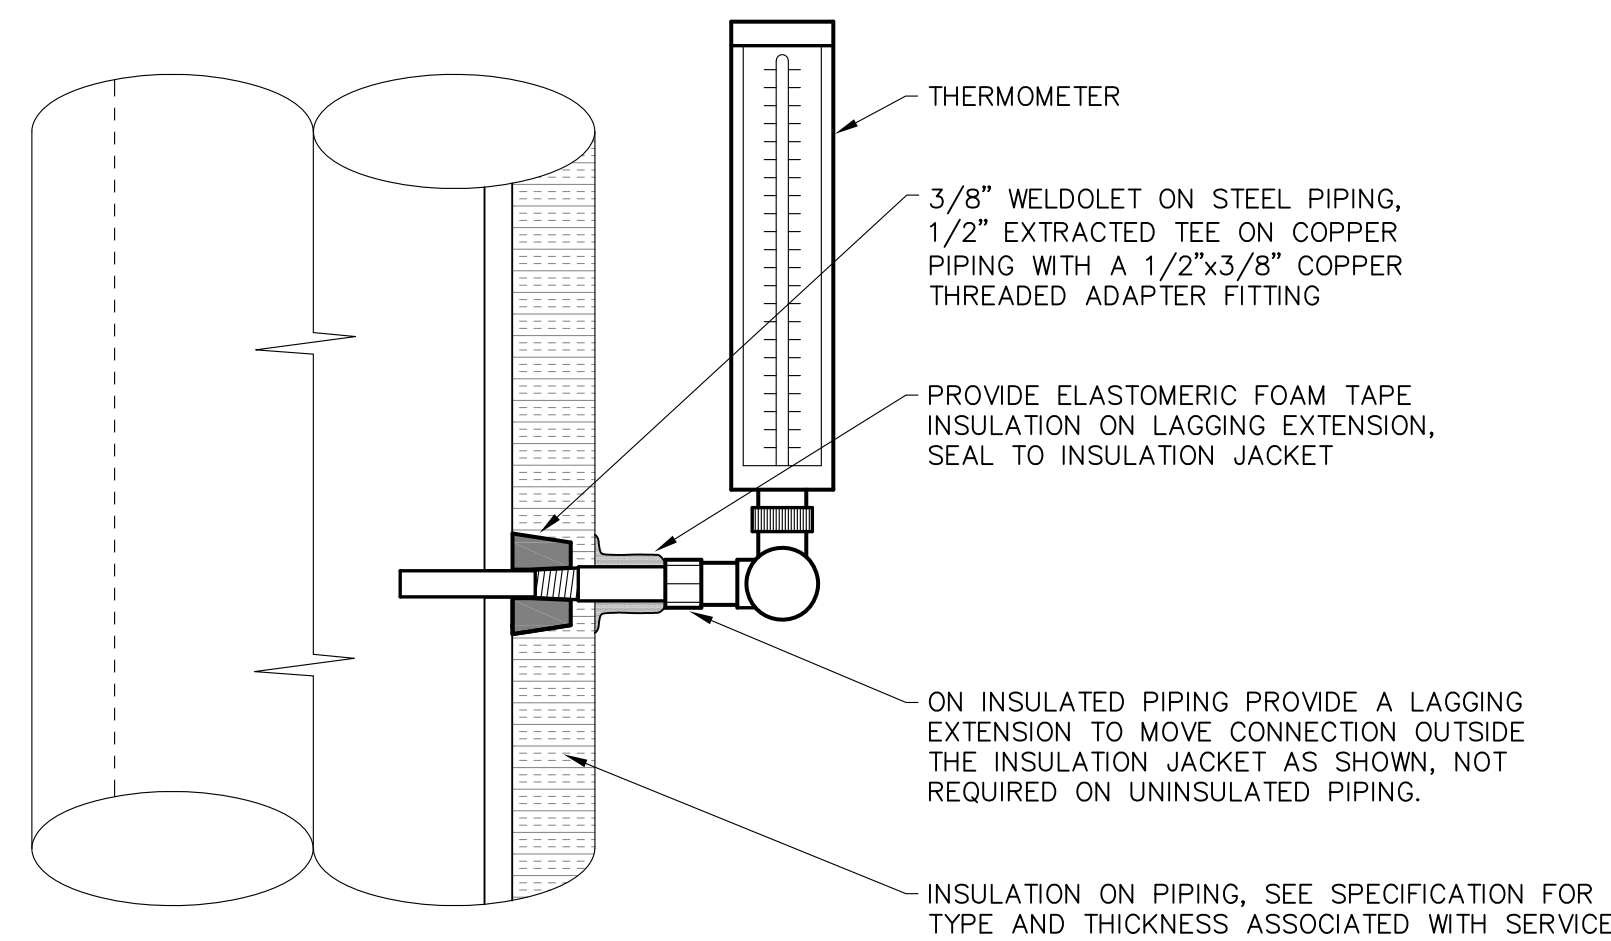


THERMOMETER INSTALLATION DETAIL
NO SCALE

NOTE: COORDINATE THERMOMETER STEM LENGTH, INSERTION LENGTH AND LAGGING EXTENSION LENGTH WITH PIPE SIZE AND INSULATION REQUIREMENTS

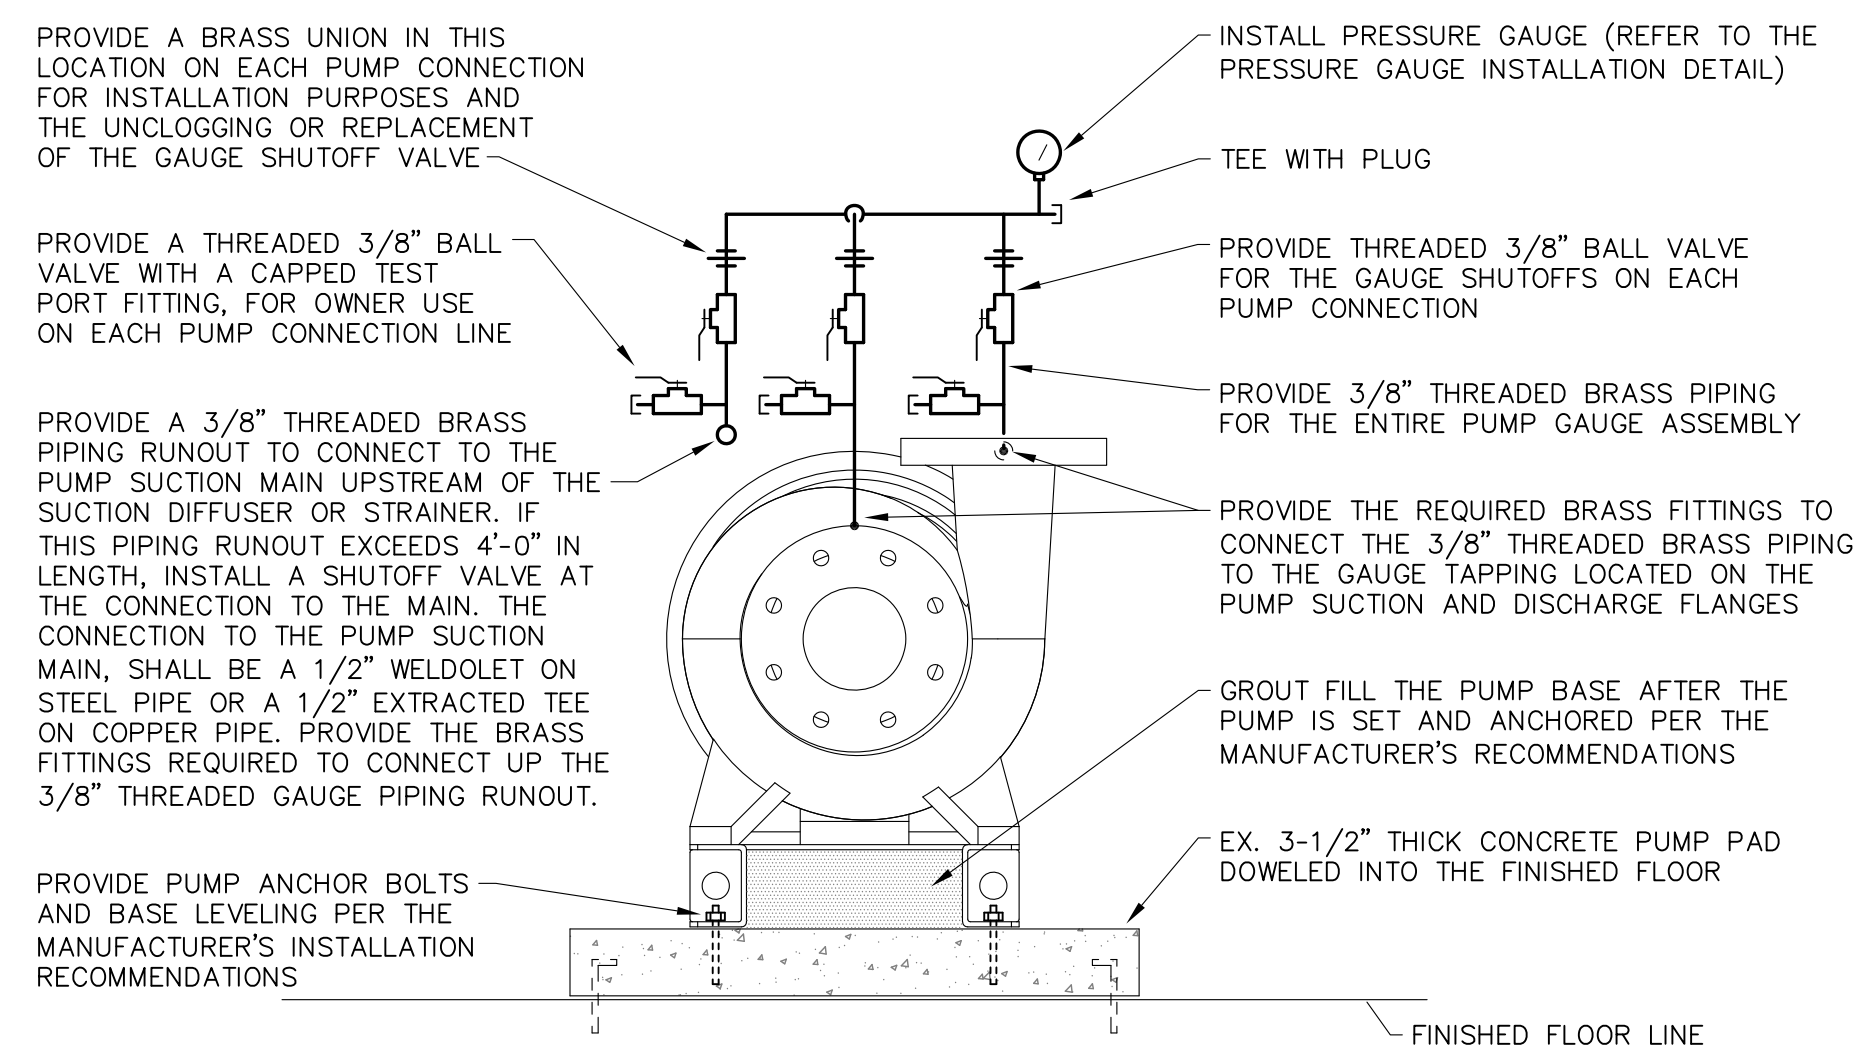

PUMP SETTING INSTALLATION DETAIL
NO SCALE

NOTE: INSTALLATION IS SIMILAR FOR DOUBLE SUCTION PUMPS

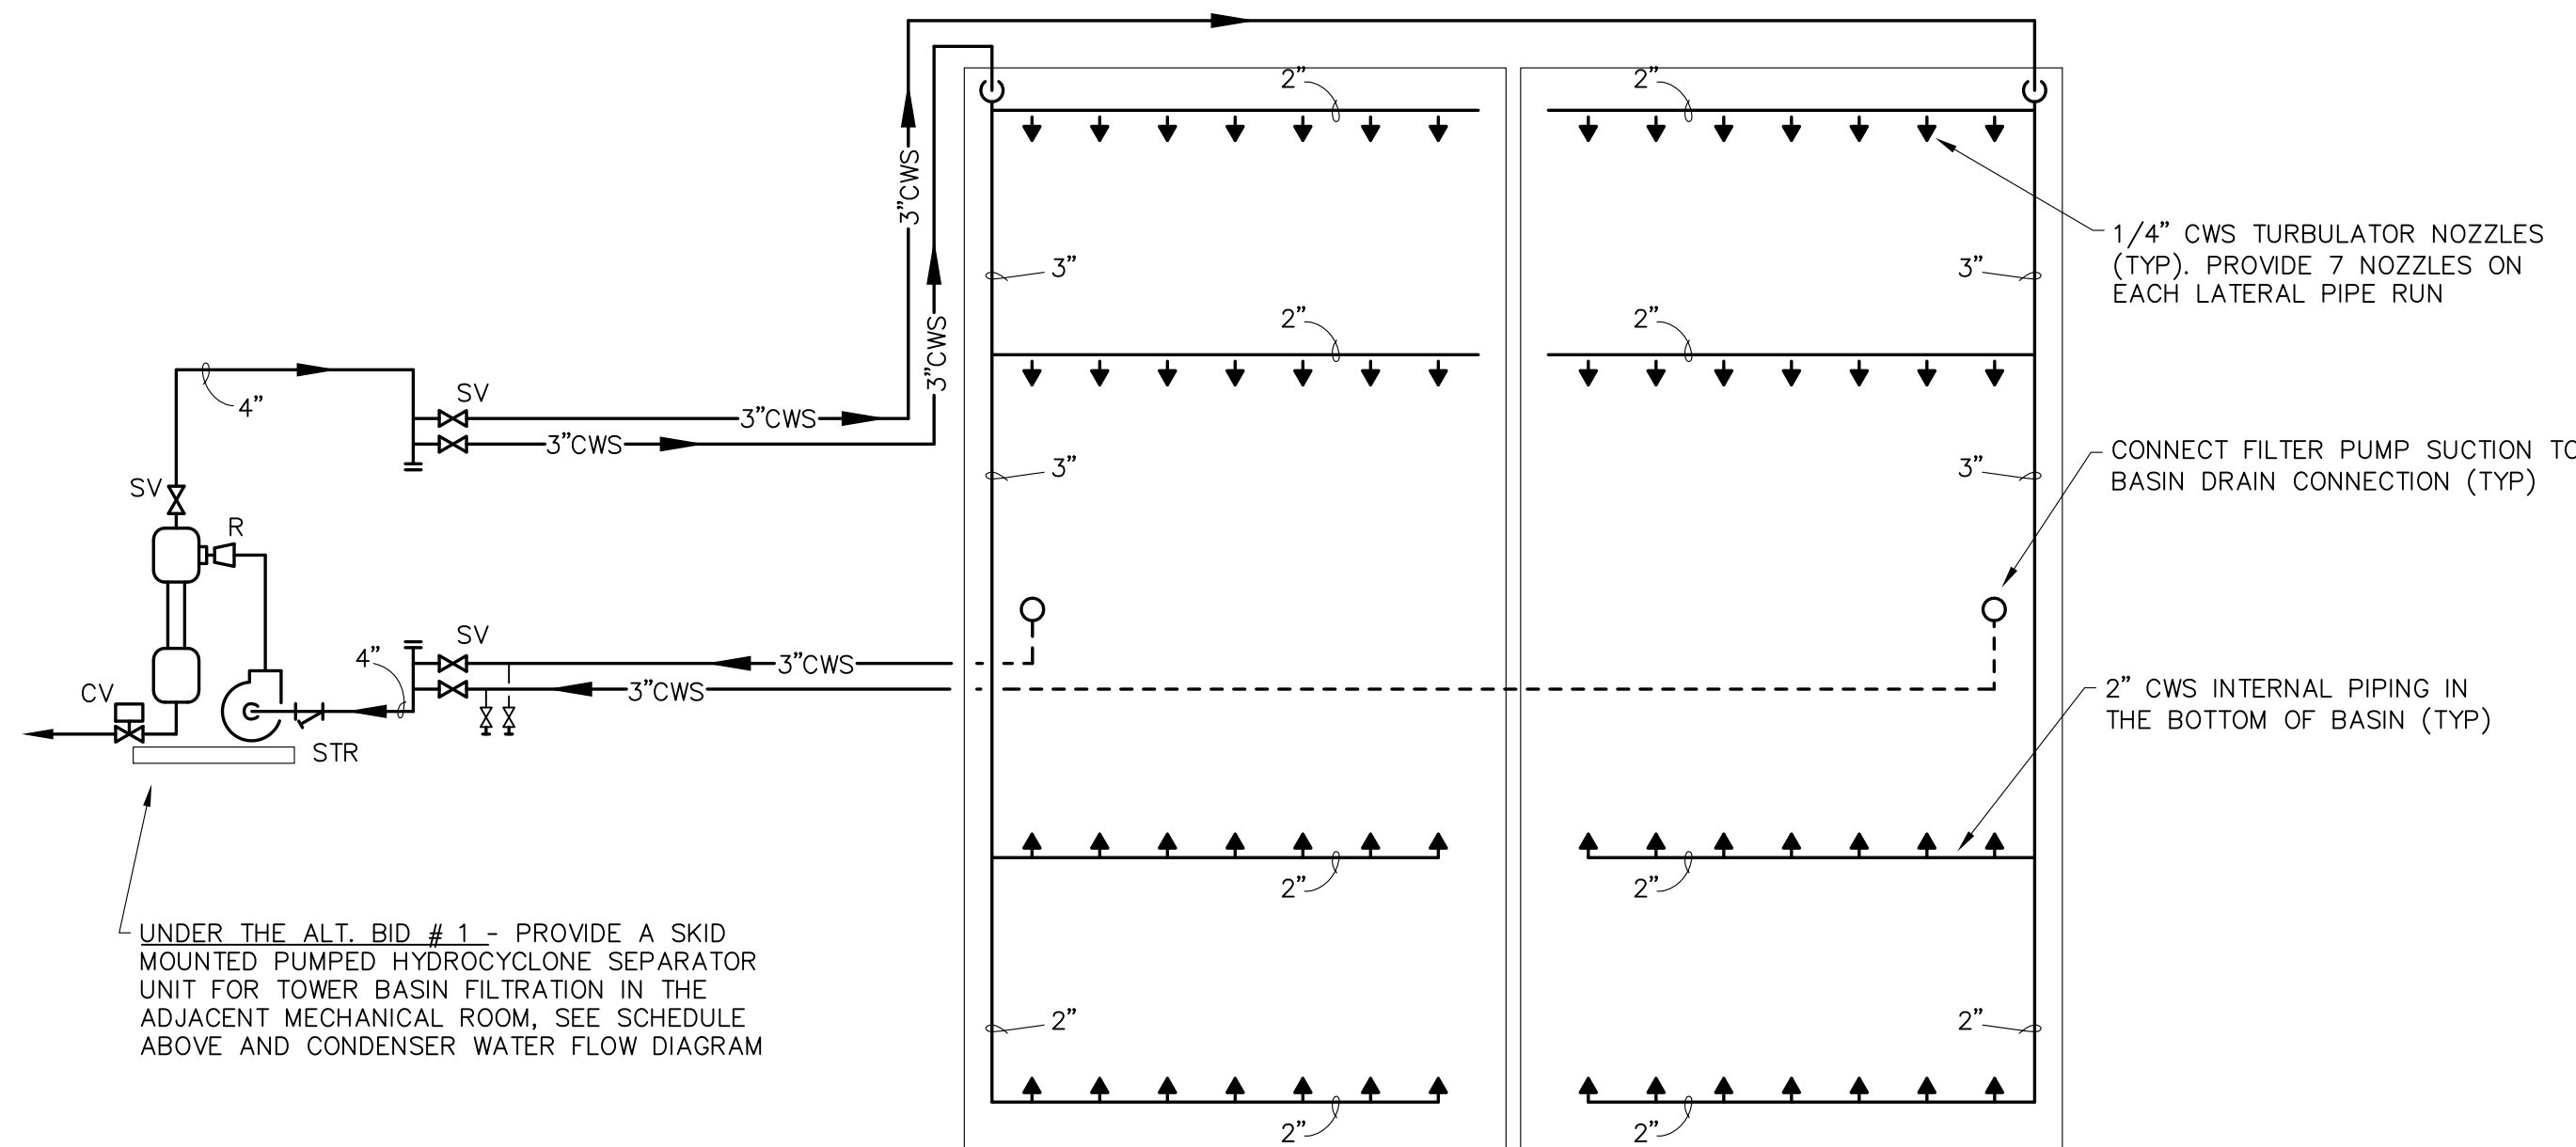

COOLING TOWER BASIN TURBULATOR PIPING DETAIL
NO SCALE

UNDER THE ALT. BID #1 - PROVIDE A SKID MOUNTED PUMPED HYDROCYCLONE SEPARATOR UNIT FOR TOWER BASIN FILTRATION IN THE ADJACENT MECHANICAL ROOM, SEE SCHEDULE ABOVE AND CONDENSER WATER FLOW DIAGRAM

ABBREVIATIONS		
A	G	P
A, AMPS AMPERES	G, GND, GRD GROUND	PF POWER FACTOR
A/C GAUGE	GA GAUGE	PH, Ø PHASE
AC ALTERNATING CURRENT	GALV GALVANIZED	PLBG PLUMBING
ADJ ADJUSTABLE	GENSET GENERATOR SET	PNL PANEL
AF AMPERE FUSE	GFCI GROUND FAULT CIRCUIT INTERRUPTER	PVC POLYVINYL CHLORIDE
AFC ABOVE FINISHED CEILING	GF I GROUND FAULT CIRCUIT INTERRUPTER	
AFB ABOVE FINISHED FLOOR		Q
AFG ABOVE FINISHED GRADE		QTY QUANTITY
AHU AIR HANDLING UNIT	H	R
AIC AMPERE INTERRUPTING CURRENT	HP HORSEPOWER	RCP REFLECTED CEILING PLAN
AL ALUMINUM	HR, HRS HOUR, HOURS	RE, REF REFERENCE, REFER
ANSI AMERICAN NATIONAL STANDARDS INSTITUTE	HSD HOUSE SIDE OPTICS	REQD REQUIRED
ARCH ARCHITECT, ARCHITECTURAL	HTR HEATER	REV REVISED, REVISION, REVISE
AUX AUXILIARY	HVAC HEATING, VENTILATION, AND AIR CONDITIONING	RGS RIGID GALVANIZED STEEL
AWG AMERICAN WIRE GAUGE	HZ HERTZ	RLA RUNNING LOAD AMPS
		RM ROOM
		RTU ROOF TOP UNIT
B	I	S
BFC BELOW FINISHED CEILING	ID INSIDE DIAMETER	SDBC SOFT-DRAWN BARE COPPER
BFG BELOW FINISHED GRADE (EARTH)	IEEE INSTITUTE OF ELECTRICAL AND ELECTRONICS	SE SERVICE ENTRANCE
BFS BELOW FLOOR SLAB	IES ILLUMINATING ENGINEERING SOCIETY	SECT SECTION
BKR BREAKER	IG ISOLATED GROUND	SHT SHEET
BLDG BUILDING		SIM SIMILAR
	J	SPEC SPECIFICATIONS
C	J-BOX JUNCTION BOX	SQ. FT., S.F. SQUARE FEET
C CONDUIT		SS STAINLESS STEEL
CATV CABLE TELEVISION SYSTEM	K	STD STANDARD
CCTV CLOSED CIRCUIT TELEVISION	KAIC 1000 AMPS INTERRUPTING CURRENT	SURF SURFACE
C.I. CUBIC INCHES	KCML 1000 CIRCULAR MILS	SUSP SUSPEND
CKT CIRCUIT	KO KNOCKOUT	SW SWITCH
CL CENTERLINE	KV KILOVOLT	
CLG CEILING	KVA KILOVOLT-AMPERE	T
COORD COORDINATE	KW KILOWATT	TELECOM TELECOMMUNICATIONS
CSA COLOR SELECTED BY ARCHITECT	KWH KILOWATT-HOUR	TGB TELECOM GROUNDING BUSBAR
CU, C/U COPPER, CONDENSING UNIT		TGMB TELECOM GROUNDING MAIN BUSBAR
	L	THD TOTAL HARMONIC DISTORTION
D	LF LINEAR FEET	THRU THROUGH
DDC HVAC DIGITAL CONTROL PANEL	LV LOW VOLTAGE	TYP TYPICAL
DEMO, DEMO'D DEMOLISH, DEMOLISHED		U
DIA DIAMETER	M	U/F UNDERFLOOR
DISC. SW., D/S DISCONNECT SWITCH	MAX MAXIMUM	UG UNDERGROUND
DN DOWN	MCA MINIMUM CIRCUIT AMPACITY	UGE UNDERGROUND ELECTRIC
DWG DRAWING	MCB MAIN CIRCUIT BREAKER	UH UNIT HEATER
	MD MOTORIZED DAMPER	UL UNDERWRITERS LABORATORIES, INC.
E	MDP MAIN DISTRIBUTION PANEL	UON, UNO UNLESS OTHERWISE NOTED
EA EACH	MECH MECHANICAL	UPS UNINTERRUPTIBLE POWER SUPPLY
EC ELECTRICAL CONTRACTOR	MFGR, MANUF. MANUFACTURER	
EF, EXH FAN EXHAUST FAN	MLO MAIN LUGS ONLY	V
ELEC ELECTRICAL	MIN MINUTE, MINIMUM	V VOLT
EM EMERGENCY FIXTURE	MOC, MOC/PD MAX. OVERCURRENT PROTECTIVE DEVICE MOUNTED	VA VOLT-AMPERE
ENCL ENCLOSURE		VFD VARIABLE FREQUENCY DRIVE
EPO EMERGENCY POWER OFF	N	
EQUIP EQUIPMENT	N. NEUTRAL	W
ETR EXISTING EQUIPMENT TO REMAIN	N.C. NORMALLY CLOSED	W WATT, WIDTH
EWC ELECTRICAL WATER COOLER	N.L. NIGHT LIGHT (FIXTURE ON 24 HRS)	W/ WITH
	N.T.S. NOT TO SCALE	W/O WITHOUT
F	N/A NOT APPLICABLE	WH WATER HEATER
FA FIRE ALARM	NEC NATIONAL ELECTRIC CODE	WP WEATHER-PROOF
FACP FIRE ALARM CONTROL PANEL	NEMA NATIONAL ELECTRIC MANUFACTURER'S ASSOCIATION	
FD FIRE DAMPER	NIF NON-USED	X
FEP HVAC FIELD EQUIP RELAY PANEL	NFPA NATIONAL FIRE PROTECTION ASSOCIATION	XFMR TRANSFORMER
FLA FULL LOAD AMPS	NIC NOT IN CONTRACT	XSTG EXISTING
FLEX FLEXIBLE		
FM FACTORY MUTUAL	O	
	O.C. ON CENTER	
	OD OUTSIDE DIAMETER	

NOTE: REFER TO INDUSTRY STANDARDS, APPLICABLE CODES, AND PLAN DOCUMENTS OF ALL DISCIPLINES FOR MORE INFORMATION ON ABBREVIATIONS AND NOMENCLATURE.

GENERAL NOTES


- EACH CIRCUIT SHALL HAVE AN EQUIPMENT GROUNDING CONDUCTOR, AND MULTI-WIRE CIRCUITS OF DIFFERENT PHASES MAY SHARE EQUIPMENT GROUND CONDUCTOR. EQUIPMENT GROUND CONDUCTOR SIZE SHALL NOT BE LESS THAN #12 AWG OR AS INDICATED ON THE DRAWINGS.
- ALL CONDUCTORS #10 AND SMALLER SHALL BE SOLID COPPER, AND ALL CONDUCTORS #8 AND LARGER SHALL BE STRANDED COPPER USING BOLTED LUGS AT TERMINALS.
- MINIMUM CONDUIT SIZE SHALL BE 3/4" UNLESS OTHERWISE NOTED.
- ALL WIRING DEVICES SHALL BE INSTALLED PLUMB, SQUARE, AND TRUE; AND ALL DEVICES INSTALLED AT A SINGLE LOCATION SHALL BE ALIGNED.
- MINIMUM WIRE SIZE SHALL BE #12 AWG UNLESS OTHERWISE SPECIFIED.
- ALL WORK SHALL COMPLY WITH THE 2020 EDITION OF THE NATIONAL ELECTRICAL CODE. CONTRACTOR SHALL REFER TO THE EQUIPMENT DRAWINGS AND DETAILS FOR EXACT LOCATIONS OF ALL WIRING DEVICES.
- ALL CONDUIT SHALL BE INSTALLED AS HIGH AS POSSIBLE (MOUNT TO BOTTOM OF STRUCTURE) TO AVOID CONFLICTS WITH DUCTWORK AND PIPING. THE ELECTRICAL CONTRACTOR SHALL COORDINATE INSTALLATION WITH THE MECHANICAL CONTRACTOR.
- ON THREE PHASE, FOUR WIRE SYSTEMS, DO NOT USE A COMMON NEUTRAL MORE THAN THREE CIRCUITS IN ANY ONE CONDUIT IS NOT ALLOWED WITHOUT WRITTEN PERMISSION FROM THE ENGINEER.

GENERAL DEMOLITION NOTES

- ALL EXISTING BRANCH CIRCUITS NOT USED SHALL BE REMOVED BACK TO PANEL. THE CIRCUIT BREAKERS SHALL BE LABELED AS SPARE, AND EXISTING CONDUIT SHALL REMAIN FROM PANEL TO ABOVE ACCESSIBLE CEILING SPACE.
- THIS CONTRACTOR SHALL BE RESPONSIBLE FOR ALL DEMOLITION IN AREAS OF RENOVATION. ALL WIRING DEVICES, LIGHT FIXTURES, WIRE, AND CONDUIT THAT IS TO BE REMOVED SHALL BE STORED, AS DIRECTED BY THE OWNER, OR RELOCATED, AS SHOWN ON THE NEW FLOOR PLANS. APPROPRIATE MEASURES SHALL BE TAKEN TO ASSURE CONTINUITY OF EXISTING CIRCUITS WHERE REQUIRED. ALL OUTAGES WHICH MAY RESULT SHALL BE COORDINATED WITH THE OWNER PRIOR TO THE WORK.
- THE ELECTRICAL CONTRACTOR SHALL BE RESPONSIBLE FOR UPDATING SCHEDULES IN ALL ELECTRICAL PANELS THAT ARE AFFECTED BY THIS WORK. UPDATED SCHEDULES ARE TO BE TYPEWRITTEN.
- THE ELECTRICAL CONTRACTOR SHALL BE RESPONSIBLE FOR MARKING ALL SWITCHES, RECEPTACLES, AND FIXED EQUIPMENT WITH THE BRANCH CIRCUIT PANEL NAME AND NUMBER SERVING EACH DEVICE.

1 VFD DISCONNECT DETAIL

SCALE: NONE

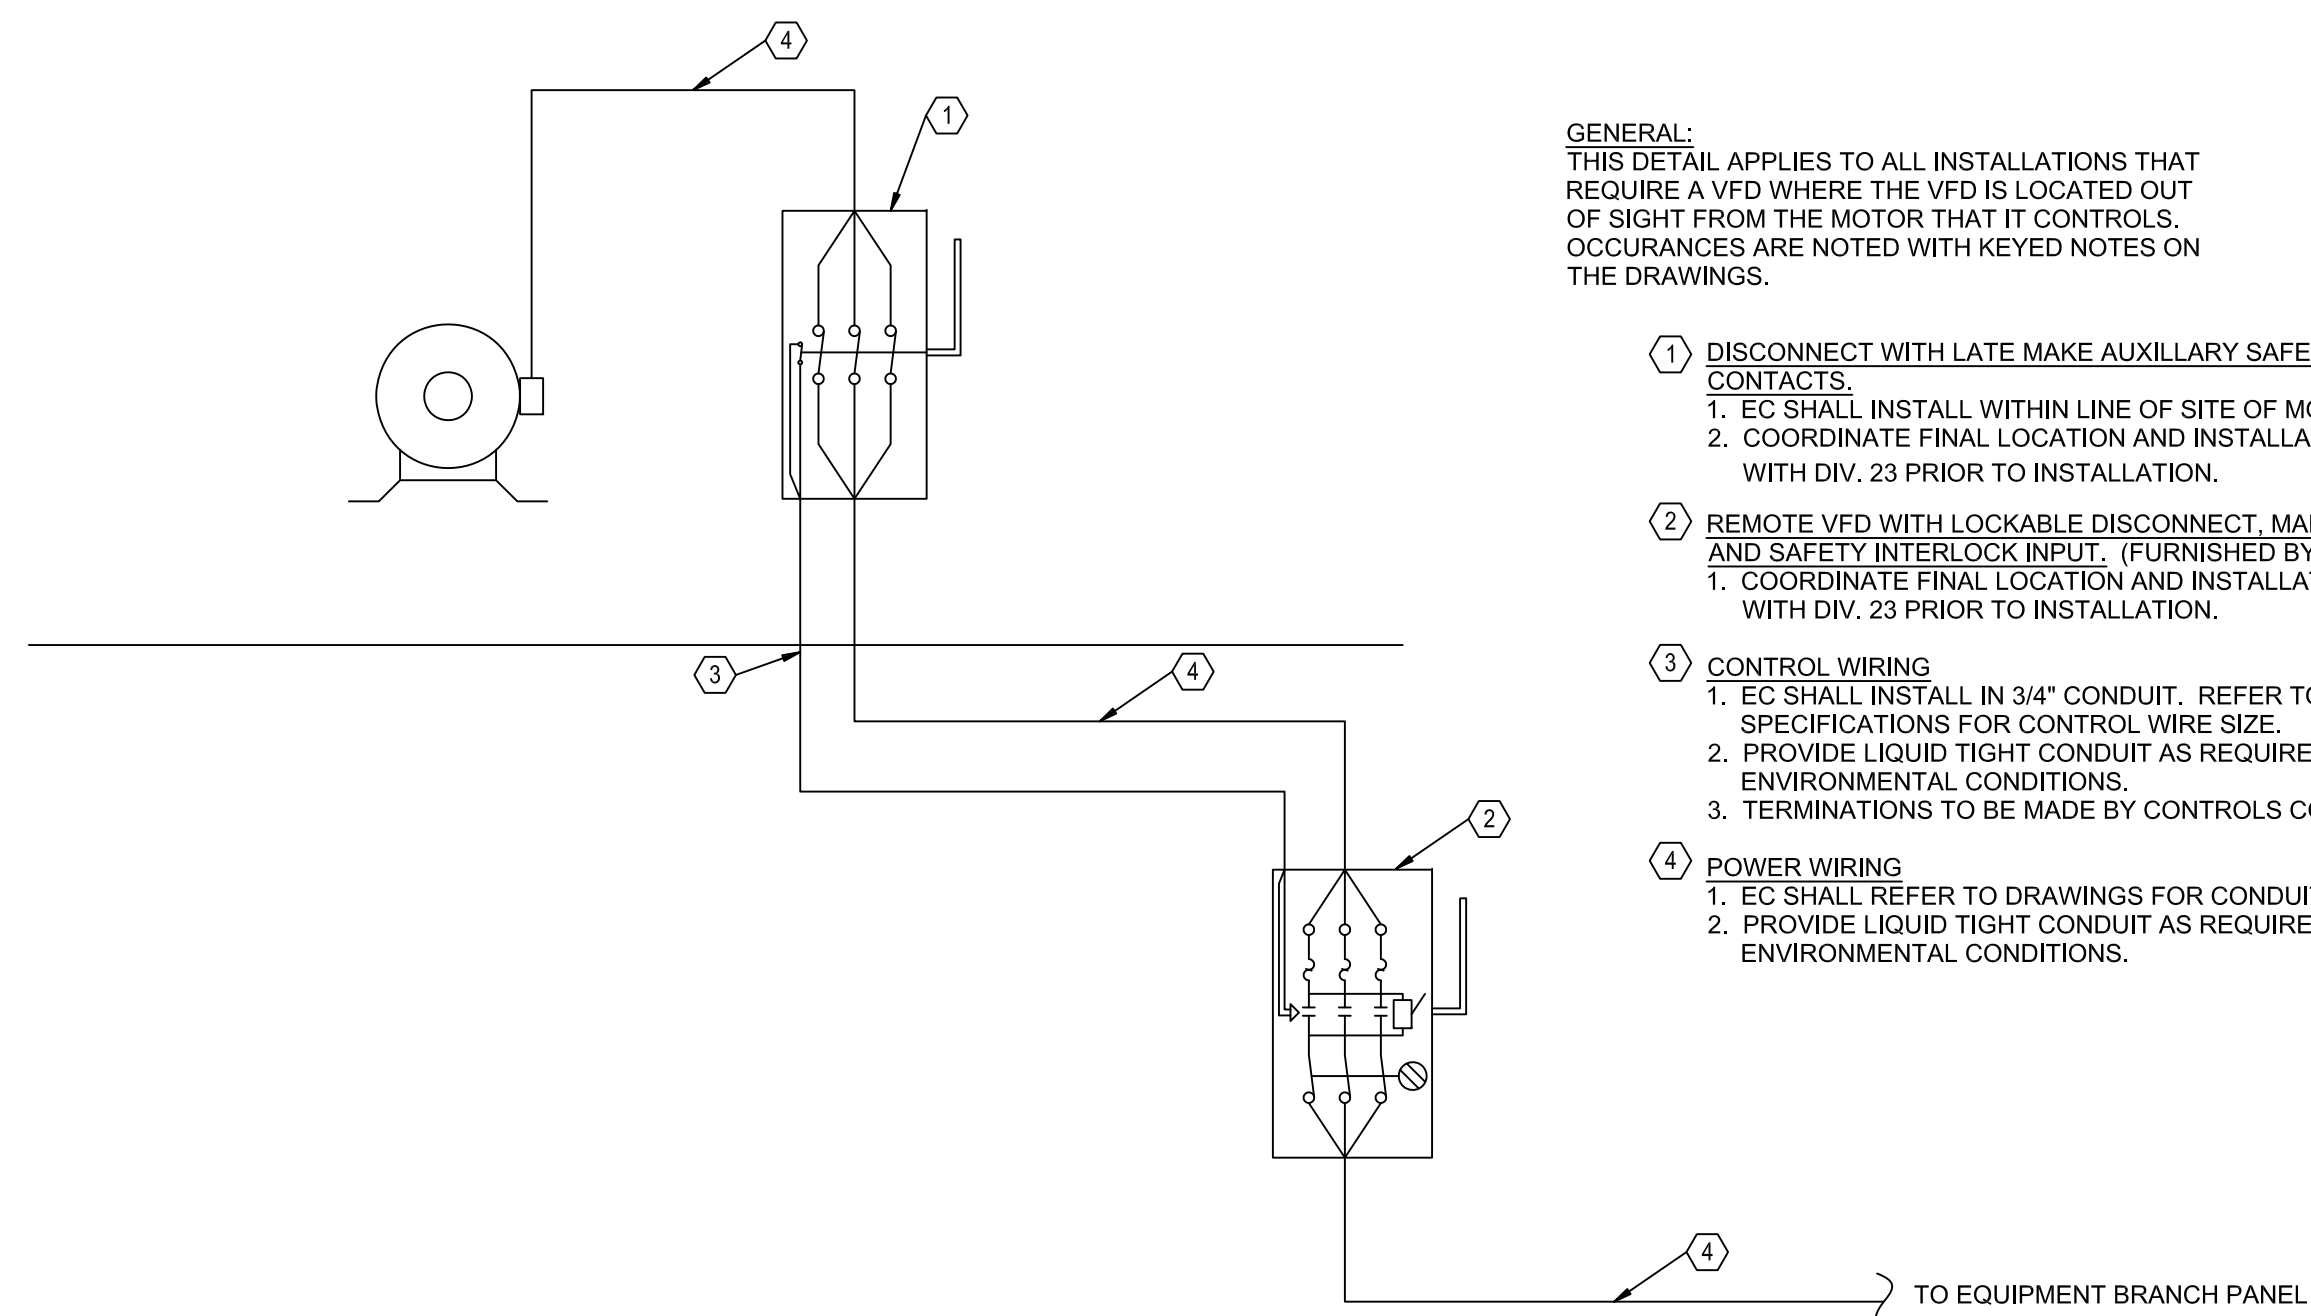

GENERAL:
THIS DETAIL APPLIES TO ALL INSTALLATIONS THAT REQUIRE A VFD WHERE THE VFD IS LOCATED OUT OF SIGHT FROM THE MOTOR THAT IT CONTROLS. OCCURRENCES ARE NOTED WITH KEYED NOTES ON THE DRAWINGS.

- DISCONNECT WITH LATE MAKE AUXILIARY SAFETY INTERLOCK CONTACTS.
1. EC SHALL INSTALL WITHIN LINE OF SITE OF MOTOR.
2. COORDINATE FINAL LOCATION AND INSTALLATION METHOD WITH DIV. 23 PRIOR TO INSTALLATION.
- REMOTE VFD WITH LOCKABLE DISCONNECT, MANUAL BYPASS AND SAFETY INTERLOCK INPUT. (FURNISHED BY DIV. 23.)
1. COORDINATE FINAL LOCATION AND INSTALLATION METHOD WITH DIV. 23 PRIOR TO INSTALLATION.
- CONTROL WIRING
1. EC SHALL INSTALL IN 3/4" CONDUIT. REFER TO PROJECT SPECIFICATIONS FOR CONTROL WIRE SIZE.
2. PROVIDE LIQUID TIGHT CONDUIT AS REQUIRED BY ENVIRONMENTAL CONDITIONS.
3. TERMINATIONS TO BE MADE BY CONTROLS CONTRACTOR.
- POWER WIRING
1. EC SHALL REFER TO DRAWINGS FOR CONDUIT AND WIRE SIZE.
2. PROVIDE LIQUID TIGHT CONDUIT AS REQUIRED BY ENVIRONMENTAL CONDITIONS.

1

SCALE: NONE

TO EQUIPMENT BRANCH PANEL

VFD DISCONNECT DETAIL

SCALE: NONE

TO EQUIPMENT BRANCH PANEL

VFD DISCONNECT DETAIL

SCALE: NONE

TO EQUIPMENT BRANCH PANEL

These design drawings have been altered to indicate as-built information supplied by the construction contractor. The Engineer-of-Record is not responsible for the accuracy of said information. A record of as-designed drawings are maintained by the Owner.



BERNHARD TME ENGINEERING
622 Emerson Road, Suite 250
St. Louis, MO 63141 • 314-727-8760
MO Certificate of Authority No. 2009021478



2/14/23

OFFICE OF ADMINISTRATION
DIVISION OF FACILITIES
MANAGEMENT,
DESIGN AND CONSTRUCTION
DEPARTMENT OF
MENTAL HEALTH

REPLACE COOLING TOWERS
SAINT LOUIS FORENSIC
TREATMENT CENTER - NORTH
SAINT LOUIS, MISSOURI

PROJECT # M2015-01
SITE # 7391
ASSET # 6517391002

REVISION: _____
DATE: _____
REVISION: _____
DATE: _____
REVISION: _____
DATE: _____
ISSUE DATE: 02/14/2023


CAD DWG FILE: M2015-01 ED-101.DWG
DRAWN BY: JBM
CHECKED BY: VUP
DESIGNED BY: GDL

SHEET TITLE:
**PARTIAL ROOF
DEMOLITION PLAN**

SHEET NUMBER:

ED-101

SHEET 12 OF 15
FEBRUARY 14, 2023

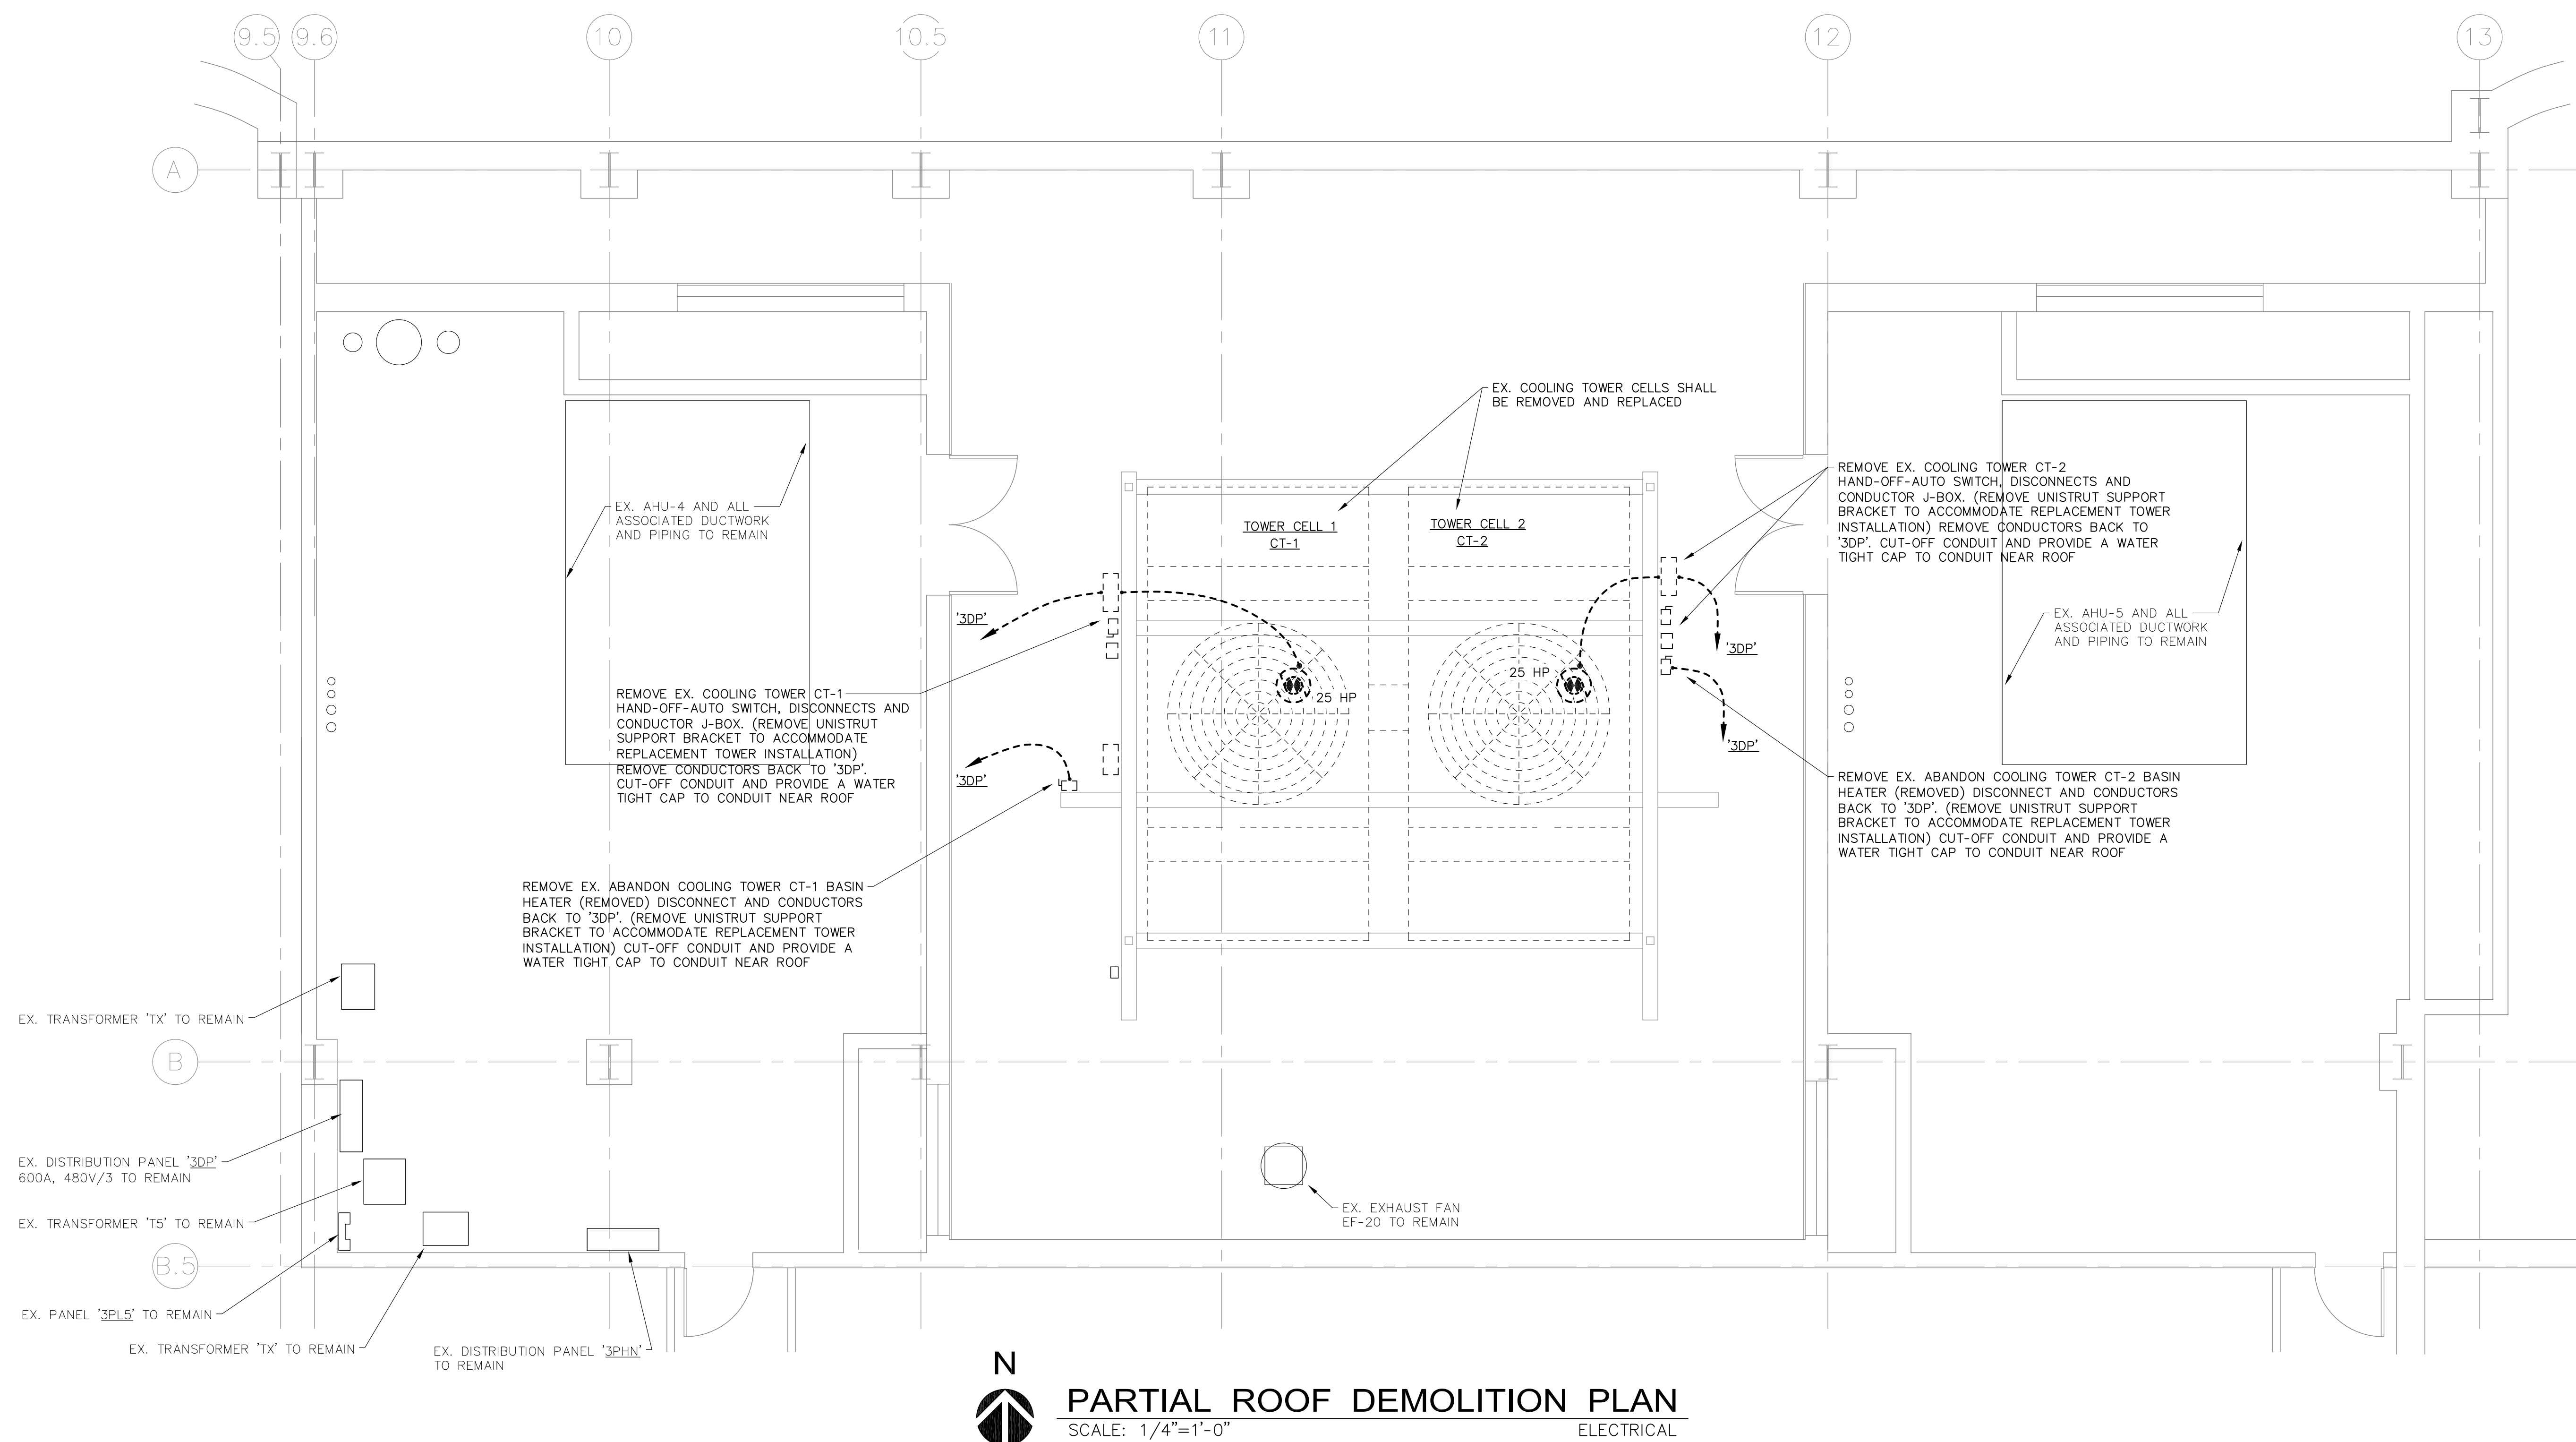

PARTIAL ROOF DEMOLITION PLAN
SCALE: 1/4"=1'-0" ELECTRICAL

M2015-01 ED-101.dwg, 2/13/2023 4:46 PM, jbmrcn

These design drawings have been altered to indicate as-built information supplied by the construction contractor. The Engineer-of-Record is not responsible for the accuracy of said information. A record of as-designed drawings are maintained by the Owner.



BERNHARD TME ENGINEERING
622 Emerson Road, Suite 250
St. Louis, MO 63141 • 314-727-8760
MO Certificate of Authority No. 2009021478



2/14/23

OFFICE OF ADMINISTRATION
DIVISION OF FACILITIES
MANAGEMENT,
DESIGN AND CONSTRUCTION
DEPARTMENT OF
MENTAL HEALTH

REPLACE COOLING TOWERS
SAINT LOUIS FORENSIC
TREATMENT CENTER - NORTH
SAINT LOUIS, MISSOURI

PROJECT # M2015-01
SITE # 7391
ASSET # 6517391002

REVISION: _____
DATE: _____
REVISION: _____
DATE: _____
REVISION: _____
DATE: _____
ISSUE DATE: 02/14/2023

CAD DWG FILE: M2015-01 ED-102.DWG
DRAWN BY: JBM
CHECKED BY: VUP
DESIGNED BY: GDL


SHEET TITLE:

PARTIAL FIRST FLR.
PLAN - MAIN EQUIP.
ROOM DEMO

SHEET NUMBER:

ED-102

SHEET 13 OF 15
FEBRUARY 14, 2023

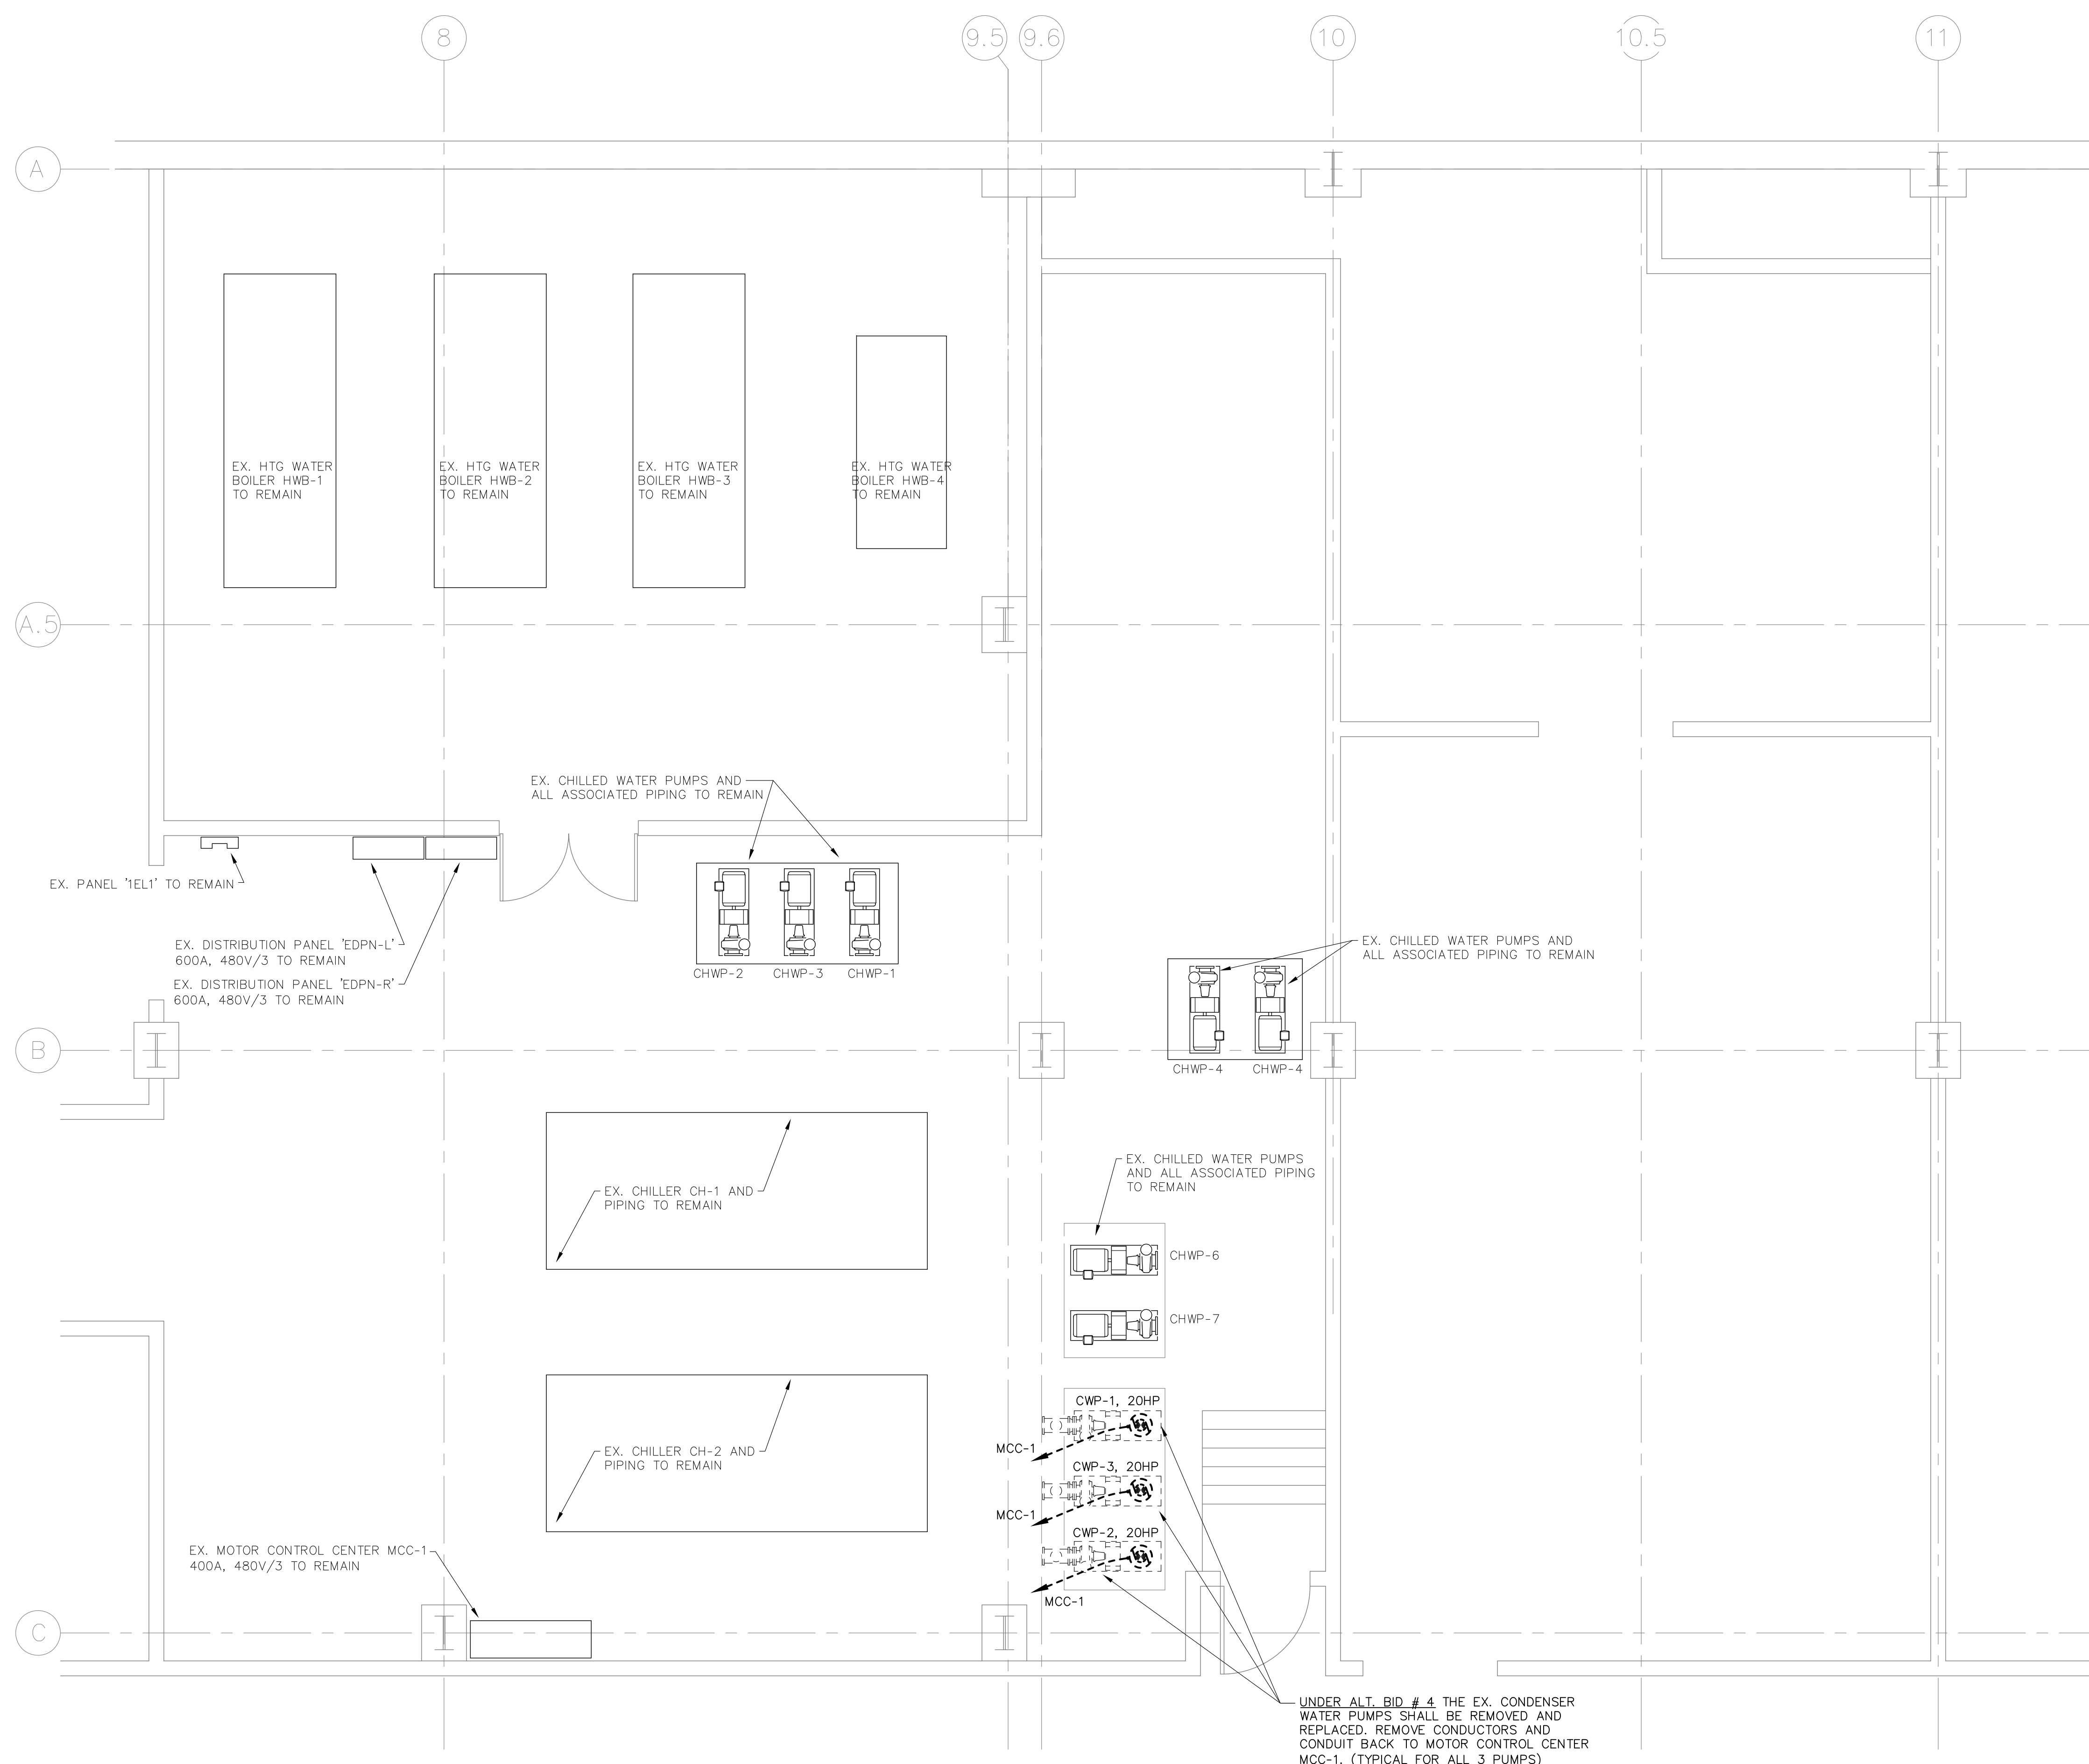

PARTIAL FIRST FLOOR PLAN - MAIN MECHANICAL DEMOLITION

SCALE: 1/4"=1'-0"

ELECTRICAL (ALT BID # 4)

These design drawings have been altered to indicate as-built information supplied by the construction contractor. The Engineer-of-Record is not responsible for the accuracy of said information. A record of as-designed drawings are maintained by the Owner.



BERNHARD TME ENGINEERING
622 Emerson Road, Suite 250
St. Louis, MO 63141 • 314-727-8760
MO Certificate of Authority No. 2009021478



2/14/23

OFFICE OF ADMINISTRATION
DIVISION OF FACILITIES
MANAGEMENT,
DESIGN AND CONSTRUCTION
DEPARTMENT OF
MENTAL HEALTH

REPLACE COOLING TOWERS
SAINT LOUIS FORENSIC
TREATMENT CENTER - NORTH
SAINT LOUIS, MISSOURI

PROJECT # M2015-01
SITE # 7391
ASSET # 6517391002

REVISION: _____
DATE: _____
REVISION: _____
DATE: _____
REVISION: _____
DATE: _____
ISSUE DATE: 02/14/2023

CAD DWG FILE: M2015-01 E-101.DWG
DRAWN BY: JBM
CHECKED BY: VUP
DESIGNED BY: GDL


SHEET TITLE:

PARTIAL ROOF
PLAN - NEW WORK

SHEET NUMBER:

E-101

SHEET 14 OF 15
FEBRUARY 14, 2023

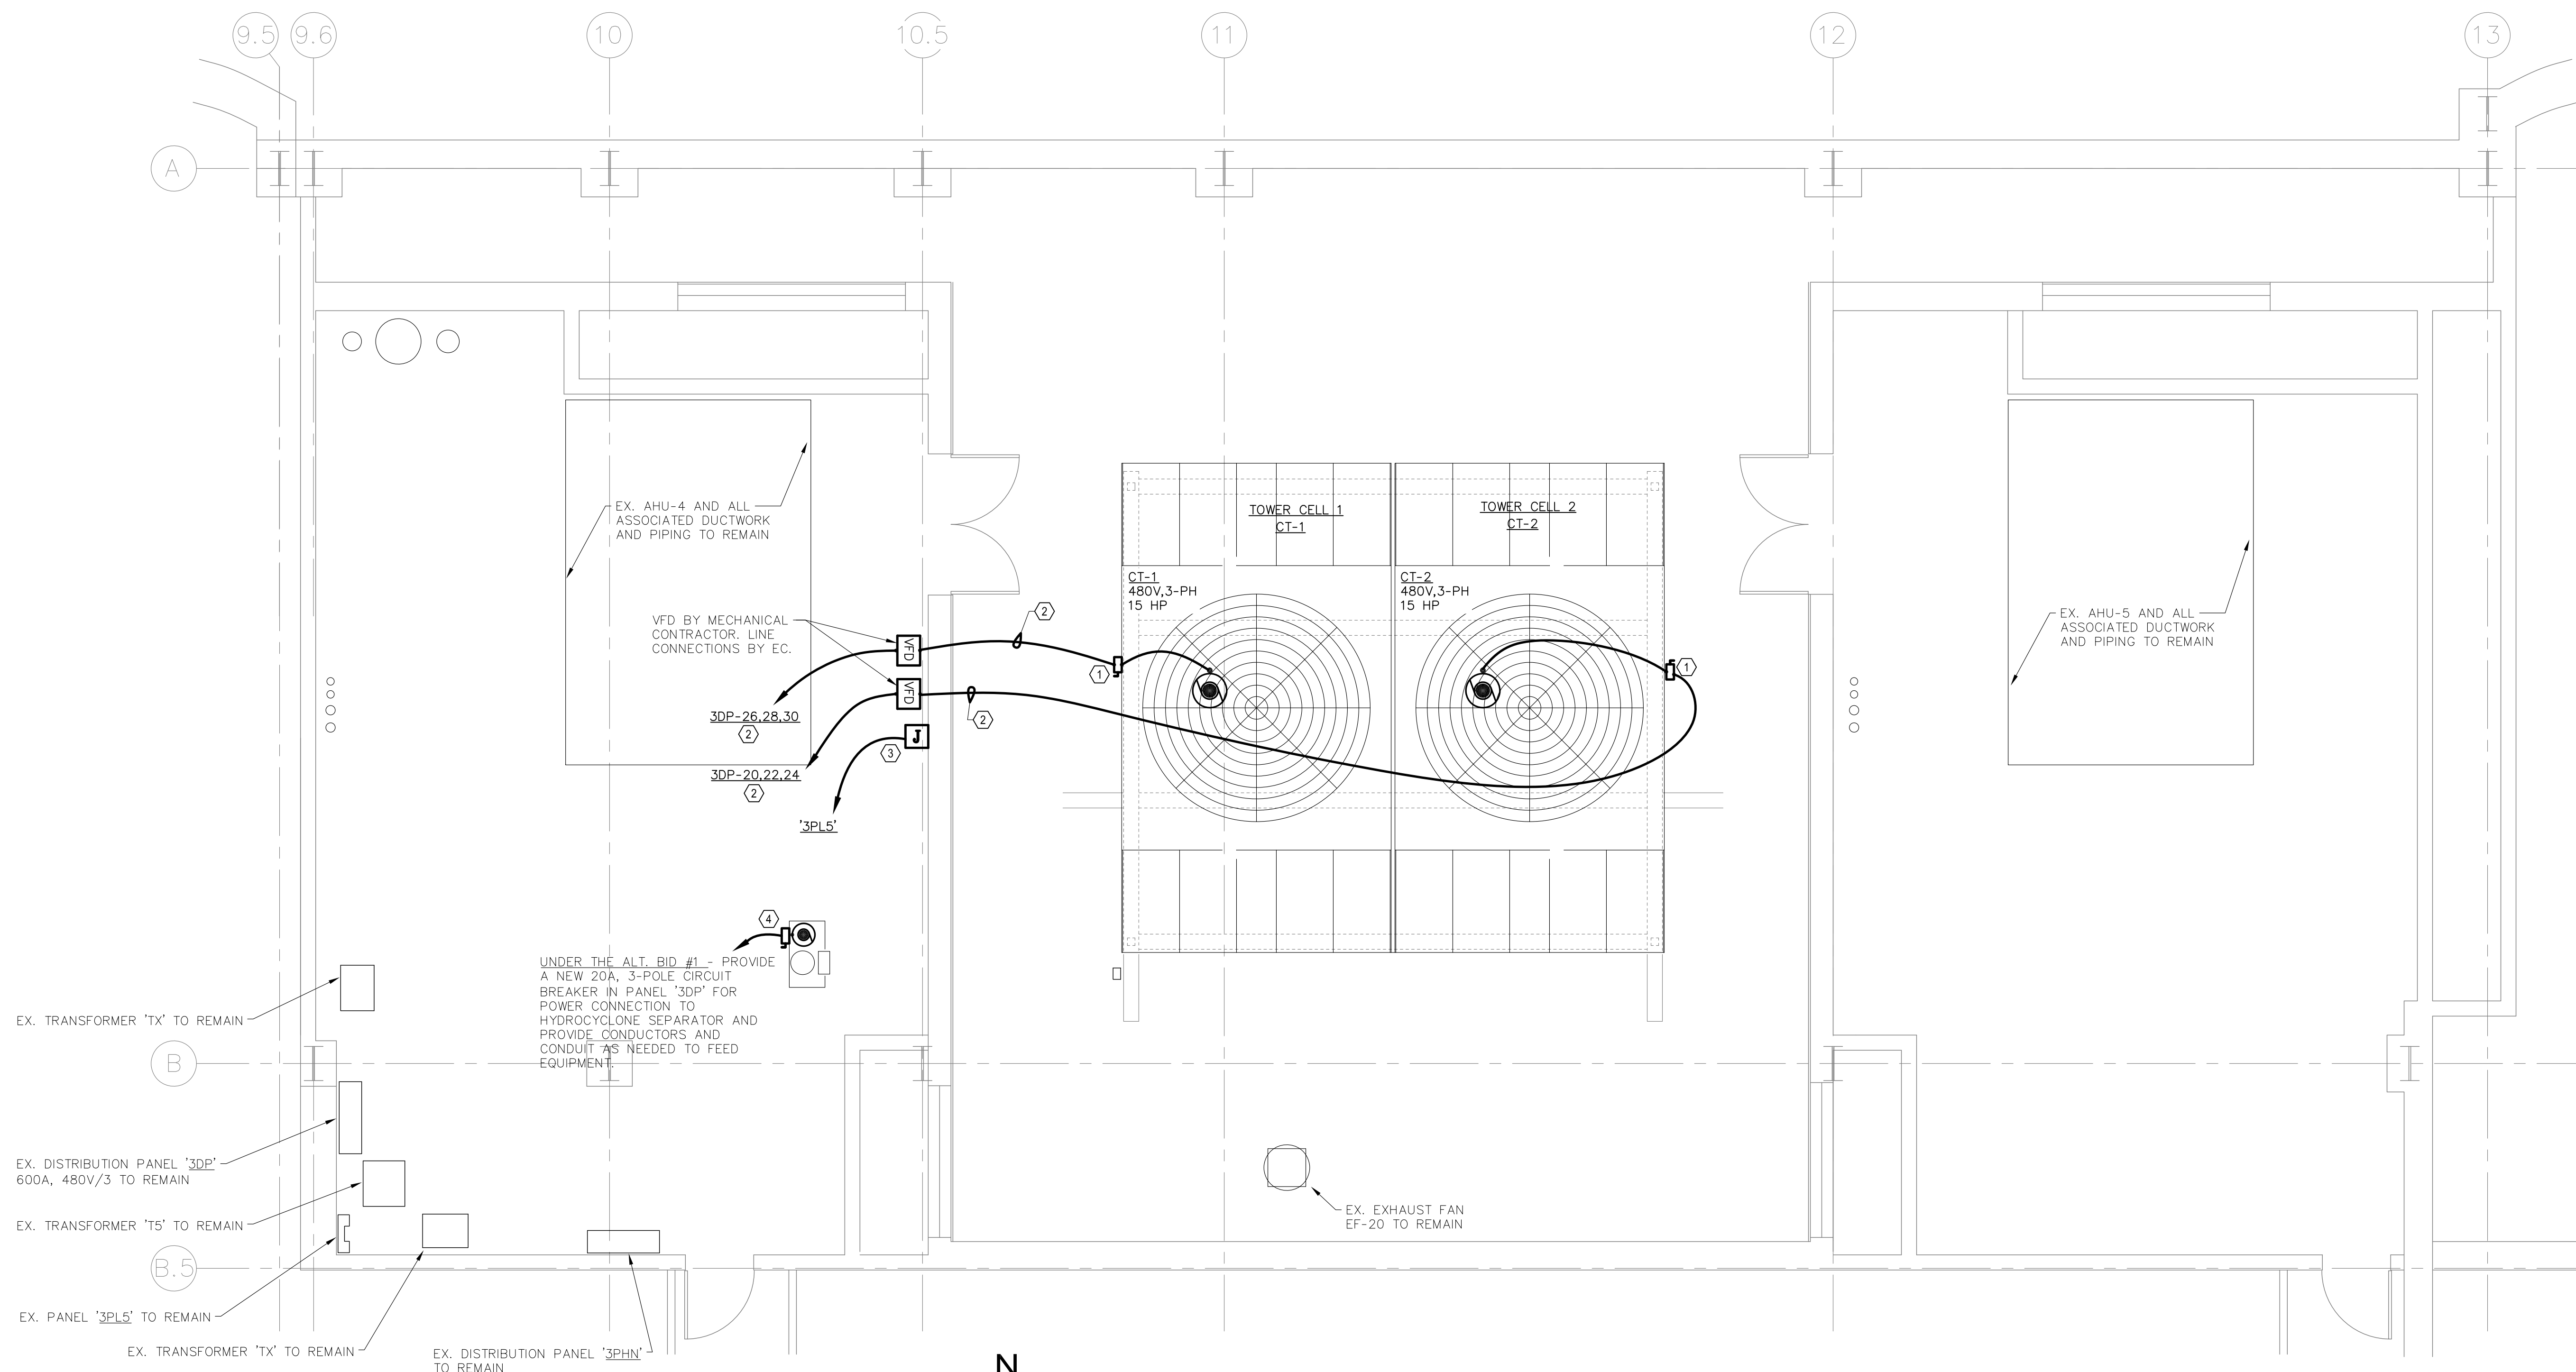

PARTIAL ROOF PLAN - NEW WORK

SCALE: 1/4"=1'-0"

ELECTRICAL

KEYED NOTES:

- ① PROVIDE A 600V, 60A, 3P, NEMA-3X, HEAVY DUTY REMOTE NON-FUSED DISCONNECT SWITCH. REFER TO REMOTE VFD/DISCONNECT DETAIL 01 ON SHEET E-001. COORDINATE EXACT LOCATION WITH MECHANICAL CONTRACTOR.
- ② REPLACE THE EXISTING 70A BREAKER FEEDING THE EXISTING COOLING TOWERS WITH A NEW 50A, 3P BREAKER. PROVIDE (3)#10, (1)#10G, CONDUCTORS IN EXISTING CONDUIT. EXTEND CONDUIT AS NEEDED TO CONNECT TO NEW TOWERS. REFER TO DETAIL 01 ON SHEET E-001.
- ③ UNDER ALT. BID #2 PROVIDE 120V/1PH, POWER CONNECTION TO ELECTRONIC WATER CONTROL SYSTEM. CONNECT TO THE NEXT AVAILABLE CIRCUIT IN PANEL '3PLS' WITH 1-POLE, 20A CIRCUIT BREAKER.
- ④ UNDER ALT. BID#1 PROVIDE A 30A, 3P, NEMA-1, HEAVY DUTY NON-FUSED DISCONNECT SWITCH. COORDINATE EXACT LOCATION WITH MECHANICAL CONTRACTOR.

These design drawings have been altered to indicate as-built information supplied by the construction contractor. The Engineer-of-Record is not responsible for the accuracy of said information. A record of as-designed drawings are maintained by the Owner.



BERNHARD TME ENGINEERING
622 Emerson Road, Suite 250
St. Louis, MO 63141 • 314-727-8760
MO Certificate of Authority No. 2009021478



2/14/23

OFFICE OF ADMINISTRATION
DIVISION OF FACILITIES
MANAGEMENT,
DESIGN AND CONSTRUCTION
DEPARTMENT OF
MENTAL HEALTH

REPLACE COOLING TOWERS
SAINT LOUIS FORENSIC
TREATMENT CENTER - NORTH
SAINT LOUIS, MISSOURI

PROJECT # M2015-01
SITE # 7391
ASSET # 6517391002

REVISION: _____
DATE: _____
REVISION: _____
DATE: _____
REVISION: _____
DATE: _____
ISSUE DATE: 02/14/2023

CAD DWG FILE: M2015-01 E-102.DWG
DRAWN BY: JBM
CHECKED BY: VUP
DESIGNED BY: GDL


SHEET TITLE:

PARTIAL FIRST FLR.
PLAN - MAIN EQUIP.
ROOM NEW WORK

SHEET NUMBER:

E-102

SHEET 15 OF 15
FEBRUARY 14, 2023

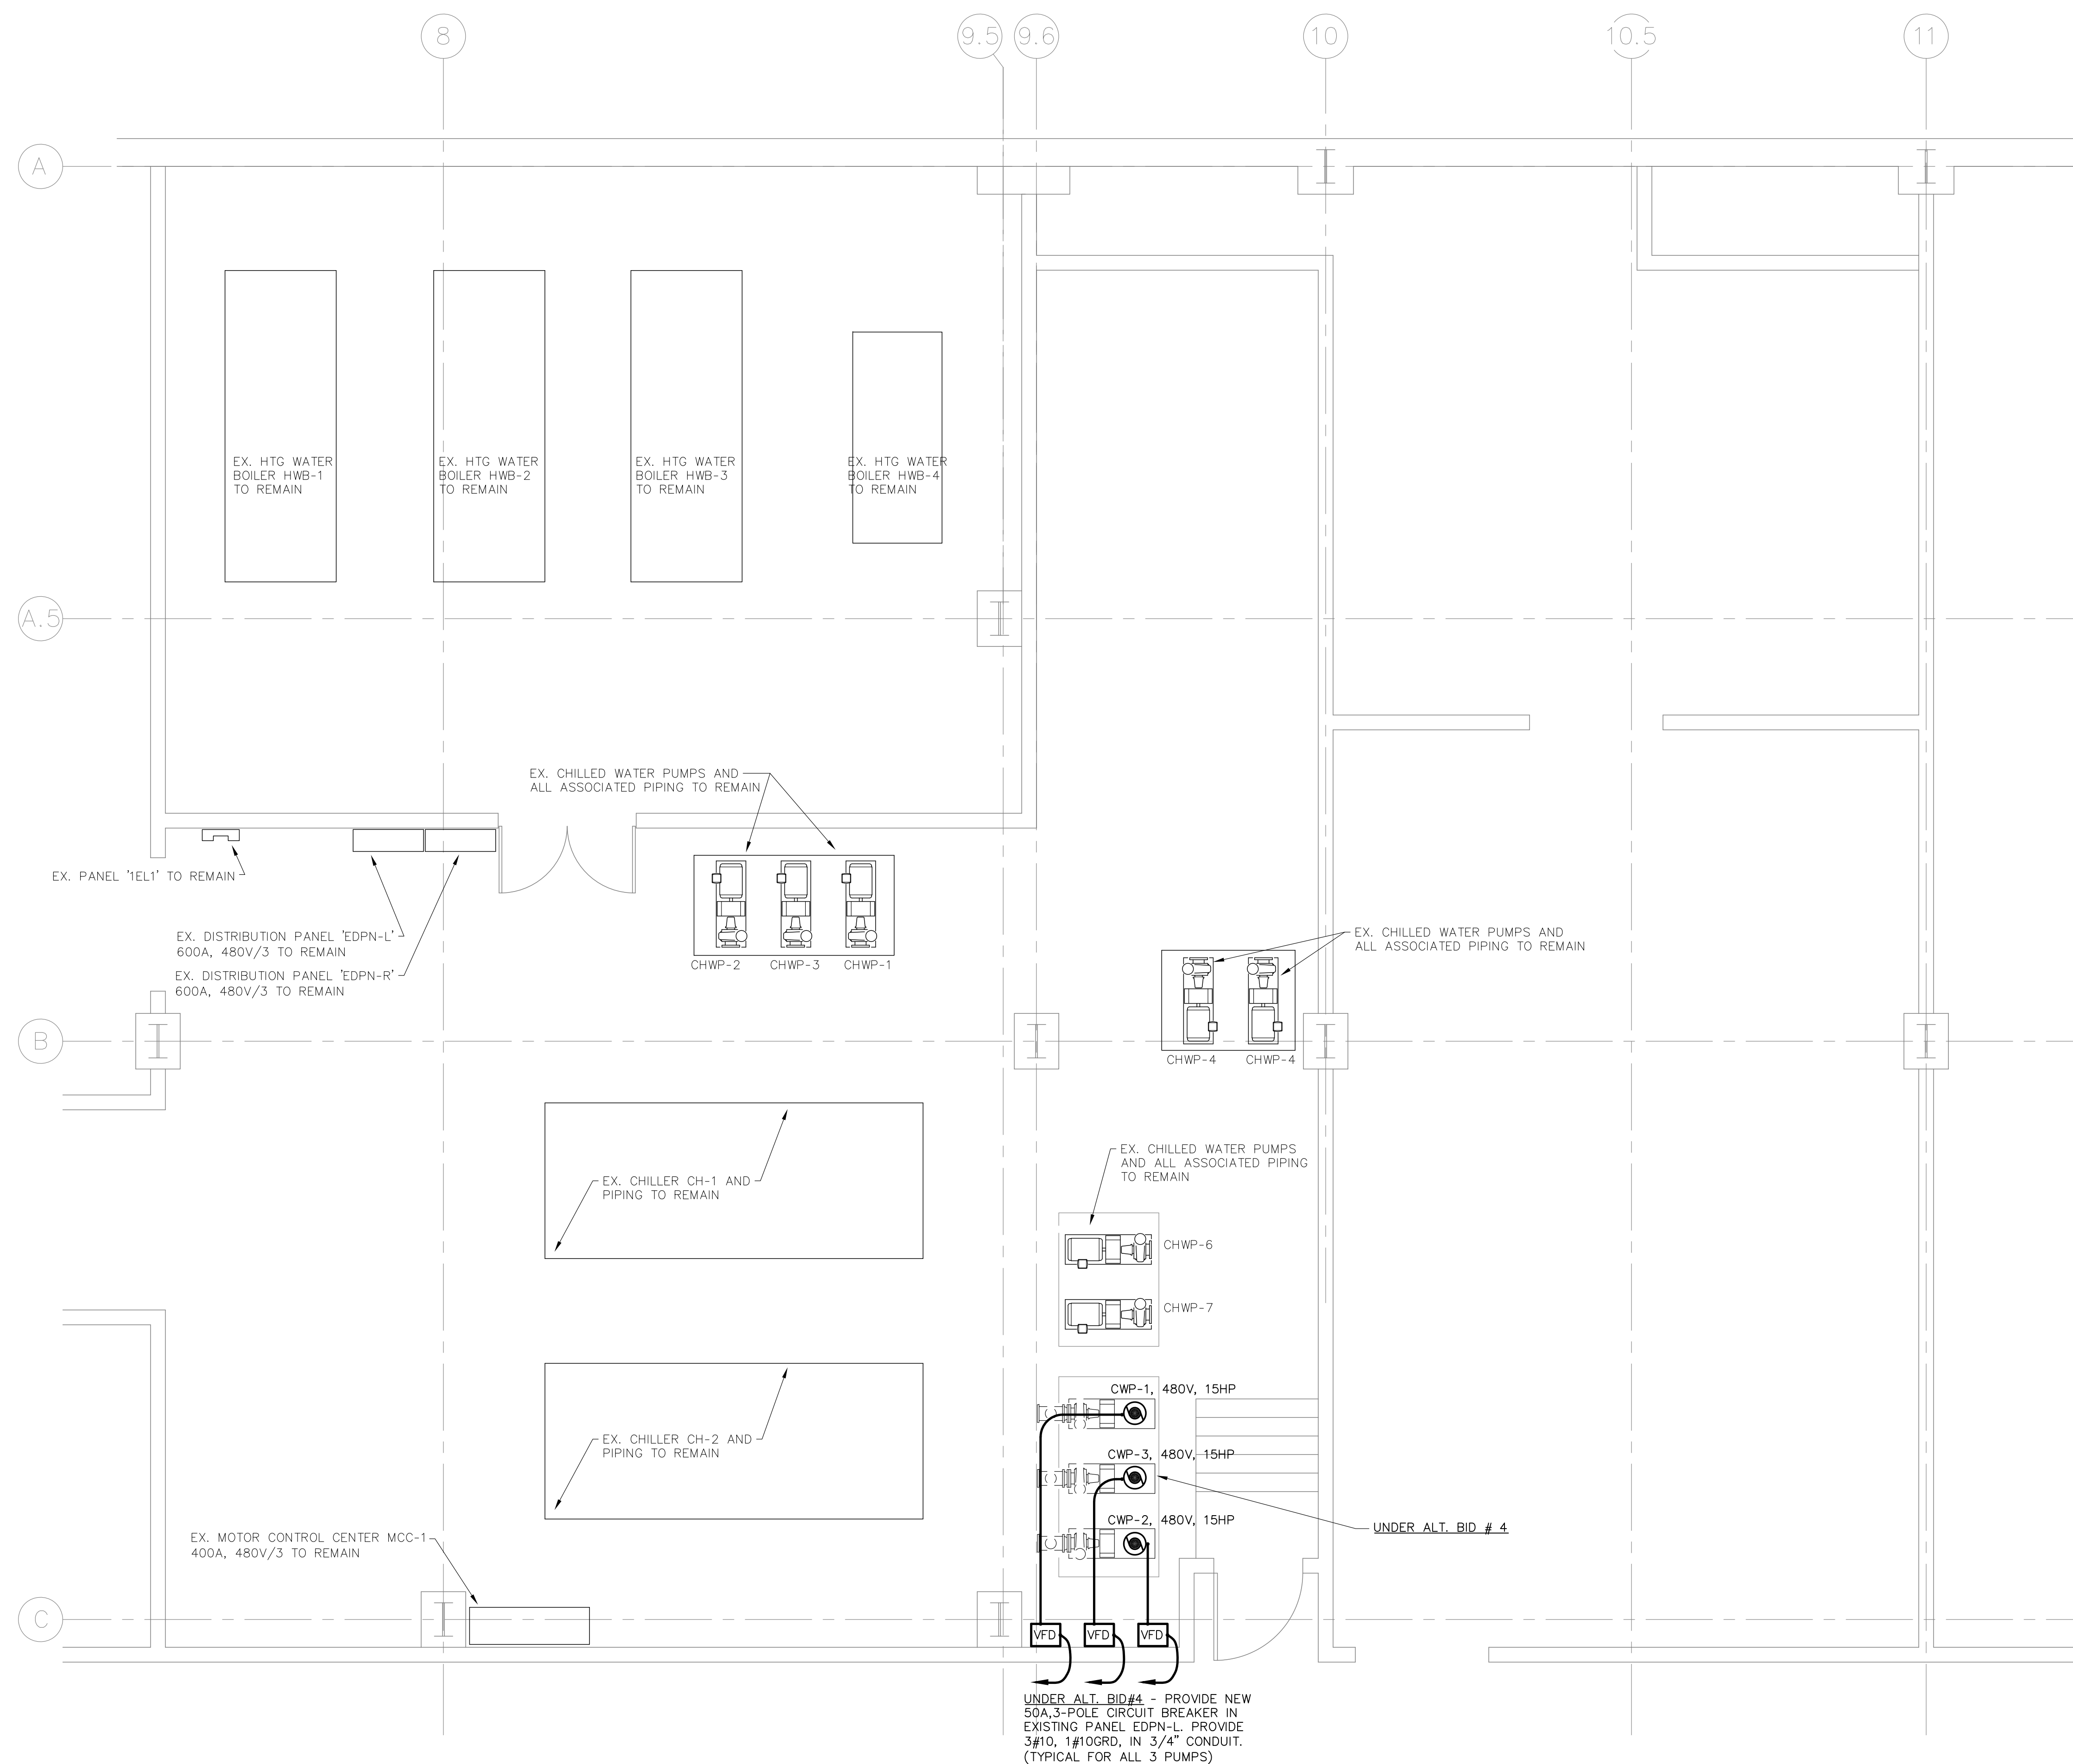

PARTIAL FIRST FLOOR PLAN - MAIN MECHANICAL NEW WORK
ELECTRICAL (ALT BID # 4)

SCALE: 1/4"=1'-0"

M2015-01 E-102.dwg, . . 2/13/2023 4:48 PM, jmoran