ADDENDUM NO. 1

TO: PLANS AND SPECIFICATIONS FOR STATE OF MISSOURI

Interior and Exterior LED Lighting Upgrade Starc RC, HQ/SEMA, MEF Building Ike Skelton Training Site Jefferson City, Missouri PROJECT NO.: T2128-01

Bid Opening Date: 1:30 PM, Thursday, July 28, 2022 (Not Changed)

Bidders are hereby informed that the construction Plans and/or Specifications are modified as follows:

SPECIFICATION CHANGES:

1. No changes to specifications.

DRAWING CHANGES:

1. Sheet DE-2.0

- a. ADD the following General Lighting Demolition Note:
 - 6. Elevator pit lighting existing to remain. No demolition or replacement required in pit.

2. Sheet DE-2.1

- a. ADD the following General Lighting Demolition Note:
 - 6. Main entry wall sconces existing to remain.

3. Sheet DE-2.3

- a. ADD the following General Lighting Demolition Note:
 - 6. Exterior canopy lighting existing to remain.

4. Sheet DE-2.7

- a. ADD the following General Lighting Demolition Note:
 - 6. Exterior canopy lighting existing to remain.

5. Sheet E-0.1

a. ADD: Lighting fixture schedule modified for downlights per site measurements. See attached revised Sheet E-0.1

6. Sheet E-2.0

- a. ADD the following General Note:
 - 1. Elevator pit lighting existing to remain. No demolition or replacement required in pit.

7. Sheet E-2.1

- a. ADD: Main entry exterior wall sconces existing to remain.
- b. CHANGE: Main entry downlighting modified to reflect 10" diameter with a new type 'DK' designation.
- c. CHANGE: Exterior wall pack designations changed to 'SA' to align with fixture schedule designation.
- d. See attached revised Sheet E-2.1

8. Sheet E-2.2

- a. ADD the following description for Keyed Note 1:
 - 1. EC shall install new exit light, type 'X1' in this location, extending EM circuit from nearest exit light on floor directly below.

9. Sheet E-2.3

- a. ADD the following General Note:
 - 1. Exterior canopy lighting existing to remain.

10. Sheet E-2.4

a. CHANGE: Exterior wall pack type designation changed to 'SA'.

11. Sheet E-2.7

- a. ADD the following General Note:
 - 1. Exterior canopy lighting existing to remain.

GENERAL COMMENTS:

- 1. The Pre-bid Meeting was held July 12, 2022 at 10:00 AM. The sign in sheet is attached.
- 2. Please contact Paul Girouard, Contract Specialist, at 573-751-4797 or Paul.Girouard@oa.mo.gov for questions about bidding procedures, MBE\WBE\SDVE Goals, and other submittal requirements.
- 3. The deadline for technical questions was Wednesday, July 20, 2022 at noon.
- 4. Changes to, or clarification of, the bid documents are only made as issued in the addenda.
- 5. All correspondence with respect to this project must include the State of Missouri project number as indicated above.
- 6. Current Plan holders list available online at https://www.adsplanroom.net/jobs/1425/plan-holders/t2128-01-interior-and-exterior-led-lighting-upgrade-starc-rc-hqsema-mef-building-ists
- 7. Prospective Bidders contact American Document Solutions, 1400 Forum Blvd Suite 1C, Columbia MO 65201, 573-446-7768 to order official plans and specifications.
- 8. All bids shall be submitted on the bid form without additional terms and conditions, modifications, or stipulations. Each space on the bid form shall be properly filled including a bid amount for each alternate. Failure to do so will result in rejection of the bid.

9. MBE/WBE/SDVE participation requirements can be found in DIVISION 00. The MBE/WBE/SDVE participation goals are 10%/10%/3%, respectively. Only certified firms as of the bid opening date can be used to satisfy the MBE/WBE/SDVE participation goals for this project. If a bidder is unable to meet a participation goal, a Good Faith Effort Determination Form must be completed. Failure to complete this process will result in rejection of the bid.

ATTACHMENTS:

- 1. Pre-Bid Meeting Sign-In Sheet
- 2. Sheet E-0.1 Lighting Schedule Diagram and Details
- 3. Sheet E-2.1 HQ/SEMA Partial First Floor Plan Lighting


July 21, 2022

END OF ADDENDUM NO. 1


Pre-Bid Meeting Attendance Sheet Interior and Exterior LED Lighting Upgrade STARC RC, HQ/SEMA, MEF Building Ike Skelton Training Site Jefferson City MO, Missouri

Project No. T2128-01 July 12, 2022 at 10:00 AM

			,	Jay Schaefer	Les Wage		/	,	John Stunbers	Eric Hibdon	Name & Title
×				MONG	ISJS Minteners	Reporter Commercial Contracting 816-914-0665	Meyer Electric	Schmerchar Electric	91 LED	OA FMDC	Company Name
		•	,	573-690-4945	573638 9500	July 816-914-065	573-893-2335	577-301-2229	314-394-2004	573-522-0322	Phone
				joseph.e. schaefer 10. n/g Darmy.wil	Jay. C. wagres, ofor & serry . A.	isos a profession in the internal and in the	Crais @meyerelectorconet	Jamisascajc.com	john@ Stiled lighting com	Eric.Hibdon@oa.mo.gov	E-Mail Address

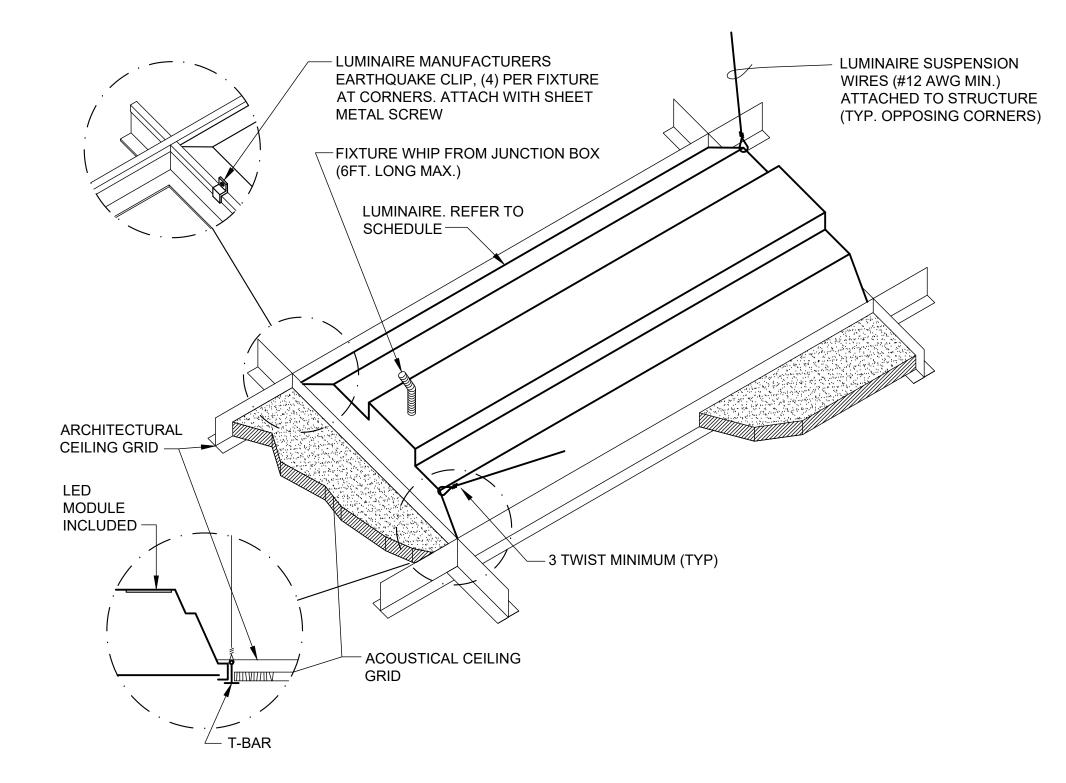

LUMINAIRE MOUNTING - LAY-IN-CEILING NO SCALE

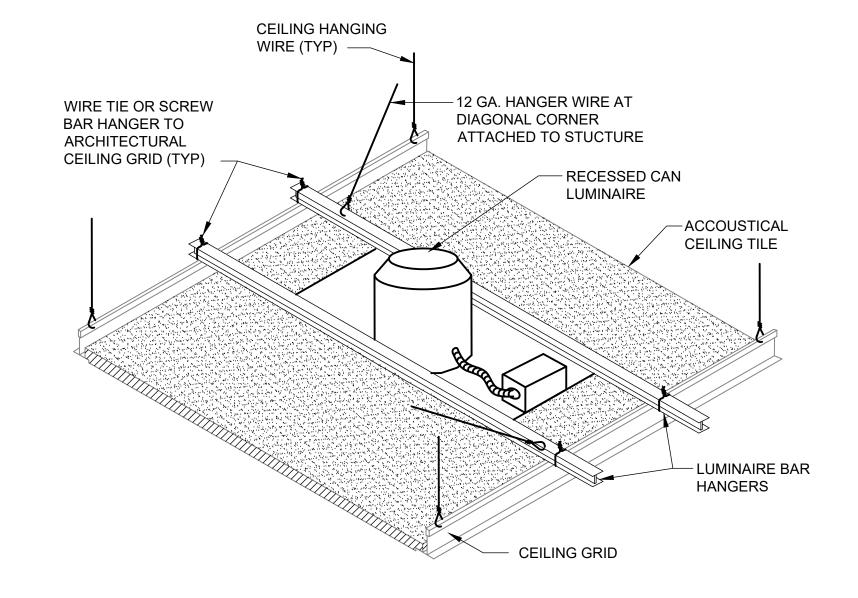


DOWNLIGHT MOUNTING - LAY-IN-CEILING NO SCALE

			I TRAINING FA	CILI	TIES	LUMII	NAIR	SCHEL	DULE	
YPE	MANUFACTURER	APPROVED EQUALS	DESCRIPTION	VOLTS	WATTAGE	ССТ	CRI	DIMMING TYPE	MOUNTING	REMARKS
CA-X	WILLIAMS LIGHTING CXC-X-L8-840-(0-25)-D-DIM-UNV	LITHONIA COOPER	LED CONTINUOUS COVE	UNV	7.3/FT	4000K	80	0-10V		EC TO VERIFY LENGTHS IN FIELD.
CAE-X	SAME AS ABOVE WITH SELF CONTAINED 10W EMERGENCY PACK	LITHONIA COOPER	***************************************	~~~	****	~~~~	~~~~	·····	····	EC TO VERIFY LENGTHS IN FIELD.
DA	WILLIAMS LIGHTING 8DR-L20-840-(L15)-DIM-120-OW-CS	LITHONIA COOPER	LED 8" ROUND DOWNLIGHT IN ACT CEILING	120	20	4000K	80	0-10V	RECESSED	
DAE	SAME AS ABOVE WITH SELF CONTAINED 10W EMERGENCY PACK	LITHONIA COOPER								
DB	WILLIAMS LIGHTING 8DR-L40-840-(L25)-DIM-120-OW-CS	LITHONIA COOPER	LED 8" ROUND DOWNLIGHT IN	120	30.2	4000K	80	0-10V	RECESSED	
DBE	SAME AS ABOVE WITH SELF CONTAINED 10W EMERGENCY PACK	LITHONIA COOPER	Alon General							
DC	WILLIAMS LIGHTING 8DR-L20-840-(L15)-DIM-120-OW-CS-R	LITHONIA COOPER	LED 8" ROUND DOWNLIGHT IN GYP CEILING - RETROFIT	120	20	4000K	80	0-10V	RECESSED	
DCE	SAME AS ABOVE WITH SELF CONTAINED 10W EMERGENCY PACK	LITHONIA	GTP CEILING - RETROFIT							
DE	WILLIAMS LIGHTING	COOPER	LED 8" ROUND DOWLIGHT IN GYP	120	11	4000K	80	0-10V	RECESSED	
DF	8DR-L20-840-(L8)-DIM-120-OW-CS-WET/CC-R WILLIAMS LIGHTING	COOPER	CEILING - RETROFIT WET LED 8" ROUND DOWLIGHT IN GYP	120	14	4000K	80	0-10V	RECESSED	
DFE	8DR-L20-840-(L10)-DIM-120-OW-CS-R SAME AS ABOVE WITH SELF CONTAINED 10W EMERGENCY PACK	COOPER	CEILING - RETROFIT							
DG	WILLIAMS LIGHTING	COOPER	LED 8" ROUND DOWLIGHT IN GYP	120	30.2	4000K	80	0-10V	RECESSED	
DGE	8DR-L40-840-(L25)-DIM-120-OW-CS-R SAME AS ABOVE WITH SELF CONTAINED 10W EMERGENCY PACK	COOPER LITHONIA	CEILING - RETROFIT	120	30.2	400010	00	0-100	RECEGGED	
	WILLIAMS LIGHTING	COOPER	LED 8" ROUND DOWLIGHT IN GYP			10001/				
DJ	8DR-L40-840-(L30)-DIM-120-OW-CS-R PORTFOLIO	COOPER	CEILING - RETROFIT LED 10" ROUND DOWLIGHT IN	120	36	4000K	80	0-10V	RECESSED	
DK	LDRT810B-L30-D010/ER8B-3040-8040/8LB-W-0-H	SPECTRUM LIGHTING	GYP CEILING - RETROFIT	120	27.6	4000K	80	0-10V	RECESSED	
DKE	SAME AS ABOVE WITH SELF CONTAINED 10W EMERGENCY PACK	SPECTRUM LIGHTING				••••				
FA	LT-AR-24-L40-840-AF-DIM-UNV	COOPER LITHONIA	LED 2X4 AIR RETURN TROFFER	UNV	32.7	4000K	80	0-10V		
FAE	SAME AS ABOVE WITH SELF CONTAINED 12W EMERGENCY PACK	COOPER								
FB	WILLIAMS LIGHTING LT-AR-24-L40-840-AF-(L37)-DIM-UNV	LITHONIA COOPER	LED 2X4 AIR RETURN TROFFER	UNV	32	4000K	80	0-10V		
FBE	SAME AS ABOVE WITH SELF CONTAINED 12W EMERGENCY PACK	LITHONIA COOPER								
FC	WILLIAMS LIGHTING LT-AR-22-L39-840-AF-(L29)-DIM-UNV	LITHONIA COOPER	LED 2X2 AIR RETURN TROFFER	277	23	4000K	80	0-10V		
FCE	SAME AS ABOVE WITH SELF CONTAINED 12W EMERGENCY PACK	LITHONIA COOPER								
FD	WILLIAMS LIGHTING LT-AR-24-L40-840-AF-(L30)-DIM-UNV	LITHONIA COOPER	LED 2X4 AIR RETURN TROFFER	277	32	4000K	80	0-10V		
FDE	SAME AS ABOVE WITH SELF CONTAINED 12W EMERGENCY PACK	LITHONIA COOPER								
FF	WILLIAMS LIGHTING 50G-S24-L59-840-SAF12125-DIM-UNV	LITHONIA COOPER	LED 2X4 STATIC TROFFER DAMP LABEL	277	48	4000K	80	0-10V		
FG	WILLIAMS LIGHTING LT-AR-14-L63-840-AF-DIM-UNV	LITHONIA COOPER	LED 1X4 AIR RETURN TROFFER	277	48.5	4000K	80	0-10V		<u></u>
FH	WILLIAMS LIGHTING 18-4-L90-840-A-(L60)-DIM-UNV	LITHONIA COOPER	LED 16"X48" LOW PROFILE WRAP	277	37.4	4000K	80	0-10V		
FJ	WILLIAMS LIGHTING 17-4-L55-840-AF-DIM-UNV	LITHONIA COOPER	LED 1X4 LOW PROFILE WRAP	120	42.3	4000K	80	0-10V		SURFACE MOUNTED
FK	WILLIAMS LIGHTING 50G-S14-L65-840-SAF12125-DIM-UNV	LITHONIA COOPER	LED 1X4 STATIC TROFFER DAMP LABEL	277	55.7	4000K	80	0-10V		
FKE	SAME AS ABOVE WITH SELF CONTAINED 10W EMERGENCY PACK	LITHONIA COOPER								
GA	WILLIAMS LIGHTING 75R-4-L50-840-(L39)-DIM-UNV	LITHONIA COOPER	LED 4' STRIP LIGHT	UNV	27.6	4000K	80	0-10V		
GAE	SAME AS ABOVE WITH SELF CONTAINED 10W EMERGENCY PACK	LITHONIA COOPER	+							
GB	WILLIAMS LIGHTING 75R-4-L65-840-(L55)-DIM-UNV	LITHONIA COOPER	LED 4' STRIP LIGHT	277	36.9	4000K	80	0-10V		
GC	WILLIAMS LIGHTING	LITHONIA	LED 4' STRIP LIGHT	277	47.7	4000K	80	0-10V		
GCE	75R-4-L85-840-(L70)-DIM-UNV SAME AS ABOVE WITH SELF CONTAINED 10W EMERGENCY PACK	COOPER								
HA	WILLIAMS LIGHTING	COOPER	LED 4' COMPACT HIGH BAY	277	177.9	4000K	80	0-10V		
HAE	GH-4-L240-840-FA-DIM-UNV SAME AS ABOVE WITH SELF CONTAINED 20W EMERGENCY PACK	COOPER								
MA	WILLIAMS LIGHTING	COOPER	LED 4' INDUSTRIAL	277	34.2	4000K	80	0-10V		NO 20% UPLIGHT
MAE	80-4-L53-840-DIM-UNV SAME AS ABOVE WITH SELF CONTAINED 10W EMERGENCY PACK	COOPER	INDOORNAL		- 1.E		50			
	WILLIAMS LIGHTING	COOPER	LED AUDIDIOTOLA	277	20.2	400014	90	0.4017		
MB	80-4-L32-840-DIM-UNV WILLIAMS LIGHTING	COOPER	LED 4' INDUSTRIAL	277	20.3	4000K	80	0-10V		
SA	WPTZ-L38-7-40-DIM WILLIAMS LIGHTING	COOPER	LED MEDIUM WALL PACK LED 8" ALUMINUM ROUND	277	42	4000K	80	0-10V		<u> </u>
SB	OSA8R-L20-8-40-AC-DT WILLIAMS LIGHTING	COOPER	BOLLARD	120	24.6	4000K	80	0-10V		
sc	VWPH-L30-7-40-TFT-DIM JUNO	COOPER	LED ARCHITECTURAL WALL PACK	120	36	4000K	70	0-10V		MOUNT AT 9'-0" AFF
TA	R605L27W	CONTECH	LED MONOPOINT TRACK HEAD	120	10.5	4000K	80	0-10V		PROVIDE CORRESPONDING MANUFACTURER'S TRACK SYSTEM
WAE	WILLIAMS LIGHTING 29-4-L54-840-AF-(L30)-EM/10W-DRV-277	LITHONIA COOPER	LED 4' WALL MOUNT	277	42.4	4000K	80	0-10V		PROVIDE SELF CONTAINED 10W EMERGENCY PACK.
WB-X	WILLIAMS LIGHTING MX4WD-2-00-L8-840-F-DIM-UNV	LITHONIA COOPER	LED 4" WIDE CONTINUOUS WALL MOUNT	UNV	10.8/FT	4000K	80	0-10V		EC TO VERIFY EXACT DIMENSIONS IN FIELD.
WBE->	SAME AS ABOVE WITH SELF CONTAINED 10W EMERGENCY PACK	LITHONIA COOPER								EC TO VERIFY EXACT DIMENSIONS IN FIELD.
WC	COOPER LIGHTING HCC4W-20-D010-X-HM4-12-840-41-WD-C	LITHONIA WILLIAMS	4" CYLINDER WALL SCONCE	120	21.1	4000K	80	0-10V	WALL MOUNT	MOUNT AT +78"
XA	WILLIAMS LIGHTING EMER/LED-WHT-SDT-D-DRHL-X-WHT-MV	SURELITES LITHONIA	LED EMERGENCY LIGHT	120	2					
X1	WILLIAMS LIGHTING EXT-R-EM-WHT-D	SURELITES LITHONIA	LED EXIT SIGN	UNV	3.8					
X2	WILLIAMS LIGHTING	SURELITES	LED RECESSED DUAL FACE EXIT	120	3.8					

GENERAL NOTES:

LIGHT FIXTURE SUBSTITUTIONS TO THE BASIS OF DESIGN MUST BE EQUAL QUALITY, EQUAL PERFORMANCE, AND SUBMITTED 10 DAYS PRIOR FOR PRE-APPROVAL. REFERENCE DIVISION 1000 OF THE CONTRACT SPECIFICATIONS FOR PROCESS REQUIRED FOR PRE-APPROVAL. NO SUBSTITUTIONS WIL

STATE OF MISSOURI MICHAEL L. PARSON, **GOVERNOR**

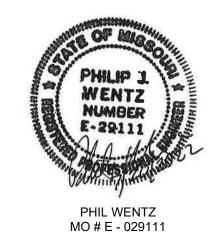

McClure ENGINEERING

1000 Clark Avenue Saint Louis, Missouri 63102 T 314-645-6232 MEP Engineers:

McClure Engineering

Professional Engineering Corporation Missouri State Certificate of Authority #000087

OFFICE OF ADMINISTRATION DIVISION OF FACILITIES MANAGEMENT, DESIGN AND CONSTRUCTION

SAFETY

MISSOURI NATIONAL GUARD

DEPARTMENT OF PUBLIC

INTERIOR AND EXTERIOR LED LIGHTING UPGRADE STARC RC, HQ/SEMA, MEF BUILDING

IKE SKELTON TRAINING FACILITY 2302 MILITIA DRIVE

JEFFERSON CITY, MO 65101

PROJECT # T2128-01 FACILITY # 8136300012

8136300013; 8136300014

REVISION: ADDENDUM #1 DATE: 07/20/2022

REVISION: REVISION:


ISSUE DATE:

CAD DWG FILE:E-0.1-075110.000.dwg
DRAWN BY: SJF
CHECKED BY: SWD DESIGNED BY: SWD


LIGHTING SCHEDULE DIAGRAM AND DETAILS

SHEET NUMBER:


06/09/2022

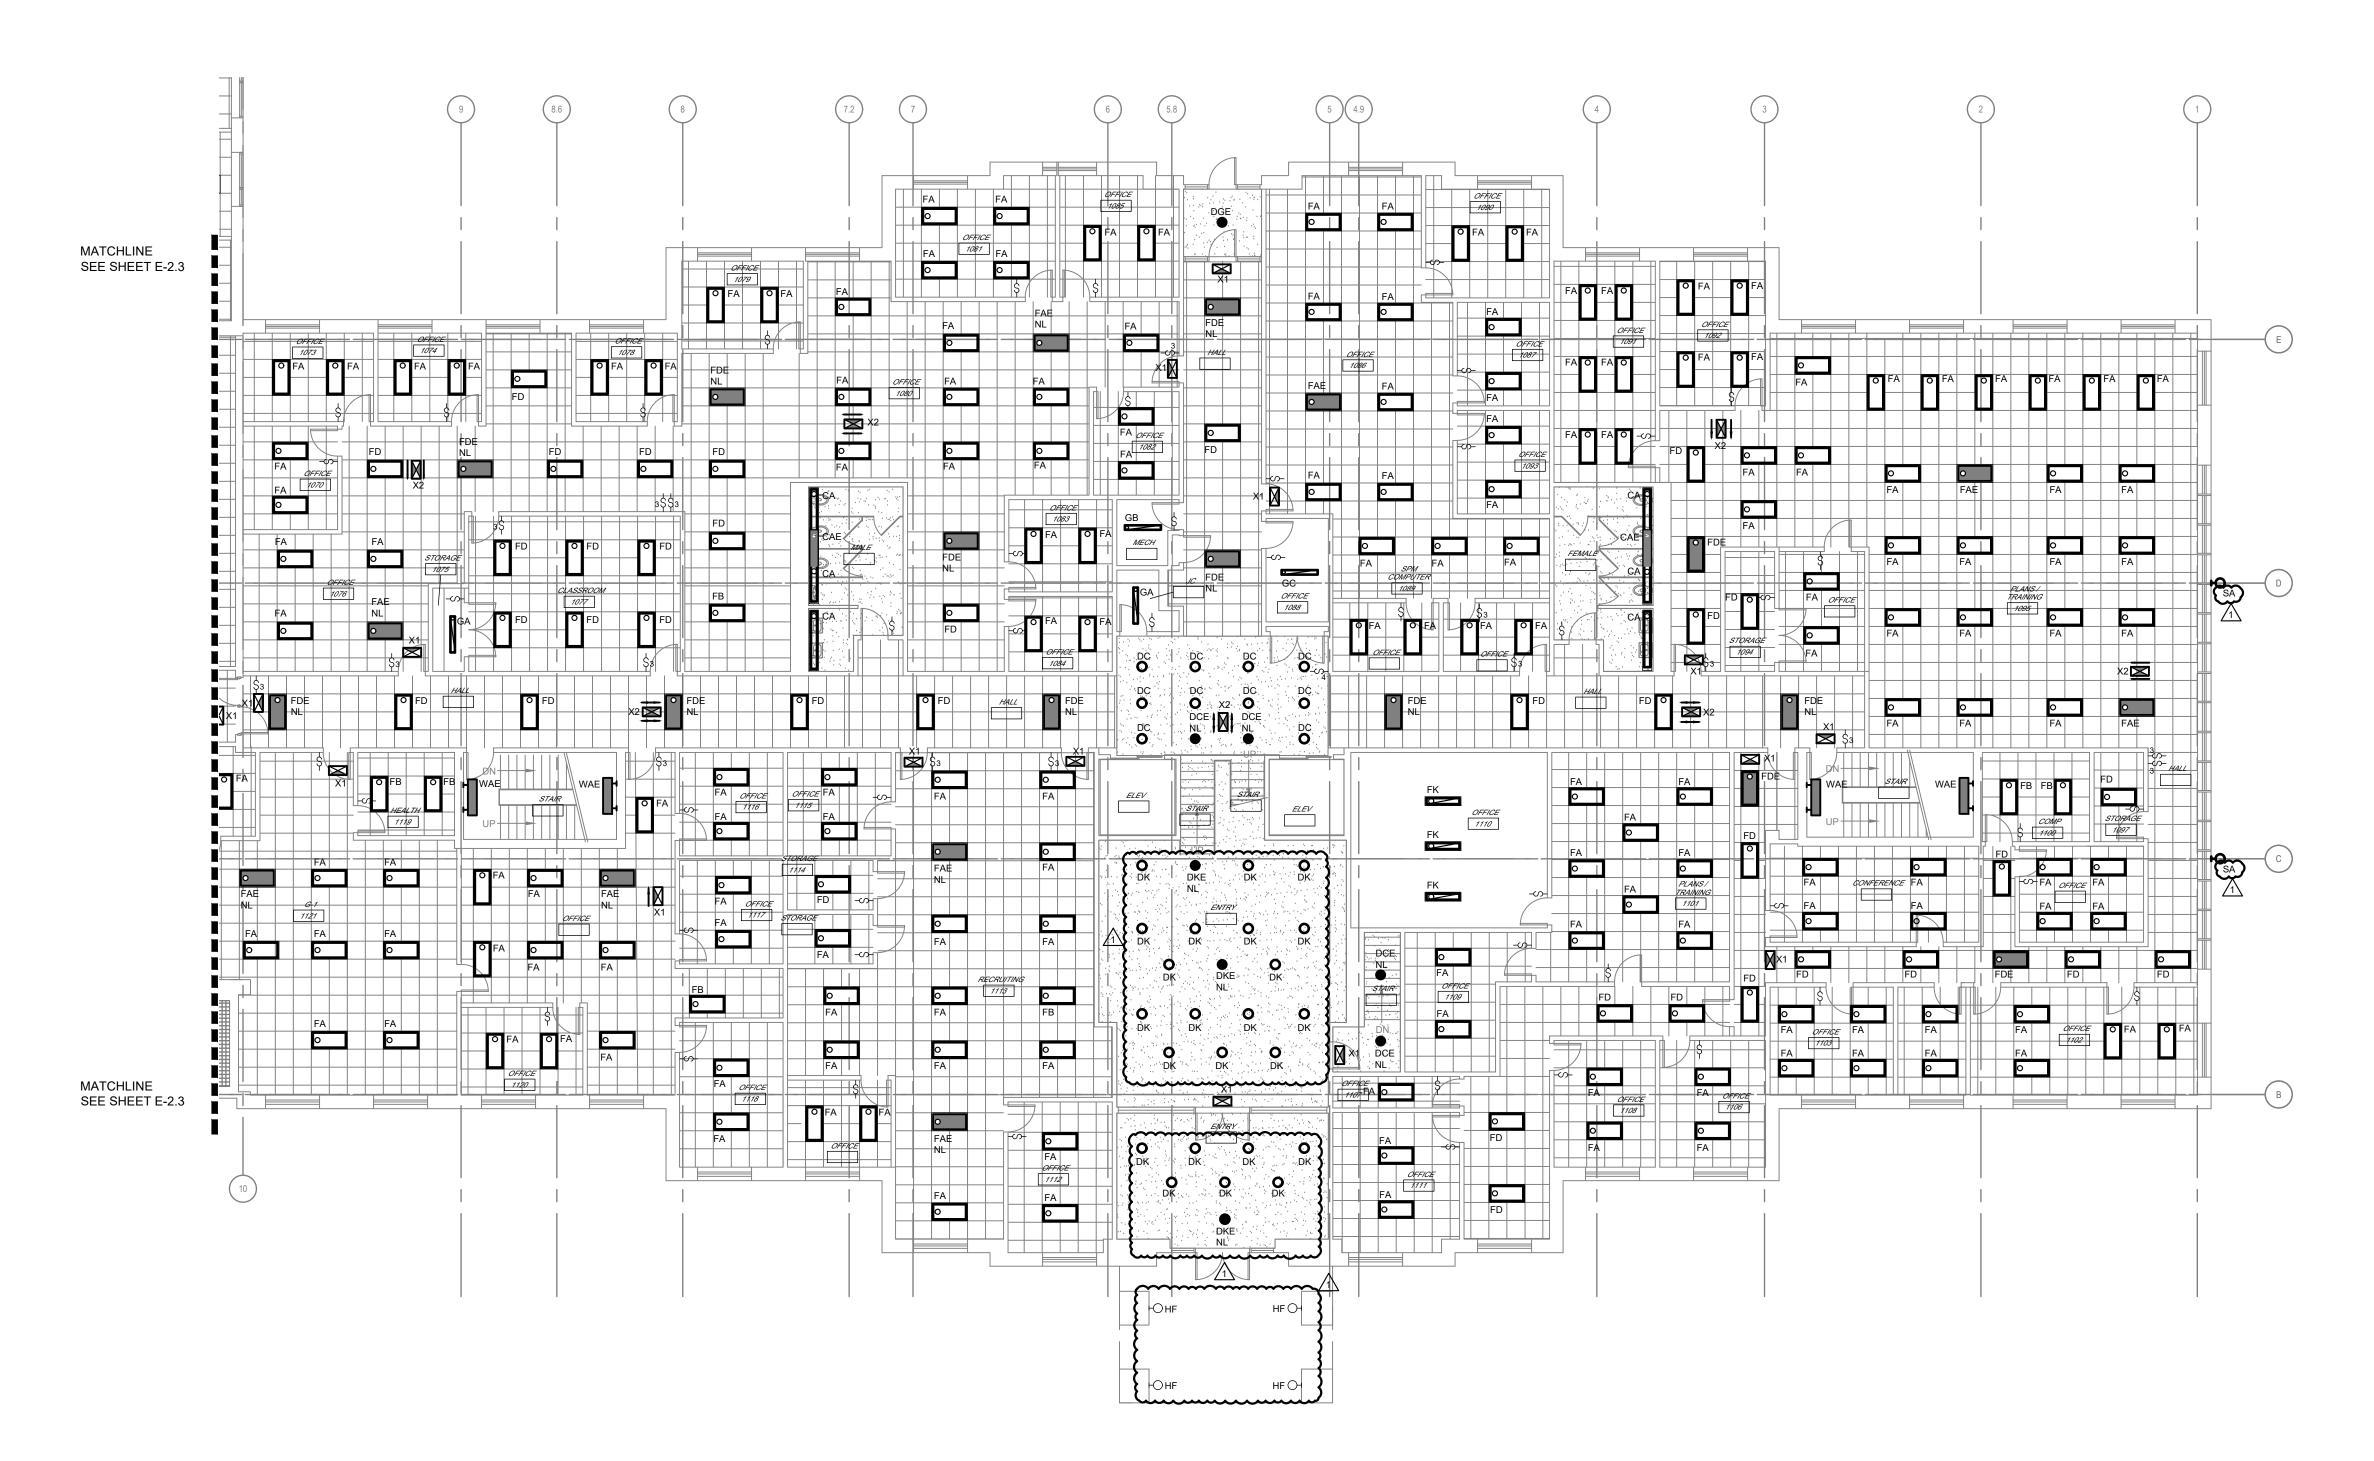



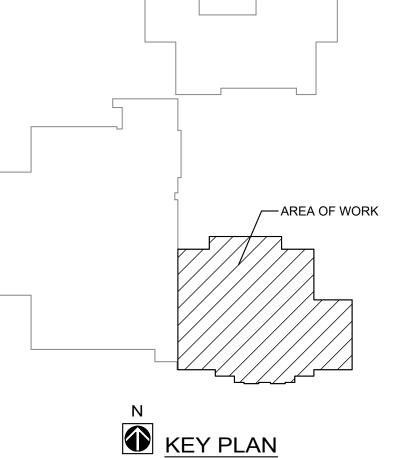

STATE OF MISSOURI MICHAEL L. PARSON, GOVERNOR

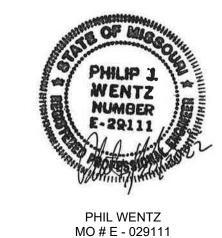

McClure Engineering

1000 Clark Avenue
Saint Louis, Missouri 63102
T 314-645-6232
MEP Engineers:
McClure Engineering
Professional Engineering
Corporation
Missouri State Certificate of
Authority #000087

OFFICE OF ADMINISTRATION DIVISION OF FACILITIES MANAGEMENT, DESIGN AND CONSTRUCTION

DEPARTMENT OF PUBLIC SAFETY

MISSOURI NATIONAL GUARD

INTERIOR AND EXTERIOR LED LIGHTING UPGRADE STARC RC, HQ/SEMA, MEF BUILDING

IKE SKELTON TRAINING FACILITY 2302 MILITIA DRIVE

JEFFERSON CITY, MO 65101

PROJECT # T2128-01 SITE # 6300 FACILITY # 8136300014

REVISION: <u>ADDENDUM #1</u>
DATE: <u>07/20/2022</u>
REVISION:
DATE:

REVISION: DATE: ISSUE DATE:

E-2.1-2.2-2.3CAD DWG FILE:075110.000.dwg
DRAWN BY: SJF
CHECKED BY: SWD
DESIGNED BY: SWD

SHEET TITLE:

HQ / SEMA PARTIAL FIRST FLOOR PLAN -LIGHTING

SHEET NUMBER:

E-2.

16 OF 22 SHEETS 06/09/2022