#### ADDENDUM NO. 1

#### TO: PLANS AND SPECIFICATIONS FOR STATE OF MISSOURI

Crime Lab-Exterior Renovations Troop-H Headquarters Building 3525 North Belt Highway, St. Joseph, Missouri 64506 PROJECT NO. R233801

Bid Opening Date: 1:30 PM, September 10, 2024 (Not Changed)

Bidders are hereby informed that the construction Plans and Specifications are modified as follows:

#### **SPECIFICATION CHANGES:**

- 1. Table of Contents:
  - a. MODIFY Section 01211 Allowances
  - b. ADD Section 012200 Unit Prices
  - c. ADD Section 260519 Low-Voltage Electrical Power Conductors and Cables
- 2. Section 004113 Bid Form, revised bid form
- 3. Division 1:

Section 012100 - Allowances

a. ADD paragraph 3.3.B.

Section 012200 -Unit Prices

a. ADD paragraph 3.1.

Section 260519 - Low-Voltage Electrical Power Conductors and Cables

a. ADD entire section.

#### **DRAWING CHANGES:**

- 1. <u>Drawing</u> C-105:
  - a. CLARIFY add alternate #1 note to indicate rip rap and trench drain is included in the base bid.
- 2. Drawing C-109:
  - a. CLARIFY add alternate #1 note to indicate rip rap and trench drain is included in the base bid.
- 3. Drawing C-113:
  - a. CLARIFY add alternate #1 note to indicate rip rap and trench drain is included in the base bid.
- 4. Drawing C-117:
  - a. CLARIFY add alternate #1 note to indicate rip rap and trench drain is included in the base bid.

- 5. Drawing E-200:
  - a. CLARIFY all new parking lot light poles are to have two fixtures with added note.
  - b. REVISE general note #4 to replace all existing electrical conduit and wiring.
- 6. <u>Drawing E-300:</u>
  - a. ADD item #12 in summary of quantities table for Parking Lot Area Light Poles
- 7. <u>Drawing E-301:</u>
  - a. ADD "or approved equal" to the light pole specification product information.

#### **BIDDER QUESTIONS AND RESPONSES:**

Are we to reuse the existing underground cable for new electrical installation? I had two of
my guys that have serviced this over the years and the existing cable has had many
repairs/splices to it and would not be a good situation to move forward with this for the new
installation.

Response: All existing electrical conduit and wiring which is broken or not functioning shall be replaced as approved by Engineer and Owner. A unit cost has been added to the Bid Form.

2. If you reference Sheet Number E-300; D. NEW- Parking Area Light- the new parking area light shows a single headed light fixture while the final product is to be a double headed fixture, thus arose the question: Would you like the Parking Area Light to have a Fixture on each side of the pole, creating a "double headed" fixture? If so, we will need to order six (6) of the Parking Area Lights.

Response: That is correct. You will need (6) fixtures for the (3) Poles in the parking lot.

3. If you reference Sheet Number E-301; Pole Specifications: Catalog NO. P200-APR-G-M00-AB- C/W 140(25/40); Will those new Parking Area Light Poles, be provided or need to be purchased by the contractor/subcontractor? The current poles will not support a double headed fixture.

Response: Yes, they need to be purchased as well and do not come with the Galleon II fixtures.

#### **GENERAL**:

- 1. Copy of Attendance Record is attached for information only. Changes to, or clarification of, the Bid Documents are only made as issued in the Addenda.
- Please contact Mandy Roberson, Contract Specialist, at 573-522-0074 or <u>Mandy.Roberson@oa.mo.gov</u> for questions about bidding procedures, MBE\WBE\SDVE Goals, and other submittal requirements.
- 3. The deadline for technical questions is September 3, 2024, at Noon.
- 4. Changes to, or clarification of, the bid documents are only made as issued in the addenda.
- 5. All correspondence with respect to this project must include the State of Missouri project number as indicated above.
- Current Plan Holders list available online at: <u>Bid Listing/ Electronic Plans (Projects Currently Bidding) | Office of Administration (mo.gov)</u> R2338-01-Crime Lab-Exterior Renovations Troop-H Headquarters, St. Joseph
- 7. Prospective Bidders contact American Document Solutions, 1400 Forum Blvd Suite Page **2** of **3**

- 7A, Columbia MO 65203, 573-446-7768 to order official plans and specifications.
- 8. All bids shall be submitted on the bid form without additional terms and conditions, modifications, or stipulations. Each space on the bid form shall be properly filled including a bid amount for the alternates. Failure to do so will result in rejection of the bid.
- 9. MBE/WBE/SDVE participation requirements can be found in DIVISION 00. The MBE/WBE/SDVE participation goals are 10%/10%/3%, respectively. Only certified firms as of the bid opening date can be used to satisfy the MBE/WBE/SDVE participation goals for this project. If a bidder is unable to meet a participation goal, a Good Faith Effort Determination Form must be completed. Failure to complete this process will result in rejection of the bid.

#### **ATTACHMENTS:**

- 1. Section 000110 Table of Contents
- 2. Section 004113 Bid form
- 3. Section 004322 Unit Price Form
- 4. Section 012100 Allowances
- 5. Section 012200 Unit Prices
- 6. Section 260519 Low-Voltage Electrical Power Conductors and Cables
- 7. Pre-Bid Sign-in Sheet
- 8. Drawings C-105, C-109, C-113, C-117, E-200, E-300 and E-301

By the Order of:

Fred L. Decker Jr., Project Manager Division of Facilities Management, Design and Construction September 5, 2024

**END ADDENDUM NO. 1** 

#### TABLE OF CONTENTS

	IABLE OF CONTENTS	
SECTION	TITLE NUMBER O	F PAGES
DIVISION OO	- PROCUREMENT AND CONTRACTING INFORMATION	
DIVISION 00	- PROCUREMENT AND CONTRACTING INFORMATION	
000000 INTR	RODUCTORY INFORMATION	
000101	Project Manual Cover	1
000107	Professional Seals and Certifications	$\frac{1}{3}$
000110	Table of Contents	$\frac{2}{2}$
000115	List of Drawings	2
001116 INVIT	TATION FOR BID (IFB) plus Missouri Buys instructions and special notice	2
002113 INSTE	RUCTIONS TO BIDDERS (Includes MBE/WBE/SDVE Information)	8
003144	MBE/WBE/SDVE Directory	1
**The followin	ng documents may be found on MissouriBUYS at https://missouribuys.mo.gov/**	
Q04Q00\PROQ	ZUREMENT FORMS & SUPPLEMENTS VIVIA	$\sim$
004113	Bid Form	· ·* · )
004322	Unit Prices Form	* * )
004336	Proposed Subcontractors Form	
004337	MBE/WBE/SDVE Compliance Evaluation Form	*
004338	MBE/WBE/SDVE Eligibility Determination	*
	Form for Joint Ventures	
004339	MBE/WBE/SDVE Good Faith Effort (GFE)	*
004240	Determination Forms	ata
004340	SDVE Business Form	*
004541	Affidavit of Work Authorization	*
004545	Anti-Discrimination Against Israel Act Certification form	4
005000 CONT	FRACTING FORMS AND SUPPLEMENTS	
005213	Construction Contract	3
005414	Affidavit for Affirmative Action	1
006113	Performance and Payment Bond	2
006325	Product Substitution Request	2
006519.16	Final Receipt of Payment and Release Form	1
006519.18	MBE/WBE/SDVE Progress Report	1
006519.21	Affidavit of Compliance with Prevailing Wage Law	1
007000 CONE	DITIONS OF THE CONTRACT	
007213	General Conditions	20
007300	Supplementary Conditions	1
007346	Wage Rate	4
	•	
	GENERAL REQUIREMENTS	
011000	Summary of Work	mgm
012100	Allowances	2 3
012200 012300	Unit Prices Afternates	June J
		1
012600 013100	Contract Modification Procedures Coordination	2 4
013100	Project Management Communications	4
013113	Schedule – Bar Chart	4
013200	Submittals	6
013513.25	Site Security and Health Requirements (MSHP)	6
015010	Construction Facilities and Temporary Controls	7
017400	Cleaning	3
317100	C.com.ii.g	5

#### TECHNICAL SPECIFICATIONS INDEX:

DIVISION 04 –	MASONRY	
040120	Brick Masonry Restoration and Cleaning	17
040121	Task Items – Masonry Restoration	4
DIVISION 05 –	STEEL	
050110	Steel Field Re-Coating	4
055213	Pipe and Tube Railings	6
DIVISION 07 –	THERMAL AND MOISTURE PROTECTION	
071900	Water Repellents	4
DIVISION 26 -	ELECTRICAL	
260519	Low-Voltage Electrical Power Conductors and Cables	3
260526	Globiliding and Bonding for Electrical Systems	تىنچ
260529	Hangers and Supports for Electrical Systems	4
260533	Raceways and Boxes for Electrical Systems	8
260544	Sleeves and Sleeve Seals for Electrical Raceways and Cabling	3
260553	Identification for Electrical Systems	7
262726	Wiring Devices	4
262813	Fuses	2
265619	LED Exterior Lighting	7
DIVISION 31 –	EARTHWORK	
311000	Site Clearing	8
312000	Earth Moving	13
DIVISION 32 –	EXTERIOR IMPROVEMENTS	
321216	Asphalt Paving	7
321313	Concrete Paving	13
321373	Concrete Paving Joint Sealants	5
329200	Turf and Grasses	7
APPENDIX		
A – STORM WA	ATER POLLUTION PREVENTION PLAN	64

## STATE OF MISSOURI

### Per Addendum #1

Bid Time:	1:30 PM
Bid Date:	

#### **SECTION 004113 - BID FORM**

1.0

BID A. From:	
	(Bidder's Name)
	herein after called the "Bidder".
В. То:	Director, Division of Facilities Management, Design and Construction Room 730, Harry S Truman State Office Building 301 West High Street Jefferson City, Missouri 65101
	herein after called the "Owner."
C. For:	Crime Lab-Exterior Renovations Troop-H Headquarters Building Troop-H Headquarters St. Joseph, Missouri
D. Project Number:	R2338-01
	hereinafter called the "Work."
E. Documents:	The undersigned, having examined and being familiar with the local conditions affecting the work and with the complete set of contract documents, including the Drawings, the Invitation For Bid, Instructions To Bidders, Statement of Bidders Qualifications, General Conditions, Supplement to General Conditions, and the technical specifications, including: addenda number through hereby proposes to perform the Work for the following:
F. Bid Amount:	
	Dollars (\$)
G. Allowances:	Included within the completion period for this Project is ten (10) "bad weather" days. See Section 012100 for details.
H. Alternates:	Alternate No. 1: Description.
	Add grading and asphalt paving as indicated on the Drawings labeled "Add Alternate # 1".
	Dollars (\$)

#### 2.0 MBE/WBE/SDVE PERCENTAGE OF PARTICIPATION PROJECT GOALS

A. This project's specific goals are: **MBE 10%**, **WBE 10%**, and **SDVE 3%**. NOTE: Only MBE/WBE firms certified by the State of Missouri Office of Equal Opportunity, and SDVE(s) meeting the requirements of Section 34.074, RSMo, and 1 CSR 30-5.010, as of the date of bid opening can be used to satisfy the MBE/WBE/SDVE participation goals for this project.

#### 3.0 BID BOND

A. Accompanying the bid is: \_\_\_\_ 5% Bid Bond or \_\_\_ Cashier's Check/Bank Draft for 5% of base bid that is payable without condition to the Division of Facilities Management, Design and Construction, State of Missouri, as per Article 5 of "Instructions To Bidders".

#### **SECTION 004322 - UNIT PRICES FORM**

#### PROJECT NUMBER: R2338-01

#### 1.0 Description

A. For changing specified quantities of work from those indicated by the contract drawings and specifications, upon written instructions of Owner, the following unit prices shall prevail. The unit prices include all labor, overhead and profit, materials, equipment, appliances, bailing, shoring, shoring removal, etc., to cover the finished work of the several kinds of work called for. Only a single unit price shall be given and it shall apply for either MORE or LESS work than that shown on the drawings and called for in the specifications or included in the Base Bid. In the event of more or less units than so indicated or included during construction the total contract price shall be decreased as appropriate or increased by contract change in accordance with General Conditions Article 4.1.

2.	Λ	T T	•4	D-	ice	
Z.,		UI	ш	Pľ	TCE	×

- A. Unit Price No. 1 2'' Conduit:
  - 1. Description: Install new 2" electrical conduit according to Division 26 Section "260533 Raceways and Boxes for Electrical Systems."
  - 2. Unit of Measurement: LF (linear feet).
  - 3. Base Bid Quantity: 1500 LF

\$	per cubic foo
----	---------------

- B. Unit Price No. 2 Electrical Wire:
  - 1. Description: Install new electrical wire for site lighting systems according to Division 26 Section "260519 Low-Voltage Electrical Power Conductors and Cables."
  - 2. Unit of Measurement: LF (linear feet).
  - 3. Alternate No. 1 Quantity: 3000 LF

\$ per square	foot
per square	100

- C. Unit Price No. 3 Grounding Wire:
  - 1. Description: Install new grounding wire for site lighting systems according to Division 26 Section "260519 Low-Voltage Electrical Power Conductors and Cables."
  - 2. Unit of Measurement: LF (linear feet).
  - 3. Alternate No. 1 Quantity: 1500 LF


#### SECTION 012100 - ALLOWANCES

#### **PART 1 - GENERAL**

#### 1.1 RELATED DOCUMENTS

A. Drawings and general provisions of the Contract including General and Supplementary Conditions and other Division 1 Specification Sections apply to this Section.

#### 1.2 SUMMARY

- A. This Section includes administrative and procedural requirements governing allowances.
  - 1. Certain items are specified in the Contract Documents by allowances. Allowances have been established in lieu of additional requirements and to defer selection of actual materials and equipment to a later date when additional information is available for evaluation. If necessary, additional requirements will be issued by Change Order.
- B. Types of allowances include the following:
  - 1. Lump-sum allowances.
  - 2. Weather allowances.
- C. Related Sections include the following:
  - 1. Division 1 Section "Contract Modification Procedures" for procedures for submitting and handling Change Orders for allowances.
  - 2. Division 1 Section "Unit Prices" for procedures for using unit prices.

#### 1.3 WEATHER ALLOWANCE

- A. Included within the completion period for this project are a specified number of "bad weather" days (see Schedule of Allowances).
- B. The Contractor's progress schedule shall clearly indicate the bad weather day allowance as an "activity" or "activities". In the event weather conditions preclude performance of critical work activities for 50% or more of the Contractor's scheduled workday, that day shall be declared unavailable for work due to weather (a "bad weather" day) and charged against the above allowance. Critical work activities will be determined by review of the Contractor's current progress schedule.
- C. The Contractor's Representative and the Construction Representative shall agree monthly on the number of "bad weather" days to be charged against the allowance. This determination will be documented in writing and be signed by the Contractor and the Construction Representatives. If there is a failure to agree on all or part of the "bad weather" days for a particular month, that disagreement shall be noted on this written document and signed by each party's representative. Failure of the Contractor's representative to sign the "bad weather" day documentation after it is presented, with or without the notes of disagreement, shall constitute agreement with the "bad weather" day determination contained in that document.
- D. There will be no modification to the time of contract performance due solely to the failure to deplete the "bad weather" day allowance.

ALLOWANCES 012100 - 1

E. Once this allowance is depleted, a no cost Change Order time extension will be executed for "bad weather" days, as defined above, encountered during the remainder of the Project.

#### 1.4 SELECTION AND PURCHASE

A. Purchase products and systems selected by Designer from the designated supplier.

#### 1.5 SUBMITTALS

- A. Submit proposals for purchase of products or systems included in allowances, in the form specified for Change Orders.
- B. Submit invoices or delivery slips to show actual quantities of materials delivered to the site for use in fulfillment of each allowance.
- C. Coordinate and process submittals for allowance items in same manner as for other portions of the Work.

#### 1.6 COORDINATION

A. Coordinate allowance items with other portions of the Work. Furnish templates as required to coordinate installation.

#### 1.7 ALLOWANCES

A. Unless otherwise indicated, Contractor's costs for receiving and handling at Project site, labor, installation, overhead and profit, and similar costs related to products and materials under allowance shall be included as part of the Contract Sum and not part of the allowance.

#### PART 2 - PRODUCTS (Not Used)

#### **PART 3 - EXECUTION**

#### 3.1 EXAMINATION

A. Examine products covered by an allowance promptly on delivery for damage or defects. Return damaged or defective products to manufacturer for replacement.

#### 3.2 PREPARATION

A. Coordinate materials and their installation for each allowance with related materials and installations to ensure that each allowance item is completely integrated and interfaced with related work.

#### 3.3 SCHEDULE OF ALLOWANCES

- A. Weather Allowance: Included within the completion period for this Project is ten (10) "bad weather" days.
- B. Unit Price Allowances:
  - 1. Unit Price No. 1-2" Conduit: 1500 LF
  - 2. Unit Price No. 2 Electrical Wiring: 3000 LF

ALLOWANCES 012100 - 2

3. Unit Price No. 3 – Grounding Wire: 1500 LF

#### **END OF SECTION 012100**

ALLOWANCES 012100 - 3

#### **SECTION 012200 – UNIT PRICES**

#### **PART 1 - GENERAL**

#### 1.1 RELATED DOCUMENTS

- A. Drawings and general provisions of the Contract including General and Supplementary Conditions and other Division 1 Specification Sections apply to this Section.
- B. Quantities of Units to be included in the Base Bid are indicated in Section 004322 Unit Prices.

#### 1.2 SUMMARY

- A. This Section includes administrative and procedural requirements for Unit Prices.
- B. Related Sections include the following:
  - 1. Division 1 Section "Allowances" for procedures for using Unit Prices to adjust quantity allowances.
  - 2. Division 1 Section "Contract Modification Procedures" for procedures for submitting and handling Change Orders.

#### 1.3 **DEFINITIONS**

A. Unit Price is an amount proposed by bidders, stated on the Bid Form Attachment 004322 a price per unit of measurement for materials or services added to or deducted from the Contract Sum by appropriate modification, if estimated quantities of Work required by the Contract Documents are increased or decreased.

#### 1.4 PROCEDURES

- A. Unit Prices include all necessary material plus cost for delivery, installation, insurance, [applicable taxes, ]overhead, and profit.
- B. Measurement and Payment: Refer to individual Specification Sections for work that requires establishment of Unit Prices. Methods of measurement and payment for Unit Prices are specified in those Sections.
- C. Owner reserves the right to reject Contractor's measurement of Work in-place that involves use of established Unit Prices and to have this work measured, at Owner's expense, by an independent surveyor acceptable to Contractor.
- D. List of Unit Prices: A list of Unit Prices is included in Part 3. Specification Sections referenced in the schedule contain requirements for materials described under each Unit Price.

UNIT PRICES 012200 - 1

#### PART 2 - PRODUCTS (Not Used)

#### **PART 3 - EXECUTION**

#### 3.1 LIST OF UNIT PRICES

- A. Unit Price No. 1 2" Conduit:
  - 1. Description: Install new 2" electrical conduit according to Division 26 Section "260533 Raceways and Boxes for Electrical Systems."
  - 2. Unit of Measurement: LF (linear feet).
  - 3. Base Bid Quantity: 1500 LF
- B. Unit Price No. 2 Electrical Wire:
  - 1. Description: Install new electrical wire for site lighting systems according to Division 26 Section "260519 Low-Voltage Electrical Power Conductors and Cables."
  - 2. Unit of Measurement: LF (linear feet).
  - 3. Base Bid Quantity: 3000 LF
- C. Unit Price No. 3 Grounding Wire:
  - 1. Description: Install new grounding wire for site lighting systems according to Division 26 Section "260519 Low-Voltage Electrical Power Conductors and Cables."
  - 2. Unit of Measurement: LF (linear feet).
  - 3. Base Bid Quantity: 1500 LF

**END OF SECTION 012200** 

UNIT PRICES 012200 - 2

# SECTION 260519 - LOW-VOLTAGE ELECTRICAL POWER CONDUCTORS AND CABLES

#### **PART 1 - GENERAL**

#### 1.1 SUMMARY

- A. Section Includes:
  - 1. Copper wire rated 600 V or less.
  - 2. Metal-clad cable, Type MC, rated 600 V or less.
  - 3. Connectors, splices, and terminations rated 600 V and less.

#### 1.2 ACTION SUBMITTALS

- A. Product Data: For each type of product.
- B. Product Schedule: Indicate type, use, location, and termination locations.

#### 1.3 INFORMATIONAL SUBMITTALS

A. Field quality-control reports.

#### **PART 2 - PRODUCTS**

#### 2.1 COPPER WIRE

- A. Description: Flexible, insulated and uninsulated, drawn copper current-carrying conductor with an overall insulation layer or jacket, or both, rated 600 V or less. Belden, Southwire, Alpha or approved equal.
- B. Standards:
  - 1. Listed and labeled as defined in NFPA 70, by a qualified testing agency, and marked for intended location and use.
  - 2. RoHS compliant.
  - 3. Conductor and Cable Marking: Comply with wire and cable marking according to UL's "Wire and Cable Marking and Application Guide."
- C. Conductors: Copper, complying with ASTM B 3 for bare annealed copper and with ASTM B 8 for stranded conductors.
- D. Conductor Insulation:
  - 1. Type THHN and Type THWN-2: Comply with UL 83.

#### 2.2 CONNECTORS AND SPLICES

A. Description: Factory-fabricated connectors, splices, and lugs of size, ampacity rating, material, type, and class for application and service indicated; listed and labeled as

defined in NFPA 70, by a qualified testing agency, and marked for intended location and use.

- B. Jacketed Cable Connectors: For steel and aluminum jacketed cables, zinc die-cast with set screws, designed to connect conductors specified in this Section.
- C. Lugs: One piece, seamless, designed to terminate conductors specified in this Section.
  - 1. Material: Copper.
  - 2. Type: One hole with standard barrels.
  - 3. Termination: Compression.

#### **PART 3 - EXECUTION**

#### 3.1 CONDUCTOR MATERIAL APPLICATIONS

- A. Feeders: Copper; solid for No. 10 AWG and smaller; stranded for No. 8 AWG and larger.
- B. Branch Circuits: Copper. Solid for No. 10 AWG and smaller; stranded for No. 8 AWG and larger.
- C. Branch Circuits: Copper. Solid for No. 12 AWG and smaller; stranded for No. 10 AWG and larger.
- D. Power-Limited Control: Solid for No. 12 AWG and smaller.

## 3.2 CONDUCTOR INSULATION AND MULTICONDUCTOR CABLE APPLICATIONS AND WIRING METHODS

- A. Feeders Concealed in Ceilings, Walls, Partitions, and Crawlspaces: Type THHN/THWN-2, single conductors in raceway.
- B. Feeders Concealed in Concrete, below Slabs-on-Grade, and Underground: Type THHN/THWN-2, single conductors in raceway.

#### 3.3 INSTALLATION OF CONDUCTORS AND CABLES

- A. Conceal cables in finished walls, ceilings, and floors unless otherwise indicated.
- B. Complete raceway installation between conductor and cable terminateon points according to Section 26 05
- C. Use manufacturer-approved pulling compound or lubricant where necessary; compound used must not deteriorate conductor or insulation. Do not exceed manufacturer's recommended maximum pulling tensions and sidewall pressure values.
- D. Use pulling means, including fish tape, cable, rope, and basket-weave wire/cable grips, that will not damage cables or raceway.
- E. Install exposed cables parallel and perpendicular to surfaces of exposed structural members, and follow surface contours where possible.

#### 3.4 CONNECTIONS

- A. Tighten electrical connectors and terminals according to manufacturer's published torquetightening values. If manufacturer's torque values are not indicated, use those specified in UL 486A-486B.
- B. Make splices, terminations, and taps that are compatible with conductor material and that possess equivalent or better mechanical strength and insulation ratings than unspliced conductors.
- C. Wiring at Outlets: Install conductor at each outlet, with at least 6 inches of slack.

#### 3.5 IDENTIFICATION

- A. Identify and color-code conductors and cables according to Section 26 05 53 "Identification for Electrical Systems."
- B. Identify each spare conductor at each end with identity number and location of other end of conductor, and identify as spare conductor.

#### 3.6 SLEEVE AND SLEEVE-SEAL INSTALLATION FOR ELECTRICAL PENETRATIONS

A. Install sleeves and sleeve seals at penetrations of exterior floor and wall assemblies. Comply with requirements in Section 26 05 44 "Sleeves and Sleeve Seals for Electrical Raceways and Cabling."

#### **END OF SECTION 260519**

Pre-Bid Meeting Attendance Sheet Troop H Headquarters & Crim Lab-Exterior Renovations St. Joseph, Missouri

Project No. R2338-01 August 20, 2024 10:30AM

Name & Title	Company Name & Type of Contracting	MBE/WBE/ SDVE Status	Phone	E-Mail Address of Attendee & E-Mail Address of Individual filling out Bid Documents
DAVID T. FORD MANAGING DIRECTOR	WALTER P MOORE	1	816 701-2118	PFORDO WALTERP MOORE.COM
BRITTIN GORAN COWNER + CEO	REL DEVELOP MENT	W8E	573,864.5061	CONNECT & REIDENGIROUP. COM
DAULO ACLLRY Pleased LEATER	3013	,	816-400-2316	316-400-2316 DAVID. ACKLEY COCCOMANDEOT.
Undsay Fida Oraduate Enginu	Walter P Woore			Holasmalterpmoore.com
MIKE HANKE PROSECT MANNIER	WASTER P MOORE		צווב-וסר אוצי	mhinked watherpmoore com
Wayne Lottid Project Marager	MTS contracting		816-98-3279	816-98-3279 Westin & Mts contracting, com

Pre-Bid Meeting Attendance Sheet Troop H Headquarters & Crim Lab-Exterior Renovations St. Joseph, Missouri

Project No. R2338-01 August 20, 2024 10:30AM

	Company Name	MBE/WBE/	ċ	E-Mail Address of Attendee and
Name & Title	Type of Contracting	SDVE Status	Pnone	E-Mail Address of Individual Illing out Bid Documents
DREW GRAY	E.L. CRAWFORD		8/1-233-2596	drew @ elerantopo. Com
Casey Laner	ELCC		816 233-35h	816 233-25th Casey @ closur from -cr-
Myone Harring Pinnings Stecks.	PHWARE Electric		016-279-1800	dumme e prima mole electric inc.
Paul Loftin Facilities Mann Fres L. Decret of	d+15W		573-568-4269	Paul. loftin Emshp. dgs. mo. gov fred. decker @ 04. mo. 60V
Plested namedel	0A-FUDC		136-126-8521	





walter or

Walter P. Moore and Associa 1100 Walnut, Suite 1825 Kansas City, Missouri 64106

OFFICE OF ADMINISTRATION DIVISION OF FACILITIES MANAGEMENT, DESIGN AND CONSTRUCTION

MISSOURI STATE HIGHWAY PATROL

CRIME LAB - EXTERIOR RENOVATIONS TROOP H HEADQUARTERS BUILDING

PROJECT# R-2338-01 SITE# 6009 FACILITY# 8136009002 & 8136009003

REVISION: ADDENDUM #1
DATE: 08:30:2024
REVISION: DATE:
REVISION: DATE:
ISSUE DATE:

CAD DWG FILE:C-109 dwg DRAWN BY: DMB CHECKED BY: MJH DESIGNED BY: LF

SHEET TITLE:
CIVIL SITE
LAYOUT PLAN

(1) CIVIL SITE LAYOUT PLAN

C-109





walter of the constant of the Walter P. Moore and Associal 1100 Walnut, Suite 1825 Kansas City, Missouri 64106

OFFICE OF ADMINISTRATION DIVISION OF FACILITIES MANAGEMENT, DESIGN AND CONSTRUCTION

MISSOURI STATE HIGHWAY PATROL

CRIME LAB - EXTERIOR RENOVATIONS TROOP H HEADQUARTERS BUILDING

ST. JOSEPH, MISSOURI


PROJECT# R-2338-01 SITE# 6009 FACILITY# 8136009002 & 8136009003

REVISION: ADDENDUM #1
DATE: 08:30:2024
REVISION: DATE:
REVISION: DATE:
ISSUE DATE:


CIVIL SITE

1 PAVEMENT JOINT PLAN

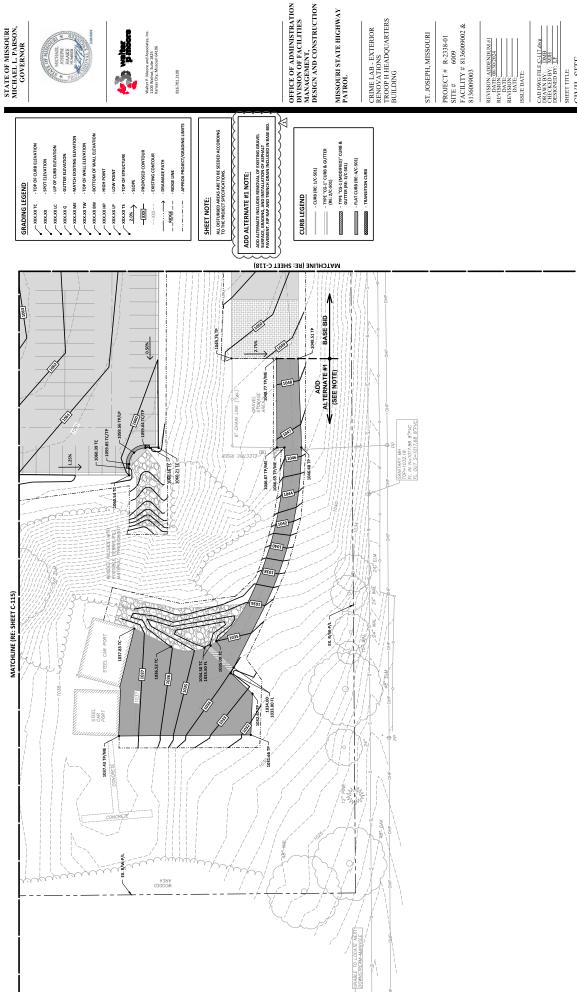





Walter P. Moore and Associal 1100 Walnut, Suite 1825 Kansas City, Missouri 64106

CRIME LAB - EXTERIOR RENOVATIONS TROOP H HEADQUARTERS BUILDING

ST. JOSEPH, MISSOURI

PROJECT# R-2338-01 SITE# 6009 FACILITY# 8136009002 & 8136009003

REVISION: ADDENDUM #1
DATE: 08:30:2024
REVISION: DATE:
REVISION: DATE:
ISSUE DATE:


CAD DWG FILE;C-117.dwg DRAWN BY: DMB CHECKED BY: MH DESIGNED BY: LF

SHEET TITLE:
CIVIL SITE
GRADING PLAN

(1) CIVIL SITE GRADING PLAN

C-117

				0)	ITE LIGHT	SITE LIGHTING SCHEDULE	DULE					
MARK	MANUFACTURER*	MODEL NO.*	TYPE	VOLTS	AMPS	WATTS	LUMENS	(),()	ig.	LAMPS	MOUNTING	REMARKS
٧	ISI	XFLM-VF-LED-28-HO-NW-UNV-BRZ-PC1120	ARCHITECTURAL FLOOD (XFLM)	120		36	3156	4000k	08	O31	STANCHION	
89	ISI	XBVRD-ID-LED-24-400-WW-UE-BRZ-PC1120-45	ARCHITECTURAL BOLLARD (XBVR)	120		38	1224	4000k	0.0	OE)	BOLLARD	
٥	WAVE LIGHTING	C8025T-F-L40-C-8Z	ENTRANCE LIGHTING	120		40	4000	3000 <del>7</del>	06	O37	POLE POST (7FT)	
٥	COOPER LIGHTING SOLUTIONS	GALN-SA4C-940-2-T4FT-HSS-PA-BZ-PR	AREALIGHTING	208		213	27751	3000 <del>7</del>	06	TED TED	20 FT POLE + 3 FT BASE)	3) FT POLE + 3 FT BASE)   DUAL HEADED FIXTURE WITH NEW POLE
MINDE												

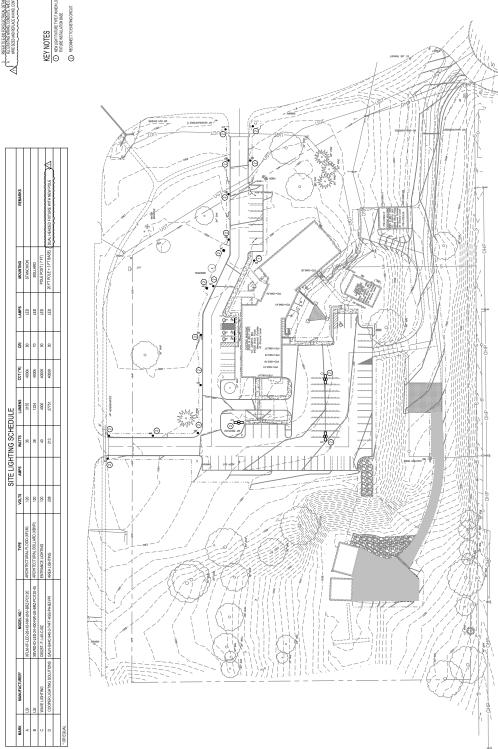















# OFFICE OF ADMINISTRATION DIVISION OF FACILITIES MANAGEMENT, DESIGN AND CONSTRUCTION

MISSOURI STATE HIGHWAY PATROL

CRIME LAB - EXTERIOR RENOVATIONS TROOP H HEADQUARTERS BUILDING

ST. JOSEPH, MISSOURI

PROJECT# R-2338-01 SITE# 6009 FACILITY# 8136009002 & 8136009003

CAD DWG FILE:
DRAWN BY: MCC
CHECKED BY: CKB
DESIGNED BY: HAK

SHEET TITLE:
ELECTRICAL SITE
PLAN

 $\underset{\scriptscriptstyle{26\text{ OF 34 SHETS}}}{E-200}$ 

_	=		L									2-	ý
	TEM NO.	1	60	9	2	9	1	8	6	10	11	12	CONTRACT
NEW CONSTRUCTION SUMMARY OF QUANTILES	DESCRIPTION	MONUMENT LIGHTS	YARDLIGHTS	ENTRANCE LIGHTS	PARKING AREA LIGHTS WITH DOUBLE HEAD FIXTURE	CONCRETE BASE FOUNDATION	1C #10 POLE AND BRACKET CABLE	3-1C #6 DISTRIBUTION CABLE	2" SCHEDULE 40 PVC CONDUIT FOR POWER	PHOTOCELL ON - TIME -CLOCK OFF	WIRE CONNECT - MISCELLANEOUS	PARKING LOT AREA LIGHT POLES	NOTE CONTRACTOR SHALL PROVIDE ALL MATERIAL AND LARGE FOR A COMPLETE AND WORKING SOSTEM
WILLES	UNIT	EA	EA	EA	EA	EA	- IF	- ILF	JT.	EA	LF	EA	GHTING SYSTEM
	PLAN QUANTITY	2	10	4	3	3	45	900	10	3	(8)	3	














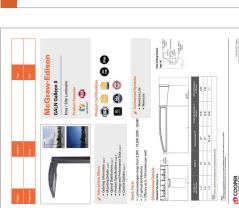











CUSTOM ENGINEERING

OFFICE OF ADMINISTRATION DIVISION OF FACILITIES MANAGEMENT, DESIGN AND CONSTRUCTION

MISSOURI STATE HIGHWAY PATROL

CRIME LAB - EXTERIOR RENOVATIONS TROOP H HEADQUARTERS BUILDING

ST. JOSEPH, MISSOURI

PROJECT# R-2338-01 SITE# 6009 FACILITY# 8136009002 & 8136009003


REVISION: ADDENDUM#1
REVISION: 08:30:2024
REVISION: DATE:
REVISION: DATE:
ISSUE DATE:

CAD DWG FILE;
DRAWN BY: MCC
CHECKED BY: CKB
DESIGNED BY: HAK

SHEET TITLE:
ELECTRICAL
DETAILS

SHEET NUMBER:

 $\underset{\tiny{0.9382024}}{E-300}$ 

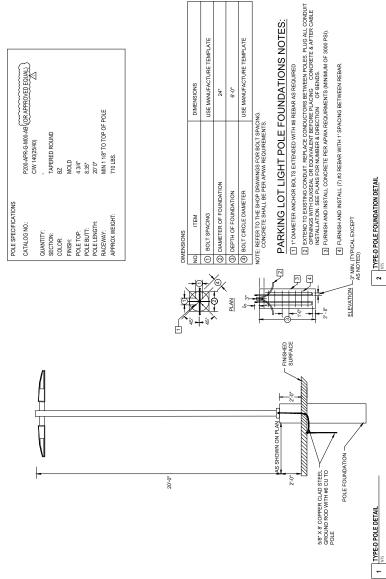





Walter P. Moore and Associates, I 1100 Walnut, Suite 1825 Kansas City, Missouri 64106

816.701.2100



CUSTOM ENGINEERING

OFFICE OF ADMINISTRATION DIVISION OF FACILITIES MANAGEMENT, DESIGN AND CONSTRUCTION

MISSOURI STATE HIGHWAY PATROL

CRIME LAB - EXTERIOR RENOVATIONS TROOP H HEADQUARTERS BUILDING

ST. JOSEPH, MISSOURI

PROJECT # R-2338-01 SITE # 6009

FACILITY # 8136009002 & 8136009003

REVISION: ADDENDUM#1
REVISION: 08:30:2024
REVISION: DATE:
REVISION: DATE:
ISSUE DATE:

CAD DWG FILE; DRAWN BY: MCC CHECKED BY: CKB DESIGNED BY: HAK

SHEET TITLE:

SUPPLEMENTAL POLE DETAILS

SHEET NUMBER:

E-301